

Tap ID - 05-410827

11-18-93 House connection required, JEN
11-24-93 ok JEN P 49738

PERMIT

SEWAGE DISPOSAL SYSTEM

DEPARTMENT OF HEALTH AND MENTAL HYGIENE

A 47974

DISTRICT _____

DATE 11/5/93

HOWARD COUNTY HEALTH DEPARTMENT

BUREAU OF ENVIRONMENTAL HEALTH

~~XXXXXXXX~~ 313-2640

DATE SYSTEM APPROVED 11-24-93

INSPECTOR JEN

INDEXED

Tattie Levy IS PERMITTED TO INSTALL ALTER _____

ADDRESS PO Box 129 Glenwood MD 21738 PHONE 301-442-2747

SUBDIVISION Twelve Hills, Sec. 3 LOT 43 ROAD 13010 Red Maple Way

PROPERTY OWNER Michael and Dawn Donovan

ADDRESS _____

SEPTIC TANK CAPACITY 1250 GALLONS

NUMBER OF BEDROOMS 4

210 SQUARE FEET PER BEDROOM

210
4
3150
280

LINEAR FEET OF TRENCH REQUIRED 280

TRENCHES - Trench to be 3 feet wide. Inlet 3 feet below original grade. Bottom maximum depth 5.5 feet below original grade. Effective area begins at 3.0 feet below original grade. 2.5 feet of stone below distribution pipe.

LOCATION - Place the distribution box 220 feet down the left (391.9') lot line and 115 feet off the same lot line as seen when facing the lot from Red Maple Way. Run trenches along contour toward the left (391.9') and rear (215.88') lot lines. MAINTAIN A MINIMUM OF 100 FEET TO ALL WELLS.

NOTES - No trench to exceed 100 feet in length. Provide 6" - 8" diameter cleanout and cap to grade or above on septic tank. 012 6/23/93 BH

PLANS APPROVED BY Jane Nadeau DATE 4/12/93

COVER NO WORK UNTIL INSPECTED AND APPROVED

NEITHER THE HOWARD COUNTY COUNCIL NOR THE HEALTH DEPARTMENT IS RESPONSIBLE FOR THE SUCCESSFUL OPERATION OF ANY SYSTEM

NOTE: CLEANOUT REQUIRED EVERY 70 FEET OF SEWER LINE AND/OR AT 90° SWEEPS IN LINES FROM HOUSE TO DRAIN FIELDS, 90° ELBOWS NOT ACCEPTABLE.

NOTE: ALL PARTS OF SEPTIC SYSTEMS (I.E. TANK, DISTRIBUTION BOX TRENCHES) TO BE 100 FEET FROM WELL (UNLESS OTHERWISE SPECIFICALLY AUTHORIZED)

NOTE: IF DEEP TRENCH(ES) ARE USED CALL FOR INSPECTION BEFORE AND AFTER PLACING GRAVEL IN TRENCH(ES)

NOTE: NO DRY WELL SHALL EXCEED 15 FOOT IN DIAMETER NO ABSORPTION TRENCH TO EXCEED 100 FEET IN LENGTH

NOTE: ALL PIPE FROM HOUSE TO SEPTIC TANK MUST BE CAST IRON OR SCHEDULE 35/40 PVC OR ABS

PERMIT VOID AFTER TWO YEARS

NOTE: INSTALL STAND PIPE ON SEPTIC TANK AND DRY WELL STAND PIPES MUST BE 6 INCHES IN DIAMETER CAST IRON, CONCRETE OR TERRA COTTA OR PVA OR ABS ACCEPTED. IF TOP OF SEPTIC TANK IS DEEPER THAN 3 FEET. MANHOLE TO GRADE REQUIRED


NOTE: DISTRIBUTION BOXES MUST HAVE BAFFLES

BLDG. PERMIT SIGNED AND RETURNED 2-25-99
Serial # 670116380

John A. Allerton

***INSTALLER IS RESPONSIBLE FOR OBTAINING FINAL APPROVAL ON THIS PERMIT**

A 47974

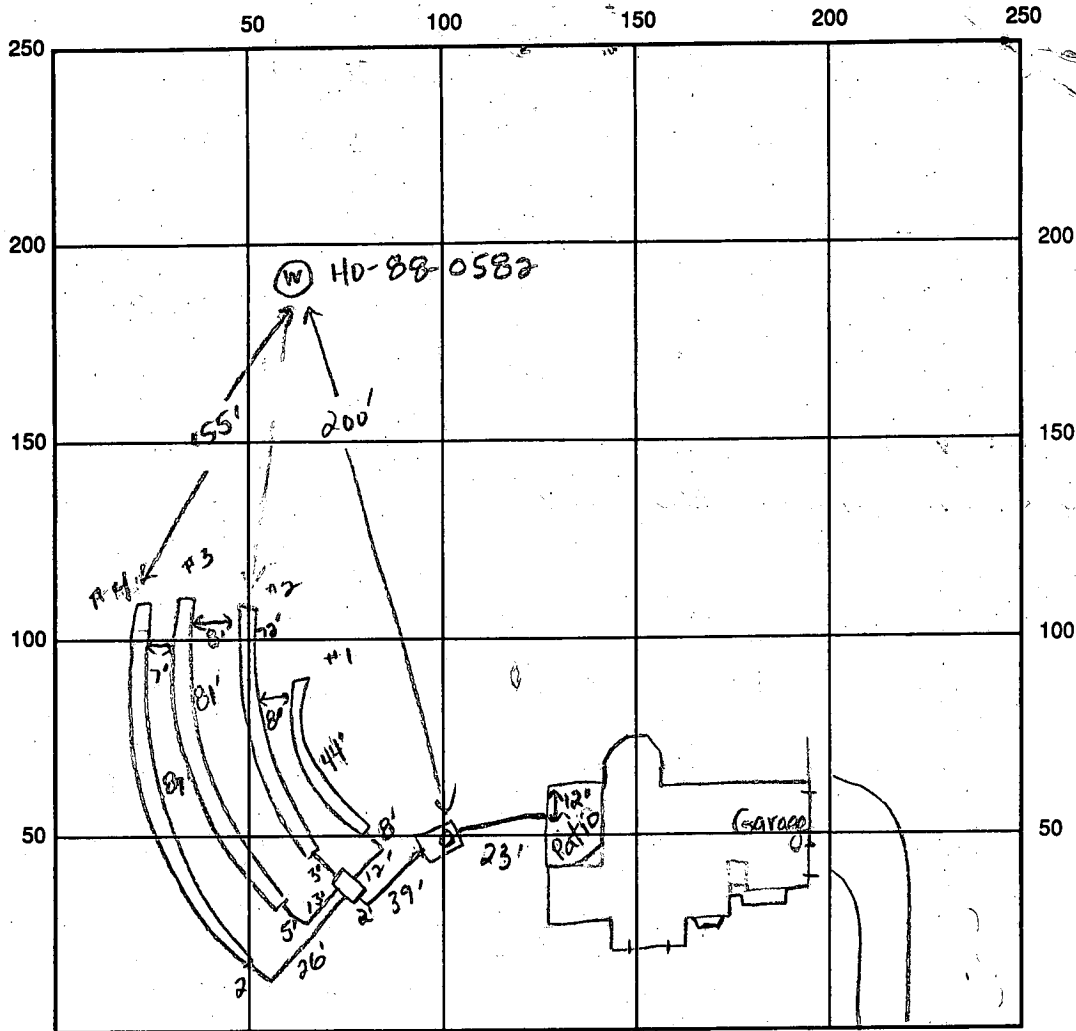

INDICATE NORTH - NAME ADJOINING ROADWAY AS BASE LINE

Red Maple Way

SEPTIC TANK LEVEL ok 1250 gal CLEANOUTS 1 on septic tank

DISTRIBUTION BOX LEVEL ok w/ divider

DRAIN FIELD/TITLE DEPTH 5.5/5.5/5.5/5.2 FT. TRENCH WIDTH 3 FT. INLET DEPTH 3/3.5/2.5/2.5 FT.

EFFECTIVE GRAVEL DEPTH 2.5/2/3/3 FT. TOTAL LENGTH 44/72/81/87 FT.

NUMBER OF TRENCHES 4 ONE SIDEWALL/BOTTOM AREA 139/216/247/261 SQ. FT.

DRYWALL INSIDE DIAMETER FT. EFFECTIVE DEPTH BELOW INLET FT.

ABSORBENT AREA 852 SQ. FT.

REMARKS: 11-18-93 OK to cover all work behind septic tank. Need house connection. JEN
11-24-93 OK to cover septic tank and house connection, JEN

DATE SYSTEM APPROVED 11-24-93 INSPECTOR Jane E. Madigan

APPLICATION

4/1/92
1:30
4-392
1:30

PERCOLATION TESTING

A 47974

P _____

HOWARD COUNTY HEALTH DEPARTMENT
BUREAU OF ENVIRONMENTAL HEALTH
P.O. BOX 476 ELLICOTT CITY, MARYLAND 21043
TELEPHONE. 461-9933

PREVIOUS OK
TEST FOR RECONSTRUCTIVE MGA.
WET-1 2005 ACROSS STAGGT
10-15' LOWER IN ELEV. C.W.

DISTRICT _____

DATE 3/31/92

1/2

TO: THE COUNTY HEALTH OFFICER
ELLICOTT CITY, MARYLAND

I. HEREBY, APPLY FOR THE NECESSARY TEST IN ORDER TO CONSTRUCT (OR RECONSTRUCT) A SEWAGE DISPOSAL SYSTEM.

Michael P and Dawn K. DONOVAN

PROPERTY OWNER TERRIE J. LEVY CONST Co Inc

ADDRESS 3689 Sharp Rd PHONE 301 442-2747

PROSPECTIVE BUYER Glennwood and 21738 725-5677
924-4471

ADDRESS _____ PHONE _____

PROPERTY LOCATION:

SUBDIVISION 12 Hills sub. sec 3 LOT NO. Lot 43

ROAD AND DESCRIPTION 13010 Red maple way

TAX MAP _____ PARCEL # _____

Reperc

SIZE OF LOT 3 acres TYPE BLDG SINGLE
(SINGLE FAMILY DWELLING OR COMMERCIAL)

THE SYSTEM INSTALLED UNDER THIS APPLICATION IS ACCEPTABLE ONLY UNTIL PUBLIC FACILITIES BECOME AVAILABLE. I FULLY UNDERSTAND THE FEE CONNECTED WITH THE FILING OF THIS PERC TEST APPLICATION IS NON-REFUNDABLE UNDER ANY CIRCUMSTANCES. I ALSO AGREE TO COMPLY WITH ALL M.O.S.H.A. REQUIREMENTS IN TESTING THIS LOT.

G.C. Long pres
(SIGNATURE OF APPLICANT)

APPROVED BY _____ FOR _____ DATE _____

REJECTED BY _____ FOR _____ DATE _____

HOLD PENDING FURTHER TESTS _____ DATE _____

REASONS FOR REJECTION OR HOLDING 4-9-92 Pending perc hole locations and plan approval JEN

BLDG. PERMIT ~~SIGNED~~
AND RETURNED 3/6/92
Paul 48257
SF-17 - 4 Boms


HD-216

THIS IS NOT A PERMIT

A479.74

SOIL PROFILE

0-3.5 Br s1 c loam
 3.5-4.5 Orange br s1 lm
 4.5-12.5 White clay s1 lm, desomp. pegmatite w/ quartz, feldspar and muscovite
 Damp to moist at bottom
 12.5 Bottom

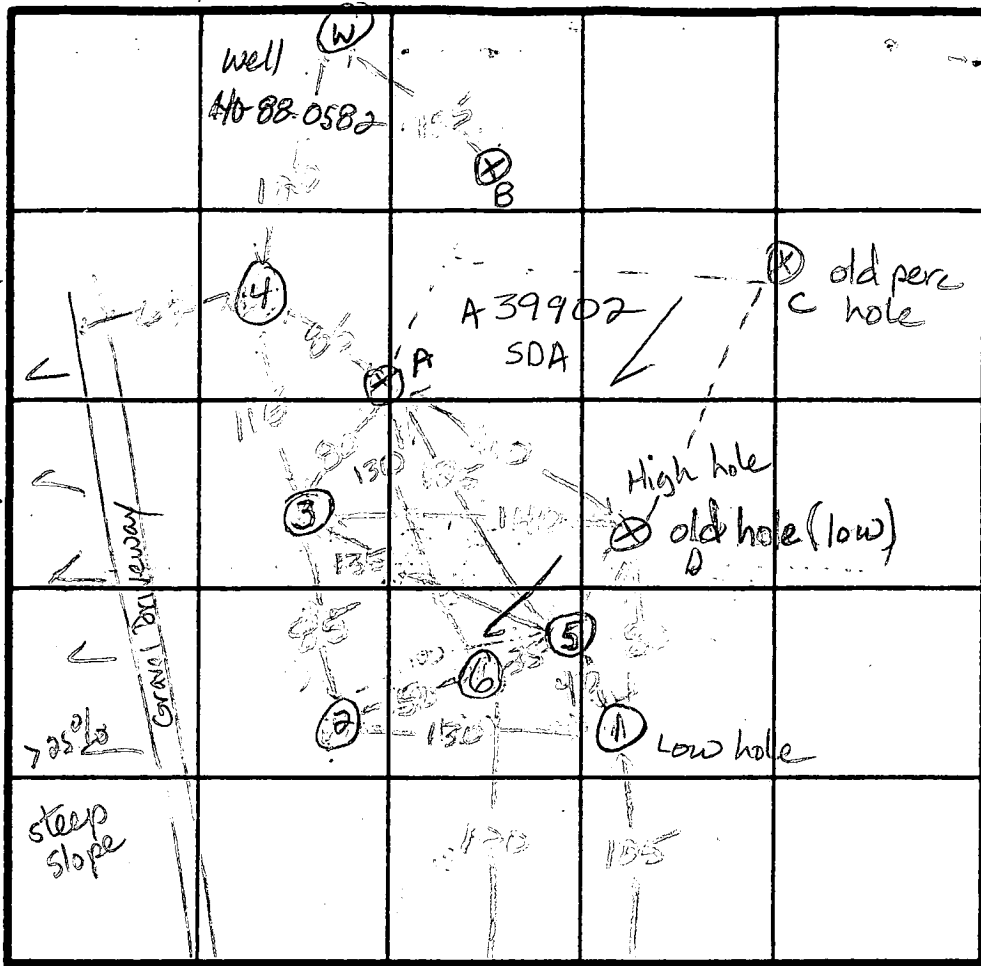

0-3.0 Red s1 c lm
 3.0-5.5 Br s1 clay lm
 5.5-14.0 White c1 s1 lm, pegmatite w/ quartz & feldspar
 14.0 Bottom
 x̄ = 8 min
 3.0 ft wide
 3.0 ft inlet
 5.5 ft bottom

INDICATE NORTH - NAME ADJOINING ROADWAY AS BASE LINE.

Red Maple Way --- Cl

0-3.0 Yellow-br s1 c loam
 3-6.0 Red s s1 lm
 6-12.5 brown s s1 lm
 12.5 Bottom

0-6.0 Red-br s1 c lm
 6.0-15.0 Red s s1 lm
 little rock frags < 10%
 15.0 Bottom

0-3.0 Br s1 c l
 3.0-5.5 Red-br s1 c loam
 5.5-13.5 Red-br s s1 loam
 13.5 Bottom

DATE	TEST NO.	DEPTH	PRE-WET		TEST - 1" DROP		TIME
			START	STOP	START	STOP	
4-19-92	X 1	4.5 S	1:51:00	2:24	1/4 inch		slow
		12.5 D	Pegmatite from		4.5 ft to	12.5 ft	Fail
	2	4.5 S (see next page)	2:02:11	2:03:45	2:03:45	2:07:02	3 min 17 sec
		12.5 D	Bottom				ok
	3	5.0 S	2:30:09	2:33	2:33	2:42	9 min
		15.0 D	Bottom				ok
	4	5.0 S 12.0 D	3:08:34	3:15	3:15	3:45	slow fail
					3/4 inch		
	X 5	4.5 S 9.5 D	3:49	4:03	4:03	4:29	26 min
			Hoe broke		down		
4-3-92	X 5	8.5 M	2:58	3:21	3:21	3:57	36 min
		14.0 D	Pegmatite decomposed from				Fail

5.5' bottom max
 8.0' bottom max

REMARKS * Barshoe broke a hydraulic line 4-2-92 5.5 feet.

TYPE OF SOIL _____

TESTED BY J.E. Nadeau ALSO PRESENT Mr. Levy

APPLICATION

PERCOLATION TESTING

A 47974

P _____

HOWARD COUNTY HEALTH DEPARTMENT
BUREAU OF ENVIRONMENTAL HEALTH
P.O. BOX 476 ELLICOTT CITY, MARYLAND 21043
TELEPHONE 461-9933

DISTRICT _____

DATE 3-31-98

2/2

TO: THE COUNTY HEALTH OFFICER
ELLICOTT CITY, MARYLAND

I HEREBY APPLY FOR THE NECESSARY TEST IN ORDER TO CONSTRUCT (OR RECONSTRUCT) A SEWAGE DISPOSAL SYSTEM.

PROPERTY OWNER Tattrie E. Levij Const. Co. Inc

ADDRESS 3689 Sharp Road PHONE 301-442-2747

PROSPECTIVE BUYER Glenwood, MD 21738 PHONE 942-4471

ADDRESS _____ PHONE _____

PROPERTY LOCATION:

SUBDIVISION Twelve Hills Sec 3 LOT NO. 43

ROAD AND DESCRIPTION Red Maple Way

TAX MAP _____ PARCEL # _____

SIZE OF LOT _____ TYPE BLDG SFD Reperc
(SINGLE FAMILY DWELLING OR COMMERCIAL)

THE SYSTEM INSTALLED UNDER THIS APPLICATION IS ACCEPTABLE ONLY UNTIL PUBLIC FACILITIES BECOME AVAILABLE. I FULLY UNDERSTAND THE FEE CONNECTED WITH THE FILING OF THIS PERC TEST APPLICATION IS NON-REFUNDABLE UNDER ANY CIRCUMSTANCES. I ALSO AGREE TO COMPLY WITH ALL M.O.S.H.A. REQUIREMENTS IN TESTING THIS LOT.

(SIGNATURE OF APPLICANT)

APPROVED BY _____ FOR _____ DATE _____

REJECTED BY _____ FOR _____ DATE _____

HOLD PENDING FURTHER TESTS _____ DATE _____

REASONS FOR REJECTION OR HOLDING _____

HD-216

THIS IS NOT A PERMIT

A47974

(6)

SOIL PROFILE

0-3 Red-br
s s/c/m
3-14.0 Brown
s s/c/m
L10%
rock
frag
Bottom
14.0

INDICATE NORTH - NAME ADJOINING ROADWAY AS BASE LINE.

DATE	TEST NO.	DEPTH	PRE-WET		TEST - 1" DROP		TIME
			START	STOP	START	STOP	
4-3-92	2	9.0 M	3:02	3:03	3:03	3:07	4min
↓	4	6.5 M 13.5 D	3:19	3:32	3:32	3:52	20min OK
4-9-92	6	4.6 S 14.0 D	1:42	1:47	1:47	1:57	10min OK

6.5' bottom max
7.0' bottom max

4-3-92 Backhoe hose came off again - No other holes excavated
 REMARKS
 TYPE OF SOIL Use holes 2, 3, 4, & 6, old holes OK
 TESTED BY Jane Nadeau ALSO PRESENT Mr. Levij

APPLICATION

PERCOLATION TESTING

A 39902

P _____

HOWARD COUNTY HEALTH DEPARTMENT
BUREAU OF ENVIRONMENTAL HEALTH
P.O. BOX 476 ELLICOTT CITY, MARYLAND 21043
TELEPHONE: 461-9933

9-1-87 Percs ok
pending plat approval JEN

DISTRICT 5th

DATE 8-19-87

TO: THE COUNTY HEALTH OFFICER
ELLICOTT CITY, MARYLAND

I, HEREBY, APPLY FOR THE NECESSARY TEST IN ORDER TO CONSTRUCT (OR RECONSTRUCT) A SEWAGE DISPOSAL SYSTEM.

PROPERTY OWNER Alfred Bassler

ADDRESS 4994 Shepherd Lane PHONE 531-2193

PROSPECTIVE BUYER N/A

ADDRESS _____ PHONE 43 Final

PROPERTY LOCATION:

SUBDIVISION Twelve Hills Sec III LOT NO. 10 ~~11~~ ~~9~~ new

ROAD AND DESCRIPTION Linden Church Rd

BUDG. PERMIT SIGNED
AND RETURNED 7/20/87
#28805 SBR

TAX MAP 28 PARCEL # 49

SIZE OF LOT 3 acres TYPE BLDG. SFD
(SINGLE FAMILY DWELLING OR COMMERCIAL)

THE SYSTEM INSTALLED UNDER THIS APPLICATION IS ACCEPTABLE ONLY UNTIL PUBLIC FACILITIES BECOME AVAILABLE. I FULLY UNDERSTAND THE FEE CONNECTED WITH THE FILING OF THIS PERC TEST APPLICATION IS NON-REFUNDABLE UNDER ANY CIRCUMSTANCES. I ALSO AGREE TO COMPLY WITH ALL M.O.S.H.A. REQUIREMENTS IN TESTING THIS LOT.

M. D. Rein

(SIGNATURE OF APPLICANT)

APPROVED BY _____ FOR _____ DATE _____

REJECTED BY _____ FOR _____ DATE _____


HOLD PENDING FURTHER TESTS _____ DATE _____

REASONS FOR REJECTION OR HOLDING 9-1-87 for perc hole location & subdivision plat approval
Make sure well elevation is higher than septic field JEN

THIS IS NOT A PERMIT

High B-C
Low D-A

A 39902

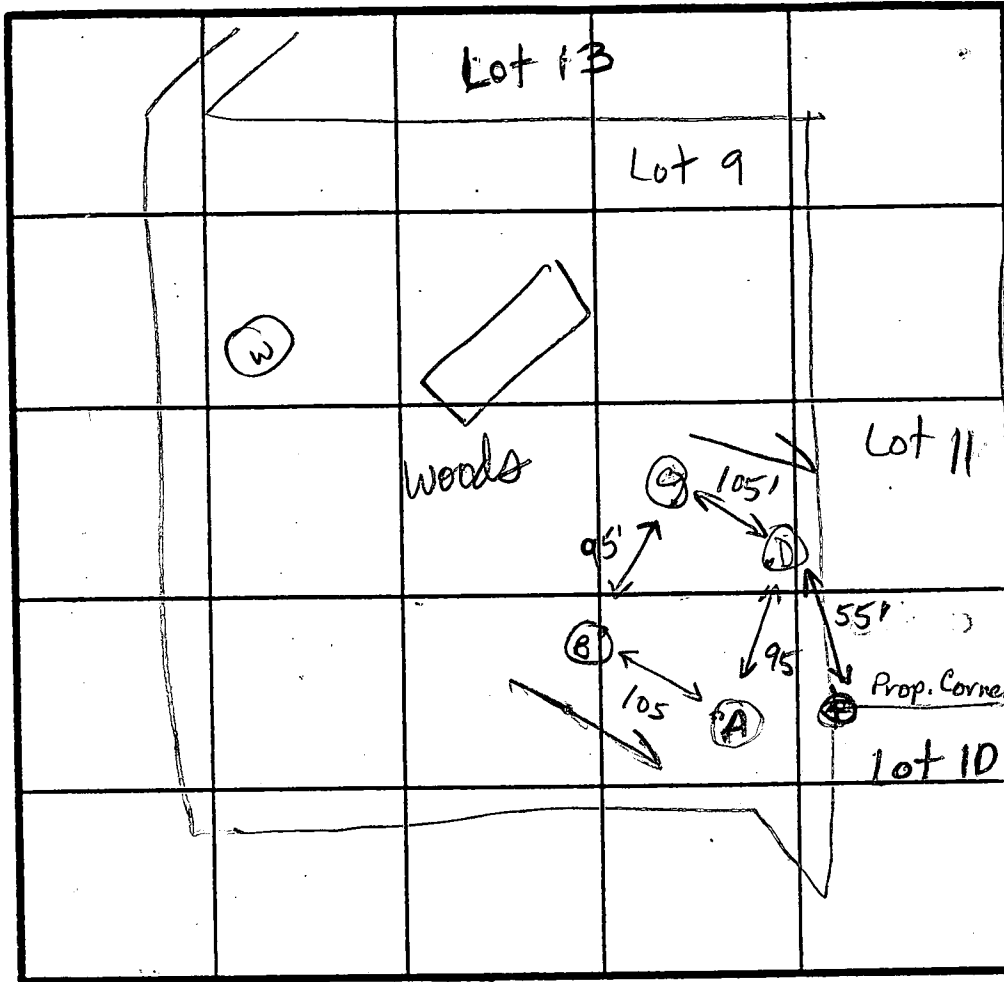

INDICATE NORTH - NAME ADJOINING ROADWAY AS BASE LINE.

ⓐ
0-3.5 Br sa si
lm, trc gvl
3.5-10.5 Red-tan
sandy
si lm,
trc of
broken
rock
fraggs
L 10%
10.5 Bottom

X Perc 3min
160 lb BR
INLET 3.0'
BOTTOM 7.0'

ⓐ
SOIL PROFILE
0'
0-3.5 Brown sa
silty lm,
trc gvl
3.5-8.5 Red sa
si lm
8.5-11 Red-tan
sa loam
14.0 Bottom

ⓐ
0-3.5 Brown sa
si cl lm
3.5-12.5 Brown
micaceous
sa si
loam
12.5 Bottom

ⓐ
0-2.0 Br sa
si lm,
trc gvl
L 5%
2.0-11 Br sa
si lm
broken
rock fraggs
L 30%
11.0 Bottom

DATE	TEST NO.	DEPTH	PRE-WET		TEST - 1" DROP		TIME	
			START	STOP	START	STOP		
9-1-87	D	4 S	1:09	1:11	1:11	1:13	2	
		14 D	Bottom (see profile)					
	A	4 S	1:14	1:16	1:16	1:19	3	
		12.5 D	Bottom (see profile)					
	C	5.0 S	1:23	1:26	1:26	1:29	3	
		7.5 M	1:24	1:26	1:26	1:29	3	
		10.5 D	Bottom (see profile)					
	B	11.0 V	see profile.					ok

REMARKS Holes per plot. Make sure elevation for well is above septic area.


TYPE OF SOIL 0-4 Br sa si lm, trc gvl, 4-14 Red-tan sa si lm

TESTED BY J.E. Wademan ALSO PRESENT Glen K, Mark R..

EH-12-1079

THIS AREA DESIGNATES A PRIVATE SEWAGE EASEMENT OF 10,000 SQ. FT. AS REQUIRED BY THE MARYLAND DEPARTMENT OF THE ENVIRONMENT FOR INDIVIDUAL SEWAGE DISPOSAL IMPROVEMENTS OF ANY NATURE IN THIS AREA ARE RESTRICTED UNTIL PUBLIC SEWER IS AVAILABLE, THESE EASEMENTS SHALL BECOME NULL AND VOID UPON CONNECTION TO A PUBLIC SEWAGE SYSTEM. THE COUNTY HEALTH OFFICER SHALL HAVE THE AUTHORITY TO GRANT VARIANCES FOR ENCROACHMENTS INTO THE PRIVATE SEWAGE EASEMENT. RECONSTRUCTION OF A MODIFIED SEWAGE EASEMENT PLAT SHALL NOT BE NECESSARY.

LOT 44

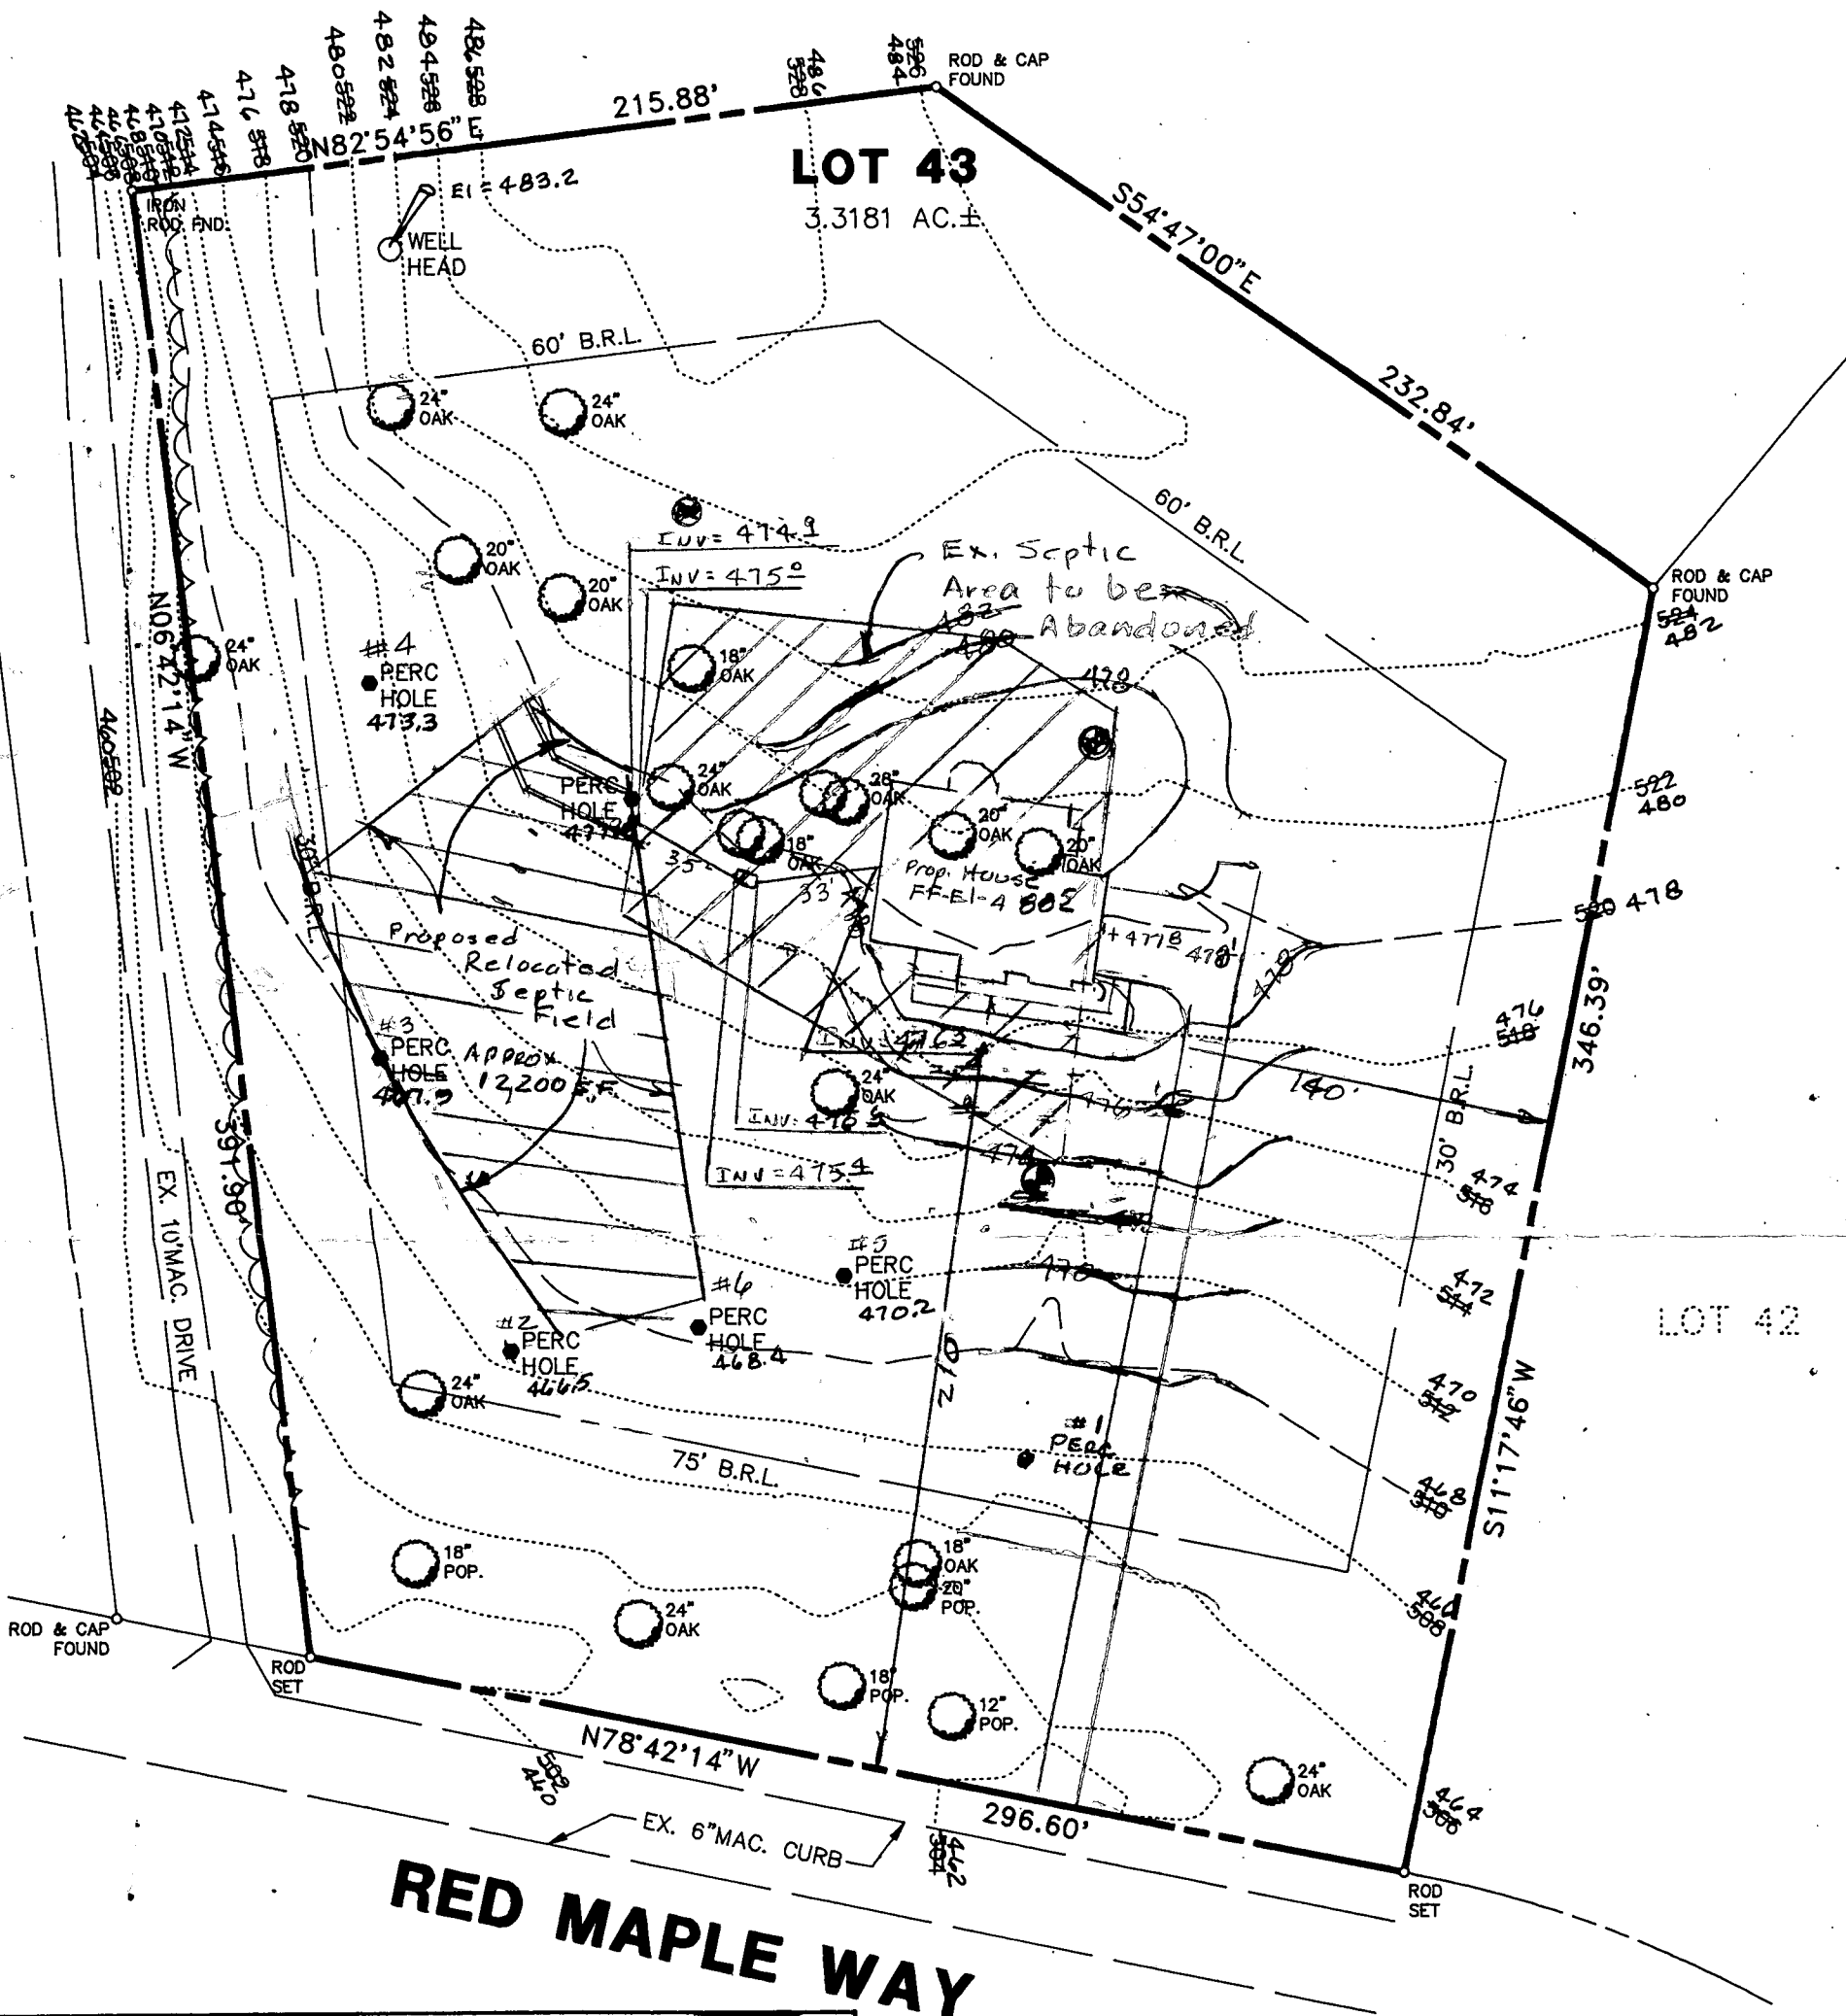

RED MAPLE WAY

APPROVED: For Private Water and Private Sewerage Systems

HOWARD COUNTY HEALTH DEPT.

J. J. B. J.
COUNTY HEALTH OFFICER

4-13-93
DATE

Note: Length of pipes in septic field is to be determined at the time of permit issuance.

SURVEYOR'S CERTIFICATE

I HEREBY CERTIFY THAT THE TOPOGRAPHIC INFORMATION SHOWN HEREON WAS ESTABLISHED BY A FIELD RUN SURVEY AND THAT IS CORRECT AS SHOWN. PERCOLATION TEST LOCATIONS WERE LOCATED BY THE SAME SURVEY AND ARE SHOWN THUS: ● PERC HOLE #3, 4

Jack Clark 3/15/93
LAND SURVEYOR

**PLOT PLAN
LOT 43
TWELVE HILLS
SECTION 3**

ELECTION DISTRICT NO. 5
HOWARD COUNTY, MARYLAND.

SCALE: 1" = 50' DATE: NOV. 1992

REV. APR. 15, 1992


PREPARED BY:

THE J.E. CLARK COMPANY
LAND SURVEYING AND ENGINEERING

P.O. BOX 147 LAUREL, MARYLAND 20707
(301) 725 3442

THIS AREA DESIGNATES A PRIVATE SEWAGE EASEMENT OF 10,000 SQ. FT. AS REQUIRED BY THE MARYLAND DEPARTMENT OF THE ENVIRONMENT FOR INDIVIDUAL SEWAGE DISPOSAL IMPROVEMENTS OF ANY NATURE IN THIS AREA ARE RESTRICTED UNTIL PUBLIC SEWER IS AVAILABLE. THESE EASEMENTS SHALL BECOME NULL AND VOID UPON CONNECTION TO A PUBLIC SEWAGE SYSTEM. THE COUNTY HEALTH OFFICER SHALL HAVE THE AUTHORITY TO GRANT VARIANCES FOR ENCROACHMENTS INTO THE PRIVATE SEWAGE EASEMENT. RECORDED OF A MODIFIED SEWAGE EASEMENT PLAT SHALL NOT BE NECESSARY.

LOT 44

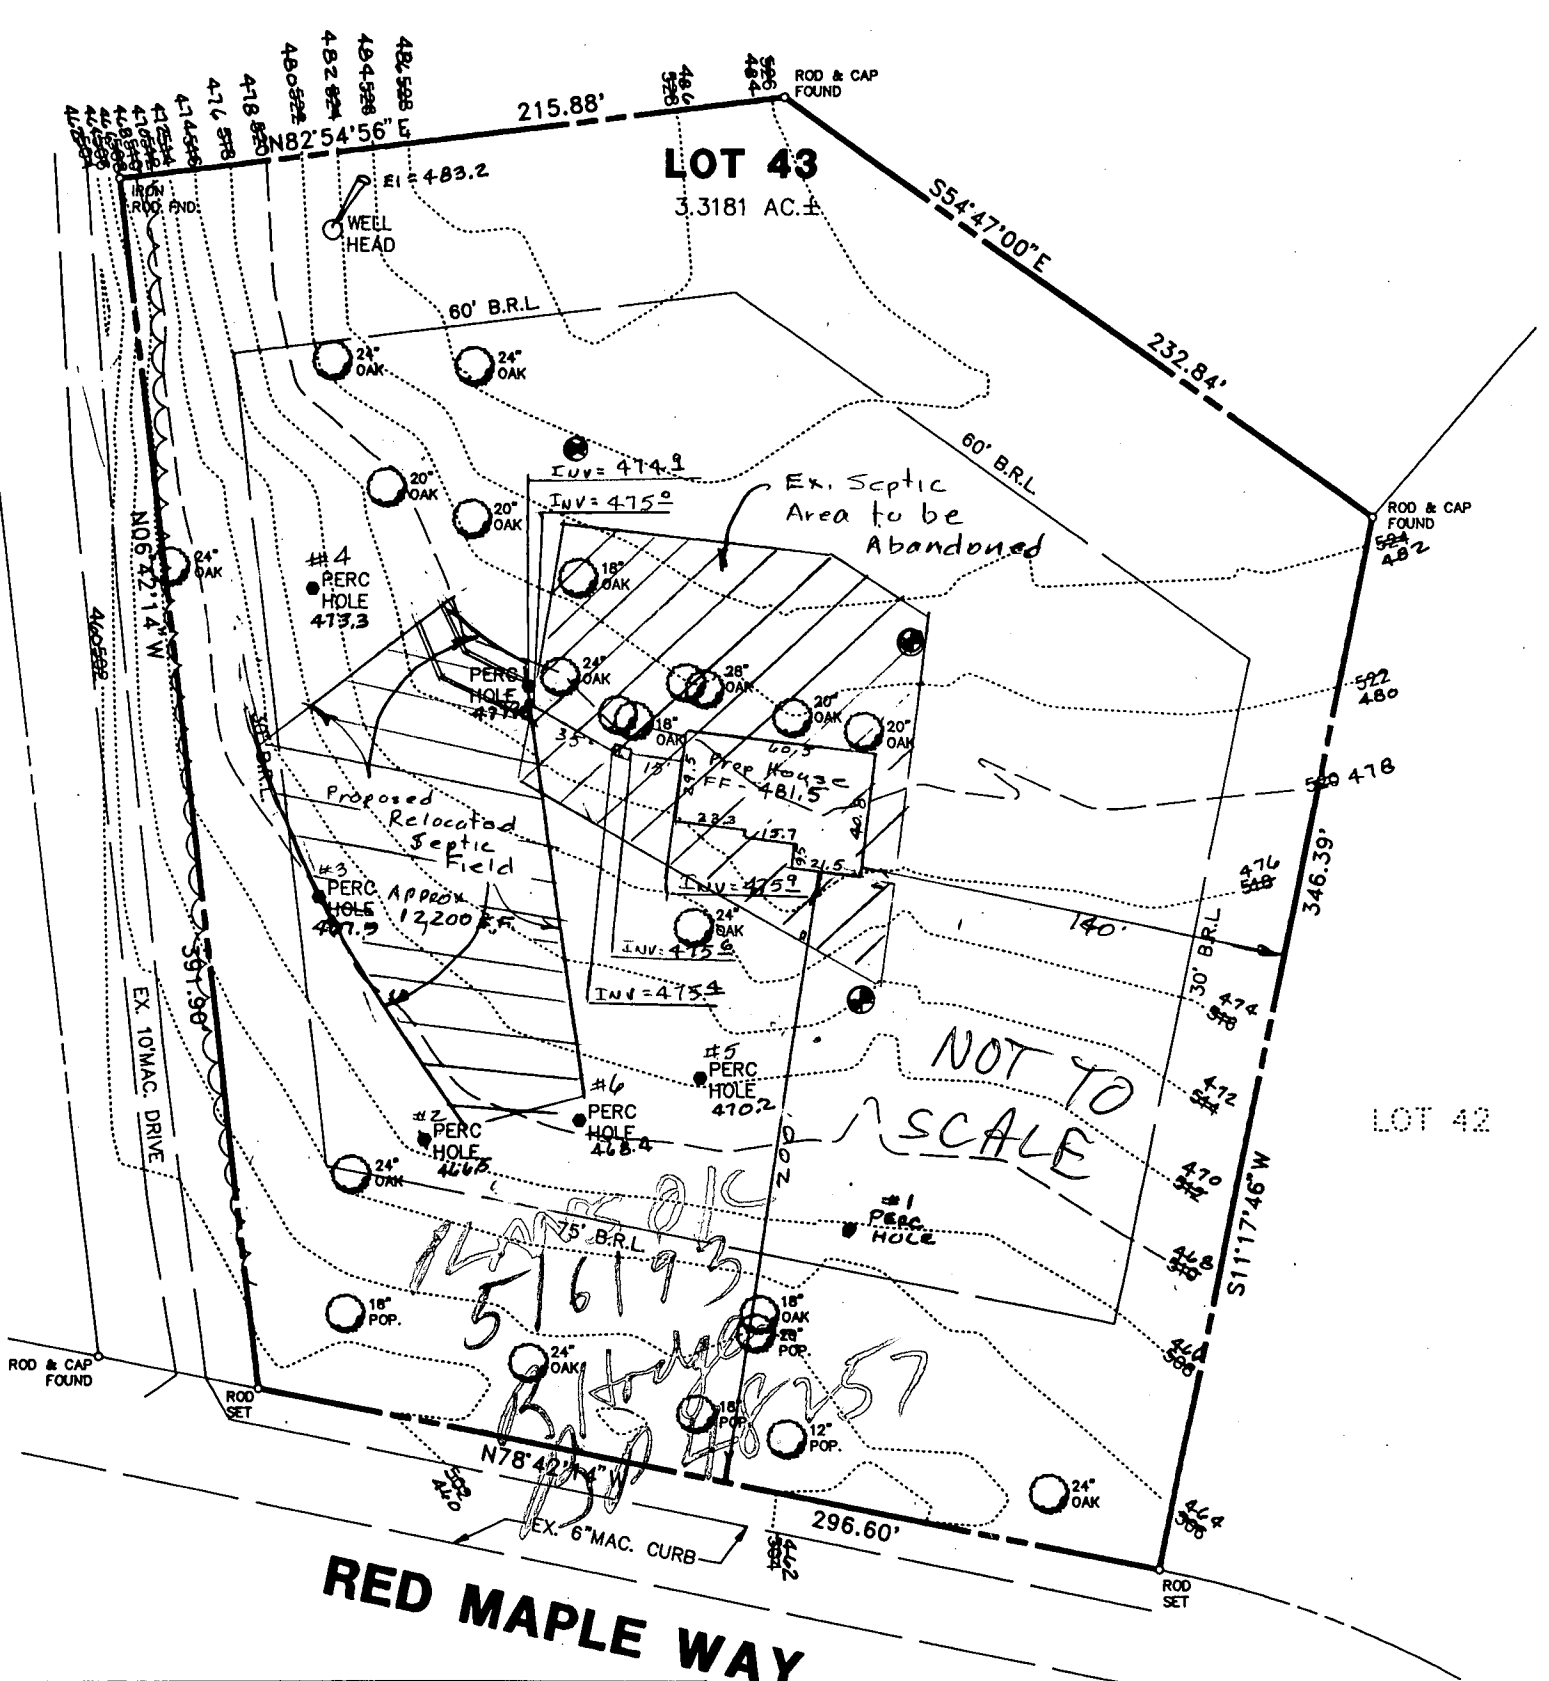

RED MAPLE WAY

APPROVED: For Private Water and Private Sewerage Systems
HOWARD COUNTY HEALTH DEPT.
Joseph M. Byrd
 COUNTY HEALTH OFFICER JUN 4-13-93
 DATE


Note: Length of pipes in septic field is to be determined at the time of permit issuance.

PLOT PLAN
LOT 43
TWELVE HILLS
SECTION 3

ELECTION DISTRICT NO. 5
 HOWARD COUNTY, MARYLAND.
 SCALE: 1" = 50' DATE: NOV. 1992

PREPARED BY:
THE J.E. CLARK COMPANY
 LAND SURVEYING AND ENGINEERING

P.O. BOX 147 LAUREL, MARYLAND 20707
 (301) 725 3442

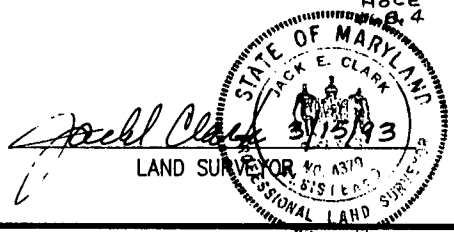

NOT TO SCALE

Handwritten notes:
 12" OAK
 5 16 19 3
 8 10 11 12 13 14 15 16 17 18 19 20 21 22 23 24 25 26 27 28 29 30 31 32 33 34 35 36 37 38 39 40 41 42 43 44 45 46 47 48 49 50 51 52 53 54 55 56 57

C1 2438

SEQUENCE NO. (DENV USE ONLY)

STATE OF MARYLAND WELL COMPLETION REPORT

THIS REPORT MUST BE SUBMITTED WITHIN 45 DAYS AFTER WELL IS COMPLETED.

(THIS NUMBER IS TO BE PUNCHED IN COLUMNS 3-6 ON ALL CARDS)

COUNTY NUMBER A 37902

DATE RECEIVED

DATE WELL COMPLETED 05/16/89

Depth of Well 225 (TO NEAREST FOOT)

PERMIT NO. FROM "PERMIT TO DRILL WELL" 40-88-0502

OWNER Altogether LTD Partnership last name Red Maple way first name TOWN Dayton SUBDIVISION Twelve Hills SECTION 3 LOT 43

WELL LOG Not required for driven wells STATE THE KIND OF FORMATIONS PENETRATED, THEIR COLOR, DEPTH, THICKNESS AND IF WATER BEARING

Table with columns: DESCRIPTION (Use additional sheets if needed), FEET (FROM, TO), Check if water bearing. Rows include Topsoil, Shale, MIKA, Sandstone, MIKA, Sandstone, MIKA.

GROUTING RECORD WELL HAS BEEN GROUTED (Circle Appropriate Box) TYPE OF GROUTING MATERIAL CEMENT CM BENTONITE CLAY BC NO. OF BAGS 23 NO. OF POUNDS 2300

CASING RECORD casing types insert appropriate code below MAIN CASING TYPE FL Nominal diameter top (main) casing (nearest inch) 63 Total depth of main casing (nearest foot) 66

OTHER CASING (if used) diameter inch depth (feet) from to

SCREEN RECORD screen type or open hole insert appropriate code below ST STEEL BR BRASS PL PLASTIC HO OPEN HOLE OT OTHER

DEPTH (nearest ft.) HOLE DEPTHS: 50, 160

CIRCLE APPROPRIATE LETTER A WELL WAS ABANDONED AND SEALED WHEN THIS WELL WAS COMPLETED E ELECTRIC LOG OBTAINED P TEST WELL CONVERTED TO PRODUCTION WELL

I HEREBY CERTIFY THAT THIS WELL HAS BEEN CONSTRUCTED IN ACCORDANCE WITH COMAR 10.17.13 "WELL CONSTRUCTION" AND IN CONFORMANCE WITH ALL CONDITIONS STATED IN THE ABOVE CAPTIONED PERMIT, AND THAT THE INFORMATION PRESENTED HEREIN IS ACCURATE AND COMPLETE TO THE BEST OF MY KNOWLEDGE.

DRILLERS IDENT. NO. 453 DRILLERS SIGNATURE Frank DeGiac SITE SUPERVISOR (sign. of driller or journeyman responsible for sitework if different from permittee)


SLOT SIZE 1 2 3 DIAMETER OF SCREEN (NEAREST INCH) 56 60

GRAVEL PACK IF WELL DRILLED WAS FLOWING WELL INSERT F IN BOX 68

OEP USE ONLY (NOT TO BE FILLED IN BY DRILLER) T (E.R.O.S.) WQ 70 72 74 75 76 TELESCOPE CASING LOG INDICATOR OTHER DATA

PUMPING TEST HOURS PUMPED (nearest hour) 3 PUMPING RATE (gal. per min. to-nearest gal.) 9 METHOD USED TO MEASURE PUMPING RATE WATER LEVEL (distance from land surface) BEFORE PUMPING 40 WHEN PUMPING 62 TYPE OF PUMP USED (for test) S submersible

PUMP INSTALLED DRILLER WILL INSTALL PUMP YES NO IF DRILLER INSTALLS PUMP, THIS SECTION MUST BE COMPLETED FOR ALL WELLS EXCEPT HOME USE TYPE OF PUMP INSTALLED PLACE (A,C,J,P,R,S,T,O) IN BOX - SEE ABOVE: CAPACITY: GALLONS PER MINUTE (to nearest gallon) PUMP HORSE POWER PUMP COLUMN LENGTH (nearest ft.) CASING HEIGHT (circle appropriate box and enter casing height) LAND SURFACE (nearest foot)

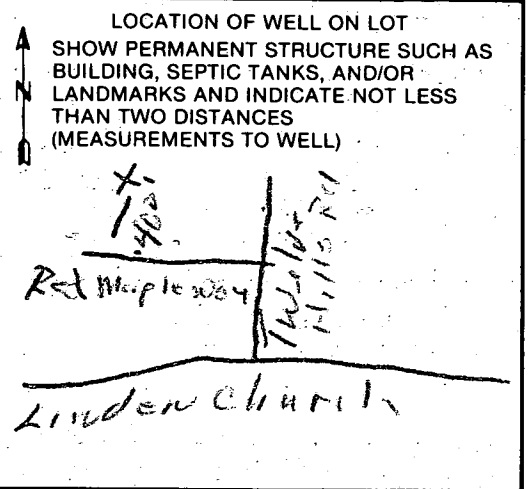

COUNTY