

4/18/91
10:00
13 COMPLAINT

PERMIT

#178849

P 47004

SEWAGE DISPOSAL SYSTEM

A REPAIR

DEPARTMENT OF HEALTH AND MENTAL HYGIENE

DISTRICT _____

HOWARD COUNTY HEALTH DEPARTMENT
BUREAU OF ENVIRONMENTAL HEALTH
461-9933

DATE 04/17/91

INDEXED

DATE SYSTEM APPROVED 4-23-91

INSPECTOR JEN

J. A Smith and Company, Inc. IS PERMITTED TO INSTALL ALTER X

ADDRESS 5918 Hunt Club Road, Elkridge, Maryland 21227 PHONE 796-7532

SUBDIVISION _____ LOT _____ ROAD 7915 Old Jessup Road

PROPERTY OWNER Ms. Verna Scheuer

ADDRESS _____

SEPTIC TANK CAPACITY _____ GALLONS

BRT 20 1500

NUMBER OF BEDROOMS _____

_____ SQUARE FEET PER BEDROOM

LINEAR FEET OF TRENCH REQUIRED _____

REPAIR - ~~UNCERTAIN ABOUT WHAT NEEDS TO BE DONE.~~ CALL FOR INSPECTION WHEN GROUND IS OPENED SO SANITARIAN CAN RECOMMEND REPAIR.

INSTALL 1500 GALLON HOLDING TANK,

NO SEPTIC REPAIR POSSIBLE, SURFACE SPRINGS THROUGHOUT PROPERTY,

4/18/91 [Signature]

PLANS APPROVED BY Craig Williams cm DATE 04/17/91

COVER NO WORK UNTIL INSPECTED AND APPROVED
NEITHER THE HOWARD COUNTY COUNCIL NOR THE HEALTH DEPARTMENT IS RESPONSIBLE FOR THE SUCCESSFUL OPERATION OF ANY SYSTEM

NOTE: CLEANOUT REQUIRED EVERY 70 FEET OF SEWER LINE AND/OR AT 90° SWEEPS IN LINES FROM HOUSE TO DRAIN FIELDS, 90° ELBOWS NOT ACCEPTABLE.

NOTE: ALL PARTS OF SEPTIC SYSTEMS (I.E. TANK, DISTRIBUTION BOX TRENCHES) TO BE 100 FEET FROM WELL (UNLESS OTHERWISE SPECIFICALLY AUTHORIZED)

NOTE: IF DEEP TRENCH(ES) ARE USED CALL FOR INSPECTION BEFORE AND AFTER PLACING GRAVEL IN TRENCH(ES)

NOTE: NO DRY WELL SHALL EXCEED 15 FOOT IN DIAMETER NO ABSORPTION TRENCH TO EXCEED 100 FEET IN LENGTH

NOTE: ALL PIPE FROM HOUSE TO SEPTIC TANK MUST BE CAST IRON OR SCHEDULE 35/40 PVC OR ABS

BLDG. PERMIT SIGNED AND RETURNED 3/31/94 Serial # 53247 - trailer temporary house fee

PERMIT VOID AFTER TWO YEARS

NOTE: INSTALL STAND PIPE ON SEPTIC TANK AND DRY WELL STAND PIPES MUST BE 6 INCHES IN DIAMETER CAST IRON. CONCRETE OR TERRA COTTA OR PVA OR ABS ACCEPTED. IF TOP OF SEPTIC TANK IS DEEPER THAN 3 FEET. MANHOLE TO GRADE REQUIRED.

NOTE: DISTRIBUTION BOXES MUST HAVE BAFFLES

***INSTALLER IS RESPONSIBLE FOR OBTAINING FINAL APPROVAL ON THIS PERMIT**

P 4/17/91



HOWARD COUNTY HEALTH DEPARTMENT

Joyce M. Boyd, M.D., County Health Officer
April 10, 1991

Reply to:

Mrs. Verna Scheuer
7915 Old Jessup Road
Jessup, Maryland 20794

Re: **NOTICE OF VIOLATION**
Overflowing Septic System
7915 Old Jessup Road

Dear Mrs. Scheuer:

On April 8, 1991, Duremea Buggs, Sanitarian from this office inspected your property known as Tax Map 43, Parcel 328, and located at 7915 Old Jessup Road, Jessup, Maryland in response to a report of an overflowing septic system. Ms. Duremea Buggs observed surface seepage in the vicinity of the septic tank near a stream.

This condition is in violation of Section 12.110 of the Howard County Code.

This property is in the metropolitan public service district, but available information suggests that the property is not accessible to public sewer. As the failing septic system creates a condition which is, or may be hazardous to the public health, you are hereby ordered to apply to this office for a septic system repair permit and effect repairs within fifteen (15) days of receipt of this letter. The cost of the septic repair permit is \$10.00. Until repairs are completed you must immediately (within 48 hours) have the septic tank and drywell contents pumped by a licensed sewage scavenger; and continue pumping, as often as necessary to prevent future sewage overflows.

If you believe that the condition described above is not and could not be a hazard to health, or that the Health Department is not acting in compliance with pertinent laws and regulations, you may request a formal hearing before the Board of Health within ten (10) days of receipt of this letter. If you wish to discuss the evidence, the regulations, or your individual circumstances, you are encouraged to request a meeting with us by calling 461-9933 and scheduling an appointment.

cont'd


- 2 -

The investigation of this complaint and the enforcement powers of the Health Department are set forth in Section 12 of the Howard County Code, a copy of which is available for your investigation at this office.

If you have any questions, please contact Ms. Duremea Buggs or myself at 461-9933.

Thank you for your cooperation in this matter.

Very truly yours,

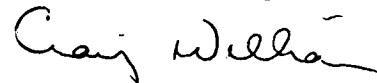


Craig Williams, Director
Water and Sewerage Program

CW/DB:cm

cc: Ms. Duremea Buggs
Mr. Richard D. Crawford
Department of Inspection, Licenses & Permits

File

Alan Smith
Hunt Club Rd
796 7532

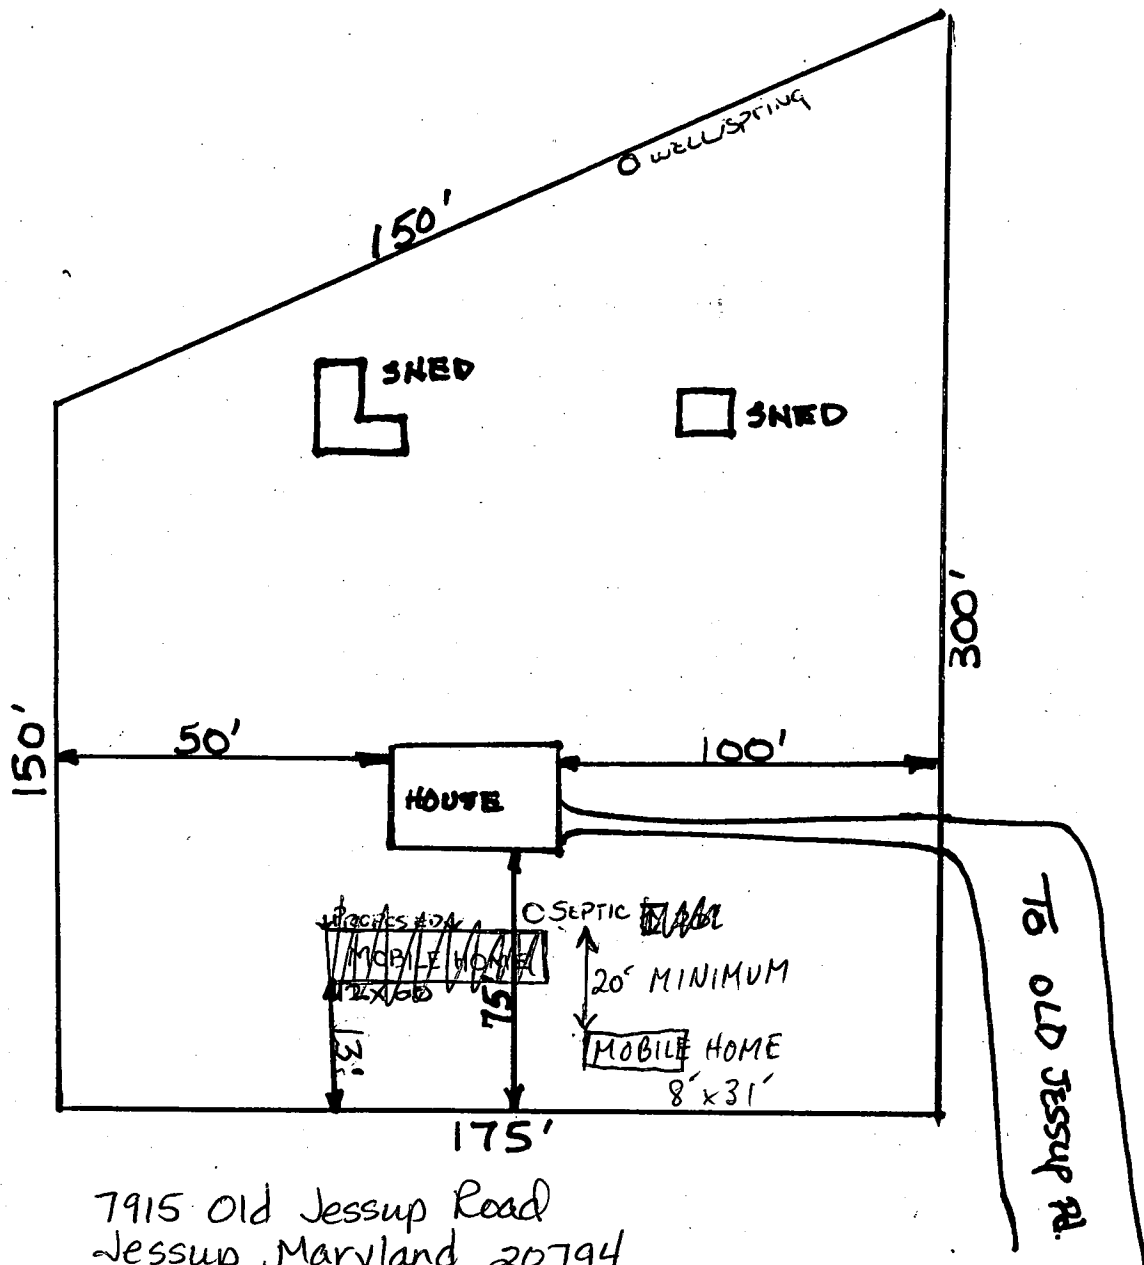

7915 Old Jessup Road
 Jessup, Maryland 20794

These measurements are
 true and correct to the
 best of my knowledge.

MARY E. SIMMONS
 Name

Mary E. Simmons 3/31/94
 Signature Date

Building Permit 53247

APPROVED DATE

BY

REGION _____

AREA _____ RATING _____

ACKNOWLEDGMENT AND CONTROLS	DATE

Howard County Department of Health
BUREAU OF ENVIRONMENTAL HEALTH

DISPOSITION	DATE

RECORD OF INVESTIGATION

LOCATION 7915 Old Gessup Rd., Gessup, Md. ZIP 20794

OWNER Mr. Vernon Schuman ADDRESS 7915 Old Gessup Rd. PHONE 799-3568

OCCUPANT _____ ADDRESS _____ PHONE _____

COMPLAINANT Unknown ADDRESS _____ PHONE _____

REASON FOR INVESTIGATION Septic system overflowing in rear by stream off rd property. During bad weather flows into a ditch and sent the top of septic tank CODES _____

RECEIVED BY Crystal Miller DATE 04/8/91 ASSIGNED TO Dixie Mae Buepp DATE 4-8-91

DATE OF INVESTIGATION 4-8-91 TIME 12:15 WEATHER warm/sunny

REPORT 4-8-91 ^{4:30} Occupants states Waterloo Sanitation was there in the winter to pump septic and notified them that in the spring they should do something about sunken septic with broken connections. Septic is overflowing with a narrow trench dug by occupant to relieve overflow. Property has a stream and lots of surface water in several areas.

4-12-91 Owner's son called to acknowledge receipt of violation letter. Inquire about procedure for repair. ^{Logged DB}

DATE SUBMITTED _____ SANITARIAN _____

REGION _____ AREA _____ RATING _____

ACKNOWLEDGMENT AND CONTROLS	DATE

Howard County Department of Health
BUREAU OF ENVIRONMENTAL HEALTH

DISPOSITION	DATE

RECORD OF INVESTIGATION

LOCATION 7915 Old Gessup Rd., Gessup, Md. ZIP 20794

OWNER Mo. Vernon Schuman ADDRESS 7915 Old Gessup Rd. PHONE 799-3568

OCCUPANT Unknown ADDRESS _____ PHONE _____

REASON FOR INVESTIGATION Septic system over flowing in rear by stream off of property. During bad weather flows into a ditch and out the top of septic tank CODES _____

RECEIVED BY Crystal Miller DATE 4/8/91 ASSIGNED TO Dorena Buapp DATE 4-8-91

DATE OF INVESTIGATION 4-8-91 TIME 12:15 WEATHER warm/sunny

REPORT 4-8-91 ^{2:30} Occupants states Waterloo Sanitation was there in the winter to pump septic and notified them that in the spring they should do something about sunken septic with broken connections. Septic is overflowing with a narrow trench dug by occupant to relieve overflow. Property has a stream and lots of surface water in several areas.

4-12-91 Owner's son called to acknowledge receipt of violation letter. Inquire about procedure for repair. ^{Logged} _{DTJ}

DATE SUBMITTED _____ SANITARIAN _____

SITE INSPECTION SHEET

OWNER: Verna Scheuer

DATE REQUESTED: 4-8-81

ADDRESS: 7915 Old Jessup Rd
Jessup Md 20794
Irving H. Scheuer, F. Wife
Tax map 43, p 328


DRILLER: _____

WELL TAG # _____

COUNTY # _____

PROPOSAL: Over-flowing septic Mrs. Scheuer states
Complaint she's a widow

LOCATION DIAGRAM

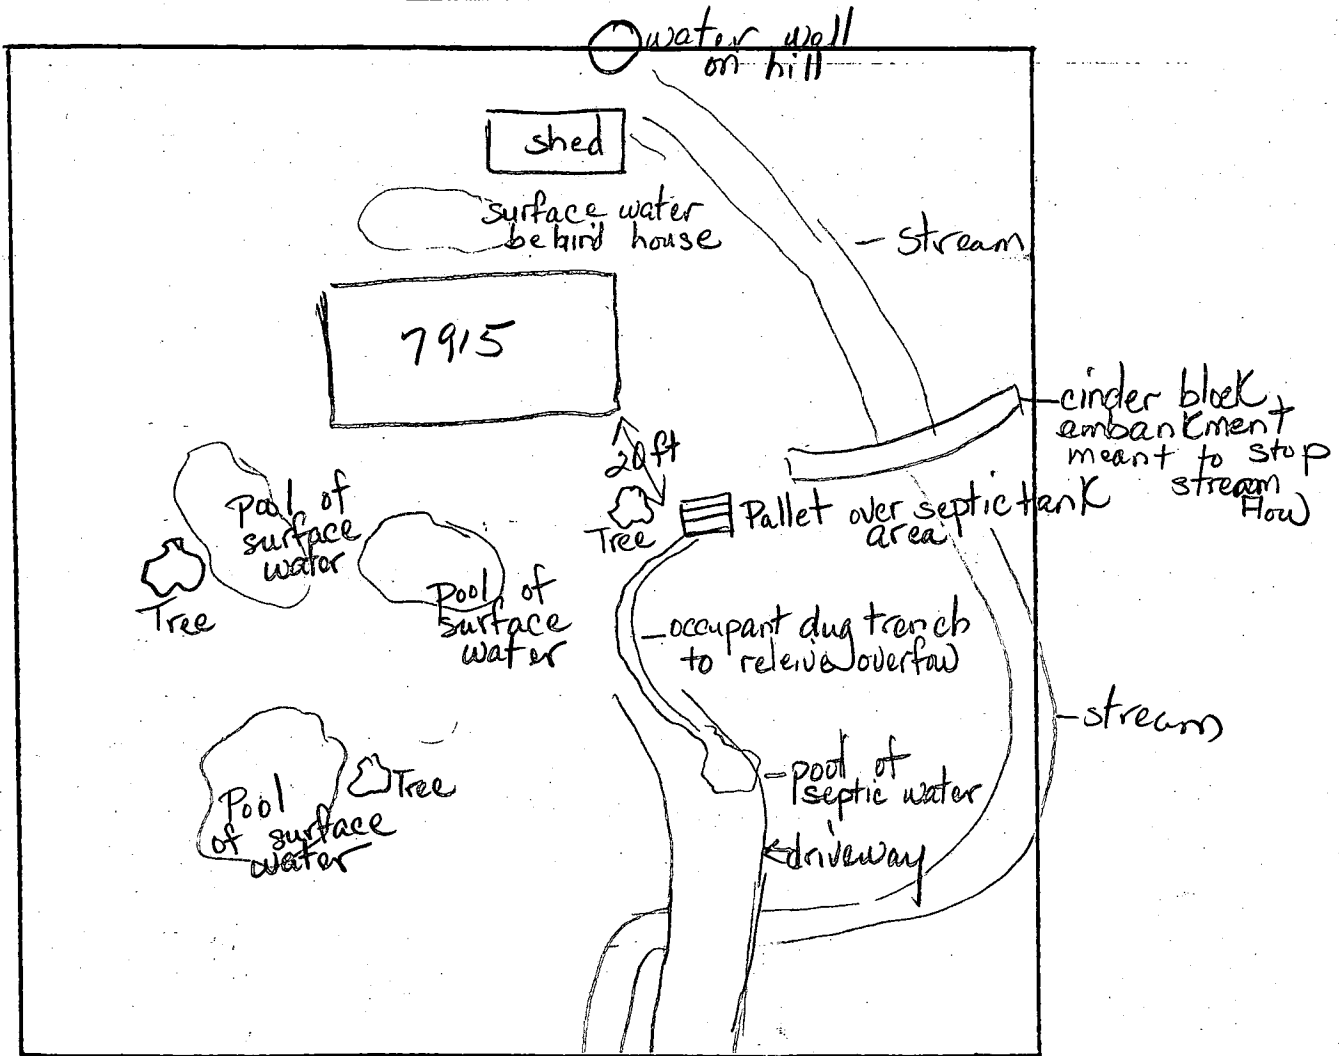

COMMENTS: 4-10-91 spoke to Jean Reed
Property has no R.O.W to allow
The house is lower than road and
is 400 to 550 ft off of Old Jessup
Road. JEN

Bureau of Engineering
connection to public sewer
cannot be sewerred. House
DB

DATE: 4-8-91

INSPECTOR: D. Buggy

HOLDING TANK EXEMPTION CERTIFICATE APPLICATION

Provide the following information in full and submit the completed application to:

Compliance Monitoring Coordinator
Little Patuxent Wastewater Treatment Plant
8900 Greenwood Place
Savage, Maryland 20763

APPLICANT'S NAME⁽¹⁾ Verna Scheuer

ADDRESS: 7915 Old Jessup Rd.

Jessup Md. 20794

TELEPHONE NO. 799 3568

HOLDING TANK SIZE 1500 GALLONS

Describe source(s) of waste discharged to holding tank:


Toilet & Kitchen -

Provide frequency at which holding tank is emptied by waste hauler (example: 1 time/week, 2 times/month, etc.) 1 to 2 times mo

Provide sketch below showing holding tank location:

EXAMPLE:

PUT YOUR SKETCH HERE:

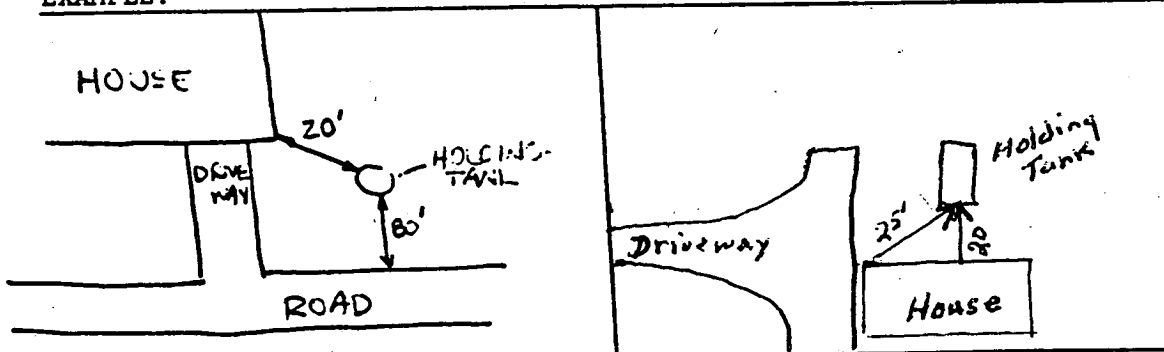

DO NOT WRITE BELOW THIS LINE

NOTES: (1) Applicant must be property owner.

APPROVED

_____ DENIED BY HEALTH DEPT., REVIEWER BJS

DATE 6/14/91

IF DENIED, STATE REASON _____

RECEIVED

JUN 4 1991

Little Patuxent Wastewater
Treatment Plant

APPLICATION

HOWARD COUNTY

PERMIT APPLICATION

DEPARTMENT OF INSPECTIONS, LICENSES & PERMIT
3430 COURT HOUSE DRIVE, ELLICOTT CITY, MARYLAND 21043

SERIAL NUMBER

53247

BUILDING ADDRESS (HOUSE NO., STREET, TOWN OR AREA)

7915 Old Jessup Road
Jessup, Md 20794

GRADING/SEDIMENT CONTROL YES NO

SDP #

DESCRIPTION OF WORK AUTHORIZED

TEMPORARY MOBILE HOME (12' x 16')
FOR FIRE DAMAGE DWELLING
TO REMOVE SFMH AFTER FIRE REPAIR
COMPLETED.

LOT NO.	PARCEL NO.	SEC.	AREA	BLOCK NO.	LIBER	FOLIO
N/A	328	N/A	N/A	22		
SUB DIVISION		ZONE	ZONE MAP	ELEC. DIST.	CENSUS TR.	
N/A		M-2	43	1	6012	

OWNER NAME AND ADDRESS PHONE NO.

MARY E. SIMMONS
7915 Old Jessup Rd 410 799 4351

OCCUPANT'S NAME AND ADDRESS PHONE NO.

OWNER -

ARCHITECT OR ENGINEER'S NAME AND ADDRESS PHONE NO.

NONE

CONTRACTOR'S NAME AND ADDRESS PHONE NO.

OWNER

EXISTING USE PROPOSED USE

SINGLE FAMILY HOME SAME WITH TEMP HOME

EST. CONSTRUCTION COST LICENSE NUMBER PERMIT FEE

200.00

W/S CODE FOR OFFICE USE ONLY

DISTRICT IN FEET FROM RW LINE TO FRONT BUILDING LINE

SIDE YARD (DISTANCE IN FEET FROM SIDE BLDG. LINE TO SIDE PROPERTY LINE)

TO SIDE BUILDING LINE DISTANCE IN FEET, REAR YD. REQUIRING SET

BACK (CORNER LOT ONLY) SDP #

Check payable to: DIRECTOR OF FINANCE OF HOWARD COUNTY

CAUTION

To begin construction before a permit placard has been issued and displayed on the job is a violation of the Law. Use and occupancy permit must be applied for two weeks before it will be issued.

IMPORTANT: PLEASE SHOW ZIP CODES AND AREA CODES WHEREVER REQUIRED.

SIZE OF BLDG.	FRONT	DEPTH	HEIGHT
TYPE OF BLDG.	AREA	VOLUME	ROOF
B. ROOMS			
ROOMS			
BATHS			
FIREPLACES			
FOOTINGS		FOUNDATION	S. WALLS

UTILITIES						
WATER	WELL	SEWER/SEPTIC	GAS	ELECTRICITY	TYPE OF HEAT	AC

I have carefully examined and read this application and know the same is true and correct, and that in doing this work, all provisions of Howard County Ordinances and the State Laws of Maryland will be complied with, whether specified or not; and I will notify the Department of Inspections, and Permits twenty-four hours in advance when I am ready for the inspections called for elsewhere in the application; and that no work will be covered up until such inspections have been complied with.

MARY E. SIMMONS

SIGNATURE

OWNER

TITLE

3/29/94

DATE

FUNCTION	DATE	SIGNATURE APPROVAL
ZONING/PLANNING		
SHA		
SEDIMENT/GRADING		
BUILDING OFFICIAL		
WATER & SEWER		
HEALTH DEPT.	3/31/94	Mark E. R. [Signature]
FIRE PROTECTION		
STORM WATER MGMT		

APPROVED

DATE