

5/10/91 ✓  
1 PM  
2:30

# PERMIT

*File*

{ 5/10 @ P.C.O. }  
C.B.

## SEWAGE DISPOSAL SYSTEM

### DEPARTMENT OF HEALTH AND MENTAL HYGIENE

P 47060

A REPAIR

DISTRICT \_\_\_\_\_

DATE 05/07/91

HOWARD COUNTY HEALTH DEPARTMENT  
BUREAU OF ENVIRONMENTAL HEALTH  
461-9933

*APC# ?*

DATE SYSTEM APPROVED 5/10/91

INDEXED

INSPECTOR C.B.

Waterloo Sanitation Service IS PERMITTED TO INSTALL \_\_\_\_\_ ALTER

ADDRESS 7311 Washington Blvd. Baltimore, Maryland 21227 PHONE 799-1942

SUBDIVISION \_\_\_\_\_ LOT \_\_\_\_\_ ROAD 10621 Gorman Road and Kindler

PROPERTY OWNER Mr. Gordon Winter

ADDRESS \_\_\_\_\_

SEPTIC TANK CAPACITY \_\_\_\_\_ GALLONS

NUMBER OF BEDROOMS \_\_\_\_\_

\_\_\_\_\_ SQUARE FEET PER BEDROOM

LINEAR FEET OF TRENCH REQUIRED \_\_\_\_\_

REPAIR - TO REPLACE SEPTIC TANK. ~~CALL FOR INSPECTION WHEN GROUND IS OPENED SO SANITARIAN~~  
~~CAN RECOMMEND REPAIR.~~

*Early*  
① 5/10/91 P.M. ← New septic tank, 1000 gallon, in  
at-site place; installer to add a new dist. box for (3)  
septic lines at far end of tank from house.  
② "Late" P.M. - see back C.B. for

PLANS APPROVED BY Craig Williams cm DATE 05/07/91

COVER NO WORK UNTIL INSPECTED AND APPROVED

NEITHER THE HOWARD COUNTY COUNCIL NOR THE HEALTH DEPARTMENT IS RESPONSIBLE FOR THE SUCCESSFUL OPERATION OF ANY SYSTEM

NOTE: CLEANOUT REQUIRED EVERY 70 FEET OF SEWER LINE AND/OR AT 90° SWEEPS IN LINES FROM HOUSE TO DRAIN FIELDS, 90° ELBOWS NOT ACCEPTABLE.

NOTE: ALL PARTS OF SEPTIC SYSTEMS (I.E. TANK, DISTRIBUTION BOX TRENCHES) TO BE 100 FEET FROM WELL (UNLESS OTHERWISE SPECIFICALLY AUTHORIZED)

NOTE: IF DEEP TRENCH(ES) ARE USED CALL FOR INSPECTION BEFORE AND AFTER PLACING GRAVEL IN TRENCH(ES)

NOTE: NO DRY WELL SHALL EXCEED 15 FOOT IN DIAMETER NO ABSORPTION TRENCH TO EXCEED 100 FEET IN LENGTH

NOTE: ALL PIPE FROM HOUSE TO SEPTIC TANK MUST BE CAST IRON OR SCHEDULE 35/40 PVC OR ABS


PERMIT VOID AFTER TWO YEARS

NOTE: INSTALL STAND PIPE ON SEPTIC TANK AND DRY WELL STAND PIPES MUST BE 6 INCHES IN DIAMETER CAST IRON. CONCRETE OR TERRA COTTA OR PVA OR ABS ACCEPTED. IF TOP OF SEPTIC TANK IS DEEPER THAN 3 FEET. MANHOLE TO GRADE REQUIRED.

NOTE: DISTRIBUTION BOXES MUST HAVE BAFFLES

**\*INSTALLER IS RESPONSIBLE FOR OBTAINING FINAL APPROVAL ON THIS PERMIT**

47060

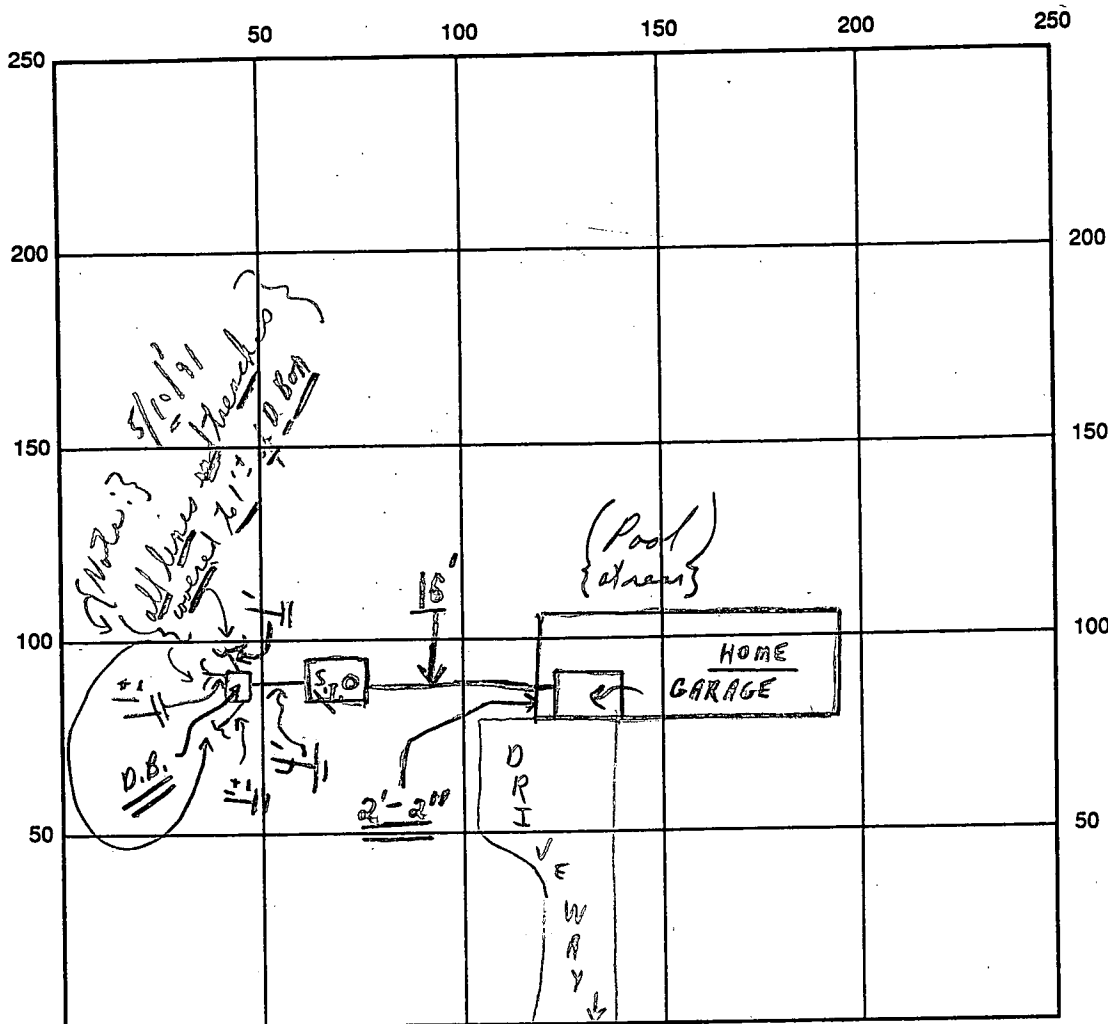

INDICATE NORTH - NAME ADJOINING ROADWAY AS BASE LINE

GORMAN ROAD

S.T.

SEPTIC TANK LEVEL OK (1000 gallons) CLEANOUTS OK

DISTRIBUTION BOX LEVEL New OK (Baffles in)

DRAIN FIELD/TITLE DEPTH      FT. TRENCH WIDTH      FT. INLET DEPTH (3'-3 1/2' FT.)

EFFECTIVE GRAVEL DEPTH      FT. TOTAL LENGTH      FT.

NUMBER OF TRENCHES      ONE SIDEWALL/BOTTOM AREA      SQ. FT.

DRYWALL INSIDE DIAMETER      FT. EFFECTIVE DEPTH BELOW INLET      FT.

ABSORBENT AREA      SQ. FT.

REMARKS: (Early P.M.) 5/10/91 ① Partial; ok to covers from home to septic tank, only; old metal tank - collapsed & on surface of ground; ② 5/10 late p.m. - distribution box in and connections being made to septic lines - final ok to cover all work as finish. (Note Public Water)

DATE SYSTEM APPROVED 5/10/91 INSPECTOR Charles Byron Street