

# PERMIT

## SEWAGE DISPOSAL SYSTEM

### DEPARTMENT OF HEALTH AND MENTAL HYGIENE

*File*

P 47091

A REPAIR

DISTRICT \_\_\_\_\_

DATE 5/16/91

DATE SYSTEM APPROVED 5/17/91

INSPECTOR C.B.D.

HOWARD COUNTY HEALTH DEPARTMENT  
BUREAU OF ENVIRONMENTAL HEALTH  
461-9933

# INDEXED

*APR#?*

Herman Sirk IS PERMITTED TO INSTALL \_\_\_\_\_ ALTER X

ADDRESS 2555 Jennings Chapel Road, Woodbine, Maryland 21797 PHONE 489-4724

SUBDIVISION \_\_\_\_\_ LOT \_\_\_\_\_ ROAD 16483 A. E. Mullinix Road

PROPERTY OWNER F. C. Dale

ADDRESS 16483 A. E. Mullinix Road  
Woodbine, Maryland 21797

SEPTIC TANK CAPACITY 1000 GALLONS

NUMBER OF BEDROOMS 3

125 SQUARE FEET PER BEDROOM } (375) = New Trench and old Dry Well

LINEAR FEET OF TRENCH REQUIRED \_\_\_\_\_ (?)

REPAIR - PURPOSE - SEPTIC SYSTEM HAS FAILED (25 years old).  
CALL FOR INSPECTION WHEN GROUND IS OPENED SO SANITARIAN CAN RECOMMEND REPAIR.


*5/15/91 Om* → Trench - dup 61' ± Long; 11' ± off. of (dry well).  
Trench - 2' sides, depth 9' average. 6' of stone in trench under pipes; 366' left in trench and old dry well.  
(C. B. D. for)

PLANS APPROVED BY C. Williams, / M. Rifkin DATE 5/15/91

- COVER NO WORK UNTIL INSPECTED AND APPROVED
- NEITHER THE HOWARD COUNTY COUNCIL NOR THE HEALTH DEPARTMENT IS RESPONSIBLE FOR THE SUCCESSFUL OPERATION OF ANY SYSTEM
- NOTE: CLEANOUT REQUIRED EVERY 70 FEET OF SEWER LINE AND/OR AT 90° SWEEPS IN LINES FROM HOUSE TO DRAIN FIELDS, 90° ELBOWS NOT ACCEPTABLE.
- NOTE: ALL PARTS OF SEPTIC SYSTEMS (I.E. TANK, DISTRIBUTION BOX TRENCHES) TO BE 100 FEET FROM WELL (UNLESS OTHERWISE SPECIFICALLY AUTHORIZED)
- NOTE: IF DEEP TRENCH(ES) ARE USED CALL FOR INSPECTION BEFORE AND AFTER PLACING GRAVEL IN TRENCH(ES)
- NOTE: NO DRY WELL SHALL EXCEED 15 FOOT IN DIAMETER NO ABSORPTION TRENCH TO EXCEED 100 FEET IN LENGTH
- NOTE: ALL PIPE FROM HOUSE TO SEPTIC TANK MUST BE CAST IRON OR SCHEDULE 35/40 PVC OR ABS
- PERMIT VOID AFTER TWO YEARS
- NOTE: INSTALL STAND PIPE ON SEPTIC TANK AND DRY WELL STAND PIPES MUST BE 6 INCHES IN DIAMETER CAST IRON. CONCRETE OR TERRA COTTA OR PVA OR ABS ACCEPTED. IF TOP OF SEPTIC TANK IS DEEPER THAN 3 FEET. MANHOLE TO GRADE REQUIRED.
- NOTE: DISTRIBUTION BOXES MUST HAVE BAFFLES

**\*INSTALLER IS RESPONSIBLE FOR OBTAINING FINAL APPROVAL ON THIS PERMIT**  
\*CALL 461-9933 FOR INSPECTION OF SEPTIC SYSTEM.

*P 47091*

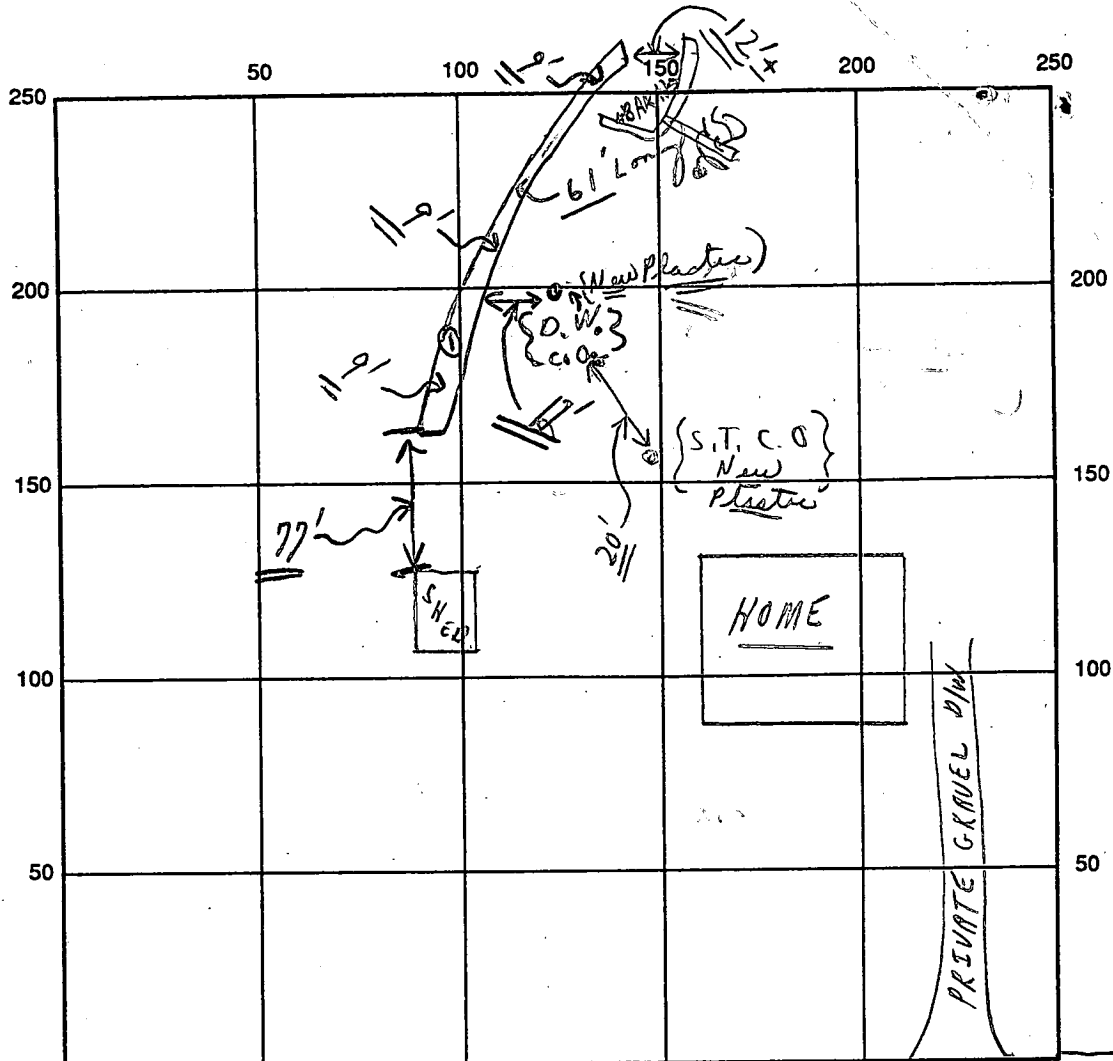

INDICATE NORTH - NAME ADJOINING ROADWAY AS BASE LINE

A. E. Mullinix →

SEPTIC TANK LEVEL Existing CLEANOUTS Existing / C.O.  
 DISTRIBUTION BOX LEVEL Using old dry well  
 DRAIN FIELD/TITLE DEPTH 9 (average) FT. TRENCH WIDTH 2 FT. INLET DEPTH 3'± FT.  
 EFFECTIVE GRAVEL DEPTH 6<sup>+</sup> average FT. TOTAL LENGTH 61 FT.  
 NUMBER OF TRENCHES 1 ONE SIDEWALL/BOTTOM AREA 366 SQ. FT. + {old drywell}  
 DRYWALL INSIDE DIAMETER — FT. EFFECTIVE DEPTH BELOW INLET — FT.

ABSORBENT AREA 366<sup>+</sup> SQ. FT.

REMARKS: NOON → 5/16/91 Partial - ok to continue on trench  
off dry well 5/16/91 late P.M. → left permit card - note  
trench not complete - {HOLD FOR A CALL} C.B.C.; 5/17/91 after lunch  
5/17/91 OK TO COVER ALL WORK - FINAL  
 C.B.C.

DATE SYSTEM APPROVED 5/17/91 INSPECTOR Charles Egan, Streets

9/26/68

app 9-26-68

# PERMIT

P 13849

SEWAGE DISPOSAL SYSTEM

A 13831

MARYLAND STATE DEPARTMENT OF HEALTH

HOWARD COUNTY

ELLICOTT CITY

DISTRICT 4

## INDEXED

DATE 8/19/68

Benjamin F. Slagle & Herman Sirk IS PERMITTED TO INSTALL  ALTER

ADDRESS Rt. 2 Woodbine, Maryland PHONE HU 9-4970

A SEWAGE DISPOSAL SYSTEM LOCATED AT

SUBDIVISION \_\_\_\_\_ ROAD <sup>16483</sup> A. E. Mullinix Rd. LOT \_\_\_\_\_  
(see application for better directions)

PROPERTY OWNER Benjamin F. Slagle

ADDRESS trailer removed

SPECIFICATIONS - 2 or 3 bedrooms

DRAIN FIELD \_\_\_\_\_ DEPTH \_\_\_\_\_ FEET, BOTTOM AREA \_\_\_\_\_ SQ. FT. septic system

SEEPAGE PITS \_\_\_\_\_ ABSORBENT SIDE-WALL AREA \_\_\_\_\_ SQ. FT.

SEPTIC TANK CAPACITY 750 GALLONS

FOR GARBAGE GRINDER, INCREASE DISPOSAL AREA 22% & TANK CAPACITY 50%.

OTHER Dry well - 429 sq. ft. absorbent sidewall area below inlet pipe.

Max. depth permitted for dry well is 13 ft. below original grade.

Place dry well at point 39 ft. off left rear corner of barn as seen when

facing from driveway.

PERMIT VOID AFTER THREE YEARS.


PLANS APPROVED BY D. W. Monaghan DATE 8/16/68

FILL SEPTIC TANK AND DISTRIBUTION BOX WITH WATER BEFORE CALLING FOR AN INSPECTION. COVER NO WORK UNTIL INSPECTED AND APPROVED.

NEITHER THE HOWARD COUNTY COMMISSIONERS NOR THE HEALTH DEPARTMENT IS RESPONSIBLE FOR THE SUCCESSFUL OPERATION OF ANY SYSTEM.

### NOTIFY THE HEALTH DEPARTMENT 48 HOURS BEFORE EXCAVATIONS ARE TO BE BACK FILLED.

13831

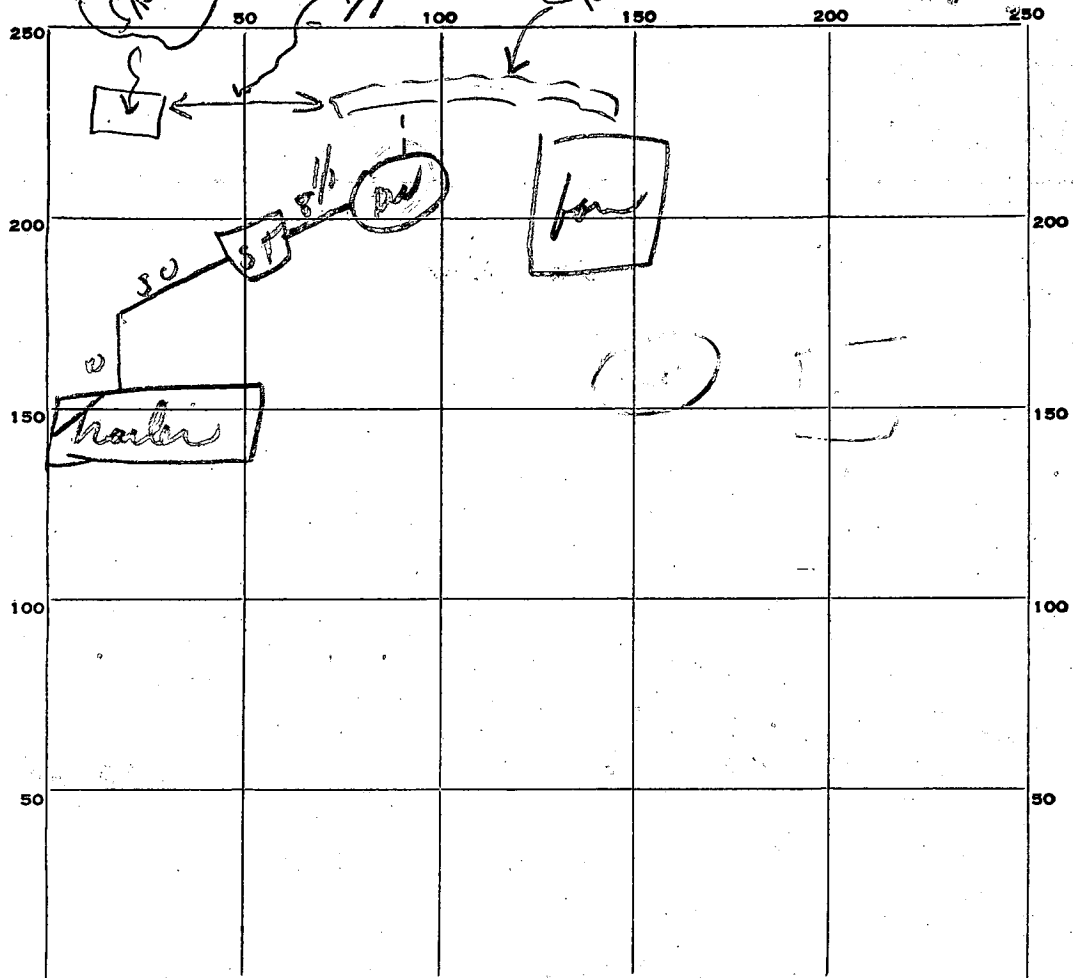

INDICATE NORTH. - NAME ADJOINING ROADWAY AS BASE LINE.

PERMIT CARD OK

SEPTIC TANK, LEVEL OK CLEANOUTS OK

DISTRIBUTION BOX, LEVEL \_\_\_\_\_

TILE FIELD, DEPTH \_\_\_\_\_ FT. TRENCH WIDTH \_\_\_\_\_ FT.

GRAVEL DEPTH \_\_\_\_\_ IN. TOTAL LENGTH \_\_\_\_\_ FT.

NUMBER OF TRENCHES \_\_\_\_\_ TOTAL BOTTOM AREA \_\_\_\_\_

SEEPAGE PITS, ~~INSIDE DIAMETER~~ permit 54 FT. DEPTH BELOW INLET 8 1/2 FT.

ABSORBENT AREA 459 SQ. FT.

REMARKS 5/16/91 S.D.W. C.O. & S.T. C.O. underground - 5/17 above ground  
(dgrade)

DATE SYSTEM APPROVED 9/20/68 INSPECTOR Dev. Mores

# APPLICATION

SEWAGE DISPOSAL TESTING

MARYLAND STATE DEPARTMENT OF HEALTH

HOWARD COUNTY

ELLICOTT CITY

DISTRICT 4

DATE 8/12/68

A 13831

P \_\_\_\_\_

TO: THE COUNTY HEALTH OFFICER  
ELLICOTT CITY, MARYLAND

I, HEREBY, APPLY FOR THE NECESSARY TESTS IN ORDER TO CONSTRUCT (OR RECONSTRUCT) A SEWAGE DISPOSAL SYSTEM.

PROPERTY OWNER Benjamin F. Slagle

ADDRESS Rt. 2 - Woodbine, Maryland PHONE HO 9-4970

PROPERTY LOCATION:

SUBDIVISION \_\_\_\_\_ LOT NO. \_\_\_\_\_

ROAD AND DESCRIPTION A. E. Mullinix Road - Rt. 94 to A. E. Mullinix Road -  
7/10 mile in - 2nd farm on right

OCCUPANT \_\_\_\_\_ PHONE \_\_\_\_\_

PERSON TO CONSTRUCT SYSTEM \_\_\_\_\_

ADDRESS \_\_\_\_\_ PHONE \_\_\_\_\_

SIZE OF LOT 115 acres TYPE BLDG. Trailer  
2 or 3  
NUMBER OF BEDROOMS

IF NOT SINGLE RESIDENCE DESCRIBE \_\_\_\_\_

SIGNATURE OF APPLICANT Benjamin F. Slagle

✓ APPROVED BY [Signature] FOR [Signature] DATE 8/16/68  
(KIND OF SYSTEM)


REJECTED BY \_\_\_\_\_ FOR \_\_\_\_\_ DATE \_\_\_\_\_  
(KIND OF SYSTEM)

HOLD PENDING FURTHER TESTS \_\_\_\_\_ DATE \_\_\_\_\_

REASONS FOR REJECTION OR HOLDING \_\_\_\_\_

# THIS IS NOT A PERMIT

Trailer permit signed & returned  
8/19/68

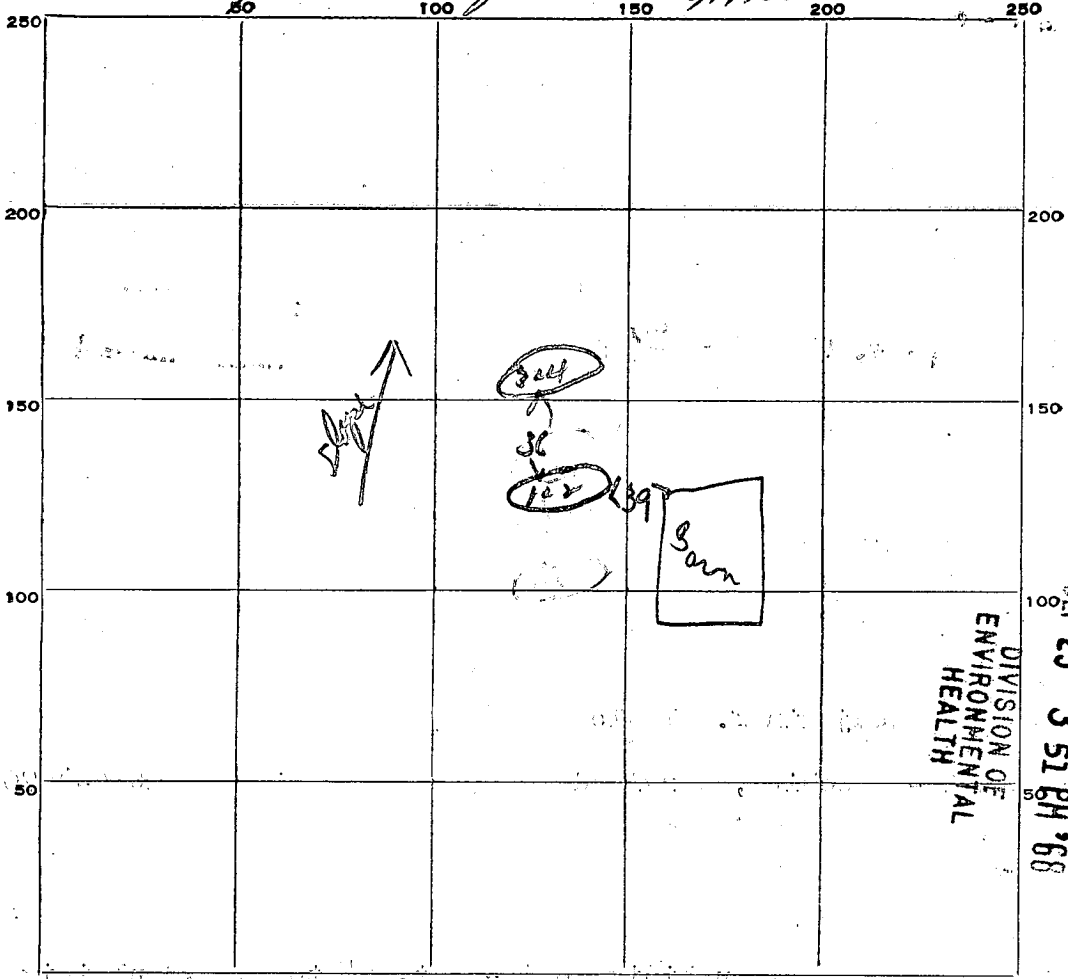

RECEIVED  
HOWARD COUNTY  
HEALTH DEPT.

SEP 25 3 51 PM '68

INDICATE NORTH. - NAME ADJOINING ROADWAY AS BASE LINE.

DATE	TEST NO.	DEPTH	PRE-WET		TEST - 1" DROP		TIME
			START	STOP	START	STOP	
8/19/68	1	10ft	9 13	9 20	9 20	9 36	16 min
	2	4ft	9 14	9 21	9 21	9 35	14 min
	3	10ft	9 17	9 18	9 18	9 20	2 min
	4	4ft	9 18	9 25	9 25	9 38	13 min

SOIL AUGER FINDING \_\_\_\_\_

TESTED BY DJM

REMARKS also present - Adman on site