

6/2/70
9:30
Lx tests

Good for
Brown - Report -

APPLICATION

A 15213

SEWAGE DISPOSAL TESTING

P

Chryles will be on Carr's Mill Rd. at the entrance of
MARYLAND STATE DEPARTMENT OF HEALTH

HOWARD COUNTY

ELLICOTT CITY

Septic Tank - 100 gal.

DISTRICT 4

DATE 5/8/70

Dry Well - Digg 15 ft sq. (5 at back vty in center for 12 ft diameter & fill in rest of pit with gravel. Dry Well to be 8 ft diam below the first 4 ft of soil above level of ground. Wet well permitted for Dry Well in the first 4 ft of soil above level of ground. Wet well - used 10 ft diameter & 8 ft deep below the first 4 ft of soil above level of ground.

Place Dry Well about 115 ft in front of the left front corner of house as shown on drawing from Carr's Mill Rd.

TO: THE COUNTY HEALTH OFFICER
ELLICOTT CITY, MARYLAND

If 2 dry wells are used - place first dry well about 115 ft in front of the left front corner of house as shown on drawing from Carr's Mill Rd. & second dry well 36 ft to the right of the first dry well. Dry wells must be 3 times diameter area of wet well.

I, HEREBY, APPLY FOR THE NECESSARY TESTS, IN ORDER TO CONSTRUCT (OR RECONSTRUCT) A SEWAGE DISPOSAL SYSTEM.

PROPERTY OWNER

Harold Stewart Cain, Jr.

ADDRESS 5719 Berwyn Road, Berwyn Heights, Maryland PHONE 474-5719

PROPERTY LOCATION:

SUBDIVISION _____ LOT NO. _____

ROAD AND DESCRIPTION Carr's Mill Rd. - 6/10 mile off Rt. 144 to test area.

OCCUPANT _____ PHONE _____

PERSON TO CONSTRUCT SYSTEM _____

ADDRESS _____ PHONE _____

SIZE OF LOT 18.498 acres TYPE BLDG. 3

NUMBER OF BEDROOMS

IF NOT SINGLE RESIDENCE DESCRIBE (Single Fmly. Dwllg.)

SIGNATURE OF APPLICANT *Harold Stewart Cain Jr.*

APPROVED BY *Will Warren Lan* FOR *Dry Well* DATE 6-2-70
(KIND OF SYSTEM)

REJECTED BY _____ FOR _____ DATE _____
(KIND OF SYSTEM)


HOLD PENDING FURTHER TESTS _____ DATE _____

REASONS FOR REJECTION OR HOLDING _____

THIS IS NOT A PERMIT

EISEL A

30
11
E

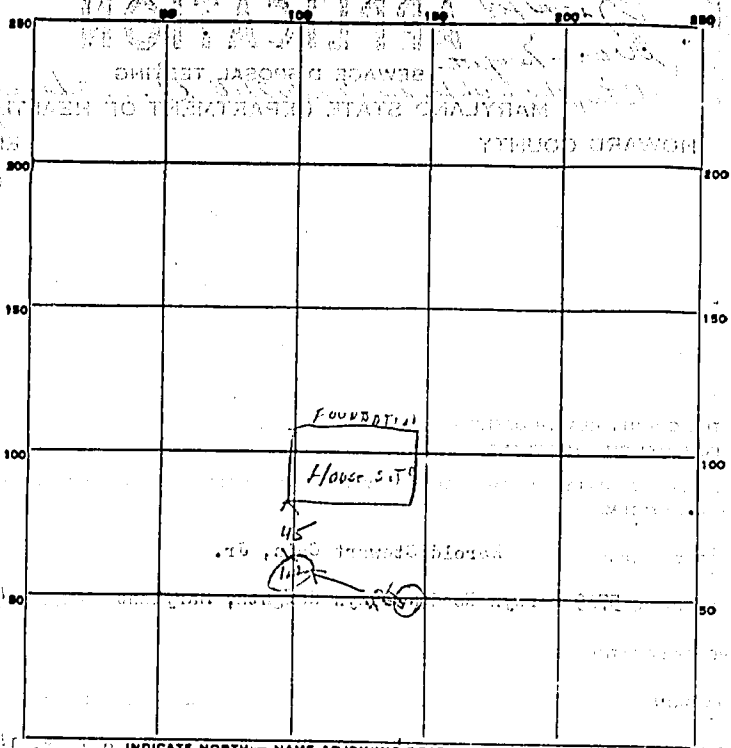

INDICATE NORTH - NAME ADJOINING ROADWAY AS BASE LINE.

DATE	TEST NO.	DEPTH	PRE-WET		TEST - 1" DROP		TIME
			START	STOP	START	STOP	
6-2-70	1	9.0'	9 41	9 44	9 44	9 51	6 min
	2	8 1/2'	9 41	9 44	9 44	9 51	
	3	4.0'	9 51	9 54	9 54	10 02	
	4	1.0'	9 51	9 54	9 54	10 02	8 min

SOIL AUGER FINDING _____

TESTED BY Dam

REMARKS _____

TRUMAN A TOWN OF CHINA