

3/5/91
12 Noon
(LATE P.M.)

PERMIT

File #328442

SEWAGE DISPOSAL SYSTEM

P 47112

DEPARTMENT OF HEALTH AND MENTAL HYGIENE

A REPAIR

DISTRICT _____

HOWARD COUNTY HEALTH DEPARTMENT

DATE 5/20/91

BUREAU OF ENVIRONMENTAL HEALTH

DATE SYSTEM APPROVED 3/5/91

461-9933

INDEXED

INSPECTOR C.B.D.

Jack Fyock IS PERMITTED TO INSTALL _____ ALTER X

ADDRESS TEN OAKS ROAD PHONE 988-9270

SUBDIVISION _____ LOT _____ ROAD 14414 Dorsey Mill Road

PROPERTY OWNER Speaks

ADDRESS 14414 Dorsey Mill Road
Glenwood, Maryland 21738

SEPTIC TANK CAPACITY 1000 GALLONS (NEW)

NUMBER OF BEDROOMS 3

_____ SQUARE FEET PER BEDROOM

LINEAR FEET OF TRENCH REQUIRED _____

REPAIR - PURPOSE - REPLACEMENT OF COLLASPE METAL SEPTIC TANK WITH A CONCRETE TANK.

3/5/91 NOON - "NO TANK" C.B.D. + D.B./C.B.D.

3/5/91 T/C (@ 2:00) (to Wanda) 3 Not delivered yet.

3/5/91 T/C @ 2:40 (to Jack) ready for inspection C.B.D.


3/5/91 LATE P.M. TANK & LINES COMPLETE. (SEE BACK) AT SITE. C.B.D.

PLANS APPROVED BY C. Williams DATE 3/05/91

- COVER NO WORK UNTIL INSPECTED AND APPROVED
- NEITHER THE HOWARD COUNTY COUNCIL NOR THE HEALTH DEPARTMENT IS RESPONSIBLE FOR THE SUCCESSFUL OPERATION OF ANY SYSTEM
- NOTE: CLEANOUT REQUIRED EVERY 70 FEET OF SEWER LINE AND/OR AT 90° SWEEPS IN LINES FROM HOUSE TO DRAIN FIELDS, 90° ELBOWS NOT ACCEPTABLE.
- NOTE: ALL PARTS OF SEPTIC SYSTEMS (I.E. TANK, DISTRIBUTION BOX TRENCHES) TO BE 100 FEET FROM WELL (UNLESS OTHERWISE SPECIFICALLY AUTHORIZED)
- NOTE: IF DEEP TRENCH(ES) ARE USED CALL FOR INSPECTION BEFORE AND AFTER PLACING GRAVEL IN TRENCH(ES)
- NOTE: NO DRY WELL SHALL EXCEED 15 FOOT IN DIAMETER NO ABSORPTION TRENCH TO EXCEED 100 FEET IN LENGTH
- NOTE: ALL PIPE FROM HOUSE TO SEPTIC TANK MUST BE CAST IRON OR SCHEDULE 35/40 PVC OR ABS
- PERMIT VOID AFTER TWO YEARS
- NOTE: INSTALL STAND PIPE ON SEPTIC TANK AND DRY WELL STAND PIPES MUST BE 6 INCHES IN DIAMETER CAST IRON, CONCRETE OR TERRA COTTA OR PVA OR ABS ACCEPTED. IF TOP OF SEPTIC TANK IS DEEPER THAN 3 FEET. MANHOLE TO GRADE REQUIRED.
- NOTE: DISTRIBUTION BOXES MUST HAVE BAFFLES

***INSTALLER IS RESPONSIBLE FOR OBTAINING FINAL APPROVAL ON THIS PERMIT**
*CALL 461-9933 FOR INSPECTION OF SEPTIC SYSTEM.

P 47112

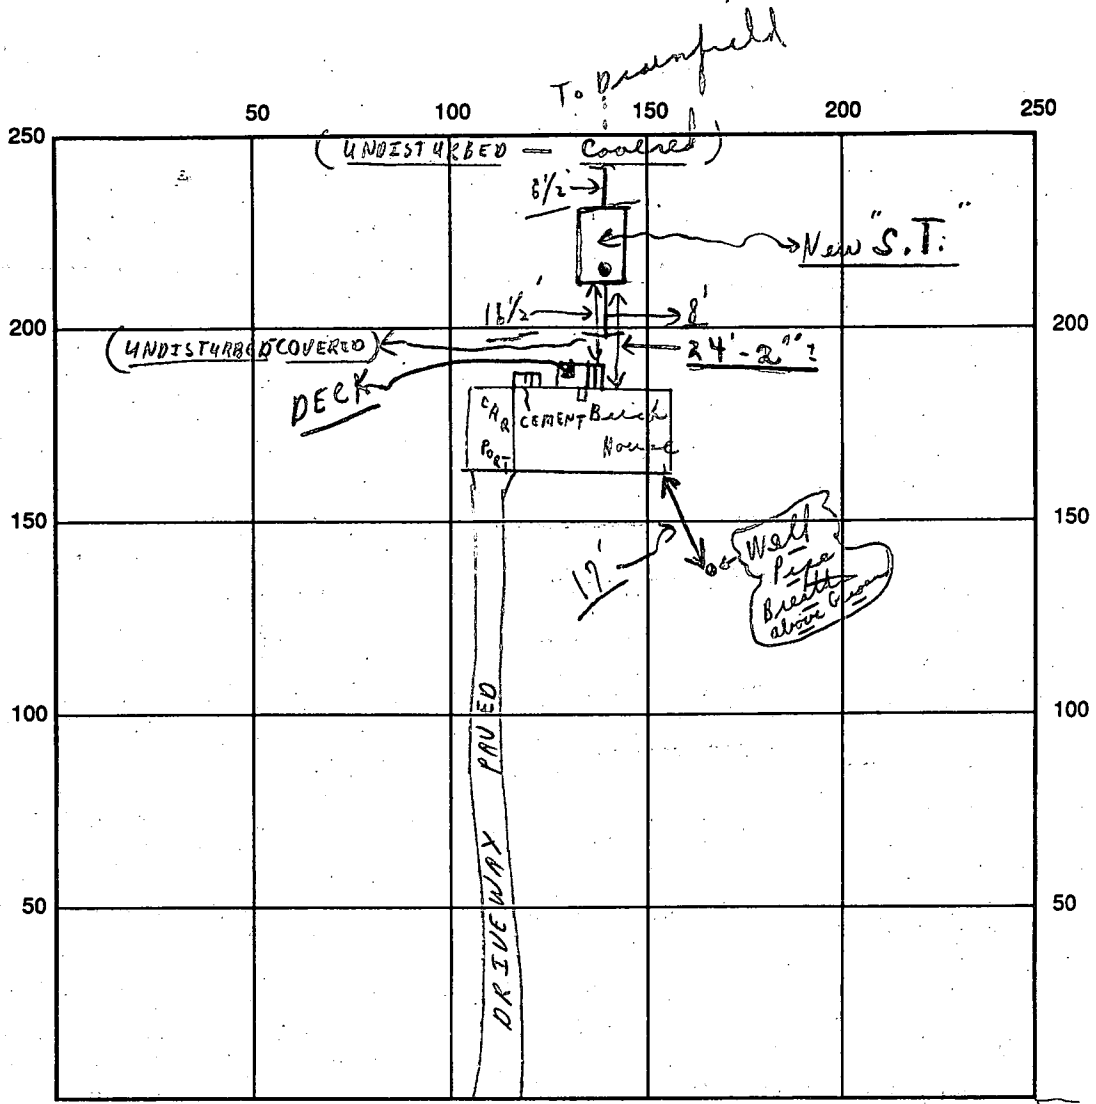

INDICATE NORTH - NAME ADJOINING ROADWAY AS BASE LINE
 DORSEY MILL ROAD

SEPTIC TANK LEVEL OK (NEW) CLEANOUTS OK (NEW)

DISTRIBUTION BOX LEVEL _____

DRAIN FIELD/TITLE DEPTH _____ FT. TRENCH WIDTH _____ FT. INLET DEPTH _____ FT.

EFFECTIVE GRAVEL DEPTH _____ FT. TOTAL LENGTH _____ FT.

NUMBER OF TRENCHES _____ ONE SIDEWALL/BOTTOM AREA _____ SQ. FT.

DRYWALL INSIDE DIAMETER _____ FT. EFFECTIVE DEPTH BELOW INLET _____ FT.

ABSORBENT AREA _____ SQ. FT. (Tank only)

REMARKS: 3/5/91 Repair - replacement of collapsed tank.
3/5/91 Site check - no tank - c.B.D. + d.B./c.B.D. - WAIT FOR CALL. C.B.D.
3/5/91 Final oh to cover new tank + new plastic pipe.

DATE SYSTEM APPROVED 3/5/91 INSPECTOR Charles Bryan & Trecker