

9/14/70

7-14-70  
DUB

# PERMIT

SEWAGE DISPOSAL SYSTEM

MARYLAND STATE DEPARTMENT OF HEALTH

HOWARD COUNTY

ELLICOTT CITY

DISTRICT 4

DATE 8/19/70

P. 15476

A. 15213

**INDEXED**

Robert Dubin Co.

IS PERMITTED TO INSTALL  ALTER

ADDRESS Route 2, Clarksville, Maryland

PHONE 286-3432

A SEWAGE DISPOSAL SYSTEM LOCATED AT \_\_\_\_\_

SUBDIVISION \_\_\_\_\_ ROAD Carr's Mill Road

LOT \_\_\_\_\_

6/10 mile off Rt. 144

PROPERTY OWNER Harold Stewart Cain, Jr.

ADDRESS \_\_\_\_\_

SPECIFICATIONS - 3 bedrooms

DRAIN FIELD \_\_\_\_\_ DEPTH \_\_\_\_\_ FEET. BOTTOM AREA \_\_\_\_\_ SQ. FT.

SEEPAGE PITS \_\_\_\_\_ ABSORBENT SIDE-WALL AREA \_\_\_\_\_ SQ. FT.

SEPTIC TANK CAPACITY 1,000 GALLONS

FOR GARBAGE GRINDER, INCREASE DISPOSAL AREA 22% & TANK CAPACITY 50%.

OTHER Dry well - dig pit 15 ft. sq. (set block and top in center for 12 ft. diameter

and fill in rest of pit with gravel). Dry well to be 8 ft. deep below the first 4 ft. of

non-absorbent ground. Max. depth permitted for dry well is 12 ft. below original grade,

or 2 dry wells each 10 ft. diameter and 8 ft. deep below the first 4 ft. of non-absorbent

ground. Place dry well about 45 ft. in front of the left front corner of house as seen

when facing from Carr's Mill Road. If 2 dry wells are used - place first dry well about

PLANS APPROVED BY D. W. Monaghan

DATE 6/2/70

45 ft. in front of the left front corner of house as seen when facing from Carr's Mill Rd,

FILL SEPTIC TANK AND DISTRIBUTION BOX WITH WATER BEFORE CALLING FOR AN INSPECTION. COVER NO WORK

UNTIL INSPECTED AND APPROVED.

and second dry well 36 ft. to the right of the first dry well. Dry wells to be connected

NEITHER THE HOWARD COUNTY COMMISSIONERS NOR THE HEALTH DEPARTMENT IS RESPONSIBLE FOR THE


SUCCESSFUL OPERATION OF ANY SYSTEM.

in series. Dry wells must be 3 times diameter apart edge to edge.

NOTE: CALL PIPE FROM HOUSE TO SEPTIC TANK MUST BE CAST IRON.

PERMIT VOID AFTER THREE YEARS.

A 15213

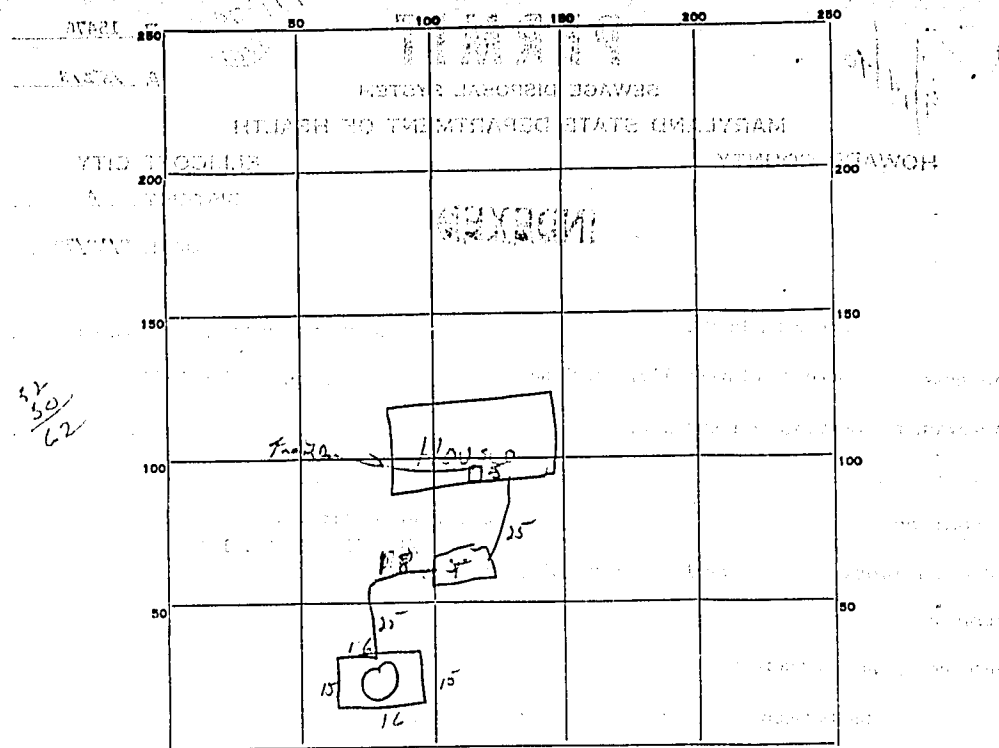

INDICATE NORTH. - NAME ADJOINING ROADWAY AS BASE LINE.

PERMIT CARD OK  
 SEPTIC TANK, LEVEL OK CLEANOUTS OK  
 DISTRIBUTION BOX, LEVEL \_\_\_\_\_  
 TILE FIELD, DEPTH \_\_\_\_\_ FT. TRENCH WIDTH \_\_\_\_\_ FT.  
 GRAVEL DEPTH \_\_\_\_\_ IN. TOTAL LENGTH \_\_\_\_\_ FT.  
 NUMBER OF TRENCHES \_\_\_\_\_ TOTAL BOTTOM AREA \_\_\_\_\_  
 SEEPAGE PITS, INSIDE DIAMETER 62 FT. DEPTH BELOW INLET 7 FT.  
 ABSORBENT AREA 496 SQ. FT.

REMARKS \_\_\_\_\_

\_\_\_\_\_

\_\_\_\_\_

\_\_\_\_\_

\_\_\_\_\_

DATE SYSTEM APPROVED 9/14/70 INSPECTOR [Signature]

32  
50  
62

12/1/70