

3/28/91  
follow up 5/14

# PERMIT

## SEWAGE DISPOSAL SYSTEM

### DEPARTMENT OF HEALTH AND MENTAL HYGIENE

P 47267B

A REPAIR

DISTRICT: \_\_\_\_\_

### INDEXED

#### HOWARD COUNTY HEALTH DEPARTMENT

#### BUREAU OF ENVIRONMENTAL HEALTH

461-9933

INDEX -  
NO WORK PERMITTED  
OF 8/21/95

03-286509

DATE \_\_\_\_\_

INSPECTED

DATE SYSTEM APPROVED 5/13/91

INSPECTOR RH

Jack Fyock Septic Service \_\_\_\_\_ IS PERMITTED TO INSTALL \_\_\_\_\_ ALTER X

ADDRESS \_\_\_\_\_ PHONE \_\_\_\_\_

SUBDIVISION \_\_\_\_\_ LOT \_\_\_\_\_ ROAD 12528 Folly Quarter Road

PROPERTY OWNER George Hall

ADDRESS 12528 Folly Quarter Road (Just before Jumpers Hole)

SEPTIC TANK CAPACITY \_\_\_\_\_ GALLONS

NUMBER OF BEDROOMS \_\_\_\_\_

\_\_\_\_\_ SQUARE FEET PER BEDROOM

LINEAR FEET OF TRENCH REQUIRED \_\_\_\_\_

### \* DIRECTIONS \*

1ST HOUSE ON RIGHT PAST FRANCISCAN FRIARS

REPAIR - TO REPAIR FAILING SEPTIC SYSTEM. CALL FOR INSPECTION WHEN GROUND IS OPENED SO SANITARIAN CAN RECOMMEND REPAIR.

UNSATISFACTORY SOILS, INSUFFICIENT LOT AREA IN FRONT OF HOUSE NEAR SEPTIC TANK,

EXISTING TANK IS SAID TO BE STEEL, 250 GAL.

INSTALL NEW TANK 1000 GAL OR LARGER + PUMP PIT, ALTERNATIVE PUMPS RECOMMENDED.

INSTALL 2-70' TRENCHES, 3' WIDE INLET 1/2" BOTTOM 3/4", 2' STONE NEAR HIGHEST (SOUTHWEST) CORNER OF PROPERTY 3/28/91 CW Williams

PLANS APPROVED BY Craig Williams cm DATE 03/28/91

COVER NO WORK UNTIL INSPECTED AND APPROVED

NEITHER THE HOWARD COUNTY COUNCIL NOR THE HEALTH DEPARTMENT IS RESPONSIBLE FOR THE SUCCESSFUL OPERATION OF ANY SYSTEM

NOTE: CLEANOUT REQUIRED EVERY 70 FEET OF SEWER LINE AND/OR AT 90° SWEEPS IN LINES FROM HOUSE TO DRAIN FIELDS, 90° ELBOWS NOT ACCEPTABLE.

NOTE: ALL PARTS OF SEPTIC SYSTEMS (I.E. TANK, DISTRIBUTION BOX TRENCHES) TO BE 100 FEET FROM WELL (UNLESS OTHERWISE SPECIFICALLY AUTHORIZED)

NOTE: IF DEEP TRENCH(ES) ARE USED CALL FOR INSPECTION BEFORE AND AFTER PLACING GRAVEL IN TRENCH(ES)

NOTE: NO DRY WELL SHALL EXCEED 15 FOOT IN DIAMETER NO ABSORPTION TRENCH TO EXCEED 100 FEET IN LENGTH

NOTE: ALL PIPE FROM HOUSE TO SEPTIC TANK MUST BE CAST IRON OR SCHEDULE 35/40 PVC OR ABS


PERMIT VOID AFTER TWO YEARS

NOTE: INSTALL STAND PIPE ON SEPTIC TANK AND DRY WELL STAND PIPES MUST BE 6 INCHES IN DIAMETER CAST IRON. CONCRETE OR TERRA COTTA OR PVA OR ABS ACCEPTED. IF TOP OF SEPTIC TANK IS DEEPER THAN 3 FEET. MANHOLE TO GRADE REQUIRED.

NOTE: DISTRIBUTION BOXES MUST HAVE BAFFLES

**\*INSTALLER IS RESPONSIBLE FOR OBTAINING FINAL APPROVAL ON THIS PERMIT**

47267B

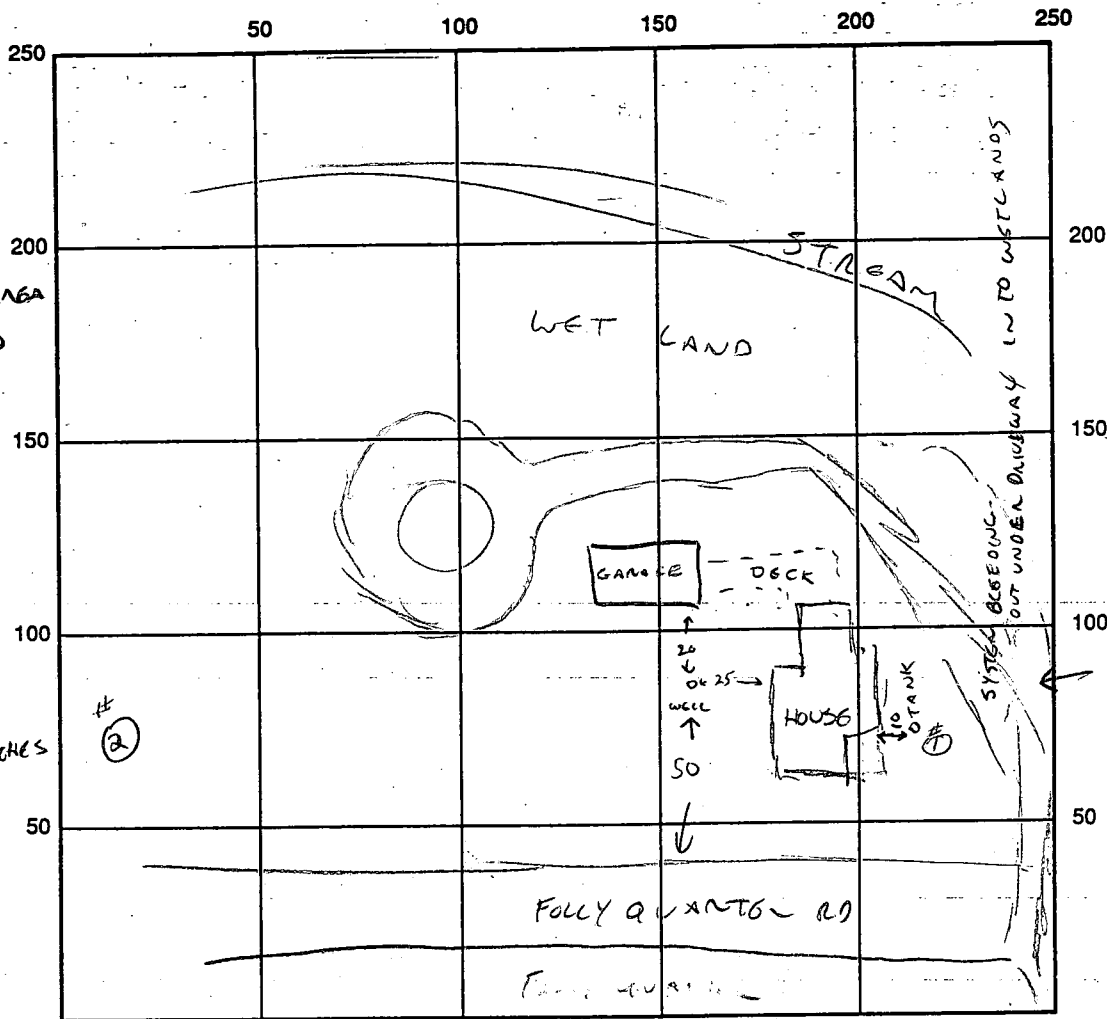

TEST #1  
 WET TO 3'  
 OR ABOVE  
 WATER AT 6'  
 LACK TAGS  
 LIMITED LOT AREA  
 NO OPPORTUNITY TO  
 INSTALL AT  
 THIS LOCATION

TEST #2  
 MOTTLED AT 6'  
 WET AT 7'  
 WATER AT 6'  
 5' MID PERC  
 AT 3 1/2'  
 INSTALL  
 2 - 70' TRENCHES  
 3' WIDE  
 IN LOT 1 1/2

INDICATE NORTH - NAME ADJOINING ROADWAY AS BASE LINE

3 1/2

SEPTIC TANK LEVEL \_\_\_\_\_ CLEANOUTS \_\_\_\_\_

DISTRIBUTION BOX LEVEL \_\_\_\_\_

DRAIN FIELD/TITLE DEPTH \_\_\_\_\_ FT. TRENCH WIDTH \_\_\_\_\_ FT. INLET DEPTH \_\_\_\_\_ FT.

EFFECTIVE GRAVEL DEPTH \_\_\_\_\_ FT. TOTAL LENGTH \_\_\_\_\_ FT.

NUMBER OF TRENCHES \_\_\_\_\_ ONE SIDEWALL/BOTTOM AREA \_\_\_\_\_ SQ. FT.

DRYWALL INSIDE DIAMETER \_\_\_\_\_ FT. EFFECTIVE DEPTH BELOW INLET \_\_\_\_\_ FT.

ABSORBENT AREA \_\_\_\_\_ SQ. FT.

REMARKS: 5/13/91 - NOTHING DONE. NO ONE HOME NO SEWAGE  
 SEEN RA

DATE SYSTEM APPROVED \_\_\_\_\_ INSPECTOR \_\_\_\_\_