

Per I 0-05-361613  
**PERMIT**

**SEWAGE DISPOSAL SYSTEM**  
**DEPARTMENT OF HEALTH AND MENTAL HYGIENE**

P 47536

A REPAIR

DISTRICT 5th

**HOWARD COUNTY HEALTH DEPARTMENT**  
**BUREAU OF ENVIRONMENTAL HEALTH**  
461-9933

DATE 10/8/91

**INDEXED**

DATE SYSTEM APPROVED 10-10-91

INSPECTOR JEN

Waterloo Sanitation Service IS PERMITTED TO INSTALL \_\_\_\_\_ ALTER X

ADDRESS 7311 Washington Blvd, Baltimore, Md. 21227 PHONE 799-1942

SUBDIVISION Beaverbrook LOT 3 B, Sec 1 ROAD 10275 Clarksville Pike

PROPERTY OWNER Mr. Maurice Bellucci

ADDRESS 10275 Clarksville Pike, Columbia, Md. 21044

SEPTIC TANK CAPACITY 1000 GALLONS

NUMBER OF BEDROOMS 3

\_\_\_\_\_ SQUARE FEET PER BEDROOM

LINEAR FEET OF TRENCH REQUIRED \_\_\_\_\_

REPAIR - To Replace Septic Tank and Install New Line to Distribution Box.

Call for inspection when ground is opened so sanitarian can recommend repair.

10-10-91 installer stated existing line to dist. box was in good condition. JEN

PLANS APPROVED BY Craig Williams cm DATE 10/8/91

COVER NO WORK UNTIL INSPECTED AND APPROVED

NEITHER THE HOWARD COUNTY COUNCIL NOR THE HEALTH DEPARTMENT IS RESPONSIBLE FOR THE SUCCESSFUL OPERATION OF ANY SYSTEM

NOTE: CLEANOUT REQUIRED EVERY 70 FEET OF SEWER LINE AND/OR AT 90° SWEEPS IN LINES FROM HOUSE TO DRAIN FIELDS, 90° ELBOWS NOT ACCEPTABLE.

NOTE: ALL PARTS OF SEPTIC SYSTEMS (I.E. TANK, DISTRIBUTION BOX TRENCHES) TO BE 100 FEET FROM WELL (UNLESS OTHERWISE SPECIFICALLY AUTHORIZED)

NOTE: IF DEEP TRENCH(ES) ARE USED CALL FOR INSPECTION BEFORE AND AFTER PLACING GRAVEL IN TRENCH(ES)

NOTE: NO DRY WELL SHALL EXCEED 15 FOOT IN DIAMETER NO ABSORPTION TRENCH TO EXCEED 100 FEET IN LENGTH

NOTE: ALL PIPE FROM HOUSE TO SEPTIC TANK MUST BE CAST IRON OR SCHEDULE 35/40 PVC OR ABS


PERMIT VOID AFTER TWO YEARS

NOTE: INSTALL STAND PIPE ON SEPTIC TANK AND DRY WELL STAND PIPES MUST BE 6 INCHES IN DIAMETER CAST IRON, CONCRETE OR TERRA COTTA OR PVA OR ABS ACCEPTED. IF TOP OF SEPTIC TANK IS DEEPER THAN 3 FEET. MANHOLE TO GRADE REQUIRED.

NOTE: DISTRIBUTION BOXES MUST HAVE BAFFLES

**\*INSTALLER IS RESPONSIBLE FOR OBTAINING FINAL APPROVAL ON THIS PERMIT**

47536

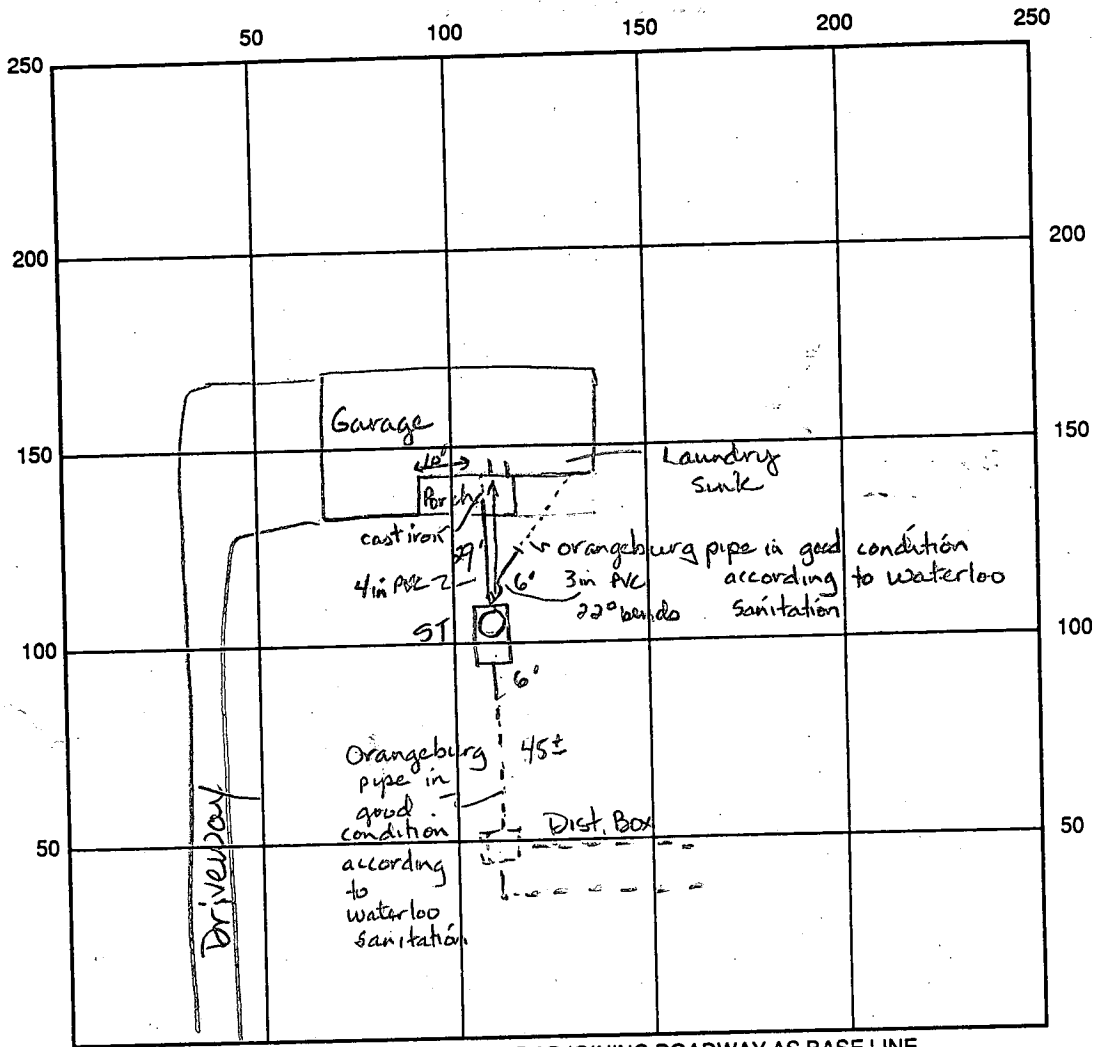

INDICATE NORTH - NAME ADJOINING ROADWAY AS BASE LINE

Route 108

SEPTIC TANK LEVEL 1000 gal CLEANOUTS 1 Manhole 44 inches

DISTRIBUTION BOX LEVEL \_\_\_\_\_

DRAIN FIELD/TITLE DEPTH N/A FT. TRENCH WIDTH \_\_\_\_\_ FT. INLET DEPTH \_\_\_\_\_ FT.

EFFECTIVE GRAVEL DEPTH \_\_\_\_\_ FT. TOTAL LENGTH \_\_\_\_\_ FT.

NUMBER OF TRENCHES \_\_\_\_\_ ONE SIDEWALL/BOTTOM AREA \_\_\_\_\_ SQ. FT.

DRYWALL INSIDE DIAMETER \_\_\_\_\_ FT. EFFECTIVE DEPTH BELOW INLET \_\_\_\_\_ FT.

ABSORBENT AREA \_\_\_\_\_ SQ. FT.

REMARKS: OK to cover all work. 10-10-91 JEN

DATE SYSTEM APPROVED 10-10-91 INSPECTOR Jane E. Madreau

6/27/62 or 6/28/62

approved  
6-27-62  
sum

# PERMIT

P 05184  
A 04199

SEWAGE DISPOSAL SYSTEM

MARYLAND STATE DEPARTMENT OF HEALTH

HOWARD COUNTY

**INDEXED**

**INDEXED**

ELICOTT CITY DISTRICT 5  
DATE 5/16/62

Wm. Warren

IS PERMITTED TO INSTALL  ALTER

ADDRESS \_\_\_\_\_ PHONE \_\_\_\_\_

A SEWAGE DISPOSAL SYSTEM LOCATED AT \_\_\_\_\_

SUBDIVISION Beaverbrook ROAD RT 108 LOT 3 b, Sec 1

PROPERTY OWNER Town and Ranch Homes

ADDRESS 2 Beaverbrook Rd.

SPECIFICATIONS

DRAIN FIELD  DEPTH \_\_\_\_\_ FEET, BOTTOM AREA 300 SQ. FT.

SEEPAGE PITS \_\_\_\_\_ ABSORBENT SIDE-WALL AREA \_\_\_\_\_ SQ. FT.

SEPTIC TANK CAPACITY 250 GALLONS

FOR GARBAGE GRINDER, INCREASE DISPOSAL AREA 22% & TANK CAPACITY 50%.


OTHER Place the tub field in the area 15 to 95 feet from the front lot line and 15 feet to 95 feet from the left side of the lot that is furthest from Rt 29

PLANS APPROVED BY Raymond Hodge DATE 9/22/61

FILL SEPTIC TANK AND DISTRIBUTION BOX WITH WATER BEFORE CALLING FOR AN INSPECTION. COVER NO WORK UNTIL INSPECTED AND APPROVED.

NEITHER THE HOWARD COUNTY COMMISSIONERS NOR THE HEALTH DEPARTMENT IS RESPONSIBLE FOR THE SUCCESSFUL OPERATION OF ANY SYSTEM.

A 04199

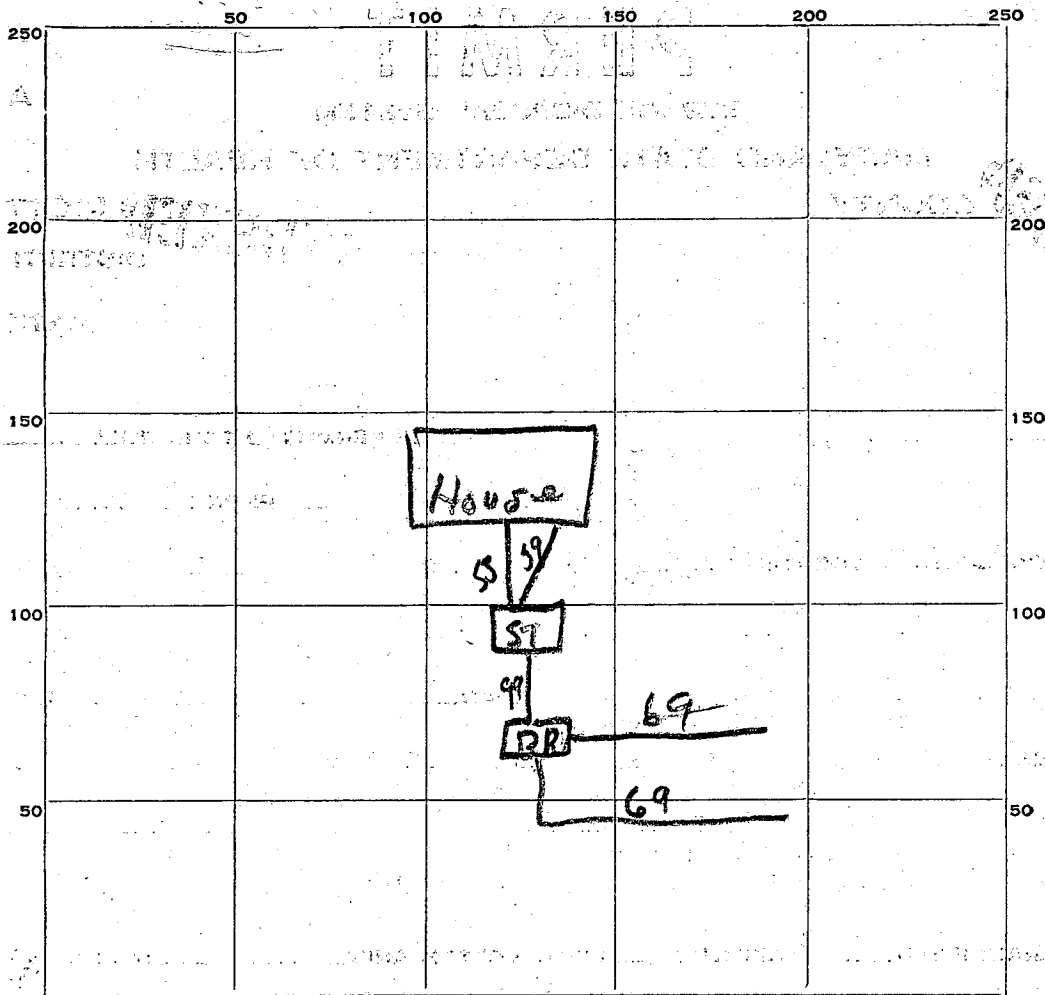

INDICATE NORTH. - NAME ADJOINING ROADWAY AS BASE LINE.

7 Route 108

PERMIT CARD

SEPTIC TANK, LEVEL

CLEANOUTS

DISTRIBUTION BOX, LEVEL

TILE FIELD, DEPTH 3 FT. TRENCH WIDTH 3 FT.

GRAVEL DEPTH 12 IN. TOTAL LENGTH 138 FT.

NUMBER OF TRENCHES 2 TOTAL BOTTOM AREA 414 sq ft

SEEPAGE PITS, INSIDE DIAMETER \_\_\_\_\_ FT. DEPTH BELOW INLET \_\_\_\_\_ FT.

ABSORBENT AREA \_\_\_\_\_ SQ. FT.

REMARKS

DATE SYSTEM APPROVED

6-27-62

INSPECTOR

*W. Mough*

# APPLICATION

A 04199

SEWAGE DISPOSAL TESTING

P \_\_\_\_\_

MARYLAND STATE DEPARTMENT OF HEALTH

HOWARD COUNTY 750 Gallon Tank

ELLICOTT CITY

Tile Field - 300 sq ft bottom area

DISTRICT 5

Place the tile field in the area  
15 ft to 95 ft from the front lot line  
and 15 ft to 95 ft from the side of the lot  
that is furthest from Rt. New 29.

DATE 8-30-61

TO: THE COUNTY HEALTH OFFICER  
ELLICOTT CITY, MARYLAND

I, HEREBY, APPLY FOR THE NECESSARY TESTS IN ORDER TO CONSTRUCT (OR RECONSTRUCT) A SEWAGE DISPOSAL SYSTEM.

PROPERTY OWNER Town and Ranch Homes

ADDRESS 2 Beaverbrook Rd. PHONE HO 5-3535

PROPERTY LOCATION:

SUBDIVISION Beaverbrook LOT NO. 3 b sec. 1

ROAD AND DESCRIPTION Rt. 108

OCCUPANT \_\_\_\_\_ PHONE \_\_\_\_\_

PERSON TO CONSTRUCT SYSTEM \_\_\_\_\_

ADDRESS \_\_\_\_\_ PHONE \_\_\_\_\_

SIZE OF LOT 1 acre TYPE BLDG. 3 NUMBER OF BEDROOMS \_\_\_\_\_

IF NOT SINGLE RESIDENCE DESCRIBE \_\_\_\_\_

SIGNATURE OF APPLICANT W. W. Davis


APPROVED BY Raymond Hodges FOR Tile Field DATE 22 Sept 61  
(KIND OF SYSTEM)

REJECTED BY \_\_\_\_\_ FOR \_\_\_\_\_ DATE \_\_\_\_\_  
(KIND OF SYSTEM)

HOLD PENDING FURTHER TESTS \_\_\_\_\_ DATE \_\_\_\_\_

REASONS FOR REJECTION OR HOLDING \_\_\_\_\_

# THIS IS NOT A PERMIT

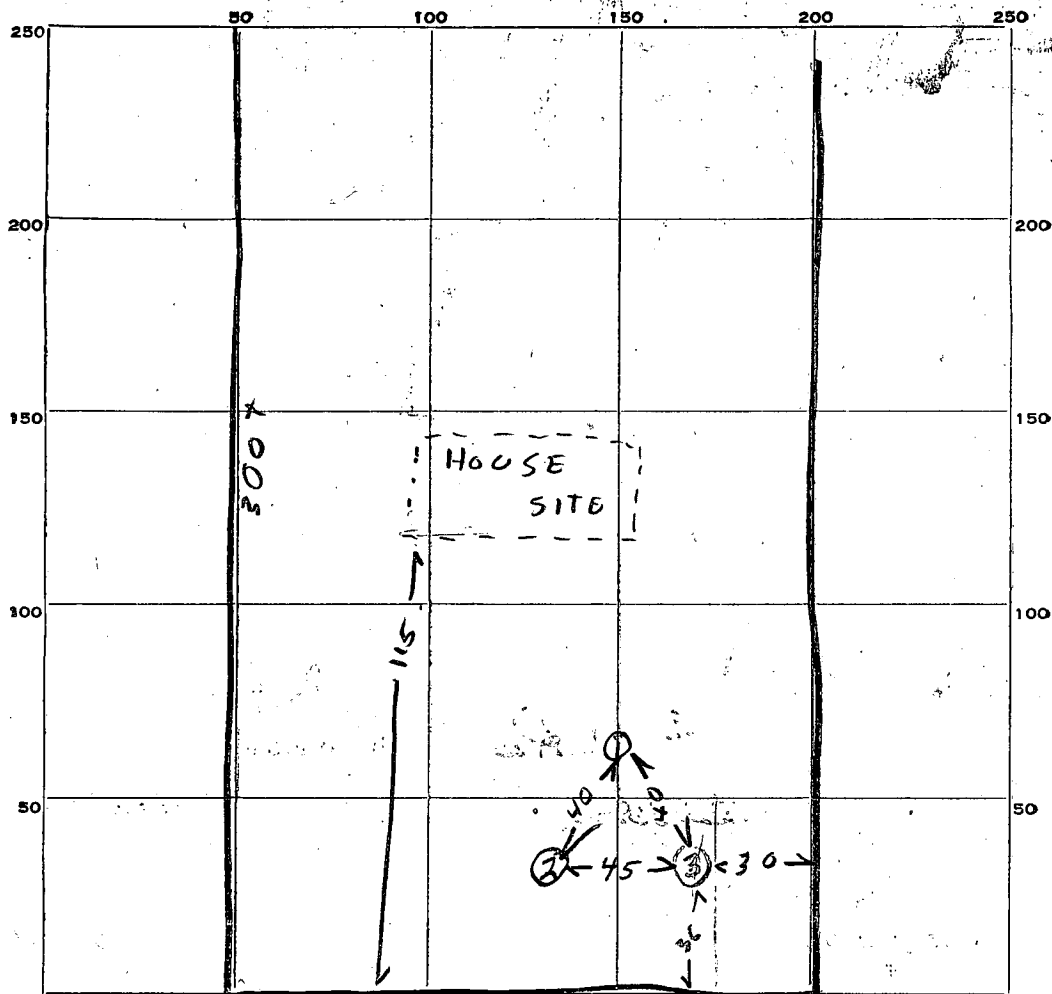

INDICATE NORTH - NAME ADJOINING ROADWAY AS BASE LINE

← TO ROUTE NEW 29

ROUTE 108

DATE	TEST NO.	DEPTH	PRE-WET		TEST - 1" DROP		TIME
			START	STOP	START	STOP	
22 Sept 61	1	3	134	134½	134½	136	½ min
"	2	3	137	138	138	141	3 min
"	3	3	143	143½	143½	144	½ min

SOIL AUGER FINDING

TESTED BY Raymond Rodges

REMARKS

ALSO PRESENT Wm C Perle LOT NO. 3 B sect 1