

PERMIT

SEWAGE DISPOSAL SYSTEM

DEPARTMENT OF HEALTH AND MENTAL HYGIENE

HOWARD COUNTY HEALTH DEPARTMENT
BUREAU OF ENVIRONMENTAL HEALTH
461-9933

INDEXED

247062

File

P 47640

A REPAIR

DISTRICT _____

DATE 11/26/91

DATE SYSTEM APPROVED 11/26/91

INSPECTOR C.B.D.

Jenkins Brothers IS PERMITTED TO INSTALL _____ ALTER

ADDRESS Route 144, Ellicott City, Maryland 21043 PHONE 465-6646

SUBDIVISION _____ LOT _____ ROAD 2936 Rogers Avenue

PROPERTY OWNER (1) Chris Gorman (2) JUDY SHELTON → Public Water

ADDRESS 2936 Rogers Avenue
Ellicott City, Maryland 21043

SEPTIC TANK CAPACITY 1000 GALLONS

NUMBER OF BEDROOMS 3

_____ SQUARE FEET PER BEDROOM

LINEAR FEET OF TRENCH REQUIRED _____

REPAIR - PURPOSE - INSTALL 1000 GALLON SEPTIC TANK.

Call for inspection when tank is in place.

11/26/91 - PUB. SEWER NOT AVAILABLE. M.R. / C.B.D.

(OK AS PER ABOVE)

11/26 C.B.D. for

PLANS APPROVED BY Mark Rifkin DATE 11/21/91

COVER NO WORK UNTIL INSPECTED AND APPROVED.

NEITHER THE HOWARD COUNTY COUNCIL NOR THE HEALTH DEPARTMENT IS RESPONSIBLE FOR THE SUCCESSFUL OPERATION OF ANY SYSTEM

NOTE: CLEANOUT REQUIRED EVERY 70 FEET OF SEWER LINE AND/OR AT 90° SWEEPS IN LINES FROM HOUSE TO DRAIN FIELDS, 90° ELBOWS NOT ACCEPTABLE.

NOTE: ALL PARTS OF SEPTIC SYSTEMS (I.E. TANK, DISTRIBUTION BOX TRENCHES) TO BE 100 FEET FROM WELL (UNLESS OTHERWISE SPECIFICALLY AUTHORIZED)

NOTE: IF DEEP TRENCH(ES) ARE USED CALL FOR INSPECTION BEFORE AND AFTER PLACING GRAVEL IN TRENCH(ES)

NOTE: NO DRY WELL SHALL EXCEED 15 FOOT IN DIAMETER NO ABSORPTION TRENCH TO EXCEED 100 FEET IN LENGTH

NOTE: ALL PIPE FROM HOUSE TO SEPTIC TANK MUST BE CAST IRON OR SCHEDULE 35/40 PVC OR ABS


PERMIT VOID AFTER TWO YEARS

NOTE: INSTALL STAND PIPE ON SEPTIC TANK AND DRY WELL STAND PIPES MUST BE 6 INCHES IN DIAMETER CAST IRON. CONCRETE OR TERRA COTTA OR PVA OR ABS ACCEPTED. IF TOP OF SEPTIC TANK IS DEEPER THAN 3 FEET, MANHOLE TO GRADE REQUIRED.

NOTE: DISTRIBUTION BOXES MUST HAVE BAFFLES

***INSTALLER IS RESPONSIBLE FOR OBTAINING FINAL APPROVAL ON THIS PERMIT**

47640

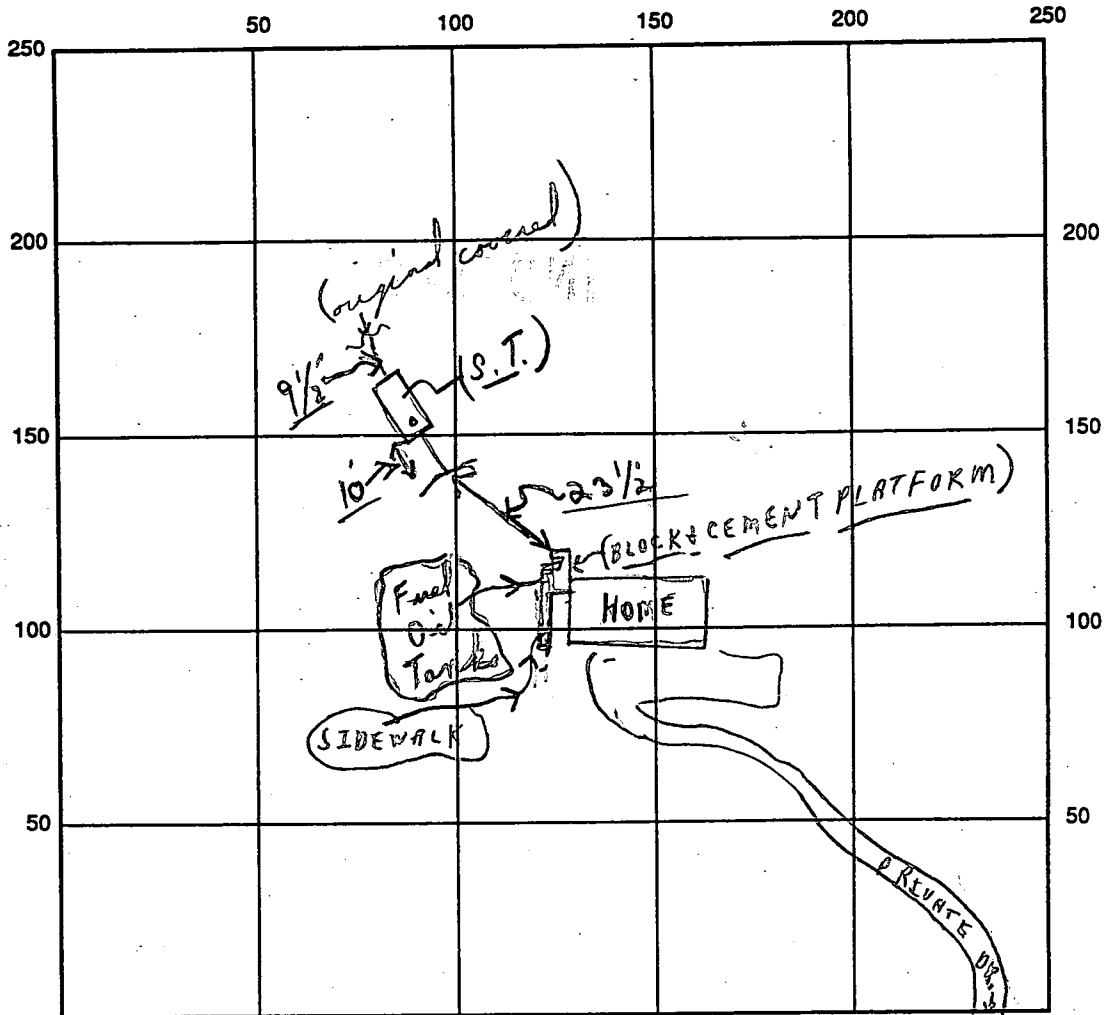

INDICATE NORTH - NAME ADJOINING ROADWAY AS BASE LINE

← E.C. ←

Rogers Avenue {OK} →
CLEANOUTS {S.T.}

SEPTIC TANK LEVEL OK

DISTRIBUTION BOX LEVEL —

DRAIN FIELD/TITLE DEPTH — FT. TRENCH WIDTH — FT. INLET DEPTH — FT.

EFFECTIVE GRAVEL DEPTH — FT. TOTAL LENGTH — FT.


NUMBER OF TRENCHES — ONE SIDEWALL/BOTTOM AREA — SQ. FT.

DRYWALL INSIDE DIAMETER — FT. EFFECTIVE DEPTH BELOW INLET — FT.

ABSORBENT AREA — SQ. FT.

REMARKS: 11/26/91 A.M. - OK TO COVER AS FINISH; SEPTIC TANK
REPLACED - FINAL C.B.D. (PUBLIC WATER TO HOME)

DATE SYSTEM APPROVED 11/26/91 INSPECTOR Charles Bryan Stuck

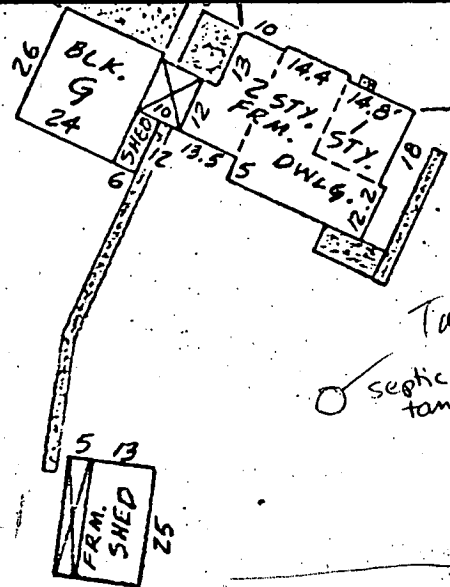

approx.
size & location
of seepage
pit.

AREA =
1.63 A.C.M/2

Chris Gorman PRESENT OWNER
2936 Rogers Ave
461-7334

1976-77 PREVIOUS OWNER
Mr & Mrs Summers
city water Private Septic

1150'00"E

379.00'

38'±

TANK Replaced 2 year ago
15' R/W
1110
76/123

Look up
in File
Building
Permit
for
Addition
coming
later
12 Nov 93

15 NOV 93
Found
Permit in
File today
I told tell
Building Permit
application
comes through
R.A

176.55

112'