

(2) ZONE

A19997


1 ACRE

(2) ZONE

STATE ET.# 114 (50 FT. W.D.)

PL

S 57° 40'

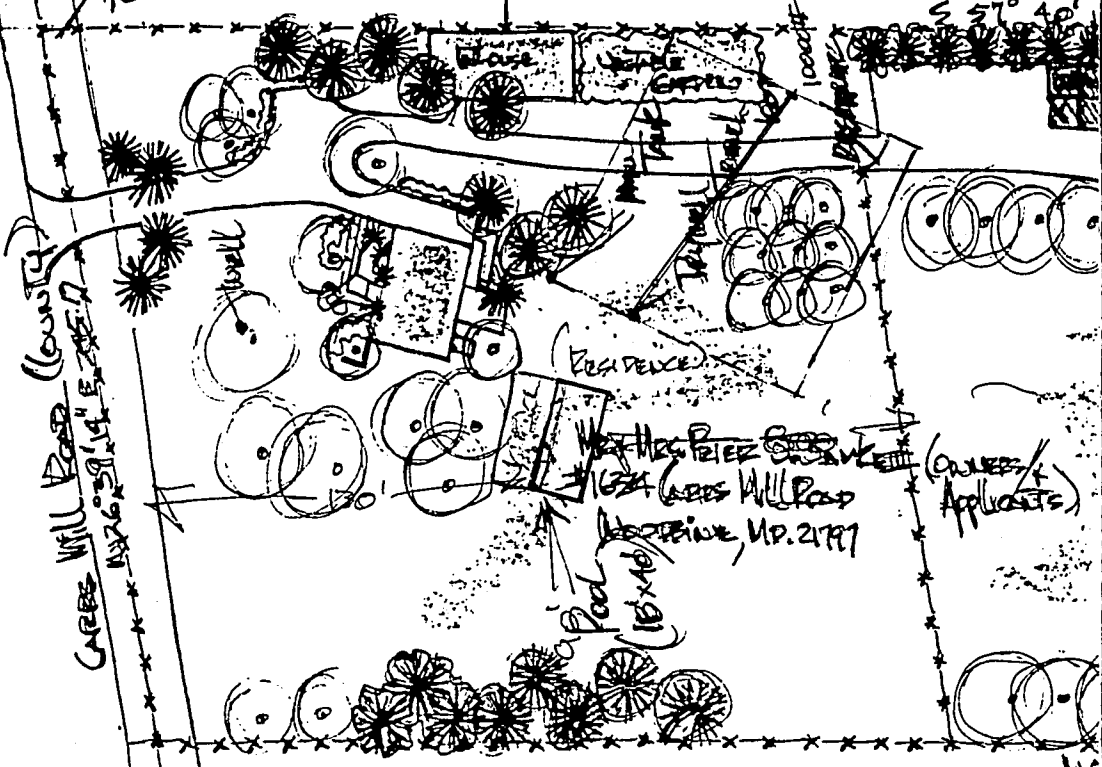

CARRE WILL ROAD (COUNTY MAG. 31 1/4\"/>

MR. & MRS. RIEZ  
1624 CARRE WILL ROAD  
ROCKFORD, MD. 21767

(OWNER'S APPLICANTS)

2.5 ACES

Improvements

Improvements


CARDS WITH (0202)

(W)

RECEIVED  
HOWARD COUNTY  
HEALTH DEPT.  
OCT 3 9 16 AM '83  
DIVISION OF  
ENVIRONMENTAL  
HEALTH

HOUSE

Clearout found for

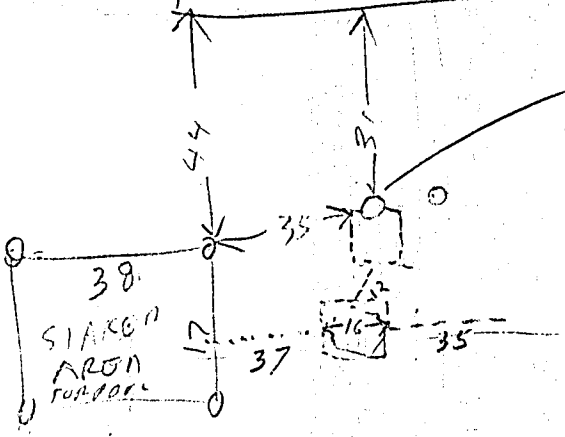

8/5/83 Rejected permit Pool appears  
to be over trench 8 in