


**LOCATION SURVEY**  
 16335 CARRS MILL ROAD  
 4TH ELECTION DISTRICT  
 HOWARD COUNTY MD

This is to certify that I have surveyed the property shown hereon, being the same land conveyed by Donald E. Hill to Louis E. Britton and Betty A. Britton by deed dated August 16, 1978 and recorded among the land records of Howard County, Maryland in Liber 898 at Folio 351, for the purpose of locating the improvements thereon.

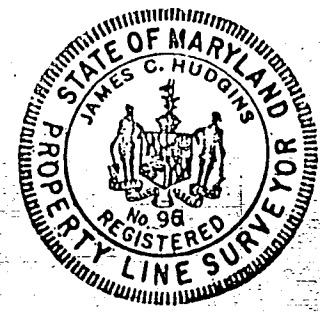

*J. Carl Hudgins*  
 J. Carl Hudgins PLS #96

THIS PLAT SHOWS ONLY THAT THE IMPROVEMENTS ARE CONTAINED WITHIN THE OUTLINES OF THE LOT AND IS NOT TO BE USED TO ESTABLISH PROPERTY LINES.		
NTT ASSOCIATES INC. 16205 OLD FREDERICK ROAD MT. AIRY, MARYLAND PHONE 646-5521 or 442-2031		
SCALE 1"=50'	FIELD BY RIK	DRAWING NUMBER
DATE 5-23-86	DRAWN BY JCH	K-286