

5/5/92 ASAP

Tax ID - 05-378656

# PERMIT

## SEWAGE DISPOSAL SYSTEM

### DEPARTMENT OF HEALTH AND MENTAL HYGIENE

P 48/63

A REPAIR

DISTRICT \_\_\_\_\_

DATE 5/27/92

HOWARD COUNTY HEALTH DEPARTMENT  
BUREAU OF ENVIRONMENTAL HEALTH  
461-9933

**INDEXED**

*Permit [unclear]  
[unclear]*

DATE SYSTEM APPROVED 5/5/92

INSPECTOR RH

Jack Fyock \_\_\_\_\_ IS PERMITTED TO INSTALL \_\_\_\_\_ ALTER X

ADDRESS \_\_\_\_\_ PHONE 988-9270

SUBDIVISION \_\_\_\_\_ LOT \_\_\_\_\_ ROAD 12868 Highland Road

PROPERTY OWNER Rottier Georgina Groleau  
12868 Highland Road

ADDRESS \_\_\_\_\_

SEPTIC TANK CAPACITY 1000 GALLONS

NUMBER OF BEDROOMS 3

125 SQUARE FEET PER BEDROOM

LINEAR FEET OF TRENCH REQUIRED 53

*53  
7 53 7 5  
3 5  
1 4*

REPAIR - PURPOSE - Dry Well Overflowing 4/20/92  
Call for inspection when ground is opened so sanitarian can recommend repair.

REPLACE CAST IRON PIPE BETWEEN  
TANK & DRY WELL & ADD TRENCH  
OF DRY WELL 10 FT DEEP 2 FT WIDE  
7 FT STONE 53 FT LONG 5/5/92 RH

PLANS APPROVED BY \_\_\_\_\_ DATE \_\_\_\_\_

COVER NO WORK UNTIL INSPECTED AND APPROVED

NEITHER THE HOWARD COUNTY COUNCIL NOR THE HEALTH DEPARTMENT IS RESPONSIBLE FOR THE SUCCESSFUL OPERATION OF ANY SYSTEM

NOTE: CLEANOUT REQUIRED EVERY 70 FEET OF SEWER LINE AND/OR AT 90° SWEEPS IN LINES FROM HOUSE TO DRAIN FIELDS, 90° ELBOWS NOT ACCEPTABLE.

NOTE: ALL PARTS OF SEPTIC SYSTEMS (I.E. TANK, DISTRIBUTION BOX TRENCHES) TO BE 100 FEET FROM WELL (UNLESS OTHERWISE SPECIFICALLY AUTHORIZED)

NOTE: IF DEEP TRENCH(ES) ARE USED CALL FOR INSPECTION BEFORE AND AFTER PLACING GRAVEL IN TRENCH(ES)

NOTE: NO DRY WELL SHALL EXCEED 15 FOOT IN DIAMETER NO ABSORPTION TRENCH TO EXCEED 100 FEET IN LENGTH

NOTE: ALL PIPE FROM HOUSE TO SEPTIC TANK MUST BE CAST IRON OR SCHEDULE 35/40 PVC OR ABS


PERMIT VOID AFTER TWO YEARS

NOTE: INSTALL STAND PIPE ON SEPTIC TANK AND DRY WELL STAND PIPES MUST BE 6 INCHES IN DIAMETER CAST IRON. CONCRETE OR TERRA COTTA OR PVA OR ABS ACCEPTED. IF TOP OF SEPTIC TANK IS DEEPER THAN 3 FEET. MANHOLE TO GRADE REQUIRED.

NOTE: DISTRIBUTION BOXES MUST HAVE BAFFLES

**\*INSTALLER IS RESPONSIBLE FOR OBTAINING FINAL APPROVAL ON THIS PERMIT**

*48163*

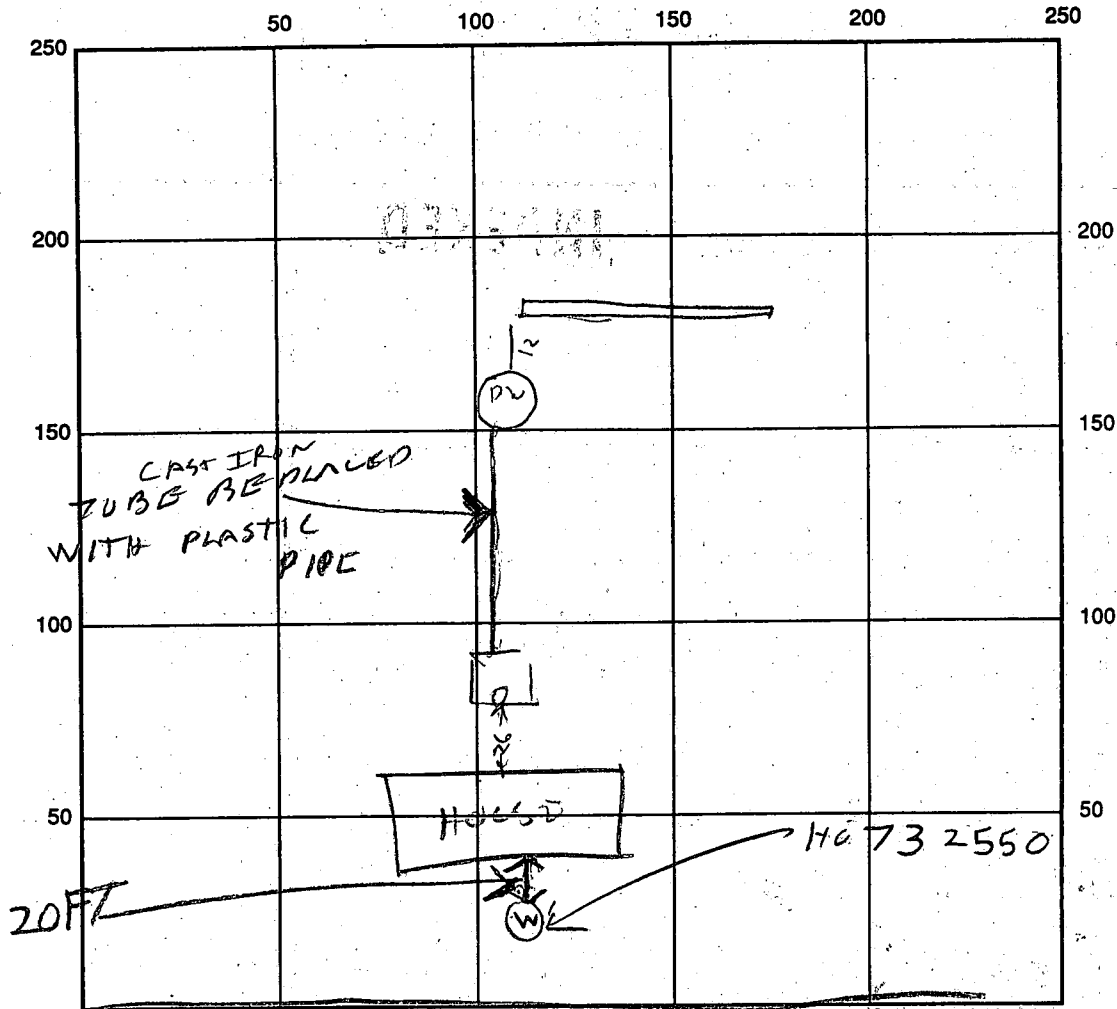

SEPTIC TANK LEVEL OLD 7A MI CLEANOUTS \_\_\_\_\_

DISTRIBUTION BOX LEVEL \_\_\_\_\_

DRAIN FIELD/TITLE DEPTH 10 FT. TRENCH WIDTH \_\_\_\_\_ FT. INLET DEPTH 3 FT.

EFFECTIVE GRAVEL DEPTH 7 FT. TOTAL LENGTH 57 FT.

NUMBER OF TRENCHES 1 ONE SIDEWALL/BOTTOM AREA 399 SQ. FT.

DRYWALL INSIDE DIAMETER \_\_\_\_\_ FT. EFFECTIVE DEPTH BELOW INLET \_\_\_\_\_ FT.

ABSORBENT AREA 1440 SQ. FT.

REMARKS: 5/5/92 ROBERT FYO UK SAID SYSTEM CAN BE COVERED BEFORE INSPECTION BECAUSE OF SPECIAL PERMISSION FROM GRAIG, PERMISSION GRANTED BECAUSE RAIN WAS IN FORECAST. RH CAST IRON PIPE CLOGGED UP BETWEEN TANK & DRY WELL RH

DATE SYSTEM APPROVED 5/5/92 INSPECTOR Raymond Hodge

57  
7  
9