

9/10/65

# PERMIT

SEWAGE DISPOSAL SYSTEM

MARYLAND STATE DEPARTMENT OF HEALTH

HOWARD COUNTY

## INDEXED

ELLICOTT CITY

DISTRICT 3

DATE 8/10/65

P 10722

A 09000

Maryland Septic Tank & Sewer Co. IS PERMITTED TO INSTALL  ALTER

ADDRESS 2323 Maryland Avenue, Baltimore 18, Md. PHONE BE 5-1109

A SEWAGE DISPOSAL SYSTEM LOCATED AT \_\_\_\_\_

SUBDIVISION Buratwood ROAD Cattlebar Dr. LOT 4, Blk. B,  
Sec. 3 Part 2

PROPERTY OWNER Burnt Woods Dev.

ADDRESS \_\_\_\_\_

SPECIFICATIONS - 3, ~~4~~ bedrooms

DRAIN FIELD \_\_\_\_\_ DEPTH \_\_\_\_\_ FEET, BOTTOM AREA \_\_\_\_\_ SQ. FT.

SEEPAGE PITS \_\_\_\_\_ ABSORBENT SIDE-WALL AREA \_\_\_\_\_ SQ. FT.

SEPTIC TANK CAPACITY _____	750	GALLONS for 3 bedrooms
	1000	" " 4 bedrooms
	1500	" " 5 bedrooms

FOR GARBAGE GRINDER, INCREASE DISPOSAL AREA 22% & TANK CAPACITY 50%.

OTHER Dry well - 100 sq. ft. absorbent sidewall area per bedroom.

Locate dry well <sup>ABOUT 65-75</sup> from front lot line and 38 ft. from left side line as

lot is seen when facing it from Street "B". 3 BEDROOM HOUSE-300

soft required OK to put Dry Well 65-75 ft from Front Lot Line R/H

PLANS APPROVED BY R. Fletcher DATE 9/24/64


FILL SEPTIC TANK AND DISTRIBUTION BOX WITH WATER BEFORE CALLING FOR AN INSPECTION. COVER NO WORK UNTIL INSPECTED AND APPROVED.

NEITHER THE HOWARD COUNTY COMMISSIONERS NOR THE HEALTH DEPARTMENT IS RESPONSIBLE FOR THE SUCCESSFUL OPERATION OF ANY SYSTEM.

A. Brown

AG 9000  
9/16/64 D Worechlas  
142 6 min at 6'  
4 min at 11'

Rebar 3#4 90° feet to look  
3 min at 11'  
4 min at 6'  
RDP

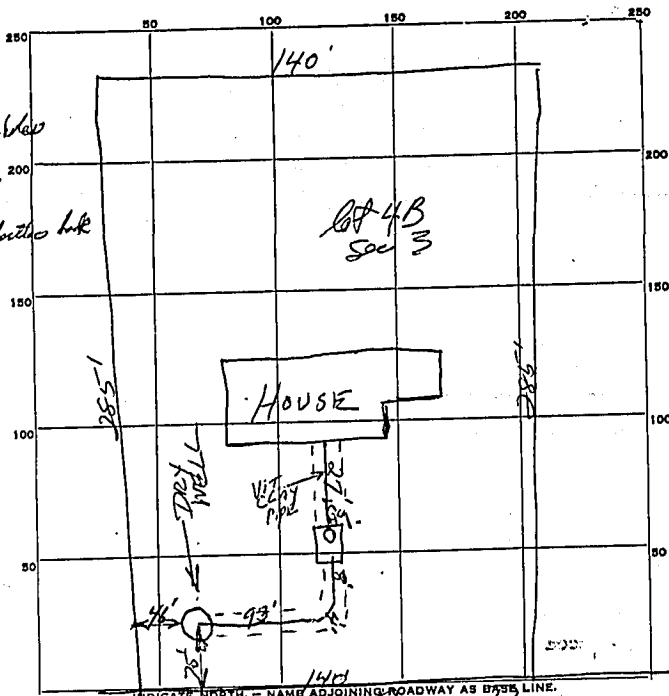

INDICATE NORTH - NAME ADJOINING ROADWAY AS BYSS LINE.  
CASTLEBAR PK.

PERMIT CARD Yes  
SEPTIC TANK, LEVEL concrete 750 gal. CLEANOUTS 6" standpipe  
DISTRIBUTION BOX, LEVEL None  
TILE FIELD, DEPTH \_\_\_\_\_ FT. TRENCH WIDTH \_\_\_\_\_ FT.  
GRAVEL DEPTH \_\_\_\_\_ IN. TOTAL LENGTH \_\_\_\_\_ FT.  
NUMBER OF TRENCHES \_\_\_\_\_ TOTAL BOTTOM AREA \_\_\_\_\_  
SEEPAGE PITS, INSIDE DIAMETER outside 14 FT. DEPTH BELOW INLET 8 1/2 FT.  
ABSORBENT AREA OK SQ. FT.

REMARKS: 9-10-65 Need to uncover earth from trenches  
the inspector house sewer and connections from house  
to dry well before final approval can be given. JH  
9-14-65 all ok.


DATE SYSTEM APPROVED 9-14-65 INSPECTOR J. Henning



**DEPARTMENT OF PLANNING & ZONING**

*Joseph W. Rutter, Jr., Director*

TO: Jacob Hickmat, P.E.  
Mildenberg, Boender & Assoc., Inc.

FROM: Brenda Barth   
Division of Land Development

RE: F 00-28 Burntwood, Block B, Lots 13 and 14

*→ should be lots 15 & 16  
★ 1/16/08*

*14014 Castlebar Drive  
14016 Castlebar Drive*

Jacob, please be advised that the above referenced original plat has been returned unsigned from the Health Department per the enclosed comments. This plat will be placed on hold within the Department of Planning and Zoning until written approval is received from the Health Department indicating that all concerns have been addressed. At that time, the plat original will be resubmitted to the Health Dept. for the Health Officer's signature. Should you have any questions regarding this matter, please contact me at your convenience.

  
:btb

Mark R. ✓  
Health Dept.

Mark please let me know when this is OK

*Shanks  
BTD*

File No. F00-28  
Burntwood  
lots 13+14

**DEPARTMENT OF PLANNING AND ZONING  
FINAL PLAT ORIGINAL FOR SIGNATURE APPROVAL**

This form is for the processing of originals for signature approvals. If corrections or additions must be made to the original, the corrections needed must be identified in the space provided and the plans must be returned unsigned to the Department of Planning and Zoning. DPZ will notify the owner of the required revisions and request that the owner's engineer make the corrections or contact the appropriate County agency with questions concerning such revisions.

**DPZ**  
[Signature]  
\_\_\_\_\_  
Reviewing Agent

Date Received  
2-02-00

Date Forwarded  
2-04-00  
(Corrected)

Rejected For: \_\_\_\_\_  
#3 2/4/00

**HEALTH**  
[Signature]  
\_\_\_\_\_  
Reviewing Agent

Date Received  
2/07/00

Date Forwarded  
\_\_\_\_\_

Rejected For: Applicant has not complied with note #9 on signed perc cert requiring drilling of wells, and abandonment of ex. well & septic

**DPW**  
\_\_\_\_\_  
Reviewing Agent

Date Received  
\_\_\_\_\_

Date Forwarded  
\_\_\_\_\_

Rejected For: \_\_\_\_\_

**Chief, DLD**  
\_\_\_\_\_  
Reviewing Agent

Date Received  
\_\_\_\_\_

Date Forwarded  
\_\_\_\_\_

Rejected For: \_\_\_\_\_

