

APPLICATION

PERCOLATION TESTING

A 48500
P 48500

HOWARD COUNTY HEALTH DEPARTMENT
BUREAU OF ENVIRONMENTAL HEALTH
P.O. BOX 476 ELLICOTT CITY, MARYLAND 21043
TELEPHONE: 461-9933

DISTRICT _____

REPAIR PERC ACCOMPLISHED DATE 9/15/92

TO ESTABLISH SOIL CONDITIONS
ADEQUATE FOR FUTURE REPAIR BECAUSE:

INDEXED

TO: THE COUNTY HEALTH OFFICER
ELLICOTT CITY, MARYLAND

- ① SEPARATE TENTATIVE HOUSE PROPOSAL (A48423) NEARBY
- ② PROBABLE BP-RENOVATION COMING IN ON THIS HOUSE.

I, HEREBY, APPLY FOR THE NECESSARY TEST IN ORDER TO CONSTRUCT (OR RECONSTRUCT) A SEWAGE DISPOSAL SYSTEM.

PROPERTY OWNER JOHN BRIGANTE (BUYER)

ADDRESS 7414 RACE RD 21076 PHONE 799 0173

PROSPECTIVE BUYER _____

ADDRESS _____ PHONE _____

PROPERTY LOCATION:

SUBDIVISION N/A "MAIN" FARM HOUSE LOT NO. _____

ROAD AND DESCRIPTION 15200 OLD FREDERICK RD

TAX MAP _____ PARCEL # _____

SIZE OF LOT _____ TYPE BLDG. EXISTING HOUSE
(SINGLE FAMILY DWELLING OR COMMERCIAL)

THE SYSTEM INSTALLED UNDER THIS APPLICATION IS ACCEPTABLE ONLY UNTIL PUBLIC FACILITIES BECOME AVAILABLE. I FULLY UNDERSTAND THE FEE CONNECTED WITH THE FILING OF THIS PERC TEST APPLICATION IS NON-REFUNDABLE UNDER ANY CIRCUMSTANCES. I ALSO AGREE TO COMPLY WITH ALL M.O.S.H.A. REQUIREMENTS IN TESTING THIS LOT.

(SIGNATURE OF APPLICANT)

APPROVED BY _____ FOR _____ DATE _____



REJECTED BY _____ FOR _____ DATE _____

HOLD PENDING FURTHER TESTS _____ DATE _____

REASONS FOR REJECTION OR HOLDING 2/19/92 PERC CERT PLAT REPAIR PERC PERMITS LETTER NEEDED BH

THIS IS NOT A PERMIT

P48500

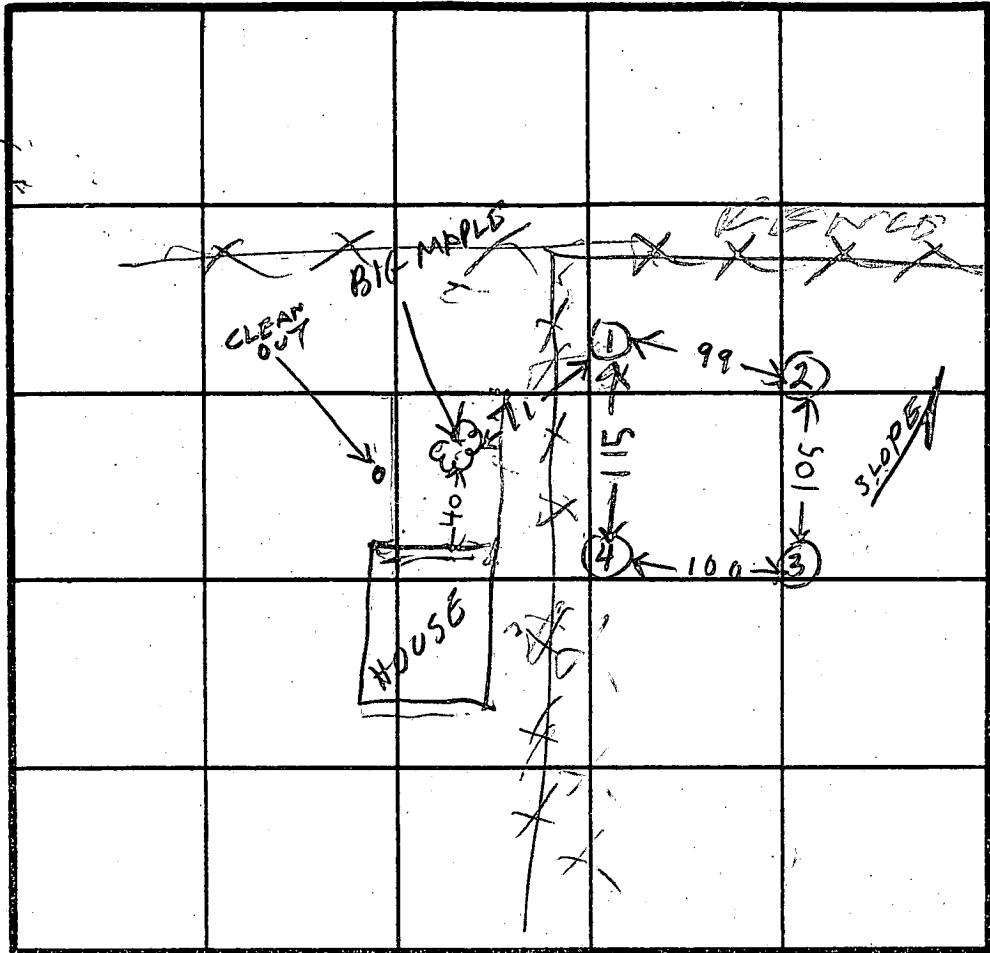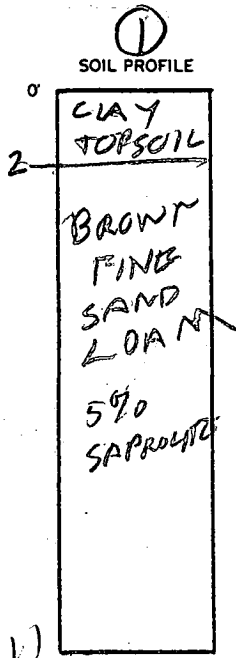

INDICATE NORTH - NAME ADJOINING ROADWAY AS BASE LINE.

HOLE
ELEVATION

④ = HIGHEST
③ = MEDIUM
② = LOWEST

DATE	TEST NO.	DEPTH	PRE-WET		TEST - 1" DROP		TIME	
			START	STOP	START	STOP		
8/11/92	1V	11	OK	T				
8/18/92	2V	9	DOUBTFUL ROCK BOTTOM					
8/18/92	3V	11	OK					
8/18/92	4V	11	OK					




① NO OVER FLOW SEEN BUT HOUSE VACANT
 ② EXISTING WELL OVER 100 FT FROM HOUSE & PERCS
 ③ EXISTING TANK NOT FOUND
 ④ NO RECORD OF EXISTING SYSTEM

TYPE OF SOIL

TESTED BY

R. Hodger

ALSO PRESENT

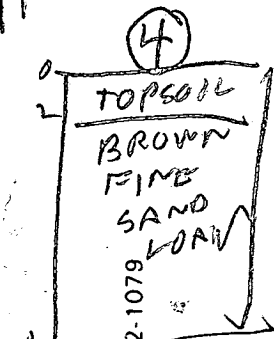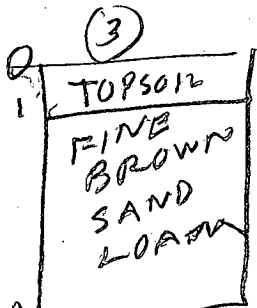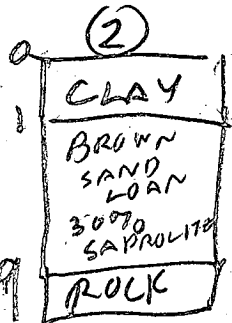

EH-12-1079

21 AUGUST 92

Craig Williams
Program Director, Water and Sewerage
Bureau of Environmental Health
Howard County Health Department

RE: Existing Well
15200 Old Fredrick Rd
Tax Map: 8 Parcel: 28


Dear Mr. Williams,

Concerning the existing well on the subject property, I propose to use this well to provide service to the new Tenant house. I intend to discontinue service from this well to the house currently on the property.


Prior to filing for certificate of occupancy, any repairs necessary to bring this existing well up to standards and pass potability inspection will be completed.

Thank you for your time and consideration on this matter.

Very truly yours,

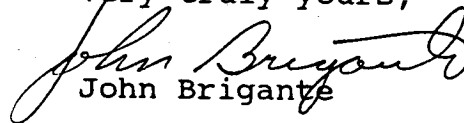
John Brigante

ACKNOWLEDGED

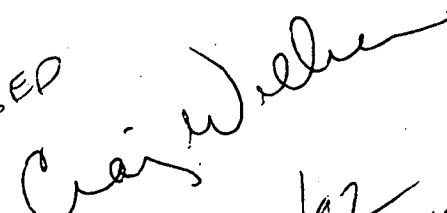

8/21/92

92 AUG 21 PM 2:57

RECEIVED
HOWARD COUNTY
HEALTH DEPT.

RECEIVED
HOWARD COUNTY
HEALTH DEPT.
92 AUG 10 PM 1:07

BRIGANTO P.P. of
5200 old Fred Rd

