

12/15/92
12/14/92
1/22/93

PERMIT

SEWAGE DISPOSAL SYSTEM

DEPARTMENT OF HEALTH AND MENTAL HYGIENE

P 48754

A REPAIR

DISTRICT _____

DATE 12/14/92

HOWARD COUNTY HEALTH DEPARTMENT

BUREAU OF ENVIRONMENTAL HEALTH

~~XXXXXXX~~ 313-2640

DATE SYSTEM APPROVED _____

INSPECTOR _____

INDEXED

Collins Company IS PERMITTED TO INSTALL _____ ALTER

ADDRESS 7702 Gaither Road, Sykesville, Maryland 21784 PHONE 442-2235

SUBDIVISION _____ LOT _____ ROAD 6398 Shady Lane

PROPERTY OWNER Dr. Ernest Colvin
ADDRESS 6398 Shady Lane

SEPTIC TANK CAPACITY 1000 GALLONS

NUMBER OF BEDROOMS 2 TRAILER

_____ SQUARE FEET PER BEDROOM

LINEAR FEET OF TRENCH REQUIRED _____

PLACE 1000 GAL TANK
AT LONGEST TEST HOLE
RUN TRENCHES ALONG CONTOUR
IN NORTHERLY DIRECTION.

REPAIR - PURPOSE - ESTABLISH SEWAGE EASEMENT FOR FARM TRAILER. 12/14/92

180' INLET 3' BOTTOM 7' ; 4' STONE IN TRENCH
FOR 3BR HOUSE - 135' TOTAL TRENCH LENGTH
12/15/92 CW.

PLANS APPROVED BY _____ DATE _____

COVER NO WORK UNTIL INSPECTED AND APPROVED

NEITHER THE HOWARD COUNTY COUNCIL NOR THE HEALTH DEPARTMENT IS RESPONSIBLE FOR THE SUCCESSFUL OPERATION OF ANY SYSTEM

NOTE: CLEANOUT REQUIRED EVERY 70 FEET OF SEWER LINE AND/OR AT 90° SWEEPS IN LINES FROM HOUSE TO DRAIN FIELDS, 90° ELBOWS NOT ACCEPTABLE.

NOTE: ALL PARTS OF SEPTIC SYSTEMS (I.E. TANK, DISTRIBUTION BOX TRENCHES) TO BE 100 FEET FROM WELL (UNLESS OTHERWISE SPECIFICALLY AUTHORIZED)

NOTE: IF DEEP TRENCH(ES) ARE USED CALL FOR INSPECTION BEFORE AND AFTER PLACING GRAVEL IN TRENCH(ES)

NOTE: NO DRY WELL SHALL EXCEED 15 FOOT IN DIAMETER NO ABSORPTION TRENCH TO EXCEED 100 FEET IN LENGTH

NOTE: ALL PIPE FROM HOUSE TO SEPTIC TANK MUST BE CAST IRON OR SCHEDULE 35/40 PVC OR ABS

PERMIT VOID AFTER TWO YEARS


NOTE: INSTALL STAND PIPE ON SEPTIC TANK AND DRY WELL STAND PIPES MUST BE 6 INCHES IN DIAMETER CAST IRON. CONCRETE OR TERRA COTTA OR PVA OR ABS ACCEPTED. IF TOP OF SEPTIC TANK IS DEEPER THAN 3 FEET. MANHOLE TO GRADE REQUIRED.

NOTE: DISTRIBUTION BOXES MUST HAVE BAFFLES



***INSTALLER IS RESPONSIBLE FOR OBTAINING FINAL APPROVAL ON THIS PERMIT**

48754

#1 (L4)

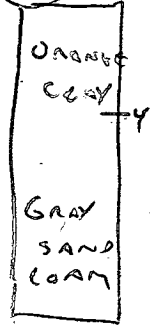

#2 (L3) #3 (L5)

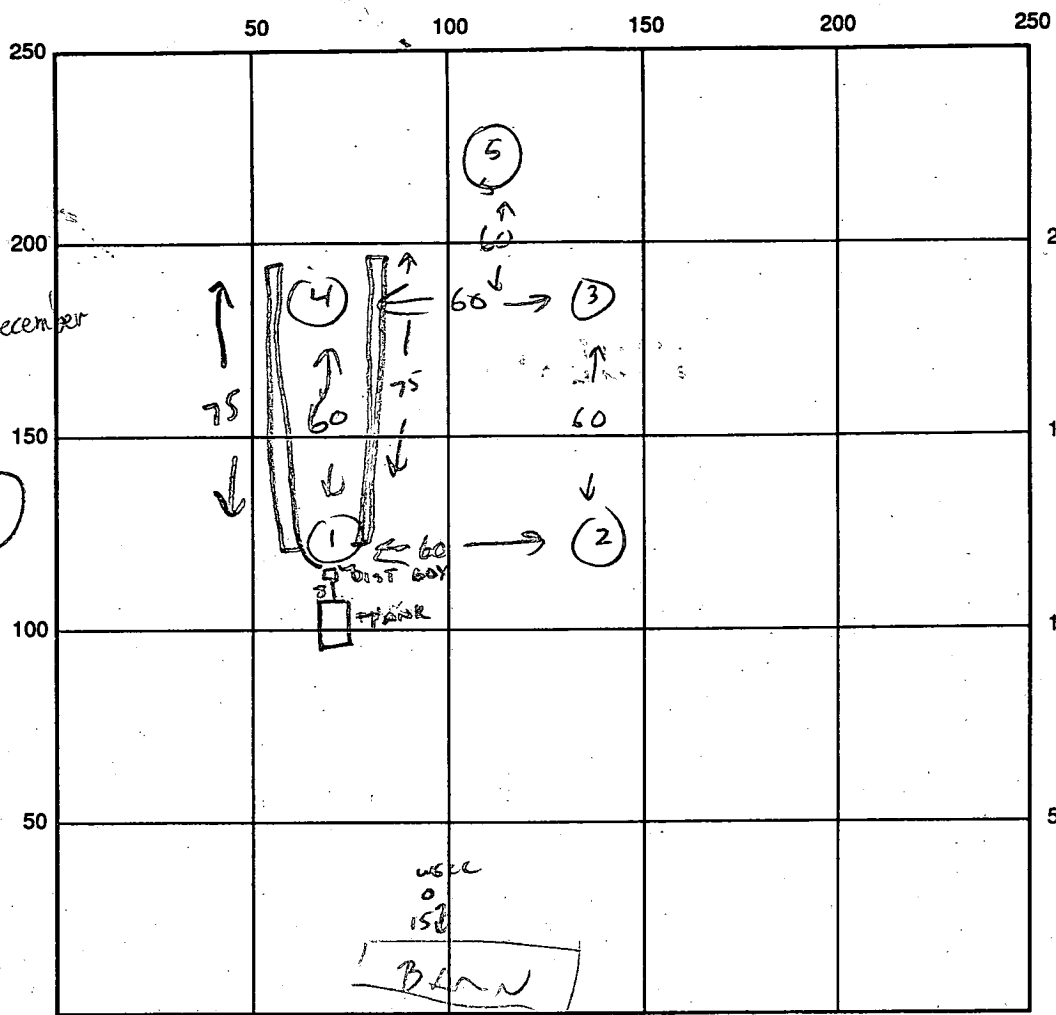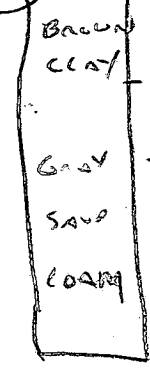

① 4' 12/59-1/03

② 3' 1/02-1/05-1/11

③ 4' 1/12-1/15-1/20

SEPTIC TANK LEVEL CLEANOUTS _____

DISTRIBUTION BOX LEVEL

DRAIN FIELD/TITLE DEPTH 7' FT. TRENCH WIDTH 2 FT. INLET DEPTH 3 FT.

EFFECTIVE GRAVEL DEPTH 4 FT. TOTAL LENGTH 150 FT.

NUMBER OF TRENCHES 2 @ 75' ONE SIDEWALL/BOTTOM AREA 600 SQ. FT.

DRYWALL INSIDE DIAMETER _____ FT. EFFECTIVE DEPTH BELOW INLET _____ FT.

ABSORBENT AREA _____ SQ. FT.

REMARKS: 12/15/92 5 TEST HOLES OK. WGL LINE BEING DUG TO CONNECT TO PRESSURE TANK IN BARN.

12/18 TRENCHES OK TO ADD STONE. 12/21 TRENCHES OK TO COVER.

NEEDS S.T. CLEANOUT & HOUSE SEWER LINE.

11/29/93 No answer @ trailer - appears all hooked up. all covered

DATE SYSTEM APPROVED _____ INSPECTOR _____

11/17/97 - No confirmation that septic was hooked up as of this date. A McMillen