

1/29/93 ASAP

File

PERMIT

SEWAGE DISPOSAL SYSTEM

DEPARTMENT OF HEALTH AND MENTAL HYGIENE

P 48962

A REPAIR

DISTRICT _____

DATE 2/22/93

DATE SYSTEM APPROVED 1/29/93

INSPECTOR C.B.D.

INDEXED

HOWARD COUNTY HEALTH DEPARTMENT

BUREAU OF ENVIRONMENTAL HEALTH

~~461-9933~~ 313-2640

Jack Fyock _____ IS PERMITTED TO INSTALL _____ ALTER X

ADDRESS _____ PHONE 988-9270

SUBDIVISION _____ LOT _____ ROAD 12685 Old Frederick Road

PROPERTY OWNER _____ Lalic
12685 Old Frederick Road

ADDRESS _____

SEPTIC TANK CAPACITY 1000 GALLONS

NUMBER OF BEDROOMS 3

125⁺ SQUARE FEET PER BEDROOM

LINEAR FEET OF TRENCH REQUIRED 56'

REPAIR - PURPOSE - SEPTIC SYSTEM HAS FAILED. ✓

Call for inspection when ground is opened so sanitarian can recommend repair. 01/27/93

1/29/93 At site (1) Trench off dry well - 2' wide; 56' long; 11' deep; 7' of stone; level 4' below original grade; 39 2' + soft effective absorbent sidewalk in trench + old dry well C.B.D.

PLANS APPROVED BY C. B. Streaker for "C. W." / C.B.D. at site DATE 1/29/93

COVER NO WORK UNTIL INSPECTED AND APPROVED

NEITHER THE HOWARD COUNTY COUNCIL NOR THE HEALTH DEPARTMENT IS RESPONSIBLE FOR THE SUCCESSFUL OPERATION OF ANY SYSTEM

NOTE: CLEANOUT REQUIRED EVERY 70 FEET OF SEWER LINE AND/OR AT 90° SWEEPS IN LINES FROM HOUSE TO DRAIN FIELDS, 90° ELBOWS NOT ACCEPTABLE.

NOTE: ALL PARTS OF SEPTIC SYSTEMS (I.E. TANK, DISTRIBUTION BOX TRENCHES) TO BE 100 FEET FROM WELL (UNLESS OTHERWISE SPECIFICALLY AUTHORIZED)

NOTE: IF DEEP TRENCH(ES) ARE USED CALL FOR INSPECTION BEFORE AND AFTER PLACING GRAVEL IN TRENCH(ES)

NOTE: NO DRY WELL SHALL EXCEED 15 FOOT IN DIAMETER NO ABSORPTION TRENCH TO EXCEED 100 FEET IN LENGTH

NOTE: ALL PIPE FROM HOUSE TO SEPTIC TANK MUST BE CAST IRON OR SCHEDULE 35/40 PVC OR ABS


PERMIT VOID AFTER TWO YEARS

NOTE: INSTALL STAND PIPE ON SEPTIC TANK AND DRY WELL STAND PIPES MUST BE 6 INCHES IN DIAMETER CAST IRON. CONCRETE OR TERRA COTTA OR PVA OR ABS ACCEPTED. IF TOP OF SEPTIC TANK IS DEEPER THAN 3 FEET. MANHOLE TO GRADE REQUIRED.

NOTE: DISTRIBUTION BOXES MUST HAVE BAFFLES

***INSTALLER IS RESPONSIBLE FOR OBTAINING FINAL APPROVAL ON THIS PERMIT**

P 48962

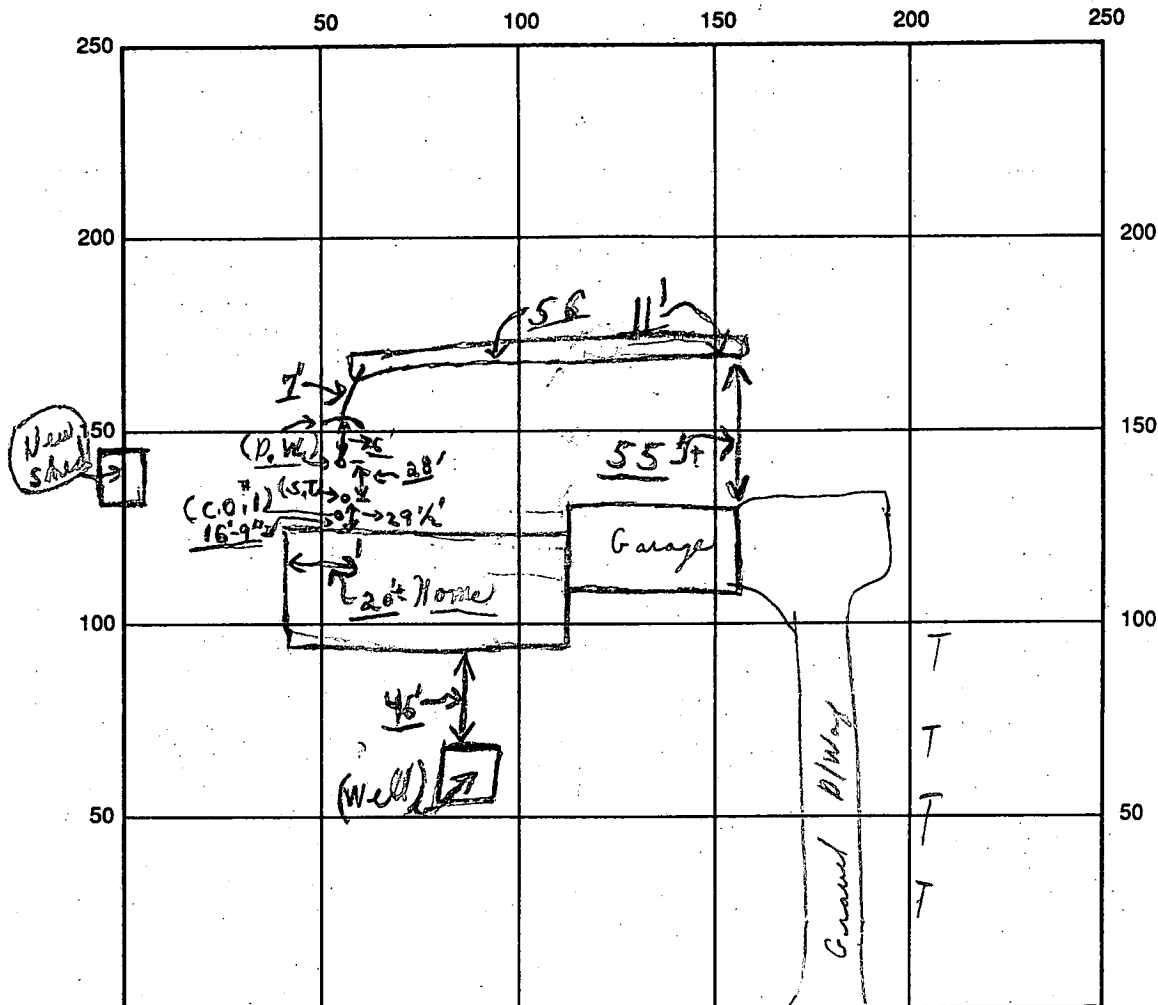

INDICATE NORTH - NAME ADJOINING ROADWAY AS BASE LINE

← OLD FREDERICK ROAD C.O.#1

SEPTIC TANK LEVEL	<u>Existing</u>	CLEANOUTS	<u>OK</u>	<u>S.T.</u>	<u>D.W.</u>
			<u>"NEW"</u>	<u>C.O.</u>	<u>C.O.</u>
DISTRIBUTION BOX LEVEL	<u>Using (Existing Dry Well)</u>			<u>OK</u>	<u>OK</u>
				<u>NEW</u>	<u>NEW</u>
DRAIN FIELD/TITLE DEPTH	<u>11</u> FT. ^{average}	TRENCH WIDTH	<u>2</u> FT.	INLET DEPTH	<u>4</u> FT.
EFFECTIVE GRAVEL DEPTH	<u>7</u> FT. ^{average}	TOTAL LENGTH	<u>56</u> FT. ^{+ (old dry well)}		
NUMBER OF TRENCHES	<u>1</u>	ONE SIDEWALL/AREA	<u>392</u> SQ. FT. ^{+(old dry well)}		
DRYWALL INSIDE DIAMETER	<u> </u> FT.	EFFECTIVE DEPTH BELOW INLET	<u> </u> FT.		
ABSORBENT AREA	<u>392</u> SQ. FT. ^{+(old dry well)}				

REMARKS: A.M. 1/29/93 (Repairs to 3 B.R. Home). New lines covered from home to septic tank; New trench off dry well; old to cover as finish; Material on site - Final

DATE SYSTEM APPROVED 1/29/93 INSPECTOR Charles Bryan Stricker

PERMIT

P 03176

SEWAGE DISPOSAL SYSTEM

A 02428

MARYLAND STATE DEPARTMENT OF HEALTH

HOWARD COUNTY

ELLCOTT CITY

INDEXED

DISTRICT 3

DATE 11-10-60

Hudson Con. Co. IS PERMITTED TO INSTALL ALTER

ADDRESS 3102 Glenmore Ave Baltimore 14, Md. PHONE Hamilton 6-6814

A SEWAGE DISPOSAL SYSTEM LOCATED AT _____

SUBDIVISION _____ ROAD Old Frederick Road, 1 mi

PROPERTY OWNER Guy Dainel and Mary Bizon ^{West Pt} 32

ADDRESS Old Fredrick Road

SPECIFICATIONS

DRAIN FIELD DEPTH _____ FEET, BOTTOM AREA _____ SQ. FT. 8 x 12 Dry Well

SEEPAGE PITS _____ ABSORBENT SIDE-WALL AREA _____ SQ. FT.

SEPTIC TANK CAPACITY 750 GALLONS

FOR GARBAGE GRINDER, INCREASE DISPOSAL AREA 22% & TANK CAPACITY 50%.


OTHER 8 x 12 Dry Well

PLANS APPROVED BY Palmer F. Wine DATE 6-1-60

FILL SEPTIC TANK AND DISTRIBUTION BOX WITH WATER BEFORE CALLING FOR AN INSPECTION. COVER NO WORK UNTIL INSPECTED AND APPROVED.

NEITHER THE HOWARD COUNTY COMMISSIONERS NOR THE HEALTH DEPARTMENT IS RESPONSIBLE FOR THE SUCCESSFUL OPERATION OF ANY SYSTEM.

A 02428

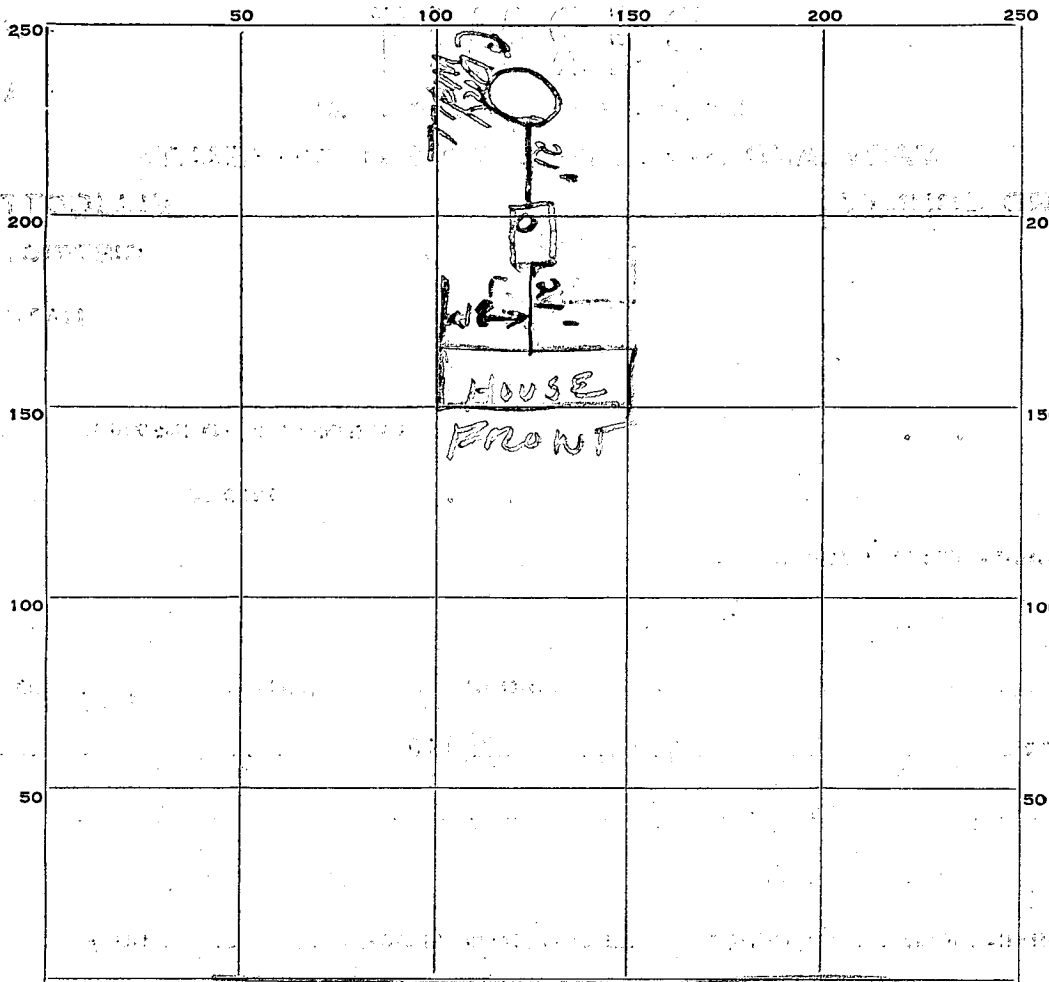

INDICATE NORTH. — NAME ADJOINING ROADWAY AS BASE LINE.

OLD FREDERICK Rd.

PERMIT CARD _____

SEPTIC TANK, LEVEL 1000.0/1000 CLEANOUTS at each junction

DISTRIBUTION BOX, LEVEL None

TILE FIELD, DEPTH _____ FT. TRENCH WIDTH _____ FT.

GRAVEL DEPTH _____ IN. TOTAL LENGTH _____ FT.

NUMBER OF TRENCHES _____ TOTAL BOTTOM AREA _____

SEEPAGE PITS, INSIDE DIAMETER 13 FT. DEPTH BELOW INLET 12 3/4 FT.

ABSORBENT AREA _____ SQ. FT.

REMARKS _____

DATE SYSTEM APPROVED 11-21-60

INSPECTOR Jeffrey

STATE OF MARYLAND

HOWARD COUNTY HEALTH DEPARTMENT ELLICOTT CITY, MARYLAND

Date

July 10

19

Name

Howard County Health Dept.

Telephone No.

410-336-6814

DETAILED LOCATION OF SITE, DEVELOPMENT,
SECTION, ROAD, LOT NO. & ELECTION DISTRICT

21 20

PRIVATE SEWAGE DISPOSAL SYSTEMS

Testing and Inspection

\$

Installation Permit

\$

1.00

Received
Payment

[Signature]

A 084282
03176
DUPLICATE

THIS RECEIPT IS NOT
A PERMIT AND IT IS
NOT A WARRANTY OF
PERFORMANCE OF
THE SYSTEM THAT
IS INSTALLED

STATE OF MARYLAND

HOWARD COUNTY HEALTH DEPARTMENT ELLICOTT CITY, MARYLAND

Date

7 Feb. 10

19

Name

Howard County

Telephone No.

410-575-6814

DETAILED LOCATION OF SITE, DEVELOPMENT,
SECTION, ROAD, LOT NO. & ELECTION DISTRICT

1009 Williams Road

D 32

PRIVATE SEWAGE DISPOSAL SYSTEMS

Testing and Inspection

\$

Installation Permit

\$

1.00

Received
Payment

John J. Stiles

A 00428 03176

TRIPPLICATE

THIS RECEIPT IS NOT
A PERMIT AND IT IS
NOT A WARRANTY OF
PERFORMANCE OF
THE SYSTEM THAT
IS INSTALLED

5/10/60
9:30
Cancelled
written in table

APPLICATION

A 02428

SEWAGE DISPOSAL TESTING

P 03176

MARYLAND STATE DEPARTMENT OF HEALTH

HOWARD COUNTY

ELLICOTT CITY

6/1/60 - 9:30

750 Tanks
8 x 12 dry-well

DISTRICT 3

DATE 5-4-60

TO: THE COUNTY HEALTH OFFICER
ELLICOTT CITY, MARYLAND

I, HEREBY, APPLY FOR THE NECESSARY TESTS IN ORDER TO CONSTRUCT (OR RECONSTRUCT) A SEWAGE DISPOSAL SYSTEM.

PROPERTY OWNER Guy Daniel Lalie & Mary Bizon Lalie

ADDRESS _____ PHONE _____

PROPERTY LOCATION:

SUBDIVISION _____ LOT NO. _____

ROAD AND DESCRIPTION Old Frederick Road, 1 mi. west Rt. 32

Slacks Corner - proceed W. on Rt. 99 - 1/2 mi. across from Slagles - property on R.

OCCUPANT _____ PHONE _____

PERSON TO CONSTRUCT SYSTEM _____

ADDRESS _____ PHONE _____

SIZE OF LOT 208 x 417 TYPE BLDG. residence 3
NUMBER OF BEDROOMS

IF NOT SINGLE RESIDENCE DESCRIBE _____

SIGNATURE OF APPLICANT Stato Leonardo


APPROVED BY Stato Leonardo FOR dry-well DATE 6/1/60
(KIND OF SYSTEM)

REJECTED BY _____ FOR _____ DATE _____
(KIND OF SYSTEM)

HOLD PENDING FURTHER TESTS _____ DATE _____

REASONS FOR REJECTION OR HOLDING _____

THIS IS NOT A PERMIT

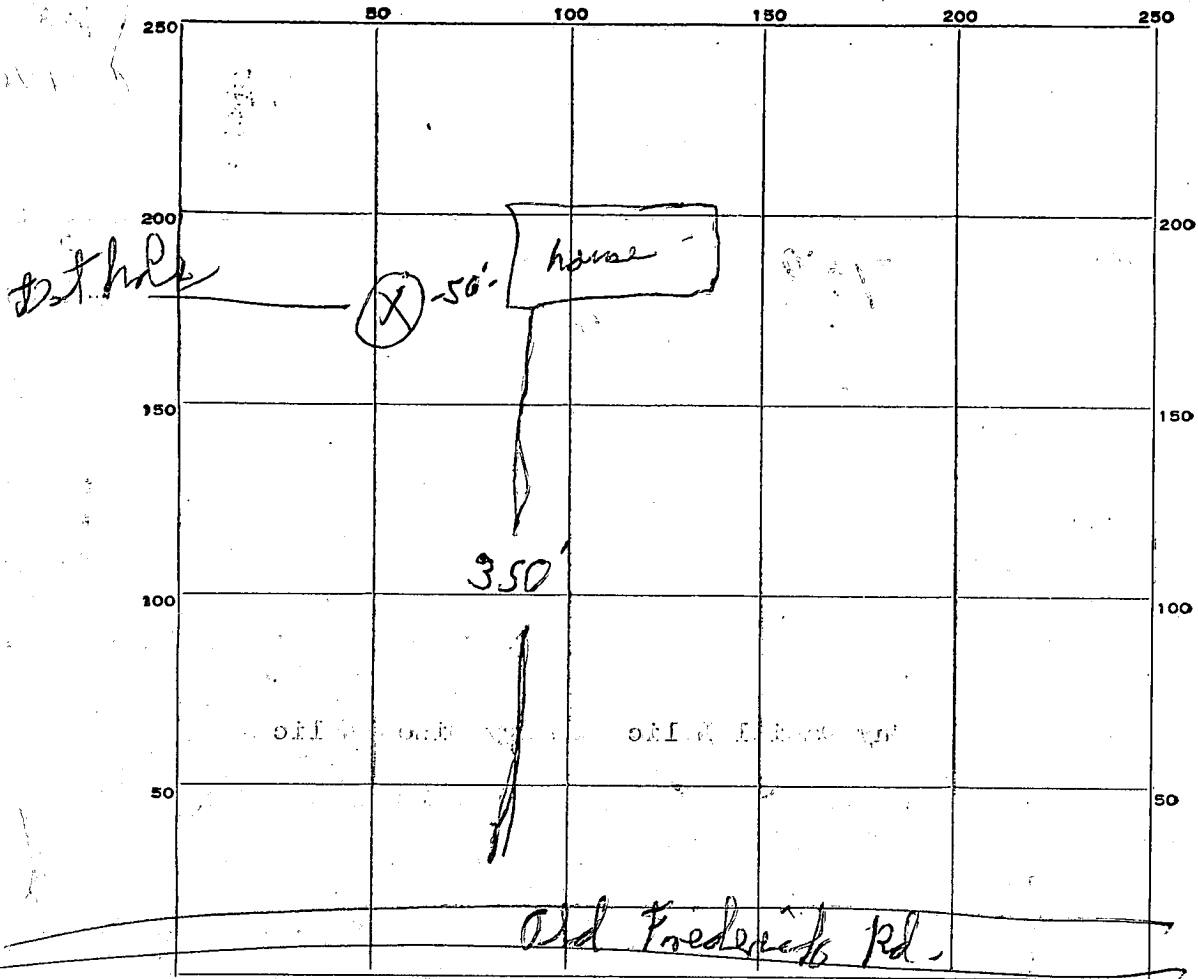

INDICATE NORTH. - NAME ADJOINING ROADWAY AS BASE LINE.

DATE	TEST NO.	DEPTH	PRE-WET		TEST - 1" DROP		TIME
			START	STOP	START	STOP	
9/1/60	1#	5'	10:04	10:08	10:08	10:13	5 min
		9'	10:06	10:14	10:14	10:22	8 min

SOIL AUGER FINDING sand & clay

TESTED BY Palmer F. Wine

REMARKS _____

ALSO PRESENT Carl A. Williams Sr. LOT NO. _____