

C1 6804

SEQUENCE NO. (DENV USE ONLY)

STATE OF MARYLAND WELL COMPLETION REPORT

FILL IN THIS FORM COMPLETELY PLEASE PRINT OR TYPE

THIS REPORT MUST BE SUBMITTED WITHIN 45 DAYS AFTER WELL IS COMPLETED.

COUNTY NUMBER

A# 48087

(THIS NUMBER IS TO BE PUNCHED IN COLS. 3-6 ON ALL CARDS)

Tag ID -- 03-293488

ST/CQ USE ONLY DATE RECEIVED

DATE WELL COMPLETED

Depth of Well

OKMR 6/19/92

PERMIT NO. FROM "PERMIT TO DRILL WELL"

Grid for ST/CQ USE ONLY DATE RECEIVED

060593

22 400 26 (TO NEAREST FOOT)

40-92-0070

OWNER ZIMMERMAN WM last name first name STREET OR RD 2115 MOUNT VIEW RD TOWN HARRIOTTSVILLE MD. SUBDIVISION SECTION LOT 21104

WELL LOG Not required for driven wells STATE THE KIND OF FORMATIONS PENETRATED, THEIR COLOR, DEPTH, THICKNESS AND IF WATER BEARING

Table with columns: DESCRIPTION (Use additional sheets if needed), FEET (FROM, TO), Check if water bearing. Rows include Top Soil, Clay, Shale, Sand Silt, Clay, Sand Stone, Mica, Sand Stone, Mica, Sand Stone, Mica.

HOLE FRAC'D

GROUTING RECORD WELL HAS BEEN GROUTED (Circle Appropriate Box) YES (Y) NO (N)

TYPE OF GROUTING MATERIAL CEMENT (CM) BENTONITE CLAY (BC) NO. OF BAGS 12 NO. OF POUNDS 1200 GALLONS OF WATER 60 DEPTH OF GROUT SEAL (to nearest foot) from 0 ft. to 40 ft.

CASING RECORD casing types insert appropriate code below ST CO STEEL CONCRETE PL OT PLASTIC OTHER

MAIN CASING TYPE Nominal diameter top (main) casing (nearest inch) Total depth of main casing (nearest foot) ST 6 95

OTHER CASING (if used) diameter inch depth (feet) from to

SCREEN RECORD screen type or open hole insert appropriate code below ST BR HO STEEL BRASS OPEN HOLE PL OT PLASTIC OTHER

Table for SCREEN RECORD with columns for depth (nearest ft.) and rows for each casing and screen.

C 3 PUMPING TEST

HOURS PUMPED (nearest hour) 3 PUMPING RATE (gal. per min. to nearest gal.) 1 METHOD USED TO MEASURE PUMPING RATE Bucket WATER LEVEL (distance from land surface) BEFORE PUMPING 50 WHEN PUMPING 400 TYPE OF PUMP USED (for test) A air P piston T turbine C centrifugal R rotary O other (describe below) J jet S submersible

PUMP INSTALLED DRILLER WILL INSTALL PUMP YES (NO)

IF DRILLER INSTALLS PUMP, THIS SECTION MUST BE COMPLETED FOR ALL WELLS EXCEPT HOME USE TYPE OF PUMP INSTALLED PLACE (A,C,J,P,R,S,T,O) IN BOX - SEE ABOVE: CAPACITY: GALLONS PER MINUTE (to nearest gallon) PUMP HORSE POWER PUMP COLUMN LENGTH (nearest ft.) CASING HEIGHT (circle appropriate box and enter casing height) LAND SURFACE (nearest foot)

CIRCLE APPROPRIATE LETTER A A WELL WAS ABANDONED AND SEALED WHEN THIS WELL WAS COMPLETED E ELECTRIC LOG OBTAINED P TEST WELL CONVERTED TO PRODUCTION WELL


I HEREBY CERTIFY THAT THIS WELL HAS BEEN CONSTRUCTED IN ACCORDANCE WITH COMAR 26.04.04 "WELL CONSTRUCTION" AND IN CONFORMANCE WITH ALL CONDITIONS STATED IN THE ABOVE CAPTIONED PERMIT AND THAT THE INFORMATION PRESENTED HEREIN IS ACCURATE AND COMPLETE TO THE BEST OF MY KNOWLEDGE.

DRILLERS IDENT. NO. 40 DRILLERS SIGNATURE (MUST MATCH SIGNATURE ON APPLICATION) SITE SUPERVISOR (sign. of driller or journeyman responsible for sitework if different from permittee)

SLOT SIZE 1 2 3 DIAMETER OF SCREEN (NEAREST INCH) GRAVEL PACK IF WELL DRILLED WAS FLOWING WELL INSERT F IN BOX 68

TELESCOPE CASING LOG INDICATOR OTHER DATA

LOCATION OF WELL ON LOT SHOW PERMANENT STRUCTURE SUCH AS BUILDING, SEPTIC TANKS, AND/OR LANDMARKS AND INDICATE NOT LESS THAN TWO DISTANCES (MEASUREMENTS TO WELL)

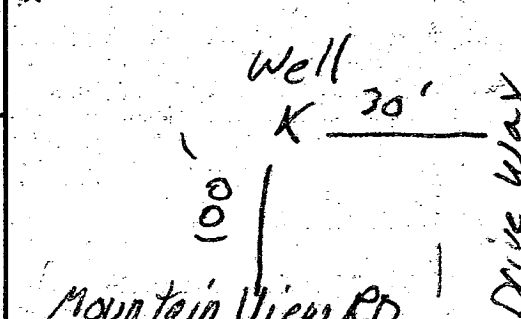

COUNTY

SITE INSPECTION SHEET

INSP MAY 7, 1992 10:00 ✓

OWNER: Zimmerman

DATE REQUESTED: 4-29-92

PHONE #: 442-1586

CONTRACTOR: George Easterday

ADDRESS: 2115 Mount View Road
Marriottsville, MD 21104


WELL TAG #: _____

COUNTY #: _____

PROPOSAL: Collapsed well - wants a replacement well
Site inspection scheduled for May 7, 1992,
Thursday, 10:00am to meet driller/owner.

TAX MAP 16 x
GRID 1 +
P. 275 x
ok
C. B.

LOCATION DIAGRAM

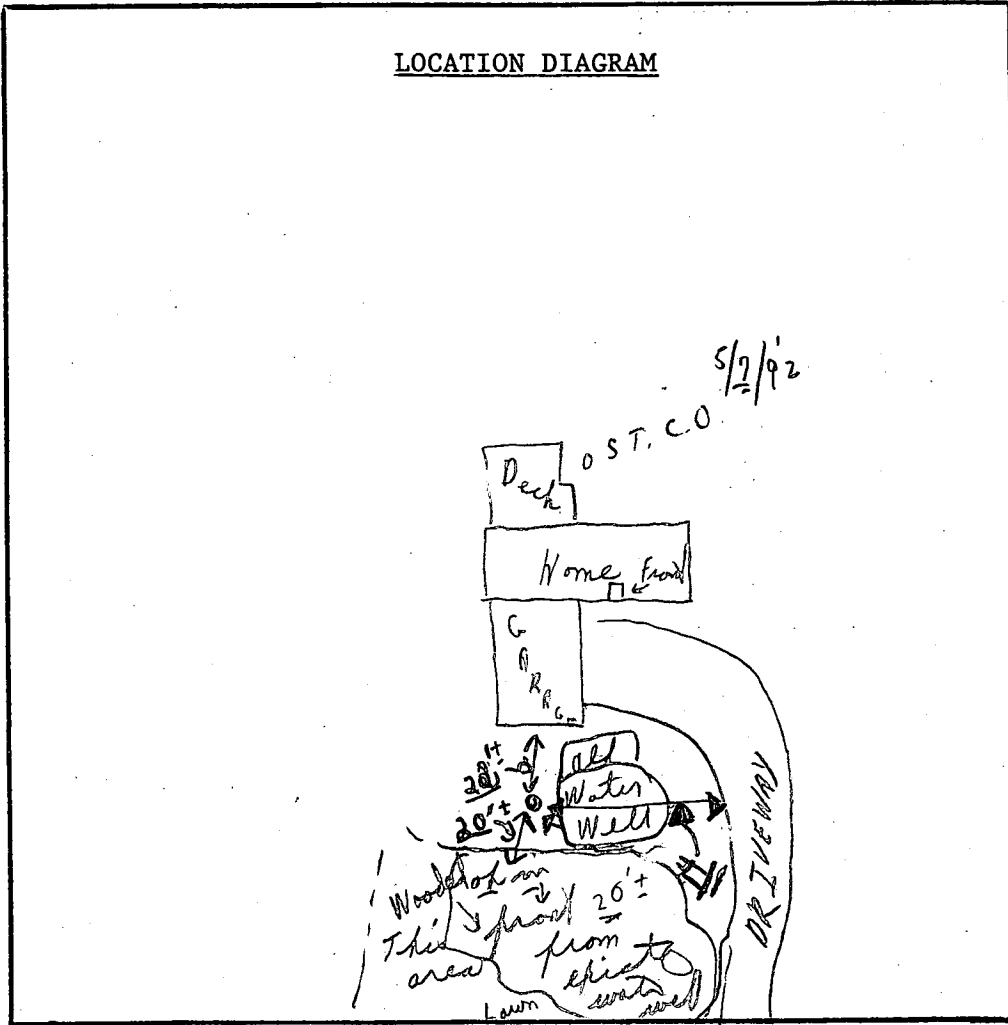

COMMENTS: States he has enough water for a shower JEN
A.M. 5/7/92 (see above drawing - please); Mr. Zimmerman
at home; Mr. Dan Easterday came in later (10:15)
with paperwork (Green Permit). Well site is 20' from edge
 DATE: 5/7/92 INSPECTOR: C. B. Street
water well and 30' + in front of home towards
road ok. C. B. R.S.

253.43 (DEED)
225.43 (COMP)

636.45'

671.80'

SEAL PERMIT SKIPPED
AND RETURNED 7/13/90
Serial # 53931-addition

New
16x17
addition

Add 5'x17'

N46°40'57"E

352°25'03"W

221'

1,100.83 TO THE BEGIN-
NING OF FOURTH OR
S41°W 1,138' LINE
OF 592/205

100' GRAVEL DRIVE
MOUNTAIN VIEW ROAD
N24°11'10"N 166.36'

7/12/90


ok
c.b.d.

Notes: No conflict with
existing water well
(2) septic system
See above

125739± SQ. FT.

THIS IS TO CERTIFY that I have located the
improvements on the 10' shown hereon, and that
said improvements are within the boundaries.
Improvements lie entirely within the boundaries.

Jonas [Signature]
PER RETCO ENGINEERING CO., INC.

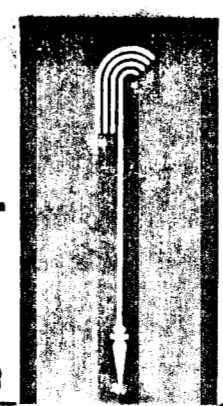

retco engineering co. inc.

313-14 Keyser Building
Baltimore, Maryland 21201

SCALE: 1"=50
DATE: 7-10-76

NOT INTENDED TO BE USED TO ESTABLISH PROPERTY LINES

761090