

PERMIT

SEWAGE DISPOSAL SYSTEM

DEPARTMENT OF HEALTH AND MENTAL HYGIENE

P 50427E

A 49282

DISTRICT 5th

DATE 12/3/94

DATE SYSTEM APPROVED 11/9/95

INSPECTOR *C. B. [Signature]*

HOWARD COUNTY HEALTH DEPARTMENT

BUREAU OF ENVIRONMENTAL HEALTH

XMAS98X 313-2640

INDEXED

Jack Fyock Septic Service

IS PERMITTED TO INSTALL ☒ ALTER

ADDRESS _____ PHONE 988-9270

SUBDIVISION Buck Haven Manor LOT 1 ROAD 12519 Scaggsville Road

PROPERTY OWNER Cornerstone Homes, Inc. Frank Duffy

ADDRESS

SEPTIC TANK CAPACITY 1250 GALLONS

NUMBER OF BEDROOMS 4

180 SQUARE FEET PER BEDROOM

LINEAR FEET OF TRENCH REQUIRED 144

TRENCHES - Trench to be 2 feet wide. Inlet 3 feet below original grade. Bottom maximum depth 8 feet below original grade. Effective area begins at 3 feet below original grade. 5 feet of stone below distribution pipe.

LOCATION - From the driveway in-common, place the distribution box 140 feet down the right (408') lot line and 40 feet off that lot line. Run trenches along contour toward back lot line, being certain to maintain at least 100 feet separation from wells on adjoining parcels.

NOTES - No trench to exceed 100 feet in length. Provide 6" - 8" diameter cleanout and cap to grade or above on septic tank. *OK And 11-7-94*

PLANS APPROVED BY C. Williams DATE 01/14/94

COVER NO WORK UNTIL INSPECTED AND APPROVED

NEITHER THE HOWARD COUNTY COUNCIL NOR THE HEALTH DEPARTMENT IS RESPONSIBLE FOR THE SUCCESSFUL OPERATION OF ANY SYSTEM

NOTE: CLEANOUT REQUIRED EVERY 70 FEET OF SEWER LINE AND/OR AT 90° SWEEPS IN LINES FROM HOUSE TO DRAIN FIELDS, 90° ELBOWS NOT ACCEPTABLE.

NOTE: ALL PARTS OF SEPTIC SYSTEMS (I.E. TANK, DISTRIBUTION BOX TRENCHES) TO BE 100 FEET FROM WELL (UNLESS OTHERWISE SPECIFICALLY AUTHORIZED)

NOTE: IF DEEP TRENCH(ES) ARE USED CALL FOR INSPECTION BEFORE AND AFTER PLACING GRAVEL IN TRENCH(ES)

NOTE: NO DRY WELL SHALL EXCEED 15 FOOT IN DIAMETER NO ABSORPTION TRENCH TO EXCEED 100 FEET IN LENGTH

NOTE: ALL PIPE FROM HOUSE TO SEPTIC TANK MUST BE CAST IRON OR SCHEDULE 35/40 PVC OR ABS


PERMIT VOID AFTER TWO YEARS

NOTE: INSTALL STAND PIPE ON SEPTIC TANK AND DRY WELL STAND PIPES MUST BE 6 INCHES IN DIAMETER CAST IRON. CONCRETE OR TERRA COTTA OR PVA OR ABS ACCEPTED. IF TOP OF SEPTIC TANK IS DEEPER THAN 3 FEET. MANHOLE TO GRADE REQUIRED.

NOTE: DISTRIBUTION BOXES MUST HAVE BAFFLES

***INSTALLER IS RESPONSIBLE FOR OBTAINING FINAL APPROVAL ON THIS PERMIT**

A 49282

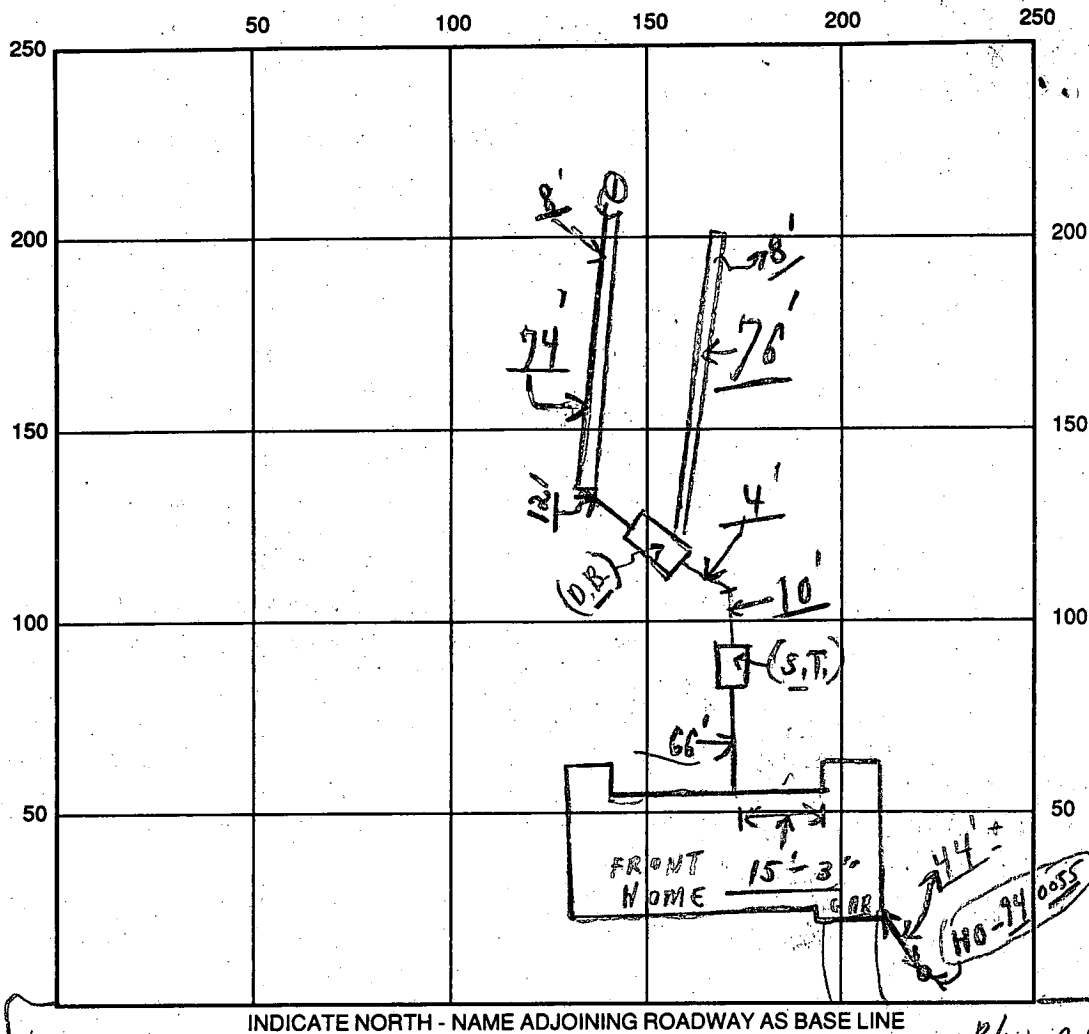

INDICATE NORTH - NAME ADJOINING ROADWAY AS BASE LINE

R/W GRAVEL ROAD

SEPTIC TANK LEVEL OK CLEANOUTS S.T. OK

DISTRIBUTION BOX LEVEL OK

DRAIN FIELD/TITLE DEPTH 8 (pay end) FT. TRENCH WIDTH 2 FT. INLET DEPTH 3 FT.

EFFECTIVE GRAVEL DEPTH 5 FT. { TOTAL LENGTH 74' + 76' = 150 FT. }

NUMBER OF TRENCHES 2 ONE SIDEWALL/ ~~BOTTOM~~ AREA 750 SQ. FT.

DRYWALL INSIDE DIAMETER — FT. EFFECTIVE DEPTH BELOW INLET — FT.

ABSORBENT AREA 750 SQ. FT.

REMARKS: 11/9/94 P. I. checked; 1st. check - ok to finish ends of 2 trenches
+ Front - ok to cover a finish - last trench, material
on site; (p.s.)

11/9 No. W. P. I. C.R.

DATE SYSTEM APPROVED 11/9/94 INSPECTOR Charles Bryan Steak

JUNE 14-17, 1993

APPLICATION

PERCOLATION TESTING

A 49282

P _____

HOWARD COUNTY HEALTH DEPARTMENT

BUREAU OF ENVIRONMENTAL HEALTH

3525-H ELLICOTT MILLS DRIVE/ELLICOTT CITY, MARYLAND 21043

TELEPHONE: 313-2640

DISTRICT Fifth

DATE MAY 26, 1993

TO: THE COUNTY HEALTH OFFICER
ELLICOTT CITY, MARYLAND

I HEREBY APPLY FOR THE NECESSARY TEST PRIOR TO APPLICATION FOR PERMIT TO CONSTRUCT (OR RECONSTRUCT) A SEWAGE DISPOSAL SYSTEM.

PROPERTY OWNER CATHERINE CLAVINGER CORNERSTONE HOMES, INC.

ADDRESS 12459 SCAGGSVILLE ROAD PHONE 531-5991 379-0157

AGENT OR PROSPECTIVE BUYER SAME AS ABOVE

ADDRESS _____ PHONE _____

PROPERTY LOCATION:

SUBDIVISION CLAVINGER PROPERTY LOT NO. 1

ROAD AND DESCRIPTION 1400'± NORTHWEST FROM INTERSECTION OF BROWN'S BRIDGE ROAD AND MARYLAND ROUTE 216
(12579 SCAGGSVILLE ROAD)

TAX MAP 40 PARCEL # 138

SIZE OF LOT 46,000 Sq. Ft. TYPE BLDG. SINGLE FAMILY Single # 53977
(SINGLE FAMILY DWELLING OR COMMERCIAL)
SFD- 4Bm

BLDG. PERMIT SIGNED
AND RETURNED 9/13/94

THE SYSTEM INSTALLED UNDER THIS APPLICATION IS ACCEPTABLE ONLY UNTIL PUBLIC FACILITIES BECOME AVAILABLE. I FULLY UNDERSTAND THE

FEE CONNECTED WITH THE FILING OF THIS PERC. TEST APPLICATION IS NON-REFUNDABLE UNDER ANY CIRCUMSTANCES. I ALSO AGREE TO

COMPLY WITH ALL M.O.S.H.A. REQUIREMENTS IN TESTING THIS LOT. [Signature]
(SIGNATURE OF APPLICANT)

APPROVED BY _____ FOR _____ DATE _____

DISAPPROVED BY _____ FOR _____ DATE _____

HOLD PENDING FURTHER TESTS _____

REASONS FOR REJECTION OR HOLDING 6/16/93 PERC OK HOLD FOR PLAT R.H.

PERCOLATION TEST PLAT/PRELIMINARY PLAT - TITLE OR I.D. # _____ DATE _____

SITE DEVELOPMENT PLAN/FINAL PLAT - TITLE OR I.D. # _____ DATE _____

THIS IS NOT A PERMIT

49282

LOT 1

LOT 1


COUNTY #

ONLINE SOIL PROFILE

0' TOPSOIL BROWN CLAY
3' BROWN SAND LOAM

11' TOPSOIL REDDISH CLAY
3' DULL BROWN & WHITE SAND LOAM

4' TOPSOIL RED CLAY
PINK WHITE BROWN SAND LOAM

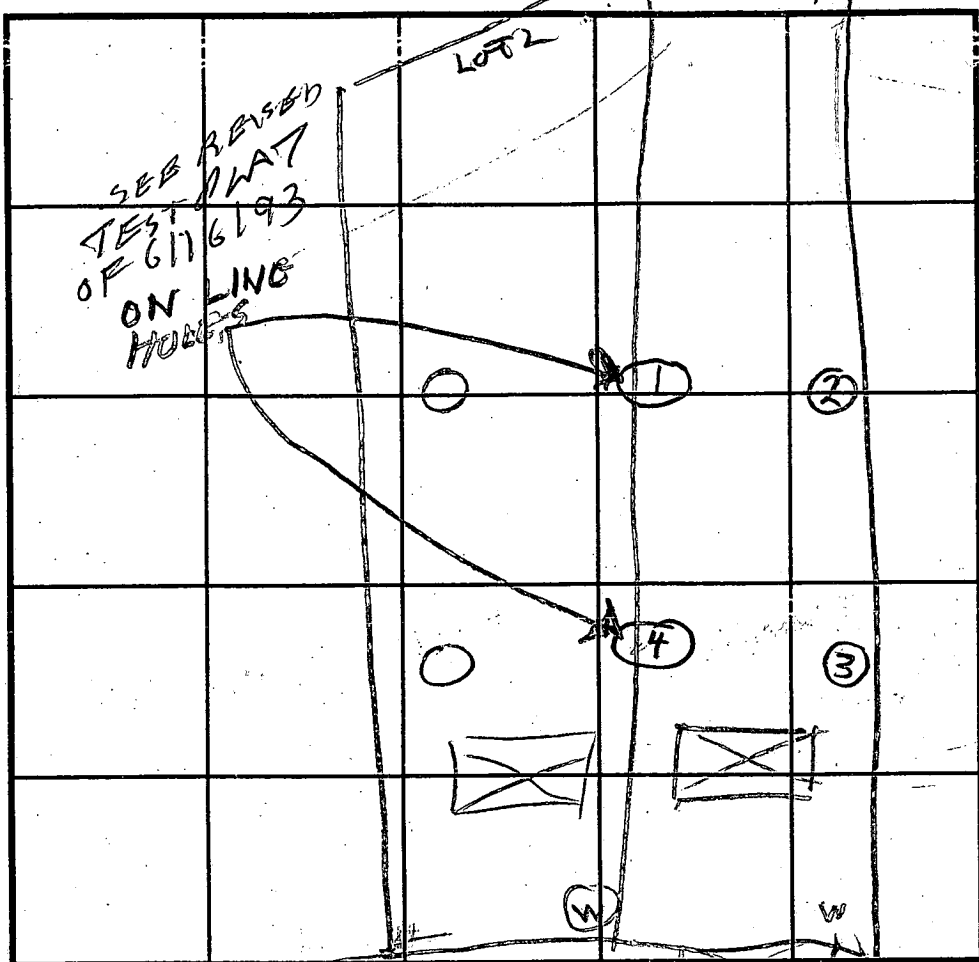

INDICATE NORTH - NAME ADJOINING ROADWAY AS BASE LINE.

ROAD

ONLINE SOIL PROFILE

0' TOPSOIL RED CLAY
3' PINK BROWN & WHITE SAND LOAM
11.5'

HOLE ELEVATION

③ = HIGH

①②④ = LOW




DATE	TEST NO.	DEPTH	PRE-WET		TEST - 1" DROP		TIME
			START	STOP	START	STOP	
6/15/93	1S	4.5	239	240	240	244	4
	1V	11	OK				
	2S	4.5	247	249	249	252	3
	2V	11	OK				
	3V	12.5	OK				
	4S	4.5	300	302	302	305	3
	4V	7.5	300	301	301	302	1
	4V	11.5	OK				

ON LINE HOLE LOT 1 & 2

IN COMMON HOLE LOT 1 & 2

artime 3 MIN max depth 3 ft

REMARKS: Holes Dug per REVISED TEST PLAT OF 6/11/93
 TYPE OF SOIL: CROWN
 TESTED BY: R. HODGES ALSO PRESENT: U. KETTERMAN JR
 TRENCH DESIGN DATA: AVERAGE PERCOLATION TIME 3 TRENCH WIDTH 2
 INLET DEPTH 3 MAXIMUM BOTTOM DEPTH 8 SQ. FT./BEDROOM 180

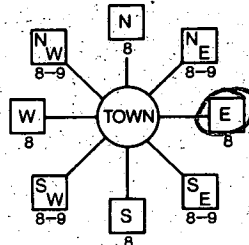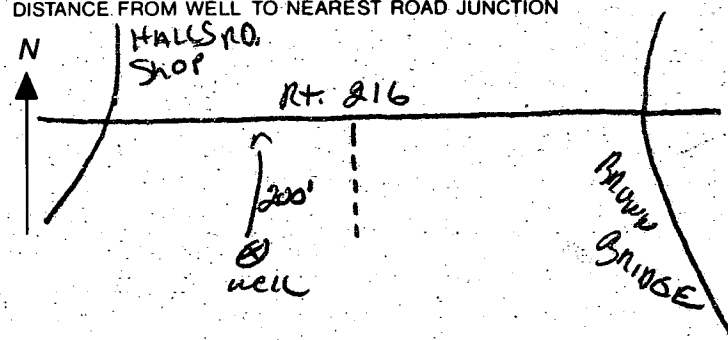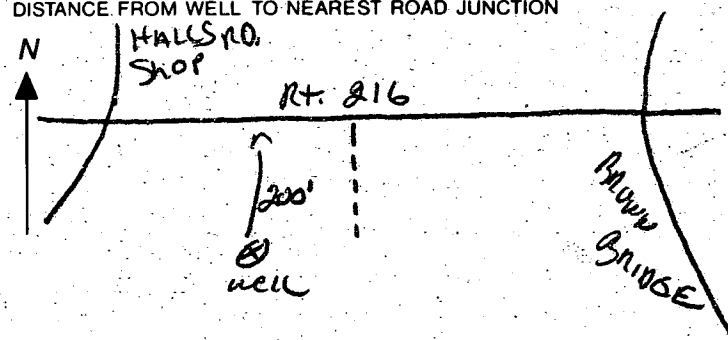B 1 1211	SEQUENCE NO. (DP USE ONLY)	STATE OF MARYLAND APPLICATION FOR PERMIT TO DRILL WELL please print or type	STATE PERMIT NUMBER H0-94-0055 70 fill in this form completely 79
Date Received (APA) 032194		B 3 LOCATION OF WELL HOWARD 8 COUNTY CLEVENGER 21 23 SUBDIVISION HIGHLAND 52 NEAREST TOWN MILES FROM TOWN (enter 0 if in town) 1 73 76 77 78	
OWNER INFORMATION BUCKS HAVEN FARM 15 Last Name 13 Owner 34 First Name 12459 RT 216 36 Street or RFD 55 HIGHLAND 57 Town 70 State 72 Zip 78		B 4 DIRECTION OF WELL FROM TOWN (CIRCLE BOX) 	
DRILLER INFORMATION MSD/MGD/MWD RALPH MAYNE 77 License No. 80 RALPH MAYNE WELL DRILLING Firm Name 9120 Brown Church Rd. Mt. Airy Address Ralph Mayne 3/15/94 Signature Date		NEAR WHAT ROAD MD RT 216 11 30 ON WHICH SIDE OF ROAD (CIRCLE APPROPRIATE BOX) 200 34 37 DISTANCE FROM ROAD ENTER FT OR MI Ft 38 39 TAX MAP: _____ BLK: _____ PARCEL: _____	
B 2 WELL INFORMATION APPROX. PUMPING RATE (GAL. PER MIN.) 5 8 12 AVERAGE DAILY QUANTITY NEEDED (GAL. PER DAY) 500 14 20		NOT TO BE FILLED IN BY DRILLER HEALTH DEPARTMENT APPROVAL Howard COUNTY NAME W49933C COUNTY NO. STATE SIGNATURE _____ INSERT S 41 DATE ISSUED 040594 43 Catherine Sol 48 CO SIGNATURE 04/05/95 EXP. DATE NORTH GRID 486000 50 55 EAST GRID 0814000 57 63	
USE FOR WATER (CIRCLE APPROPRIATE BOX) ☒ HOME (SINGLE OR DOUBLE HOUSEHOLD UNIT ONLY) ☐ FARMING (LIVESTOCK WATERING & AGRICULTURAL IRRIGATION) ☐ INDUSTRIAL, COMMERCIAL, STATE AND FEDERAL GOV. OTHER (REQUIRES APPROPRIATION PERMIT) ☐ PUBLIC OR PRIVATE WATER COMPANY (REQUIRES APPROPRIATION PERMIT AND STATE HEALTH DEPARTMENT APPROVAL) ☐ TEST, OBSERVATION, MONITORING (MAY REQUIRE APPROPRIATION PERMIT)		SHOW MAJOR FEATURES OF BOX & LOCATE WELL WITH AN X SOURCES OF DRILLING WATER 1. well 2. 3. WRITE THE BOX NUMBER FROM THE MAP HERE 8104 4806	
APPROXIMATE DEPTH OF WELL 150 FEET 24 28 APPROXIMATE DIAMETER OF WELL 6" INCH NEAREST		5/4/94 G. row 9:30 missed insp. 	
METHOD OF DRILLING (circle one) BORED (or Augered) ☒ AIR-ROTARY ☐ AIR-PERCussion ☐ JETTED ☐ Jettied & DRIVEN ☐ ROTARY (Hydraulic Rotary) CABLE ☐ REVERSE-ROTARY ☐ DRIVE-POINT other _____		DRAW A SKETCH BELOW SHOWING LOCATION OF WELL IN RELATION TO NEARBY TOWNS AND ROADS AND GIVE DISTANCE FROM WELL TO NEAREST ROAD JUNCTION 	
REPLACEMENT OR DEEPEMED WELLS (CIRCLE APPROPRIATE BOX) ☒ THIS WELL WILL NOT REPLACE AN EXISTING WELL ☐ THIS WELL WILL REPLACE A WELL THAT WILL BE ABANDONED AND SEALED ☐ THIS WELL WILL REPLACE A WELL THAT WILL BE USED AS A STANDBY-CONTACT LOCAL APPROVING AUTHORITY FOR POLICY ON STANDBY WELLS ☐ THIS WELL WILL DEEPEN AN EXISTING WELL PERMIT NUMBER OF WELL TO BE REPLACED OR DEEPEMED (IF AVAILABLE) 41 52		Not to be filled in by driller (OEP USE ONLY) APPROX. PERMIT NUMBER GAP 54 63	
FORCE CS 67 68 WRITE INITIALS IN BOX PERMIT No. H0-94-0055 70 71 72 73 74 75 76 77 78 79		SPECIAL CONDITIONS CATHERINE CLEVENGER 854-2018 - 531-5591 NOTE - APPROVING AUTHORITIES SHOULD USE SEPARATE SHEET IF NEEDED =	

C 1	8804	SEQUENCE NO. (DENY USE ONLY)	STATE OF MARYLAND WELL COMPLETION REPORT		THIS REPORT MUST BE SUBMITTED WITHIN 45 DAYS AFTER WELL IS COMPLETED.	
(THIS NUMBER IS TO BE PUNCHED IN COLS. 3-6 ON ALL CARDS)		FILL IN THIS FORM COMPLETELY PLEASE PRINT OR TYPE		COUNTY NUMBER <u>W 497330</u>		
ST/CO USE ONLY, DATE Received		DATE WELL COMPLETED		Depth of Well		PERMIT NO. FROM "PERMIT TO DRILL WELL"
		050494		205		110-99-0055
OWNER <u>FRANKS INVESTMENT CORP</u> first name <u>FRANKS</u> TOWN <u>HIGHTOWNS</u>						
STREET OR RFD. <u>Rte. 216</u> SECTION <u>1</u> LOT <u>1</u>						
SUBDIVISION <u>Stonegate Property</u>						

WELL LOG			GROUTING RECORD		
Not required for driven wells			WELL HAS BEEN GROUTED		
STATE THE KIND OF FORMATIONS PENETRATED, THEIR COLOR, DEPTH, THICKNESS AND IF WATER BEARING			(Circle Appropriate Box)		
DESCRIPTION (Use additional sheets if needed)			TYPE OF GROUTING MATERIAL		
FEET			CEMENT ☒ BENTONITE CLAY ☒		
FROM TO			NO. OF BAGS <u>11</u> NO. OF POUNDS <u>1100</u>		
Check if water bearing			GALLONS OF WATER <u>66</u>		
Top Soil 0 2			DEPTH OF GROUT SEAL (to nearest foot)		
Sandy 2 40			from <u>0</u> ft. to <u>20</u> ft.		
Sand Stone 40 45			(enter 0 if from surface)		
MICKA 45 65			Casing types insert appropriate code below		
Sand Stone 65 70			STEEL ☒ CONCRETE ☒		
MICKA 70 205			PLASTIC ☒ OTHER ☒		
			MAIN CASING TYPE		
			Nominal diameter top (main) casing (nearest inch)		
			Total depth of main casing (nearest foot)		
			OTHER CASING (if used)		
			diameter inch		
			depth (feet) from to		
			SCREEN RECORD		
			screen type or open hole		
			STEEL ☒ BRASS ☒ OPEN HOLE ☒		
			BRONZE ☒ PLASTIC ☒ OTHER ☒		
			C 2		
			DEPTH (nearest ft.)		
			1 2 3 4 5 6 7 8 9 10 11 12 13 14 15 16 17 18 19 20 21		
			2 3 4 5 6 7 8 9 10 11 12 13 14 15 16 17 18 19 20 21		
			3 4 5 6 7 8 9 10 11 12 13 14 15 16 17 18 19 20 21		
			4 5 6 7 8 9 10 11 12 13 14 15 16 17 18 19 20 21		
			5 6 7 8 9 10 11 12 13 14 15 16 17 18 19 20 21		
			6 7 8 9 10 11 12 13 14 15 16 17 18 19 20 21		
			7 8 9 10 11 12 13 14 15 16 17 18 19 20 21		
			8 9 10 11 12 13 14 15 16 17 18 19 20 21		
			9 10 11 12 13 14 15 16 17 18 19 20 21		
			10 11 12 13 14 15 16 17 18 19 20 21		
			11 12 13 14 15 16 17 18 19 20 21		
			12 13 14 15 16 17 18 19 20 21		
			13 14 15 16 17 18 19 20 21		
			14 15 16 17 18 19 20 21		
			15 16 17 18 19 20 21		
			16 17 18 19 20 21		
			17 18 19 20 21		
			18 19 20 21		
			19 20 21		
			20 21		
			21		
			22		
CIRCLE APPROPRIATE LETTER		PUMPING TEST	
A A WELL WAS ABANDONED AND SEALED WHEN THIS WELL WAS COMPLETED		HOURS PUMPED (nearest hour) <u>3</u>	
E ELECTRIC LOG OBTAINED		PUMPING RATE (gal. per min. to nearest gal.) <u>12</u>	
P TEST WELL CONVERTED TO PRODUCTION WELL		METHOD USED TO MEASURE PUMPING RATE <u>Bucket</u>	
WATER LEVEL (distance from land surface)		BEFORE PUMPING <u>34</u>	
WHEN PUMPING <u>46</u>		TYPE OF PUMP USED (for test)	
A air		P piston	
C centrifugal		R rotary	
J jet		S submersible	
T turbine		O other (describe below)	
PUMP INSTALLED			
DRILLER WILL INSTALL PUMP YES ☒ NO ☐			
(CIRCLE) (YES or NO)			
IF DRILLER INSTALLS PUMP, THIS SECTION MUST BE COMPLETED FOR ALL WELLS EXCEPT HOME USE			
TYPE OF PUMP INSTALLED			
PLACE (A,C,J,P,R,S,T,O)			
IN BOX - SEE ABOVE:			
CAPACITY:			
GALLONS PER MINUTE (to nearest gallon)			
PUMP HORSE POWER			
PUMP COLUMN LENGTH (nearest ft.)			
CASING HEIGHT (circle appropriate box and enter casing height)			
LAND SURFACE			
(nearest foot)			
LOCATION OF WELL ON LOT			
SHOW PERMANENT STRUCTURE SUCH AS BUILDING, SEPTIC TANKS, AND/OR LANDMARKS AND INDICATE NOT LESS THAN TWO DISTANCES (MEASUREMENTS TO WELL)			

I HEREBY CERTIFY THAT THIS WELL HAS BEEN CONSTRUCTED IN ACCORDANCE WITH COMAR 26.04.04 'WELL CONSTRUCTION' AND IN CONFORMANCE WITH ALL CONDITIONS STATED IN THE ABOVE CAPTIONED PERMIT, AND THAT THE INFORMATION PRESENTED HEREIN IS ACCURATE AND COMPLETE TO THE BEST OF MY KNOWLEDGE.		GRAVEL PACK	
DRILLERS IDENT. NO. <u>116</u>		IF WELL DRILLED WAS FLOWING WELL INSERT F IN BOX 68	
DRILLERS SIGNATURE <u>Nash Mayne</u>		TELESCOPE CASING	
(MUST MATCH SIGNATURE ON APPLICATION)		LOG INDICATOR	
SITE SUPERVISOR (sign. of driller or journeyman responsible for sitework if different from permittee)		OTHER DATA	

HOWARD COUNTY HEALTH DEPARTMENT
Bureau of Environmental Health
3525-H Ellicott Mills Drive
Ellicott City, MD 21043
461-9933

WELL permit
only!

OK
Final
11/10/94

APPLICATION FOR PITLESS ADAPTER, WELL PUMP AND PRESSURE TANK INSTALLATION

New Installation ☒
Replacement ☐

Receipt # -0-
Date September 22, 1994

Name of Installer CHARLES A. KLEIN & SONS, INC. Telephone (410) 549-6960

License Number 6521

Certified Well Pump Installer ☐ Well Driller ☐ Registered Plumber ☐

Name of Property Owner CORNERSTONE HOMES Telephone (410) 379-0157

Subdivision BUCKS HAVEN MANOR Lot # 1 Well Tag # NO - 94 - 0055

Site Address 12519 SCAGGSVILLE RD. HIGHLAND, MD 20777

Pump

- Type
 - Deep well jet ☐
 - Shallow well jet ☐
 - Submersible ☐
- Make ☐
- Model # ☐
- Capacity ☐ GPM
- Pump exceeds well capacity Yes ☐ No ☐
- If Yes, is low pressure cutoff switch installed? Yes ☐ No ☐
- What methods are used to protect the pump and electrical wiring from vibrations? Torque arrestors ☐ Cable guards ☐ Other ☐

Motor

- Horsepower ☐
- RPM ☐
- Voltage ☐
 - 110 ☐
 - 220 ☐

Pitless Adapter

- Make ☐
- Model # ☐
- Depth ☐

Tank

- Capacity ☐
- Pressure relief valve? ☐

Piping

- Type ☐
- Size ☐
- NSF and/or BOCA Code approved ☐
- Depth of supply line ☐

Well data

- Depth ☐ ft.
- Yield ☐ GPM
- Static water level ☐ ft.
- Will water supply be disinfected by installer? ☐

I understand that it is my responsibility to notify the Howard County Health Department when the installation is ready for inspection (otherwise this permit is null and void).

All information given above is true to the best of my knowledge.

Signature of Applicant: Charles A. Klein Jr.

Date: September 22, 1994

GREEN


Note: A sticker indicating approval/status of the installation will be placed on the well casing at the time of the inspection.

Note 11/10 - all covered except @. y
[at Well casing only] cbe

PAVING BEGIN CURB EDGE

PROPERTY OF
ARTHUR & CHARLOTTE
AYRE

EXISTING DWELLINGS

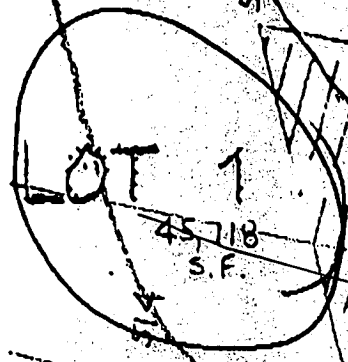

OK to
Sign
MR 12/12/94

DRIVE

FF 524
B 512

CLEVELAND
LOTS

LOT 2

EXISTING
WELL

100'

N60°11'30"W

326.83'

B.R.L.

308

306

A49284

60'

5

50'

15' 15'

100'

284.26'

S 44°00'00"E

3400

100' 121.00'

30'

51.00' N 27.53° E

25.12.4'

313-2640

(166.878 351 METERS)
N 547.500'
(404.704 50 METERS)
E 1327.000'

MOVE AREA
TO REAR
OF SEPTIC
ESMT.
TO ALLOW
20' CLEARANCE
FROM HOUSE

NOTE:
FOR FLAG OR PIPE STEM LOTS, REFUSE COLLECTION,
SNOW REMOVAL, AND ROAD MAINTENANCE TO BE
PROVIDED AT THE JUNCTION OF FLAG OR PIPE STEM
AND THE ROAD R/W AND NOT ONTO THE FLAG OR
PIPE STEM DRIVEWAY.

OK TO
SUBMIT
THIS
ADJUSTMENT
ON BP
SITE PLAN
REVISION
9/21/94
C. Carter

APPROVAL
PAG 10-32/L
(9-13-94)
GIVEN TO
SITE PLAN
-BP 55971.06D
THAT PROVIDES
NO CONFLICT
w/ 5671C MAGA

MARYLAND

SCAGGSVILLE

EXISTING ROADWAY CENTERLINE

EXISTING ROADWAY R.O.I.

SEE ENLARGEMENT "A"
THIS SHEET

EXISTING PAVING

B.R.L.
VEHICULAR

PROPERTY OF
KENNETH & DYON
MASTERS
LIBER No. 1072, FOLIO 734

PROPERTY OF
ARTHUR & CHARLOTTE
DYER
LIBER No. 240, FOLIO 184

PROPERTY OF
ROBERT & RUTH
ELDER
LIBER No. 520, FOLIO 37

PROPERTY OF
JENNINGS & AUDREY
GATHER
LIBER No. 239, FOLIO 68

LOT 1
48,988 Sq.Ft.
OR 1.125 AC.
B.R.L.
50'
1 1/4" Iron
Pipe Found

LOT 2
47,316 Sq.Ft.
OR 1.086 AC.
B.R.L.
50'
N45°05'58"W
170.42'
N21°56'53"E

1 1/4" Iron
Pipe Found (Bent)
Not Held

1" Iron
Pipe Found
1" Iron
Pipe Found

1" Iron
Pipe Found

LOT 4
51,580 Sq.Ft.
OR 1.184 AC.
B.R.L.

SEE ENLARGEMENT "B"
THIS SHEET


PRIVATE 50' USE-IN-COMMON ACCESS
EASEMENT TO LOTS 1, 2, 3

LOT 3

Approved Septic System Plan
Howard County Health Department

Signature Shirley MacM...
Date 9-13-94

TRENCH LENGTH TYPICAL
ACTUAL DESIGN by 011 P. 111-131
HEALTH Dept.

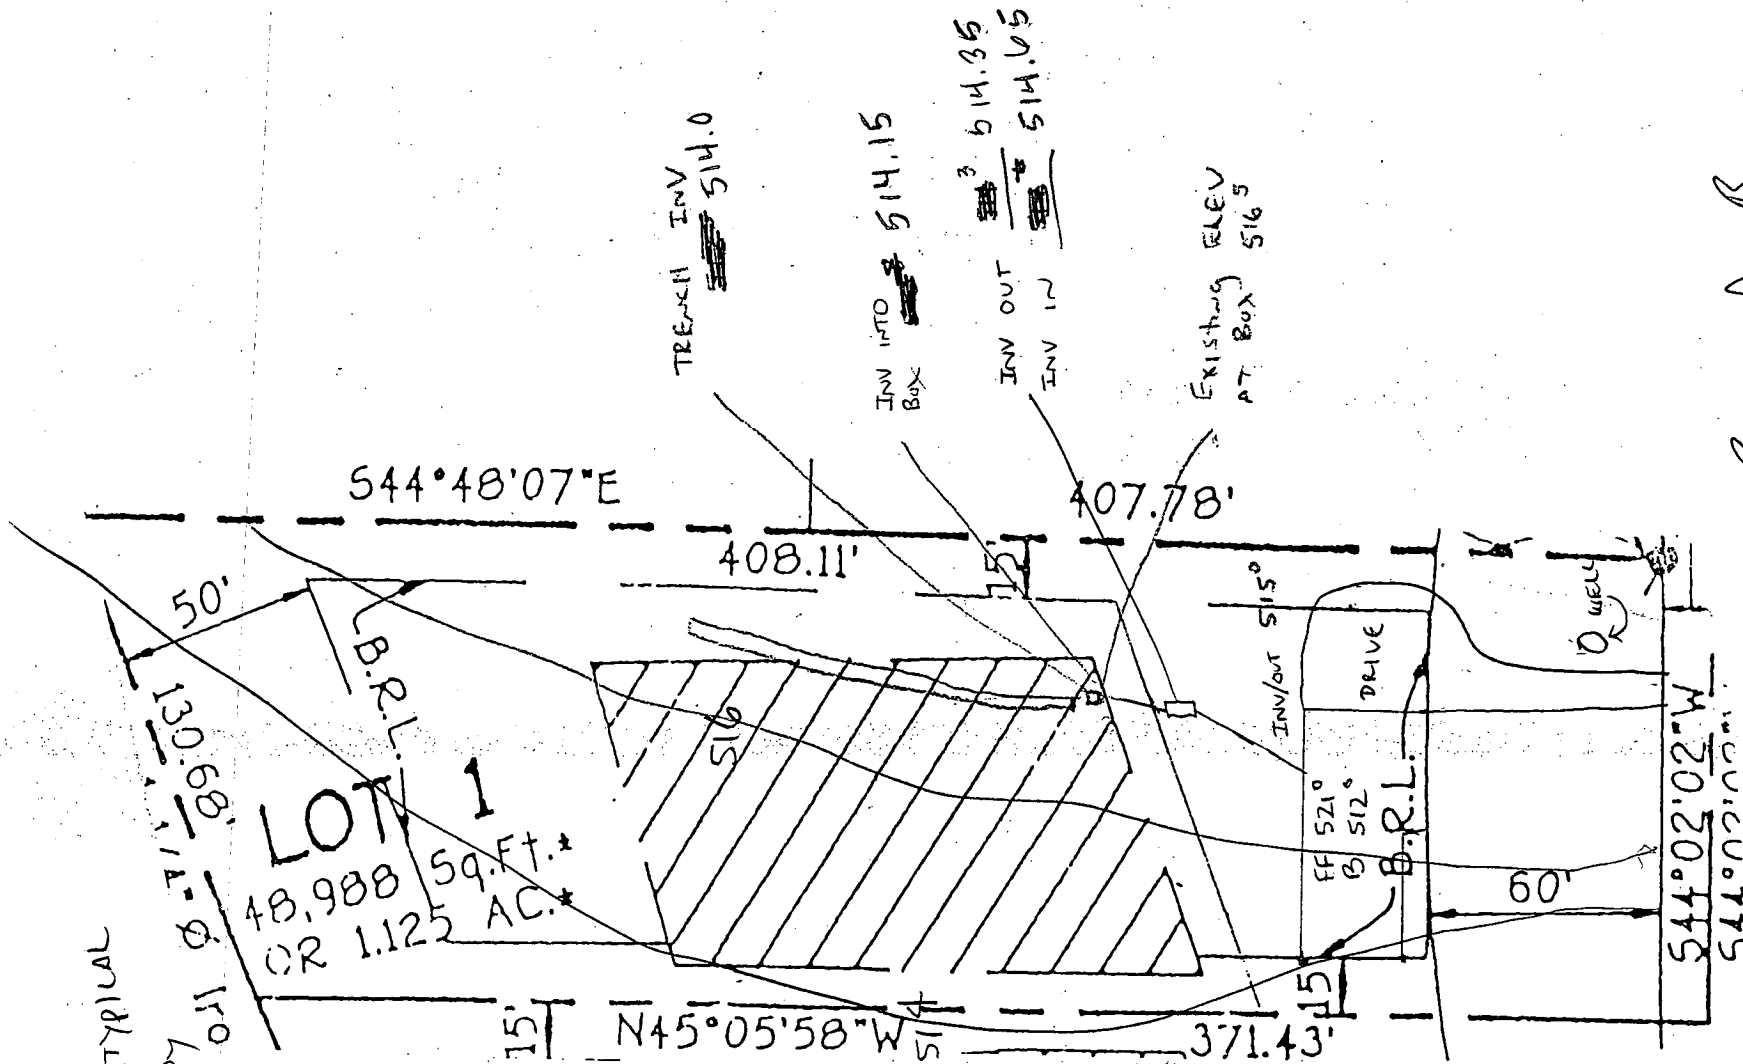

B. A. By
5/17/94
379-0157

