

APPLICATION

A 11166

SEWAGE DISPOSAL TESTING

P _____

MARYLAND STATE DEPARTMENT OF HEALTH

HOWARD COUNTY

ELLICOTT CITY

3 bedrooms - 750 gal. Septic Tanks

DISTRICT 3

Dry well 10 ft. in dia by 10 ft. deep below the inlet located 178 ft. from the property line, running across Peach's property and 25 ft. from the edge of the bank, on level ground, as seen when facing the lot from Cavey Lane. Dry well must be located in area tested.

DATE 11/13/65

4 bedrooms - 1000 gal. septic Tanks

Dry well 13 ft. in dia by 10 ft. deep below the inlet with location the same as for 3 bedrooms.

TO: THE COUNTY HEALTH OFFICER
ELLICOTT CITY, MARYLAND

I, HEREBY, APPLY FOR THE NECESSARY TESTS IN ORDER TO CONSTRUCT (OR RECONSTRUCT) A SEWAGE DISPOSAL SYSTEM.

PROPERTY OWNER James D. Jenkins

ADDRESS Old Frederick Rd., E. C. PHONE HO 5-1994

PROPERTY LOCATION:

SUBDIVISION _____ LOT NO. 3

ROAD AND DESCRIPTION Cavey Lane off Woodstock Lane - turn right at top of hill before going into Woodstock - about 1600 ft. off road

OCCUPANT _____ PHONE _____

PERSON TO CONSTRUCT SYSTEM _____

ADDRESS _____ PHONE _____

SIZE OF LOT 4.74 acres TYPE BLDG. 3 or 4
NUMBER OF BEDROOMS

IF NOT SINGLE RESIDENCE DESCRIBE _____

SIGNATURE OF APPLICANT James D. Jenkins


APPROVED BY J. Hennigh FOR Dry Well DATE 1-11-66
(KIND OF SYSTEM)

REJECTED BY _____ FOR _____ DATE _____
(KIND OF SYSTEM)

HOLD PENDING FURTHER TESTS _____ DATE _____

REASONS FOR REJECTION OR HOLDING 11-17-65 Need to know where house and well/water supply to be located in reference to lot and sewages. JH.

THIS IS NOT A PERMIT

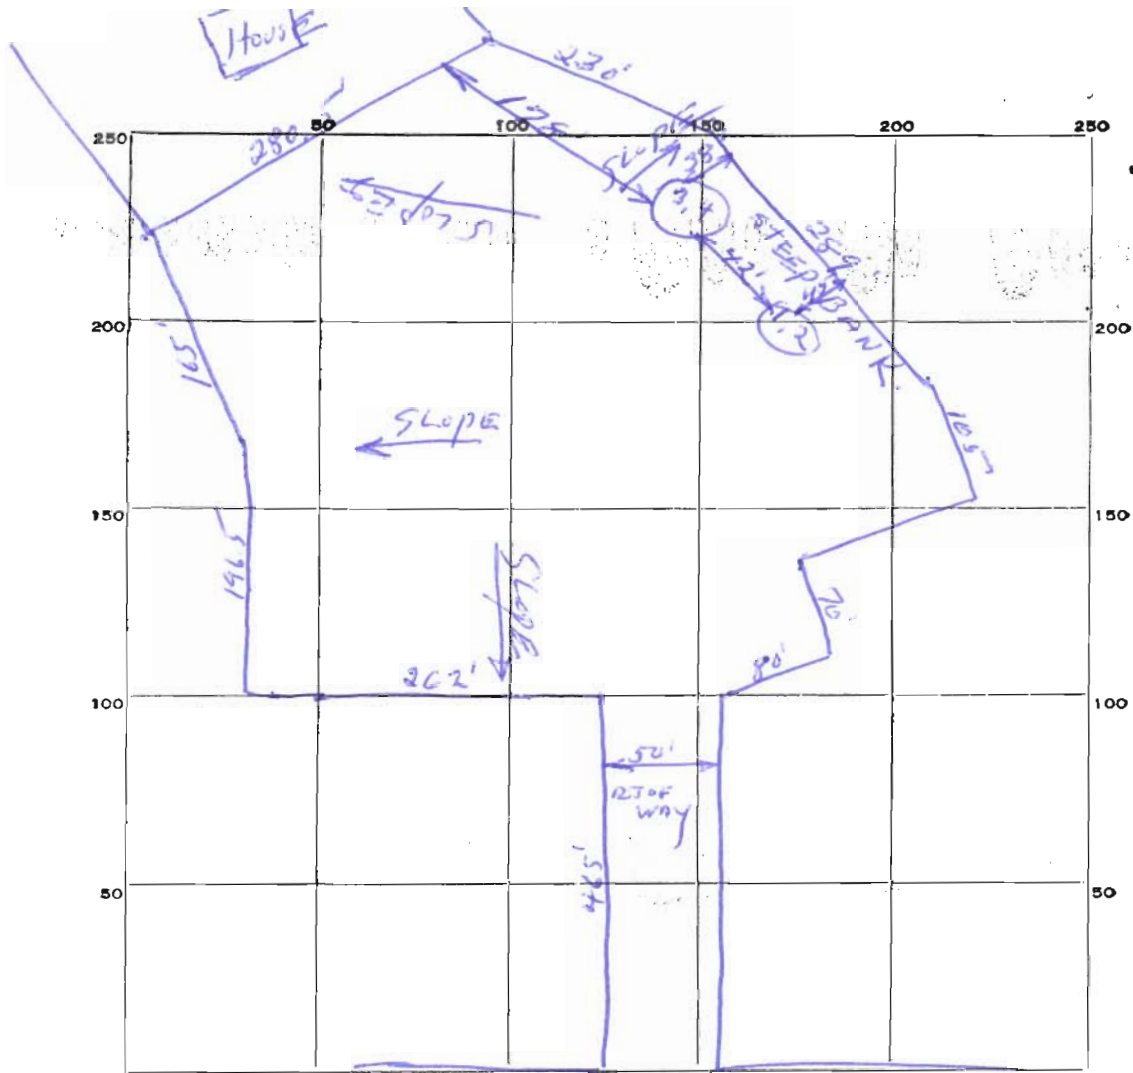

INDICATE NORTH. - NAME ADJOINING ROADWAY AS BASE LINE.

CAVEY LA.

DATE	TEST NO.	DEPTH	PRE-WET		TEST - 1" DROP		TIME	
			START	STOP	START	STOP		
12-11-65	1	Some	9'	11:43	11:44	11:44	11:47	3 min
	2	Pit	5'	11:43	11:45	11:45	11:50	5 min
	3	Some	9'	11:49	11:50	11:50	11:54	4 min
	4	Pit	5'	11:49	11:50	11:50	11:54	4 min

SOIL AUGER FINDING *good after top 3 FT both pits*

TESTED BY *HI.*

REMARKS *12-11-65 Howard Ingle*

Preliminary

*12/17/65
9:30*

APPLICATION

A 11166

P _____

SEWAGE DISPOSAL TESTING

MARYLAND STATE DEPARTMENT OF HEALTH

HOWARD COUNTY

ELLICOTT CITY

DISTRICT 3

DATE 11/13/65

TO: THE COUNTY HEALTH OFFICER
ELLICOTT CITY, MARYLAND

I, HEREBY, APPLY FOR THE NECESSARY TESTS IN ORDER TO CONSTRUCT (OR RECONSTRUCT) A SEWAGE DISPOSAL SYSTEM.

PROPERTY OWNER James D. Jenkins

ADDRESS Old Frederick Rd., E. C. PHONE HO 5-1994

PROPERTY LOCATION:

SUBDIVISION _____ LOT NO. 3

ROAD AND DESCRIPTION Cavey Lane off Woodstock Lane - turn right at top of hill before going into Woodstock - about 1600 ft. off road

OCCUPANT _____ PHONE _____

PERSON TO CONSTRUCT SYSTEM _____

ADDRESS _____ PHONE _____

SIZE OF LOT 4.74 acres TYPE BLDG. 3 or 4
NUMBER OF BEDROOMS

IF NOT SINGLE RESIDENCE DESCRIBE _____

SIGNATURE OF APPLICANT James D. Jenkins


APPROVED BY J. Hennigan FOR Dry Well DATE 1-11-66
(KIND OF SYSTEM)

REJECTED BY _____ FOR _____ DATE _____
(KIND OF SYSTEM)

HOLD PENDING FURTHER TESTS _____ DATE _____

REASONS FOR REJECTION OR HOLDING 12-17-65 Need to know where house and well/water supply) to be located in reference to lot and sewages. JH.

THIS IS NOT A PERMIT

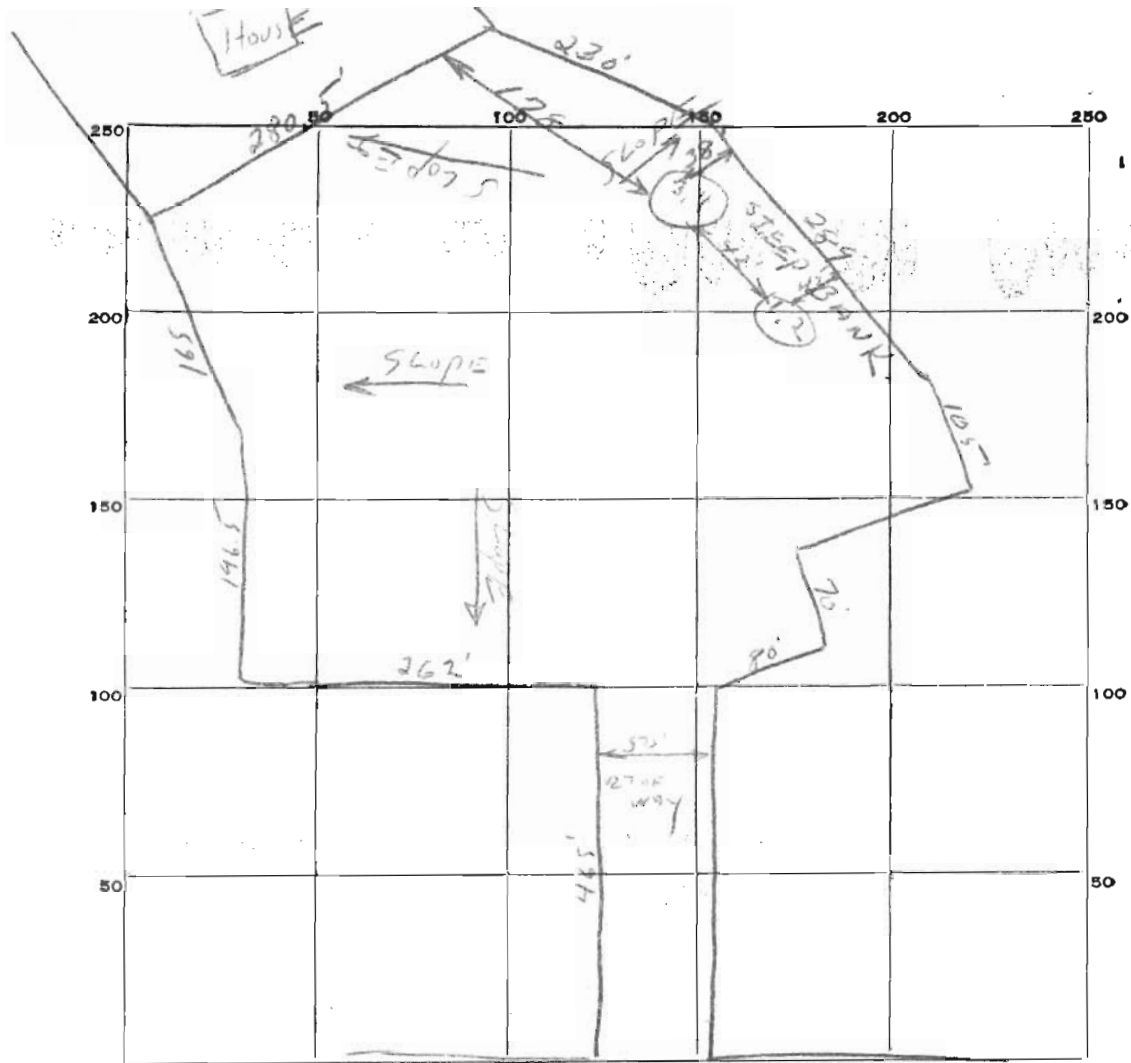

INDICATE NORTH. - NAME ADJOINING ROADWAY AS BASE LINE.

CAVEY LA

DATE	TEST NO.	DEPTH	PRE-WET		TEST - 1" DROP		TIME
			START	STOP	START	STOP	
12-11-65	1	9'	11:43	11:44	11:44	11:47	3m
	2	5'	11:43	11:45	11:45	11:50	5m
	3	9'	11:49	11:50	11:50	11:54	4m
	4	5'	11:49	11:50	11:50	11:54	4m

SOIL AUGER FINDING: Good after top 3 FT both pits.

TESTED BY: All.

REMARKS: 12-11-65 Howard Inghelt

