

*Preliminary*  
*2/11/75*  
*9:55*

*4-12' below*  
*on*  
*main st.*

# APPLICATION

A 21120  
P \_\_\_\_\_

## SEWAGE DISPOSAL TESTING

STATE OF MARYLAND - DEPARTMENT OF HEALTH AND MENTAL HYGIENE

HOWARD COUNTY HEALTH DEPARTMENT  
ENVIRONMENTAL HEALTH SERVICES  
P. O. BOX 476, ELLICOTT CITY, MARYLAND 21043  
TELEPHONE: 865-5000, EXT. 356

DISTRICT 5  
DATE 2/11/75

*2/15/75*  
*1:30*

*2/6/90 - This lot now an existing recorded lot. No record of approved subdivision plat. These tests inconclusive.*

TO: THE COUNTY HEALTH OFFICER  
ELLICOTT CITY, MARYLAND

I, HEREBY, APPLY FOR THE NECESSARY TEST IN ORDER TO CONSTRUCT (OR RECONSTRUCT) A SEWAGE DISPOSAL SYSTEM.

PROPERTY OWNER Wayne D. Wildes

ADDRESS 6429 Lochridge Road, Columbia, Md. 21044 PHONE 531-6661

PROPERTY LOCATION:

SUBDIVISION The Second Circle LOT NO. 1

ROAD AND DESCRIPTION Cedar Lane at Freetown Road

SIZE OF LOT 40,038 sq. ft. TYPE BLDG. Existing house  
3 or 4  
NUMBER OF BEDROOMS

IF NOT SINGLE RESIDENCE DESCRIBE \_\_\_\_\_

THE SYSTEM INSTALLED UNDER THIS APPLICATION IS ACCEPTABLE ONLY UNTIL PUBLIC FACILITIES BECOME AVAILABLE.

SIGNATURE OF APPLICANT /s/ Wayne D. Wildes


APPROVED BY \_\_\_\_\_ FOR \_\_\_\_\_ DATE \_\_\_\_\_  
(KIND OF SYSTEM)

REJECTED BY \_\_\_\_\_ FOR \_\_\_\_\_ DATE \_\_\_\_\_  
(KIND OF SYSTEM)

HOLD PENDING FURTHER TESTS \_\_\_\_\_ DATE \_\_\_\_\_

REASONS FOR REJECTION OR HOLDING \_\_\_\_\_

# THIS IS NOT A PERMIT

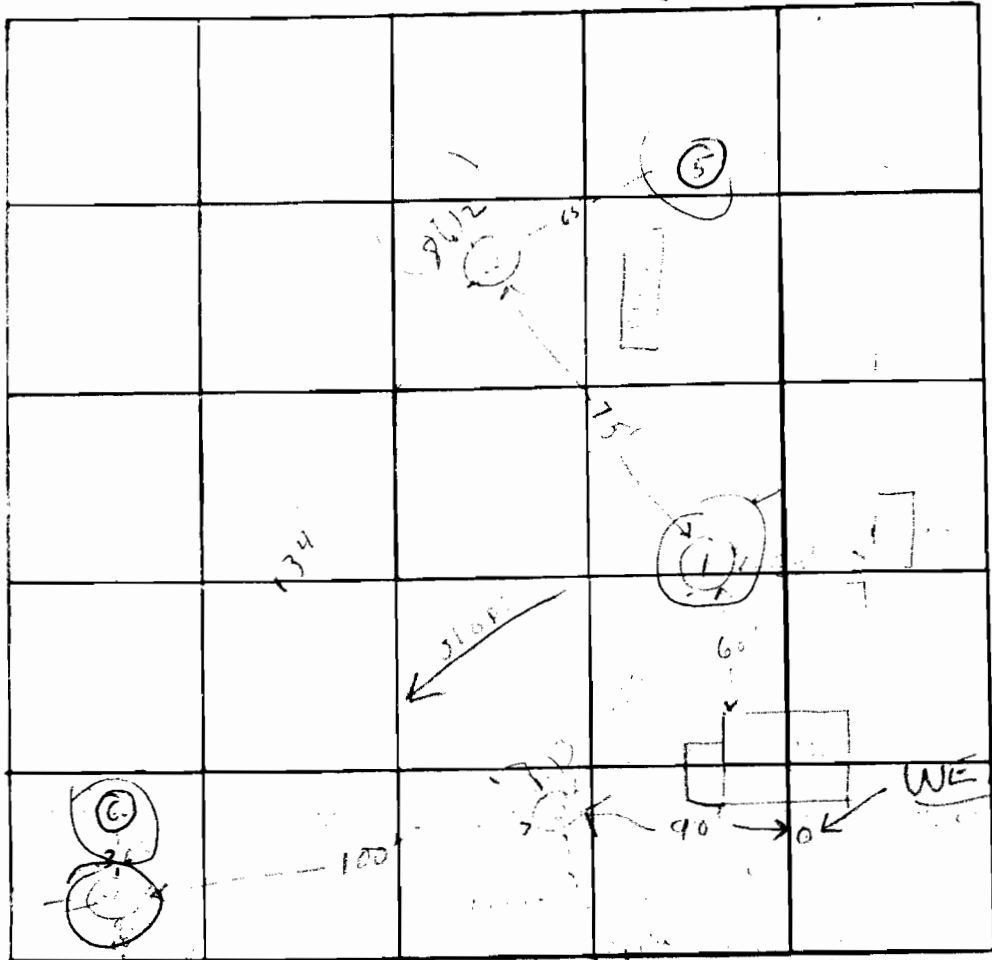


INDICATE NORTH - NAME ADJOINING ROADWAY AS BASE LINE

DATE	TEST NO.	DEPTH	PRE-WET		TEST - 1" DROP		TIME
			START	STOP	START	STOP	
2/13/75	1	12'	10:29	11:33	11:33	7/8" - 30"	
	1A	5'	10:40	11:18	11:18	10:21	30min
	2	12'	10:40	11:20	10:50	11:15	20
	2B	4'	10:40		10:40	43:00	
	3	13'	11:05	11:20	11:10	11:20	30min
	3A	4'	11:20	11:30	11:30		
	3B	7'	1:02	1:09	1:08	1:15	10min
	4	10'	1:03	1:20	1:20	1:20	10
	4L	3 1/2'	1:04	1:19	1:11	1:38	12min
	2B	7'	1:04	1:10	1:10	4:00min	

REMARKS \_\_\_\_\_

TYPE OF SOIL \_\_\_\_\_

TESTED BY F. D. [unclear] ALSO PRESENT: \_\_\_\_\_

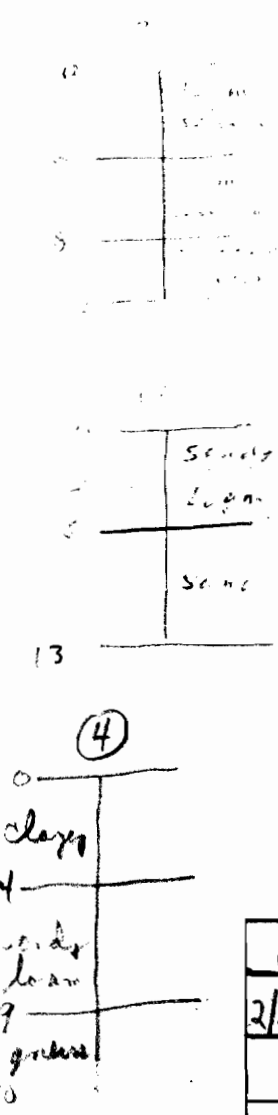

# APPLICATION

A 21120

## SEWAGE DISPOSAL TESTING

P \_\_\_\_\_

STATE OF MARYLAND - DEPARTMENT OF HEALTH AND MENTAL HYGIENE

HOWARD COUNTY HEALTH DEPARTMENT  
ENVIRONMENTAL HEALTH SERVICES  
P. O. BOX 476, ELLICOTT CITY, MARYLAND 21043  
TELEPHONE: 465-5000, EXT. 356

DISTRICT 5

DATE 2/11/75

TO: THE COUNTY HEALTH OFFICER  
ELLICOTT CITY, MARYLAND

I, HEREBY, APPLY FOR THE NECESSARY TEST IN ORDER TO CONSTRUCT (OR RECONSTRUCT) A SEWAGE DISPOSAL SYSTEM.

PROPERTY OWNER Wayne D. Wildes

ADDRESS 6429 Lochridge Road, Columbia, Md. 21044 PHONE 531-6661

PROPERTY LOCATION:

SUBDIVISION The Second Circle LOT NO. 1

ROAD AND DESCRIPTION Cedar Lane at Freetown Road

SIZE OF LOT 40,038 sq. ft. TYPE BLDG. Existing house  
3 or 4  
NUMBER OF BEDROOMS

IF NOT SINGLE RESIDENCE DESCRIBE \_\_\_\_\_

THE SYSTEM INSTALLED UNDER THIS APPLICATION IS ACCEPTABLE ONLY UNTIL PUBLIC FACILITIES BECOME AVAILABLE.

SIGNATURE OF APPLICANT /s/ Wayne D. Wildes


APPROVED BY \_\_\_\_\_ FOR \_\_\_\_\_ DATE \_\_\_\_\_  
(KIND OF SYSTEM)

REJECTED BY \_\_\_\_\_ FOR \_\_\_\_\_ DATE \_\_\_\_\_  
(KIND OF SYSTEM)

HOLD PENDING FURTHER TESTS \_\_\_\_\_ DATE \_\_\_\_\_

REASONS FOR REJECTION OR HOLDING \_\_\_\_\_

# THIS IS NOT A PERMIT

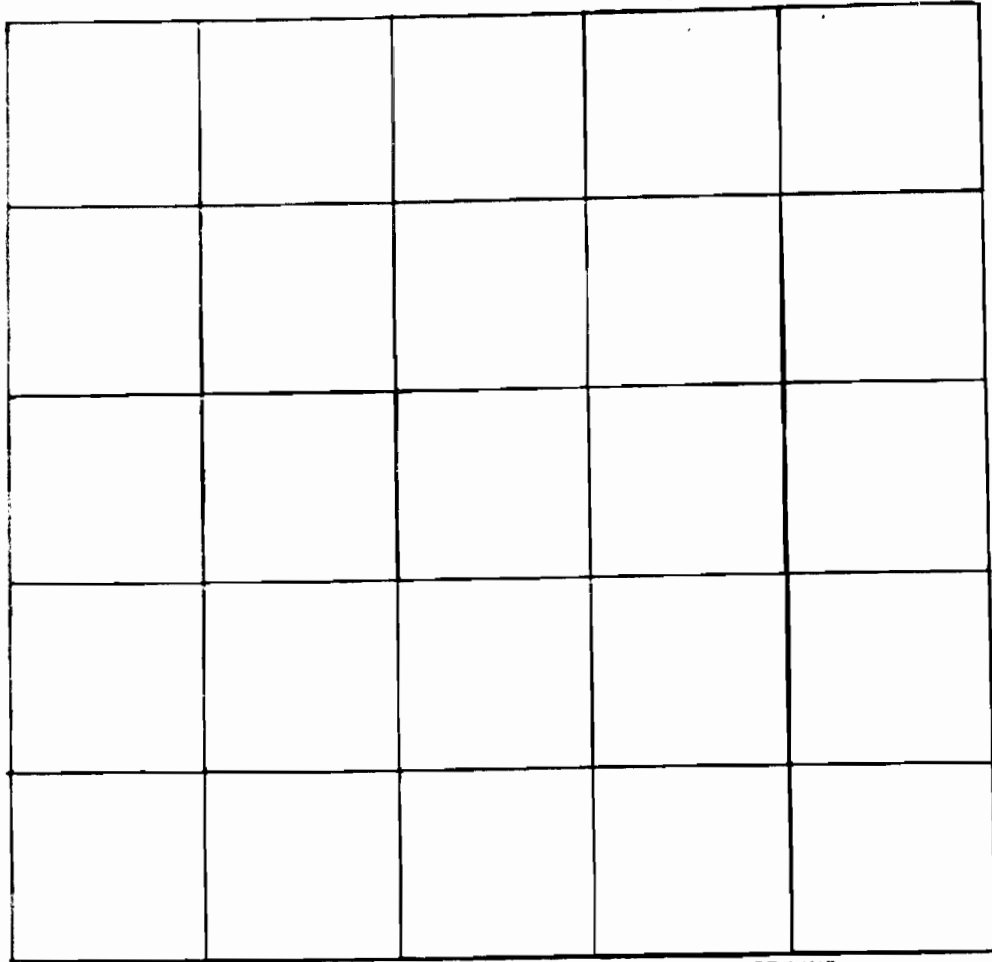

INDICATE NORTH - NAME ADJOINING ROADWAY AS BASE LINE

DATE	TEST NO.	DEPTH	PRE-WET		TEST - 1" DROP		TIME
			START	STOP	START	STOP	
	4B	2'	3:02	3:08	3:58	3:14	6 min
	4C	7'	3:07	no perc	9:05	is hard	
	20	2'	3:24	3:28	5:08		1 min
RM. 2/14	5	5	12:49	12:51	12:51	12:54	3
	5A	13	12:51	12:52	12:52	12:55	3
	6	4	12:55	1:02	1:02	1:09	7
	6A	12	11:00	11:00	—	—	—

REMARKS \_\_\_\_\_

TYPE OF SOIL \_\_\_\_\_

TESTED BY \_\_\_\_\_ ALSO PRESENT: \_\_\_\_\_

4-12' to 6' ...  
12/10, 000 1/4'

*Preliminary*  
*2/13/75*  
*1280*

# APPLICATION

A 21121

P \_\_\_\_\_

SEWAGE DISPOSAL TESTING

STATE OF MARYLAND - DEPARTMENT OF HEALTH AND MENTAL HYGIENE

HOWARD COUNTY HEALTH DEPARTMENT  
ENVIRONMENTAL HEALTH SERVICES  
P. O. BOX 476, ELLICOTT CITY, MARYLAND 21043  
TELEPHONE: 465-5000, EXT. 356

DISTRICT 5

DATE 2/11/75

TO: THE COUNTY HEALTH OFFICER  
ELLICOTT CITY, MARYLAND

I, HEREBY, APPLY FOR THE NECESSARY TEST IN ORDER TO CONSTRUCT (OR RECONSTRUCT) A SEWAGE DISPOSAL SYSTEM.

PROPERTY OWNER Wayne D. Wildes

ADDRESS 6429 Lochridge Road, Columbia, Md, 21044 PHONE 531-6661

PROPERTY LOCATION:

SUBDIVISION The Second Circle LOT NO. 2

ROAD AND DESCRIPTION Cedar Lane at Freetown Road

SIZE OF LOT 4.063 acres TYPE BLDG. 3 or 4

NUMBER OF BEDROOMS

IF NOT SINGLE RESIDENCE DESCRIBE \_\_\_\_\_ (Single Fmly. Dwllg.)

THE SYSTEM INSTALLED UNDER THIS APPLICATION IS ACCEPTABLE ONLY UNTIL PUBLIC FACILITIES BECOME AVAILABLE.

SIGNATURE OF APPLICANT /s/ Wayne D. Wildes

APPROVED BY \_\_\_\_\_ FOR \_\_\_\_\_ DATE \_\_\_\_\_  
(KIND OF SYSTEM)


REJECTED BY \_\_\_\_\_ FOR \_\_\_\_\_ DATE \_\_\_\_\_  
(KIND OF SYSTEM)

HOLD PENDING FURTHER TESTS \_\_\_\_\_ DATE \_\_\_\_\_

REASONS FOR REJECTION OR HOLDING \_\_\_\_\_

# THIS IS NOT A PERMIT

*10/75*

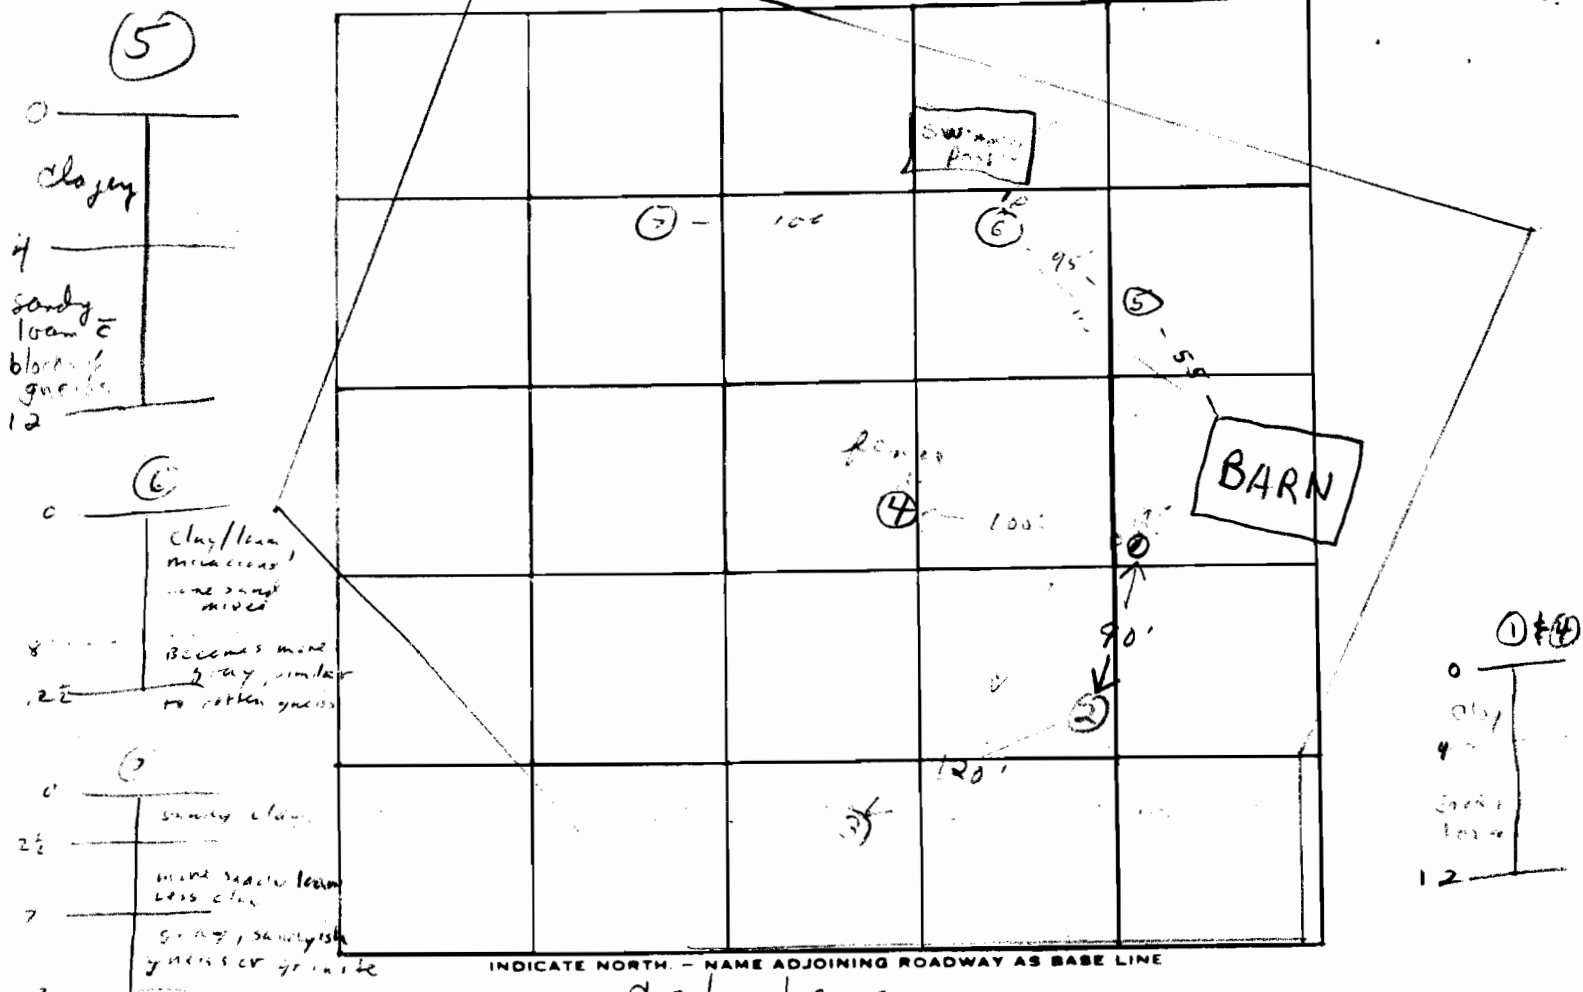

(5)  
0  
clayey  
4  
sandy loam  
blocks of granite  
12

(6)  
0  
clay/lean micaceous  
more sand mixed  
8  
becomes more silty, similar to rather gneiss  
12

(7)  
0  
sandy clay  
2 1/2  
more sandy loam less clay  
7  
silty, sandyish gneiss or granite  
12

(1+4)  
0  
clay  
4  
sandy loam  
12

DATE	TEST NO.	DEPTH	PRE-WET		TEST - 1" DROP		TIME
			START	STOP	START	STOP	
8/13/79	1	5'	2:02	2:05	2:05	2:10	5 min
	1A	12'	2:12	2:07	2:07	2:13	6 min
	2	11'	water	at 10'	clap 3'		
	3	12'	water	at 11'	clap 3'		
	4	12'	2:27	2:31	2:31	2:29	8 min
	4A	12'	2:27	2:21	2:21	2:27	6 min
	5	5'	3:52	4:04	4:03	4:11	8 min
R-77 2/14	5A	13'	3:52	4:25	rockslide needs number test		
	6	4'	1:34	1:51	1:51	2:08	17
	6A	12 1/2'	1:27	1:41	1:41	1:54	18
	7	12'	vis	dry			

REMARKS \_\_\_\_\_  
 TYPE OF SOIL \_\_\_\_\_  
 TESTED BY F.S. ALSO PRESENT: \_\_\_\_\_

# APPLICATION

A. 21121

## SEWAGE DISPOSAL TESTING

D. \_\_\_\_\_

STATE OF MARYLAND - DEPARTMENT OF HEALTH AND MENTAL HYGIENE

HOWARD COUNTY HEALTH DEPARTMENT  
ENVIRONMENTAL HEALTH SERVICES  
P. O. BOX 476, ELLICOTT CITY, MARYLAND 21043  
TELEPHONE: 465-5000, EXT. 356

DISTRICT 5

DATE 2/11/75

TO: THE COUNTY HEALTH OFFICER  
ELLICOTT CITY, MARYLAND

I, HEREBY, APPLY FOR THE NECESSARY TEST IN ORDER TO CONSTRUCT (OR RECONSTRUCT) A SEWAGE DISPOSAL SYSTEM.

PROPERTY OWNER Wayne D. Wildes

ADDRESS 6429 Lochridge Road, Columbia, Md. 21044 PHONE 531-6661

PROPERTY LOCATION:

SUBDIVISION The Second Circle LOT NO. 2

ROAD AND DESCRIPTION Cedar Lane at Freetown Road

SIZE OF LOT 4.063 acres TYPE BLDG. 3 or 4

IF NOT SINGLE RESIDENCE DESCRIBE (Single Fmly. Dwllg.)  
NUMBER OF BEDROOMS

THE SYSTEM INSTALLED UNDER THIS APPLICATION IS ACCEPTABLE ONLY UNTIL PUBLIC FACILITIES BECOME AVAILABLE.

SIGNATURE OF APPLICANT /s/ Wayne D. Wildes

APPROVED BY \_\_\_\_\_ FOR \_\_\_\_\_ DATE \_\_\_\_\_  
(KIND OF SYSTEM)

REJECTED BY \_\_\_\_\_ FOR \_\_\_\_\_ DATE \_\_\_\_\_  
(KIND OF SYSTEM)

HOLD PENDING FURTHER TESTS \_\_\_\_\_ DATE \_\_\_\_\_

REASONS FOR REJECTION OR HOLDING \_\_\_\_\_

# THIS IS NOT A PERMIT

4-12' holes  
on 1/19/75

# APPLICATION

A 21122

D \_\_\_\_\_

*Preliminary*  
2/13/75  
9:30

## SEWAGE DISPOSAL TESTING

STATE OF MARYLAND - DEPARTMENT OF HEALTH AND MENTAL HYGIENE

HOWARD COUNTY HEALTH DEPARTMENT  
ENVIRONMENTAL HEALTH SERVICES  
P. O. BOX 476, ELLICOTT CITY, MARYLAND 21043  
TELEPHONE: 465-5000, EXT. 356

DISTRICT 5

DATE 2/11/75

TO: THE COUNTY HEALTH OFFICER  
ELLICOTT CITY, MARYLAND

I, HEREBY, APPLY FOR THE NECESSARY TEST IN ORDER TO CONSTRUCT (OR RECONSTRUCT) A SEWAGE DISPOSAL SYSTEM.

PROPERTY OWNER Wayne D. Wildes

ADDRESS 6429 Lochridge Road, Columbia, Md. 21044 PHONE 531-6661

PROPERTY LOCATION:

SUBDIVISION The Second Circle LOT NO. 3

ROAD AND DESCRIPTION Cedar Lane at Freetown Road

SIZE OF LOT 40,052 sq. ft. TYPE BLDG. 3 or 4

IF NOT SINGLE RESIDENCE DESCRIBE \_\_\_\_\_  
NUMBER OF BEDROOMS  
(Single Fmly. Dwllg.)

THE SYSTEM INSTALLED UNDER THIS APPLICATION IS ACCEPTABLE ONLY UNTIL PUBLIC FACILITIES BECOME AVAILABLE.

SIGNATURE OF APPLICANT /s/ Wayne D. Wildes

APPROVED BY \_\_\_\_\_ FOR \_\_\_\_\_ DATE \_\_\_\_\_  
(KIND OF SYSTEM)

REJECTED BY \_\_\_\_\_ FOR \_\_\_\_\_ DATE \_\_\_\_\_  
(KIND OF SYSTEM)

HOLD PENDING FURTHER TESTS \_\_\_\_\_ DATE \_\_\_\_\_

REASONS FOR REJECTION OR HOLDING \_\_\_\_\_

# THIS IS NOT A PERMIT

# APPLICATION

A 21122

P \_\_\_\_\_

## SEWAGE DISPOSAL TESTING

STATE OF MARYLAND - DEPARTMENT OF HEALTH AND MENTAL HYGIENE

HOWARD COUNTY HEALTH DEPARTMENT  
ENVIRONMENTAL HEALTH SERVICES  
P. O. BOX 476, ELLICOTT CITY, MARYLAND 21043  
TELEPHONE 465-5000, EXT. 356

DISTRICT 5

DATE 2/11/75

TO: THE COUNTY HEALTH OFFICER  
ELLICOTT CITY, MARYLAND

I, HEREBY, APPLY FOR THE NECESSARY TEST IN ORDER TO CONSTRUCT (OR RECONSTRUCT) A SEWAGE DISPOSAL SYSTEM.

PROPERTY OWNER Wayne D. Wildes

ADDRESS 6429 Lochridge Road, Columbia, Md. 21044 PHONE 531-6661

PROPERTY LOCATION:

SUBDIVISION The Second Circle LOT NO. 3

ROAD AND DESCRIPTION Cedar Lane at Freetown Road

SIZE OF LOT 40,052 sq. ft. TYPE BLDG. 3 or 4

IF NOT SINGLE RESIDENCE DESCRIBE \_\_\_\_\_  
NUMBER OF BEDROOMS  
(Single Fmly. Dwlg.)

THE SYSTEM INSTALLED UNDER THIS APPLICATION IS ACCEPTABLE ONLY UNTIL PUBLIC FACILITIES BECOME AVAILABLE.

SIGNATURE OF APPLICANT /s/ Wayne D. Wildes

APPROVED BY \_\_\_\_\_ FOR \_\_\_\_\_ DATE \_\_\_\_\_  
(KIND OF SYSTEM)

REJECTED BY \_\_\_\_\_ FOR \_\_\_\_\_ DATE \_\_\_\_\_  
(KIND OF SYSTEM)

HOLD PENDING FURTHER TESTS \_\_\_\_\_ DATE \_\_\_\_\_

REASONS FOR REJECTION OR HOLDING \_\_\_\_\_

# THIS IS NOT A PERMIT

4-12' holes  
24-12, 2000 ft

# APPLICATION

A 21123

P \_\_\_\_\_

## SEWAGE DISPOSAL TESTING

STATE OF MARYLAND - DEPARTMENT OF HEALTH AND MENTAL HYGIENE

HOWARD COUNTY HEALTH DEPARTMENT  
ENVIRONMENTAL HEALTH SERVICES  
P. O. BOX 476, ELLICOTT CITY, MARYLAND 21043  
TELEPHONE: 465-5000, EXT. 356

DISTRICT 5

DATE 2/11/75

*Primary*  
*2/13/75*  
*9:30*

TO: THE COUNTY HEALTH OFFICER  
ELLICOTT CITY, MARYLAND

I, HEREBY, APPLY FOR THE NECESSARY TEST IN ORDER TO CONSTRUCT (OR RECONSTRUCT) A SEWAGE DISPOSAL SYSTEM.

PROPERTY OWNER Wayne D. Wildes

ADDRESS 5429 Lochridge Road, Columbia, Md. 21044 PHONE 531-6661

PROPERTY LOCATION:

SUBDIVISION The Second Circle LOT NO. 4

ROAD AND DESCRIPTION Cedar Lane

SIZE OF LOT 40,000 sq. ft. TYPE BLDG. 3 or 4

NUMBER OF BEDROOMS

IF NOT SINGLE RESIDENCE DESCRIBE (Single Fmly. Dwllg.)

THE SYSTEM INSTALLED UNDER THIS APPLICATION IS ACCEPTABLE ONLY UNTIL PUBLIC FACILITIES BECOME AVAILABLE.

SIGNATURE OF APPLICANT /s/ Wayne D. Wildes

APPROVED BY \_\_\_\_\_ FOR \_\_\_\_\_ DATE \_\_\_\_\_  
(KIND OF SYSTEM)

REJECTED BY \_\_\_\_\_ FOR \_\_\_\_\_ DATE \_\_\_\_\_  
(KIND OF SYSTEM)

HOLD PENDING FURTHER TESTS \_\_\_\_\_ DATE \_\_\_\_\_

REASONS FOR REJECTION OR HOLDING \_\_\_\_\_

# THIS IS NOT A PERMIT

# APPLICATION

A 21123

P \_\_\_\_\_

## SEWAGE DISPOSAL TESTING

STATE OF MARYLAND - DEPARTMENT OF HEALTH AND MENTAL HYGIENE

HOWARD COUNTY HEALTH DEPARTMENT  
ENVIRONMENTAL HEALTH SERVICES  
P. O. BOX 476, ELLICOTT CITY, MARYLAND 21043  
TELEPHONE: 465-5000, EXT. 356

DISTRICT 5

DATE 2/11/75

TO: THE COUNTY HEALTH OFFICER  
ELLICOTT CITY, MARYLAND

I, HEREBY, APPLY FOR THE NECESSARY TEST IN ORDER TO CONSTRUCT (OR RECONSTRUCT) A SEWAGE DISPOSAL SYSTEM.

PROPERTY OWNER Wayne D. Wildes

ADDRESS 5429 Lochridge Road, Columbia, Md. 21044 PHONE 531-6661

PROPERTY LOCATION:

SUBDIVISION The Second Circle LOT NO. 4

ROAD AND DESCRIPTION Cedar Lane

SIZE OF LOT 40,000 sq. ft. TYPE BLDG. 3 or 4

IF NOT SINGLE RESIDENCE DESCRIBE \_\_\_\_\_  
NUMBER OF BEDROOMS  
(Single Faly. Dwllg.)

THE SYSTEM INSTALLED UNDER THIS APPLICATION IS ACCEPTABLE ONLY UNTIL PUBLIC FACILITIES BECOME AVAILABLE.

SIGNATURE OF APPLICANT /s/ Wayne D. Wildes

APPROVED BY \_\_\_\_\_ FOR \_\_\_\_\_ DATE \_\_\_\_\_  
(KIND OF SYSTEM)

REJECTED BY \_\_\_\_\_ FOR \_\_\_\_\_ DATE \_\_\_\_\_  
(KIND OF SYSTEM)

HOLD PENDING FURTHER TESTS \_\_\_\_\_ DATE \_\_\_\_\_

REASONS FOR REJECTION OR HOLDING \_\_\_\_\_

# THIS IS NOT A PERMIT

# INVENTORY & EVALUATION

\*  
\* {  
INDIVIDUAL  
GROUP  
UNIT OF GOVERNMENT

REQUESTED BY Wayne Wildes LOCATION 6429 Lochridge Road  
Columbia, Md. 20144

ASSISTED BY C. Wayne Ray DATE 1/15/75

SITUATION: Based upon a location sketch, provide interpretative information concerning the Soil Limitations for On-Lot Disposal of Effluent from Septic Tanks in Shallow Systems.


The soil map information provided is taken from sheet 29 of the Soil Survey of Howard County, Maryland issued in 1968.

The soils as outlined on the attached sketch are as follows:

ChC2 - Chester Silt Loam	8-15% Slope
GLB2 - Glenelg Loam	3- 8% Slope
GnC2 - Glenville Silt Loam	8-15% Slope
MgB2 - Manor Gravelly Loam	3- 8% Slope
MgC2 - Manor Gravelly Loam	8-15% Slope
MLB2 - Manor Loam	3- 8% Slope
MLD2 - Manor Loam	15-25% Slope
Mnd - Manor Very Stony Loam	3-25% Slope

SUGGESTED SOLUTION(S): The attached chart "Soil Limitations for on-lot Disposal of Effluent from Septic Tanks, Howard County, Md." dated June 1972 provides information as to when to conduct percolation tests and the overall soil rating based upon physical features which affect the operation of shallow on-site systems, not deep seepage pits.

\* Circle appropriate category.

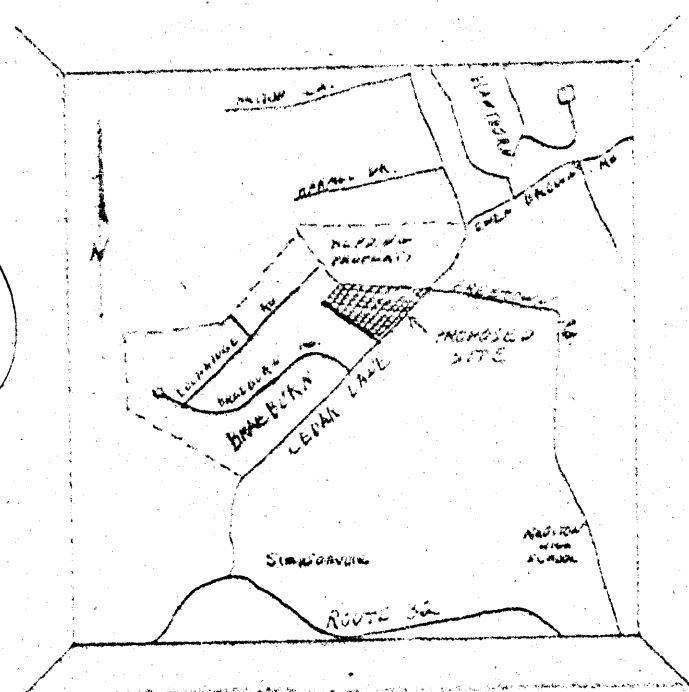

*Preliminary  
Sketch of testing  
plot.*

R-40

JAMES & ANN HERRING PROPERTY  
LIBER 75  
FOLIO 113

LOT 2  
7.005 ACRES

R-40

*2/10/75  
has to be  
complete per  
Plan*

**THE SECOND CIRCLE**  
LOTS ONE THROUGH FOUR  
SCALE: 1"=50' FEB. 10, 1975  
FIFTH ELECTION D. DISTRICT  
HOWARD COUNTY, Md.

OWNER & APPLICANT:  
WAYNE D. WILDES, Tel. 531-666.  
6429 LOCHRIDGE Rd.  
COLUMBIA, Md. 21044

PROPOSAL FOR INDIVIDUAL WATER SUPPLIES  
AND INDIVIDUAL SEWERAGE SYSTEMS

THERE ARE NO EXISTING WELLS OR  
SEWERAGE SYSTEMS LOCATED WITHIN  
ONE HUNDRED FEET OF THE PROPOSED  
SUBDIVISION BOUNDARIES

FOUR LOTS TO BE RECORDED  
TOTAL AREA 7.152 ACRES

	DATE
	DATE
*W. W. Developer*

