

7/27/93
NGON ✓

PERMIT

File

SEWAGE DISPOSAL SYSTEM

P 49554

DEPARTMENT OF HEALTH AND MENTAL HYGIENE

A REPAIR

01-167987

DISTRICT _____

HOWARD COUNTY HEALTH DEPARTMENT

DATE 8/24/93

BUREAU OF ENVIRONMENTAL HEALTH

~~XXXX-XXXX~~ 313-2640

INDEXED

DATE SYSTEM APPROVED 7/27/93

INSPECTOR C. B. D.

Jack Fyock Septic Service IS PERMITTED TO INSTALL ALTER X

ADDRESS 13775 Triadelphia Road, Glenelg, Maryland 21737 PHONE 988-9270

SUBDIVISION _____ LOT _____ ROAD 6189 Rockburn Hill Road

PROPERTY OWNER Hanson

ADDRESS 6189 Rockburn Hill Road
Elkridge, Maryland 21227

SEPTIC TANK CAPACITY 1000 GALLONS

NUMBER OF BEDROOMS 3

_____ SQUARE FEET PER BEDROOM

LINEAR FEET OF TRENCH REQUIRED _____

Note
(1) Dry Well to be filled in
(2) Metal tank collapsed Metal Top collapsed
per owner on Metal Tank C.B.D.

REPAIR - PURPOSE - THE EXISTING SEPTIC SYSTEM HAS FAILED.

Call for inspection when ground is opened so sanitarian can recommend repair. 07/13/93

Coming off existing line (Note 6' of stone under pipe)

{ (1) Trench - 2' wide; 90'± length; 8' deep; inlet 2' }
- 420'± sq. ft. effective area.

PLANS APPROVED BY C. B. D. (in field) for Mr. C. Williams DATE 7/27/93

COVER NO WORK UNTIL INSPECTED AND APPROVED

NEITHER THE HOWARD COUNTY COUNCIL NOR THE HEALTH DEPARTMENT IS RESPONSIBLE FOR THE SUCCESSFUL OPERATION OF ANY SYSTEM

NOTE: CLEANOUT REQUIRED EVERY 70 FEET OF SEWER LINE AND/OR AT 90° SWEEPS IN LINES FROM HOUSE TO DRAIN FIELDS, 90° ELBOWS NOT ACCEPTABLE.

NOTE: ALL PARTS OF SEPTIC SYSTEMS (I.E. TANK, DISTRIBUTION BOX TRENCHES) TO BE 100 FEET FROM WELL (UNLESS OTHERWISE SPECIFICALLY AUTHORIZED)

NOTE: IF DEEP TRENCH(ES) ARE USED CALL FOR INSPECTION BEFORE AND AFTER PLACING GRAVEL IN TRENCH(ES)

NOTE: NO DRY WELL SHALL EXCEED 15 FOOT IN DIAMETER NO ABSORPTION TRENCH TO EXCEED 100 FEET IN LENGTH

NOTE: ALL PIPE FROM HOUSE TO SEPTIC TANK MUST BE CAST IRON OR SCHEDULE 35/40 PVC OR ABS


PERMIT VOID AFTER TWO YEARS

NOTE: INSTALL STAND PIPE ON SEPTIC TANK AND DRY WELL STAND PIPES MUST BE 6 INCHES IN DIAMETER CAST IRON, CONCRETE OR TERRA COTTA OR PVA OR ABS ACCEPTED. IF TOP OF SEPTIC TANK IS DEEPER THAN 3 FEET, MANHOLE TO GRADE REQUIRED.

NOTE: DISTRIBUTION BOXES MUST HAVE BAFFLES

***INSTALLER IS RESPONSIBLE FOR OBTAINING FINAL APPROVAL ON THIS PERMIT**

R 49554

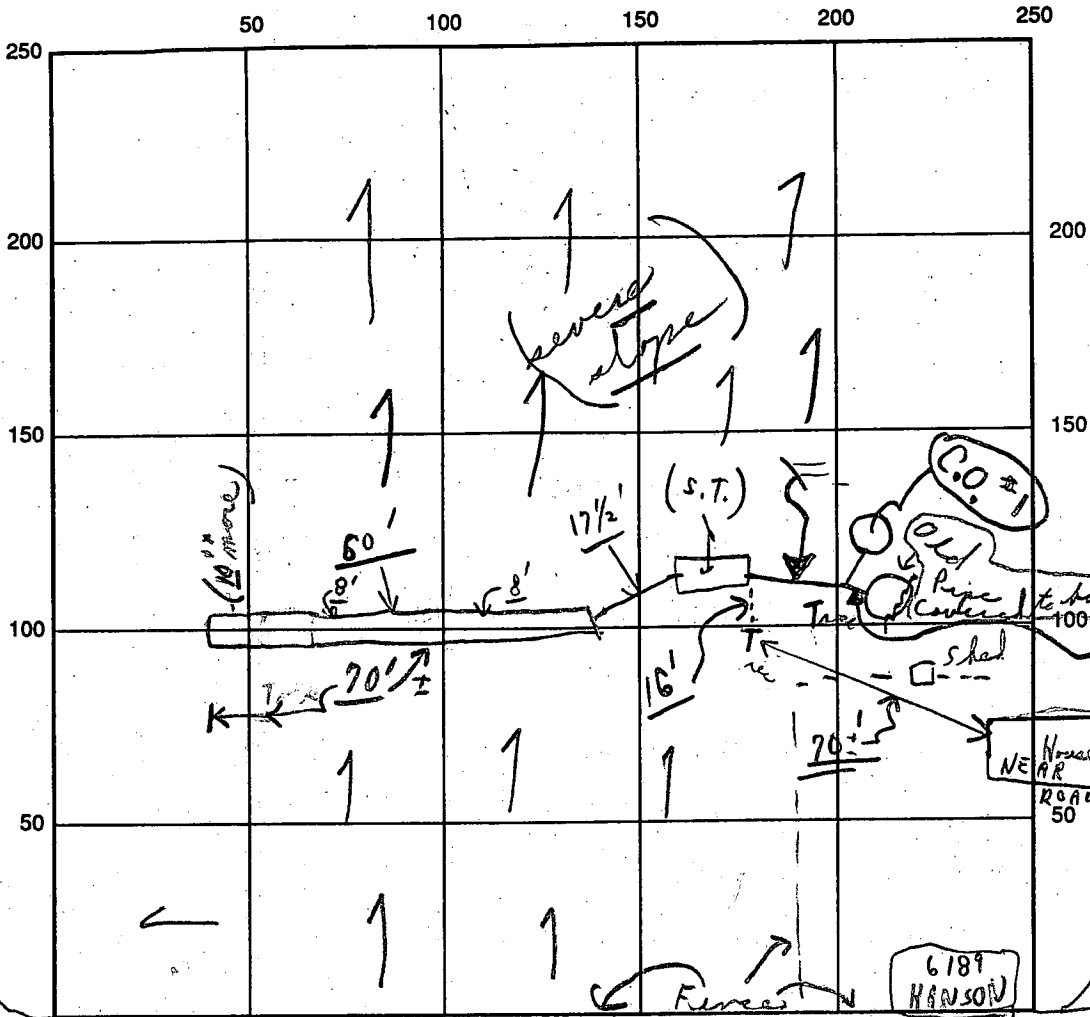

INDICATE NORTH - NAME ADJOINING ROADWAY AS BASE LINE

Rockburn Hill Road C.O. #1 S.T.

SEPTIC TANK LEVEL OK CLEANOUTS Before Tank | OK

DISTRIBUTION BOX LEVEL N/A (Trench off septic tank)

DRAIN FIELD/TITLE DEPTH 8 FT. TRENCH WIDTH 2 FT. INLET DEPTH 2 FT.

EFFECTIVE GRAVEL DEPTH 6⁺ FT. TOTAL LENGTH 70[±] FT.



NUMBER OF TRENCHES 1 ONE SIDEWALL/~~BOTTOM~~ AREA 420[±] SQ. FT.

DRYWALL INSIDE DIAMETER --- FT. EFFECTIVE DEPTH BELOW INLET --- FT.

ABSORBENT AREA 420[±] SQ. FT.

REMARKS: (A.M.) 7/27/93 Partial ok to continue; 7/27/93 P.M. - ok to cover
as finish - material on site. C.B.d.
 C. B.d.

DATE SYSTEM APPROVED 7/27/93 INSPECTOR Charles Bryan Street

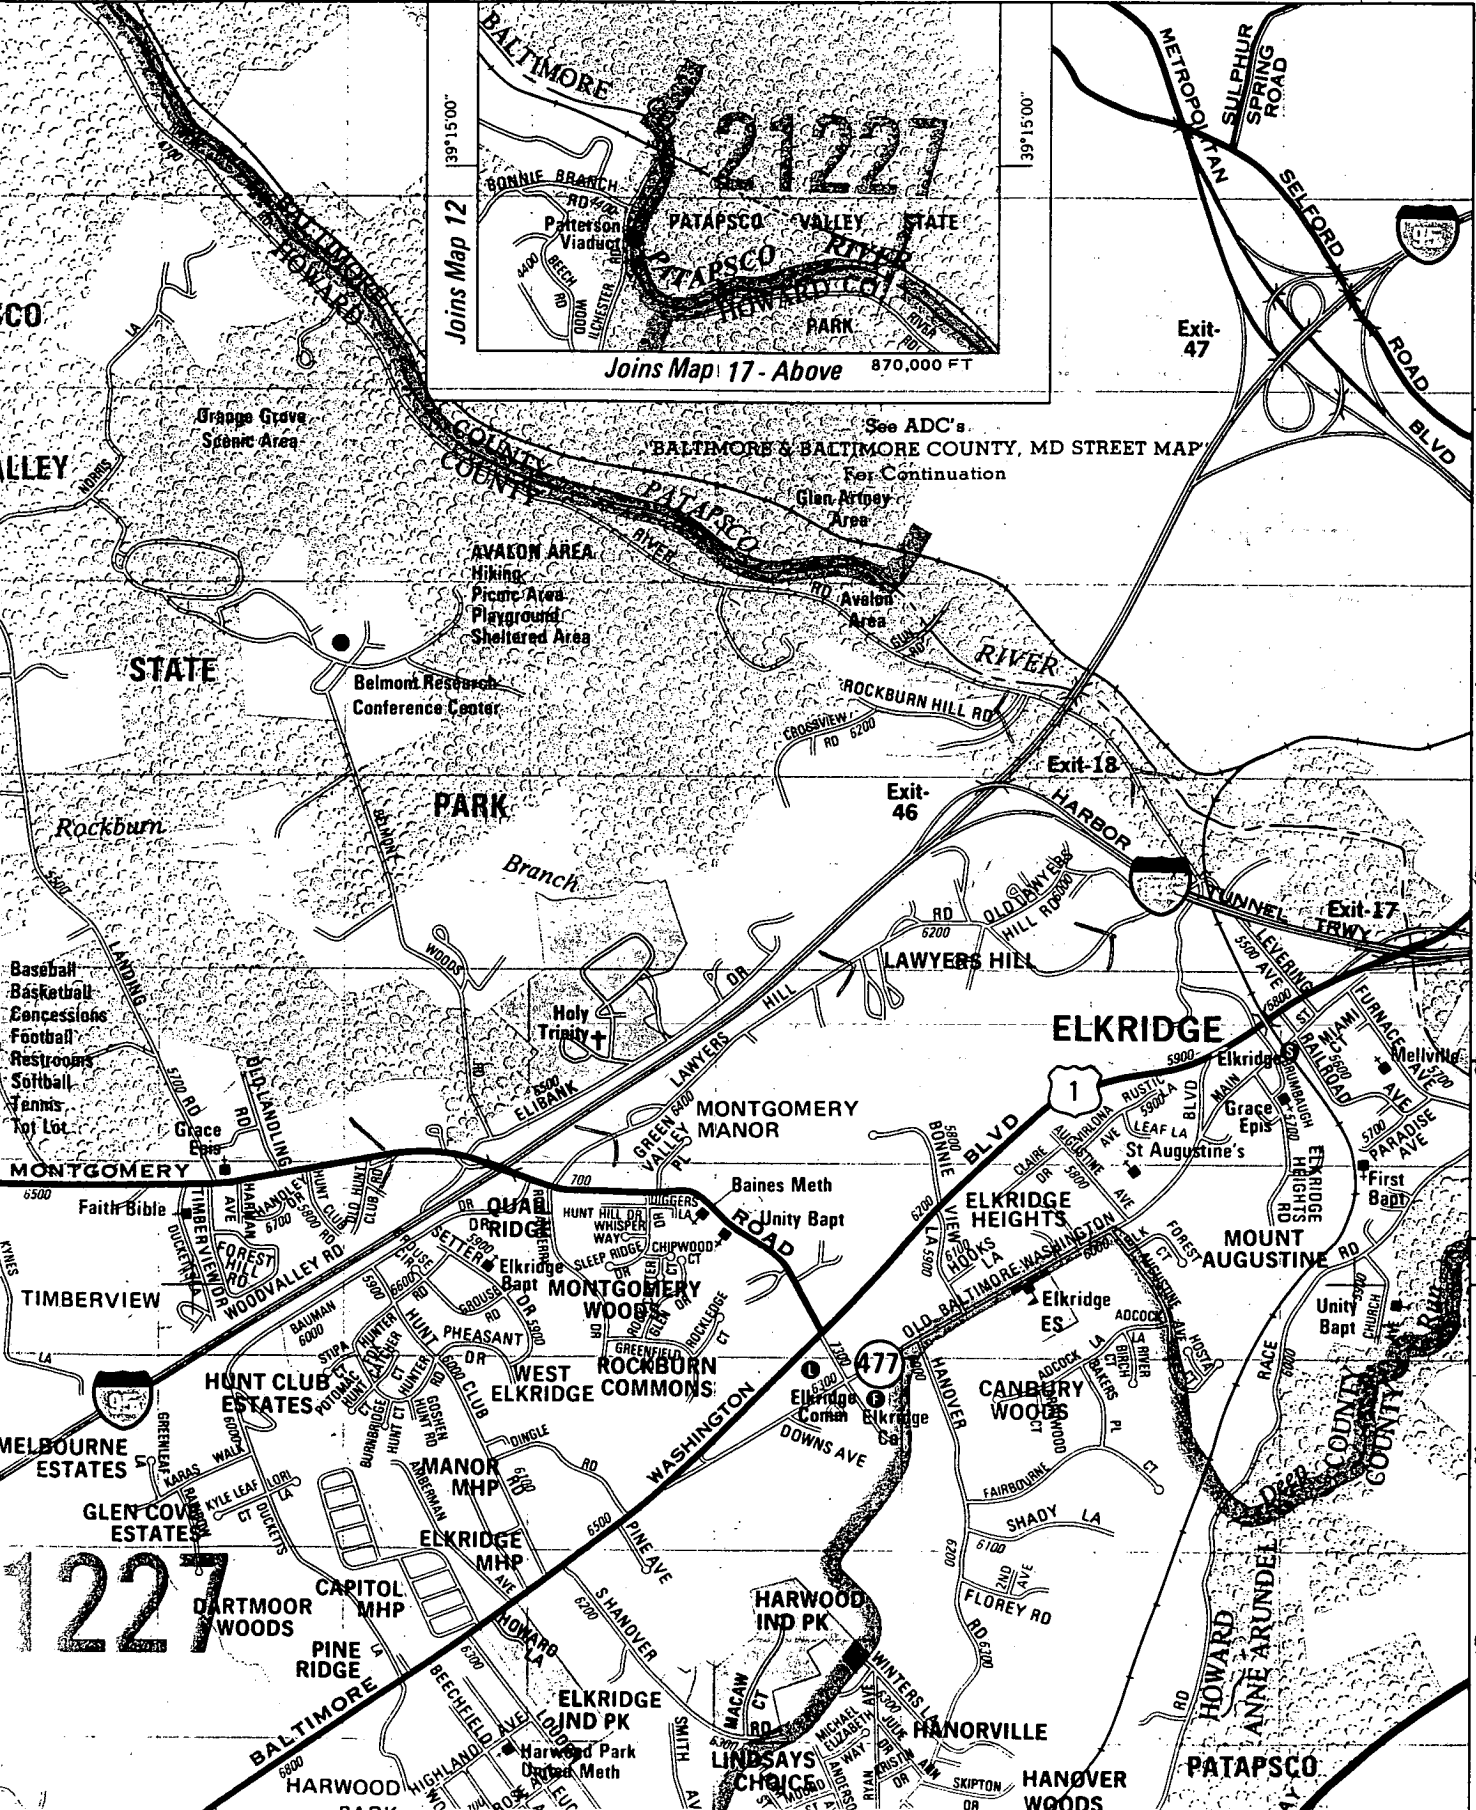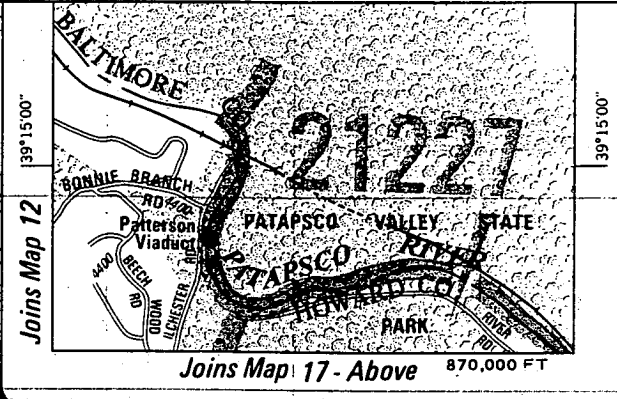

510,000 FT
4
5
6
7
8
9
500,000 FT 39°12'30"
To Harbor Tunnel To I-695
Joins Inset Below
To I-695

1227