

APPLICATION

A 28297

P _____

SEWAGE DISPOSAL TESTING

STATE OF MARYLAND - DEPARTMENT OF HEALTH AND MENTAL HYGIENE

HOWARD COUNTY HEALTH DEPARTMENT
ENVIRONMENTAL HEALTH SERVICES

P. O. BOX 476, ELLICOTT CITY, MARYLAND 21043
TELEPHONE: 465-5000, EXT. 356

Septic Tank { 1-3 Bedrooms 1000 gallons
 { 4 Bedrooms 1250 gallons
DATE May 12, 1978

*⊗ Dry well to have 150 sq ft. effective
absorbent sidewall area per bedroom below inlet.
Inlet to be 3 1/2' below original grade and maximum
depth 9 1/2'. Location per engineer's plat: 100' in from
left property line when facing lot from Homewood Road and
125' from Homewood Road when facing lot from Homewood Road.*

TO: THE COUNTY HEALTH OFFICER
ELLICOTT CITY, MARYLAND

I, HEREBY, APPLY FOR THE NECESSARY TEST IN ORDER TO CONSTRUCT (OR RECONSTRUCT) A SEWAGE DISPOSAL SYSTEM.

*⊗ or if dry well and trench used need:
(1) 5' earth buffer between trench and dry well.
(2) 2 inspections of trench before and after stone in.
(3) Run trenches on contours and after stone in.*

PROPERTY OWNER Woodmark, Inc.

ADDRESS 9267 Balto. Nat'l. Pike PHONE 461-2889

PROPERTY LOCATION:

SUBDIVISION Farside LOT NO. 45

ROAD AND DESCRIPTION Rt. 40 West to left on Rt. 144, left on Folly Quarter, left on
Homewood, 1 mile to property on left

SIZE OF LOT 3 plus acres TYPE BLDG. _____ NUMBER OF BEDROOMS 4

IF NOT SINGLE RESIDENCE DESCRIBE _____

THE SYSTEM INSTALLED UNDER THIS APPLICATION IS ACCEPTABLE ONLY UNTIL PUBLIC FACILITIES BECOME AVAILABLE.

SIGNATURE OF APPLICANT [Signature]

APPROVED BY C. B. Steaker FOR ⊗ Dry Well & Trench DATE 10/26/79
(KIND OF SYSTEM)

REJECTED BY _____ FOR _____ DATE _____
(KIND OF SYSTEM)


HOLD PENDING FURTHER TESTS _____ DATE _____

REASONS FOR REJECTION OR HOLDING _____

THIS IS NOT A PERMIT

5

Field sheet

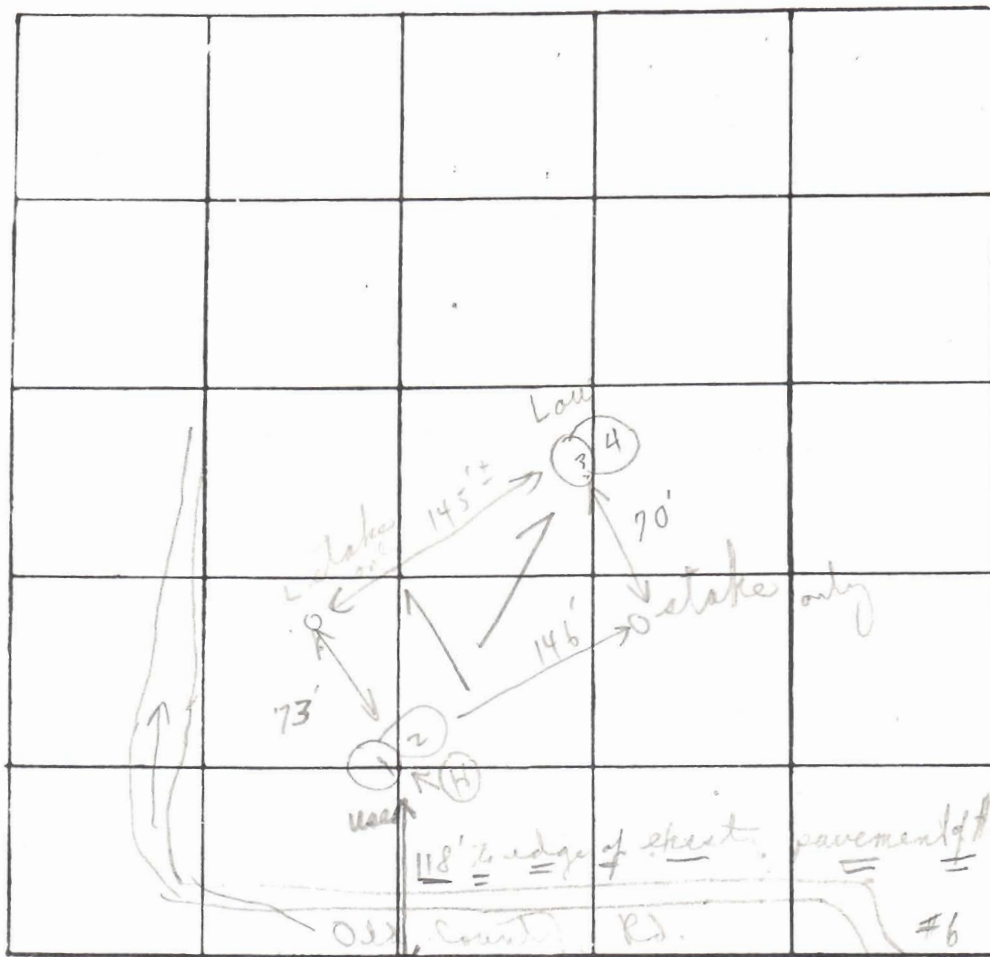

INDICATE NORTH - NAME ADJOINING ROADWAY AS BASE LINE

Woodward Rd

Now #5

Soil Profile

Below clay sand loam

DATE	TEST NO.	DEPTH	PRE-WET		TEST-- 1" DROP		TIME
			START	STOP	START	STOP	
2/13/78	① 1	3 1/2'	2:32	2:34	2:34	2:37	3
	② 2	11'	2:31	2:33	2:33	2:35	2
	③ 3	4'	2:42	2:43	2:43	2:45	2
	④ 4	11'	2:42	2:44	2:44	2:46	2
			2 Holes only		of P.F.W.		
						4	9

Tests per site

3 in

inlet 3

150 sq ft per bedroom

REMARKS Tests in open field

TYPE OF SOIL _____

TESTED BY C. B. S.

ALSO PRESENT: Mr. Steve J. R. D.