

APPLICATION

SEWAGE DISPOSAL TESTING

A 33204

STATE OF MARYLAND - DEPARTMENT OF HEALTH AND MENTAL HYGIENE

P _____

HOWARD COUNTY HEALTH DEPARTMENT
ENVIRONMENTAL HEALTH SERVICES

P. O. BOX 476 ELLICOTT CITY, MARYLAND 21043
TELEPHONE: 992-2330

DISTRICT 3rd.

DATE 10/6/83

TO: THE COUNTY HEALTH OFFICER
ELLICOTT CITY, MARYLAND

I, HEREBY, APPLY FOR THE NECESSARY TEST IN ORDER TO CONSTRUCT (OR RECONSTRUCT) A SEWAGE DISPOSAL SYSTEM.

PROPERTY OWNER Woodmark, Inc.

ADDRESS 12150 Mount Albert Court, Ellicott City, Md. PHONE 531-5072

PROPERTY LOCATION:

SUBDIVISION Farside S/D LOT NO. 5

ROAD AND DESCRIPTION Off Homewood Road, Cedar Line Court

SIZE OF LOT 3 plus acres TYPE BLDG. 3 or 4 Bedrooms
(NUMBER OF BEDROOMS)

THE SYSTEM INSTALLED UNDER THIS APPLICATION IS ACCEPTABLE ONLY UNTIL PUBLIC FACILITIES BECOME AVAILABLE. I FULLY UNDERSTAND THE FEE CONNECTED WITH THE FILING OF THIS PERC TEST APPLICATION IS NON-REFUNDABLE UNDER ANY CIRCUMSTANCES. I ALSO AGREE TO COMPLY WITH ALL M.O.S.H.A. REQUIREMENTS IN TESTING THIS LOT.

Steve Beaver

(SIGNATURE OF APPLICANT)



APPROVED BY _____ FOR _____ DATE _____

REJECTED BY _____ FOR _____ DATE _____


HOLD PENDING FURTHER TESTS _____ DATE _____

REASONS FOR REJECTION OR HOLDING _____

THIS IS NOT A PERMIT

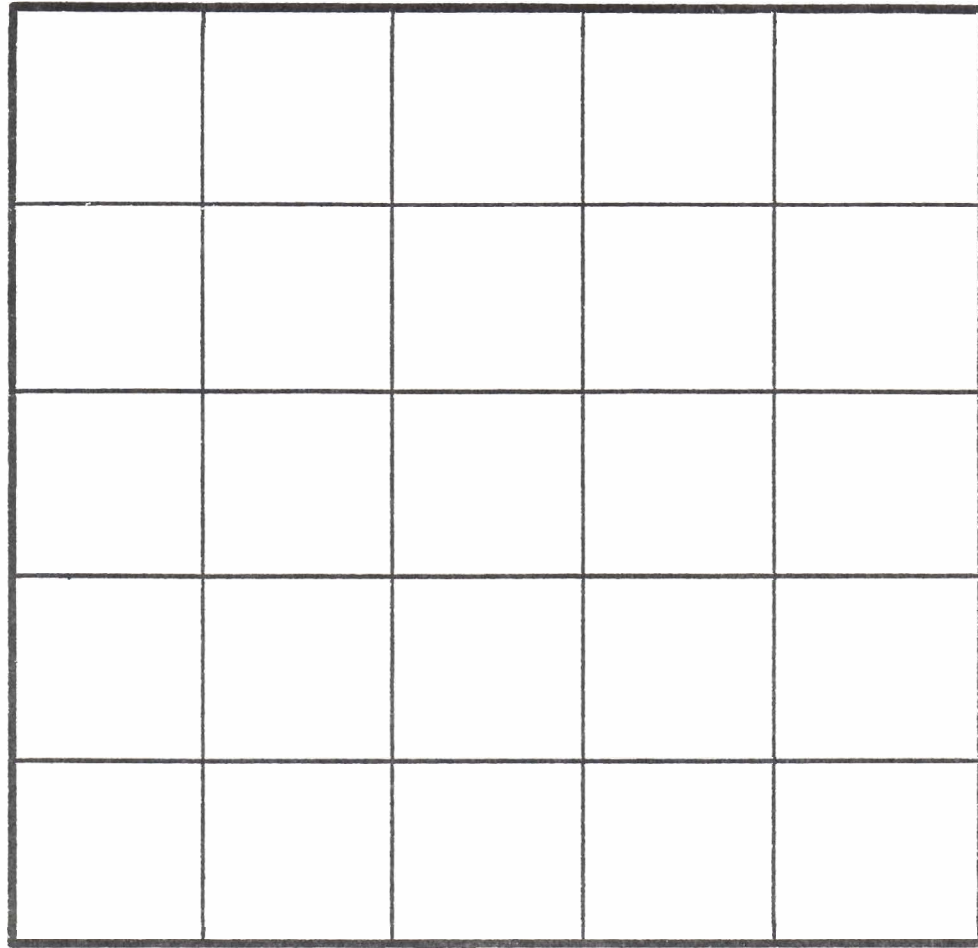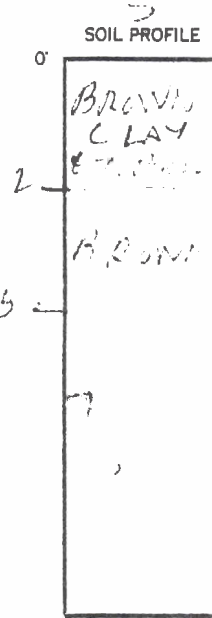

INDICATE NORTH - NAME ADJOINING ROADWAY AS BASE LINE

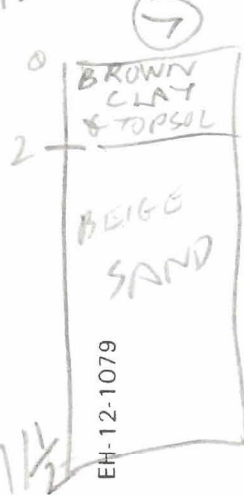

DATE	TEST NO.	DEPTH	PRE-WET		TEST - 1" DROP		TIME
			START	STOP	START	STOP	
10/11/83	5S	3	1045	1047	1047	1051	4
	5D	7 1/2	1046	1050	1050	1054	8
	5V	12 1/2	LOOKS	OK			
	6S	3	1113	1120	1120	1124	4
	6V	12	LOOKS	OK			
	7S	3 1/2	1150	1151	1151	1156	5
	7V	12	LOOKS	OK			
	8V	12	LOOKS	OK			

HOLE ELEV
 (57) HIGH
 (e) MEDIUM
 (34) (5) LOW

REMARKS TRENCH BETWEEN (6) & (7)

TYPE OF SOIL

TESTED BY R. HOESE ALSO PRESENT S. BEAVER

EH-12-1079