

TRENCH/DRAINFIELD DATA		
WIDTH	INLET	BOTTOM
_____	_____	_____
NUMBER OF TRENCHES _____		
TOTAL LENGTH _____		
ABSORPTION AREA _____		
DISTRIBUTION BOX LEVEL _____		
DISTRIBUTION BOX BAFFLE _____		
DISTRIBUTION BOX PORT _____		

SEPTIC TANK DATA	
SEPTIC TANK 1 LEVEL	_____ <input checked="" type="checkbox"/>
Comp. CAPACITY	1500 GAL
SEAM LOC	Top
TANK LID DEPTH	2-3'
BAFFLES	_____ <input checked="" type="checkbox"/>
BAFFLE FILTER	_____
MANHOLE LOC	_____
6" PORT LOC	_____
WATERTIGHT TEST	_____
SEPTIC TANK 2 LEVEL	_____
CAPACITY	_____ GAL
SEAM LOC	_____
TANK LID DEPTH	_____
BAFFLES	_____
BAFFLE FILTER	_____
MANHOLE LOC	_____
6" PORT LOC	_____
WATERTIGHT TEST	_____

PRE-CONSTRUCTION 10/2/04 - SRA staked, fill in SRA needs to be moved. OK to start 1st trenches 5' below upper stakes.

INSTALLATION if they have to w/ 10' CTC. Builder to remove fill, then OK to start, (4) 46.5' trenches (SD)


11/1/04 - Tank set, OK to install (2) 93' trench 10' CTC (SD)

FINAL INSPECTOR [Signature] DATE OF APPROVAL 12/15/04

GENERAL NOTES

1. The existing well shown on this plan (identified with the attached well tag number: HO-94-3693) has been field located by C. B. Miller professional surveyor and is accurately shown.
2. Note: See Approved Grading Plan GP-03-64 for Entire Site.

CEDARVIEW COURT (Public Access Place)

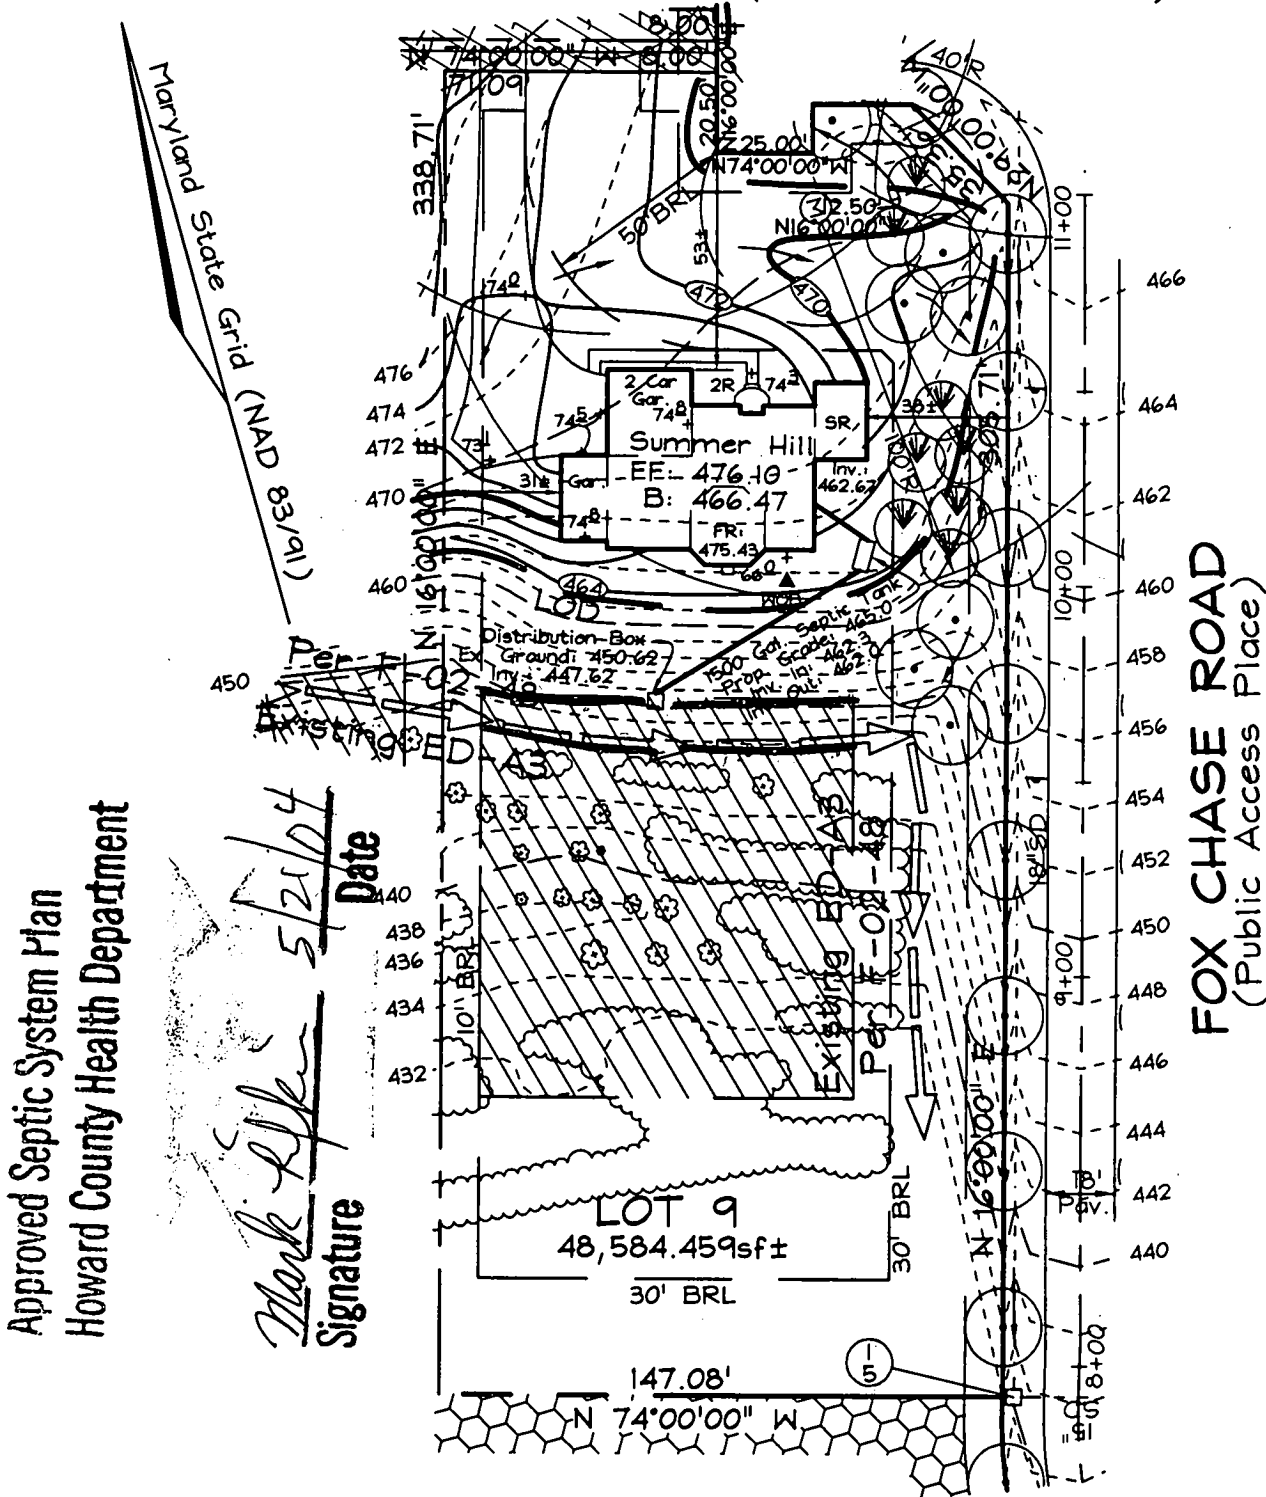

Approved Septic System Plan
Howard County Health Department

Mark R. Miller
Signature
Date: 5/21/04

FSH Associates

Engineers - Planners - Surveyors
8318 Forrest Street Ellicott City, MD 21043
Tel: 410-750-2251 Fax: 410-750-7350
E-mail: FSHAssociates@cs.com

OWNER/DEVELOPER


Williamsburg Group L.L.C.
P.O. Box 1018
Columbia, Maryland 21044

DESIGN BY: PS
DRAWN BY: AY
CHECKED BY: ZYF
SCALE: 1"=50'
DATE: April 26, 2004
W.O. No.: 3003
SHEET No.: 1 OF 1

LOT RESITE LOT 9 FOX CHASE ESTATES

TAX MAP 15 GRID 23
3RD ELECTION DISTRICT

PARCEL 25
HOWARD COUNTY, MARYLAND

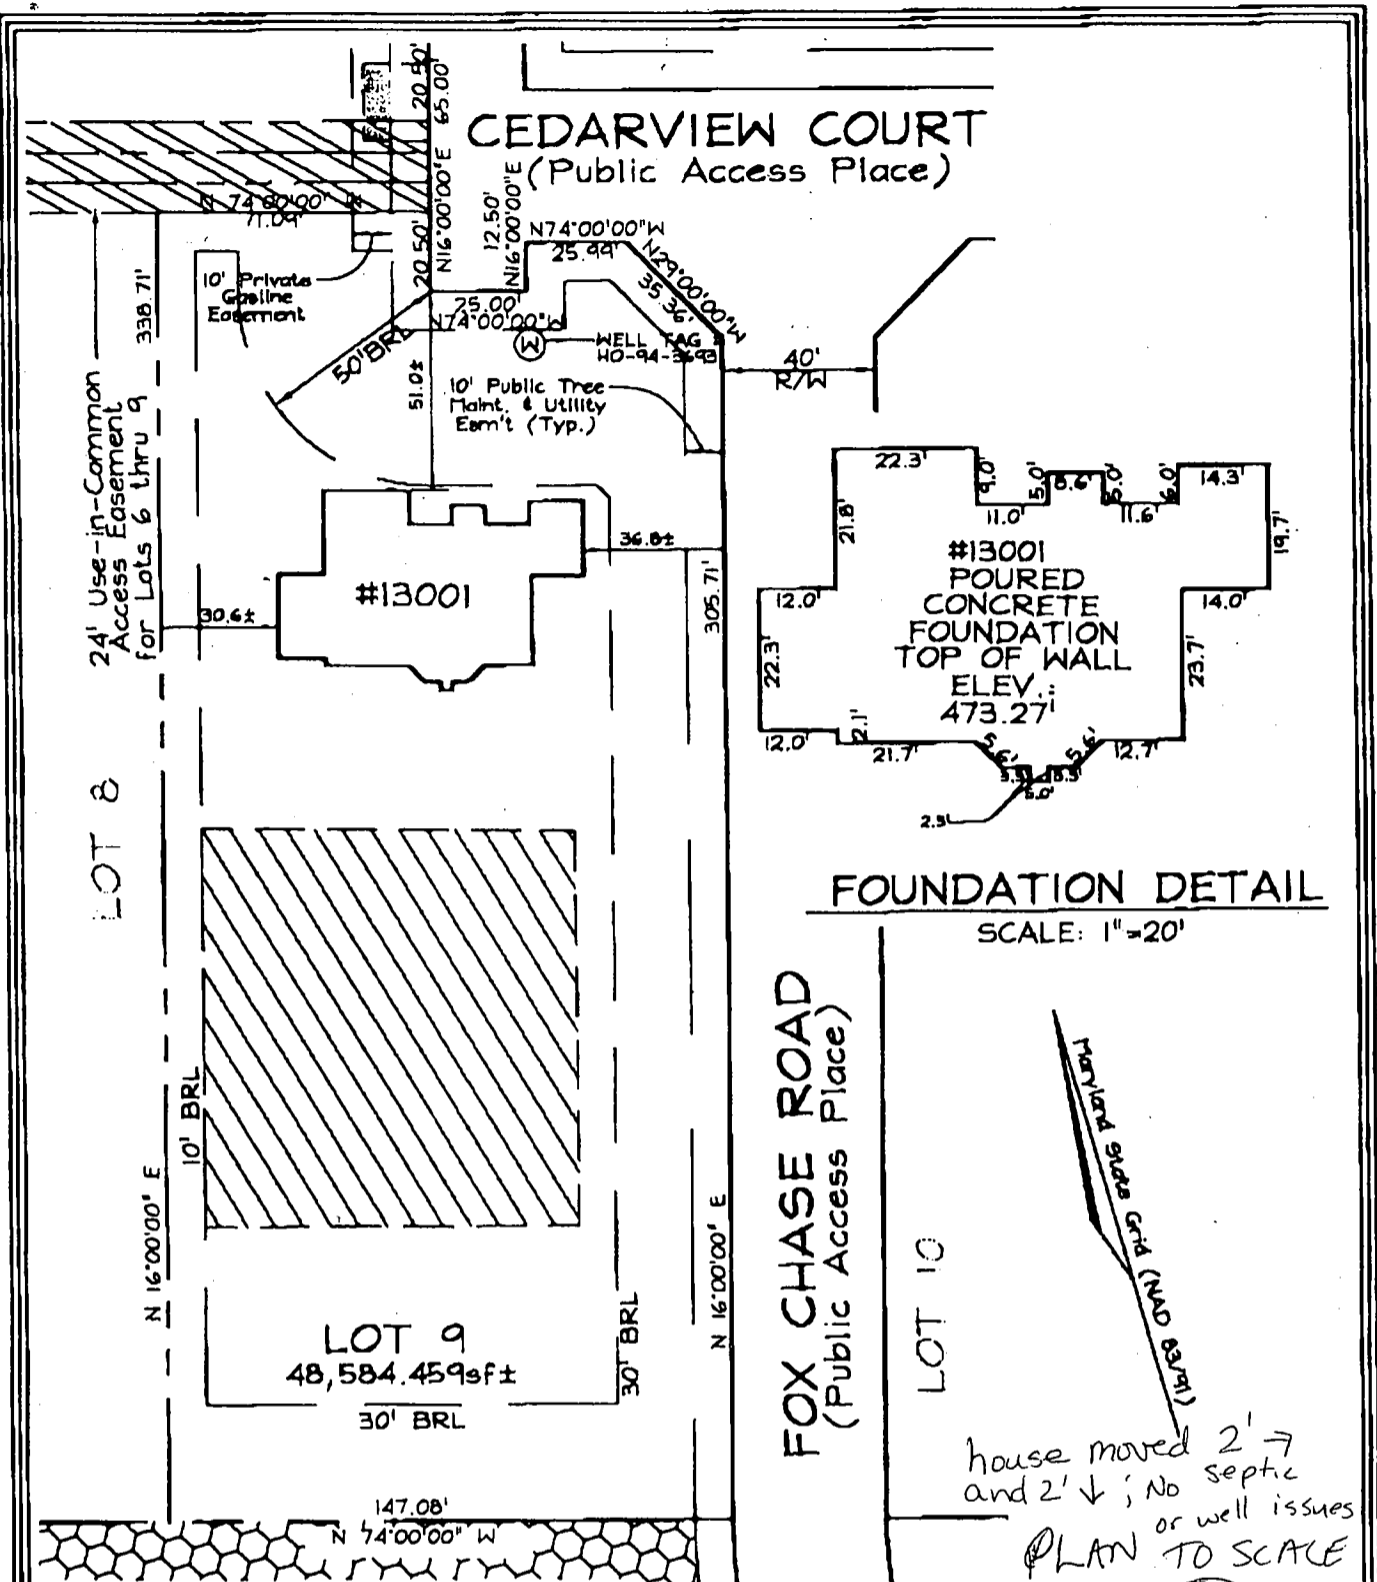

FOUNDATION DETAIL

SCALE: 1"=20'

FOX CHASE ROAD
(Public Access Place)

house moved 2' →
and 2' ↓ ; No septic
or well issues
PLAN TO SCALE

PLAN VIEW

SCALE: 1"=50'

LEGEND


- F/P = FIREPLACE
 - B/W = BAY WINDOW
 - D/W = DRIVEWAY
 - CONC = CONCRETE
 - O/H = OVERHANG
 - H/P = HEAT PUMP/AIR COND.
 - G/M = GAS METER
 - E/M = ELECTRIC METER
- DIMENSIONS FROM FOUNDATION WALL TO PROPERTY LINE ARE ±0.1'
 ADDRESS No. 13001 CEDARVIEW CT.
 WELL TAG #: HO-94-3693
 TOP OF WALL ELEV. = 473.27' FIRST FLOOR ELEV. = N/A
- THE LOCATION DRAWING IS OF BENEFIT TO THE CONSUMER ONLY
 INSOFAR AS IT IS REQUIRED BY A LENDER OR A TITLE INSURANCE
 COMPANY OR ITS AGENT IN CONNECTION WITH CONTEMPLATED
 TRANSFER, FINANCING OR REFINANCING.

FSH Associates

Engineers Planners Surveyors
 8318 Forrest Street Ellicott City, MD 21043
 Tel: 410-750-2251 Fax: 410-750-7350
 E-mail: FSHAssociates@cs.com

THE LOCATION DRAWING IS NOT TO BE RELIED UPON FOR THE ES-
 TABLISHMENT OR LOCATION OF FENCES, GARAGES, BUILDINGS, OR
 OTHER EXISTING OR FUTURE IMPROVEMENTS,
 AND THE LOCATION DRAWING DOES NOT PROVIDE FOR THE
 ACCURATE IDENTIFICATION OF PROPERTY BOUNDARY LINES, BUT
 SUCH IDENTIFICATION MAY NOT BE REQUIRED FOR THE TRANSFER
 OF TITLE OR SECURING FINANCING OR REFINANCING.

WALL CHECK	
FOUNDATION	Date: 07/19/04
FINAL	Date:
DRAWN BY:	BB
SCALE:	As Shown
W.O. No.:	3003

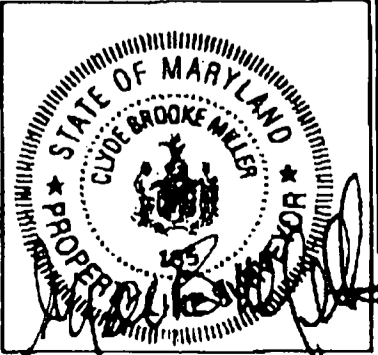

LOT 9
FOX CHASE ESTATES
 PLAT No. 15907
 3RD ELECTION DISTRICT
 HOWARD COUNTY, MARYLAND

98447

DEPARTMENT OF INSPECTIONS, LICENSES AND PERMITS
2400 COURT HOUSE DRIVE
ELICOTT CITY, MD 21043
PERMITS (410) 312-2468 INSPECTIONS (410) 312-1910
AUTOMATED INFORMATION (410) 312-3800

HOWARD COUNTY PERMIT APPLICATION

PERMIT NUMBER
1300147763 *MAN*

Building Address 13001 CENTVIEW CT.
WEST FRIENDSHIP, MD 21794
Suite/Apt. #: N/A SDP/WP/Petition #: GPO3-64
Census Tract 6030 Subdivision FOX CHASE ESTATE
Section N/A Area N/A Lot 9
Tax Map 15 Parcel 25 Grid 2322
Zoning RC Map Coordinates 15672 Lot size 42,534 sq ft

Property Owner's Name WILLIAMSBURG GROUP LLC
Address 5475 HARBERS FARM RD #200
City COLUMBIA State MD Zip Code 21044
Home Phone _____ Work Phone 410-997-8800X17
Applicant's Name & Mailing Address, (if other than stated hereon):
Phone _____ Fax 410-771-4357

Existing Use VACANT LOT
Proposed Use SFD
Estimated Construction Cost \$ 250,000
Description of Work MODEL: SUMMERHILL w/2' EXT
OPT. 3 CAR GARAGE + SINK ROOM, 2 STORY FULL
BSMT, 11K, SFD, 1113 FD + GARAGE (BDR)

Contractor Company SAME AS OWNER
Contact Person _____
Address _____
City _____ State _____ Zip Code _____
License No. 155 Phone _____ Fax _____

Occupant or Tenant SAME AS OWNER
Contact Name _____
Address _____
City _____ State _____ Zip Code _____
Phone _____ Fax _____

Engineer or Architect Company LESSARD ARCH GROUP
Contact Person PREETI
Address 8603 WESTWOOD CENTRE DR #400
City VIENNA State VA Zip Code 22182
Phone 703/760-9344 Fax 703/760-9328

BUILDING DESCRIPTION - COMMERCIAL

BUILDING DESCRIPTION - RESIDENTIAL

Building Characteristics

Utilities

Building Characteristics

Utilities

Height: _____
No. of stories: _____
Gross area, sq. ft. per floor: _____
Use group: _____
Construction type:
 Reinforced Concrete
 Structural Steel
 Masonry
 Wood Frame
 State Certified Modular

Water Supply:
 Public
 Private
Sewage Disposal:
 Public
 Private
Electric Yes No
Gas Yes No
Heating System:
Electric Oil
Natural Gas
Propane Gas
Sprinkler system: N/A
 Full
 Partial
 Other Suppression
 # of Heads

SF Dwelling SF Townhouse
Depth Width
1st floor: _____
2nd floor: _____
Basement: _____
Finished Basement Unfinished Basement
Crawl space Slab on Grade
No. of Bedrooms 5
Multi-family dwellings:
No. of efficiency units: _____
No. of 1 BR units: _____
No. of 2 BR units: _____
No. of 3 BR units: _____
Other Structure: _____
Dimensions: _____
Footings: _____
Roof: _____
 State Certified Modular
 Manufactured Home

Water Supply:
 Public
 Private
Sewage Disposal:
 Public
 Private
Electric Yes No
Gas Yes No
Heating System:
Electric Oil
Natural Gas
Propane Gas
Sprinkler system: N/A
 NFPA #13D
 NFPA #13R
 Other:

THE UNDERSIGNED HEREBY CERTIFIES AND AGREES AS FOLLOWS: (1) THAT HE/SHE IS AUTHORIZED TO MAKE THIS APPLICATION; (2) THAT THE INFORMATION IS CORRECT; (3) THAT HE/SHE WILL COMPLY WITH ALL REGULATIONS OF HOWARD COUNTY WHICH ARE APPLICABLE THERETO; (4) THAT HE/SHE WILL PERFORM NO WORK ON THE ABOVE REFERENCED PROPERTY NOT SPECIFICALLY DESCRIBED IN THE APPLICATION; (5) THAT HE/SHE GRANTS COUNTY OFFICIALS THE RIGHT TO ENTER ONTO THIS PROPERTY FOR THE PURPOSE OF INSPECTING THE WORK PERMITTED AND POSTING NOTICES.

Suzanne P. Davis
Applicant's Signature
AGENT/WJGLLC
Title/Company

SUZANNE P. DAVIS
Print Name
5/3/04
Date

Checks payable to: **DIRECTOR OF FINANCE OF HOWARD COUNTY**
** PLEASE WRITE NEATLY AND LEGIBLY **
- FOR OFFICE USE ONLY -

AGENCY DATE SIGNATURE APPROVAL
 Land Development, DPZ
 State Highways
 Building Official
 Dev. Engineering, DPZ 5/21/04 *Mark Liff*
 Health
 Fire Protection

Is Sediment Control approval required prior to issuance?
YES NO
CONTINGENCY CONSTRUCTION START:
ONE STOP SHOP:

DPZ SETBACK INFORMATION
RECEIVED
From: _____
Rear: _____
Side: _____
Side Set: MAY 18 2004
All minimum setbacks met?
HOWARD COUNTY HEALTH DEPT
BUREAU OF ENVIRONMENTAL HEALTH
YES NO
Historic District?
YES NO
Lot Coverage for New Town Zone _____
SDP/Red-line approval date _____

PROPERTY ID#: 61957
Filing fee \$ 100
Permit fee \$ _____
Excise tax \$ _____
Add'l per. fee \$ _____
TOTAL FEES \$ _____
Sub-total paid \$ _____
Balance due \$ _____
Check # 357
Validation # 47076

Distribution of Copies: White: Building Official Green: LDD, DPZ Yellow: DED, DPZ Pink: Health Gold: SEA

ATTN: Stewart +
HATFIELD'S
EQUIPMENT

Lot 9 Fox Chase
13001 Cedarview
Court

