

C1 0751 (THIS NUMBER IS TO BE PUNCHED IN COLS. 3-6 ON ALL CARDS)

STATE OF MARYLAND WELL COMPLETION REPORT

COUNTY NUMBER A 32532

DATE RECEIVED

DATE WELL COMPLETED 7 6 83

DEPTH OF WELL 200 (TO NEAREST FOOT)

PERMIT NO. FROM "PERMIT TO DRILL WELL" HO-81-0153

OWNER Spokes last name Albert first name
STREET OR RFD Chamblis Drive
SUBDIVISION Glen Mary Estates SECTION TOWN Clarksville LOT 1

WELL LOG Not required for driven wells
STATE THE KIND OF FORMATIONS PENETRATED, THEIR COLOR, DEPTH, THICKNESS AND IF WATER BEARING

Table with columns: DESCRIPTION (Use additional sheets if needed), FEET (FROM, TO), Check if water bearing. Rows include: Area Soil 0-40, Sandstone 46-100, Area Rock 100-200.

GROUTING RECORD
WELL HAS BEEN GROUTED (Circle Appropriate Box) YES [Y] NO [N]
TYPE OF GROUTING MATERIAL CEMENT [CM] BENTONITE CLAY [BC]
NO. OF BAGS 8 NO. OF POUNDS 720
GALLONS OF WATER 70
DEPTH OF GROUT SEAL (to nearest foot) from 0 ft. to 70 ft.

CASING RECORD
casing types insert appropriate code below
[ST] [CO] STEEL CONCRETE
[PL] [OT] PLASTIC OTHER

MAIN CASING Nominal diameter Total depth
TYPE top (main) casing of main casing (nearest inch) (nearest foot)
[ST] [6] [40]

OTHER CASING (if used) diameter depth (feet) from to

SCREEN RECORD
screen type or open hole insert appropriate code below
[ST] [BR] [HO] STEEL BRASS OPEN HOLE
[PL] [OT] PLASTIC OTHER


DEPTH (nearest ft.)
EACH SCREEN 1 HO 40 200
2
3
SLOT SIZE 1 2 3
DIAMETER OF SCREEN (NEAREST INCH) from to

GRAVEL PACK IF WELL DRILLED WAS FLOWING WELL INSERT F IN BOX 68

OEP USE ONLY (NOT TO BE FILLED IN BY DRILLER)
T (E.R.O.S.) WQ
70 72 74 75 76
TELESCOPE CASING LOG INDICATOR OTHER DATA

C 3
PUMPING TEST
HOURS PUMPED (nearest hour) 4
PUMPING RATE (gal. per min. to nearest gal.) 12
METHOD USED TO MEASURE PUMPING RATE 1 GAL CAN
WATER LEVEL (distance from land surface) BEFORE PUMPING 30 WHEN PUMPING 85
TYPE OF PUMP USED (for test) [A] air [P] piston [T] turbine [C] centrifugal [R] rotary [O] other [J] jet [S] submersible

PUMP INSTALLED
DRILLER WILL INSTALL PUMP YES [NO]
IF DRILLER INSTALLS PUMP, THIS SECTION MUST BE COMPLETED FOR ALL WELLS EXCEPT HOME USE
TYPE OF PUMP INSTALLED PLACE (A,C,J,P,R,S,T,O) IN BOX - SEE ABOVE: [29]
CAPACITY: GALLONS PER MINUTE (to nearest gallon) [31] [35]
PUMP HORSE POWER [37] [41]
PUMP COLUMN LENGTH (nearest ft.) [43] [47]
CASING HEIGHT (circle appropriate box and enter casing height) [above] [below] LAND SURFACE [7] (nearest foot)

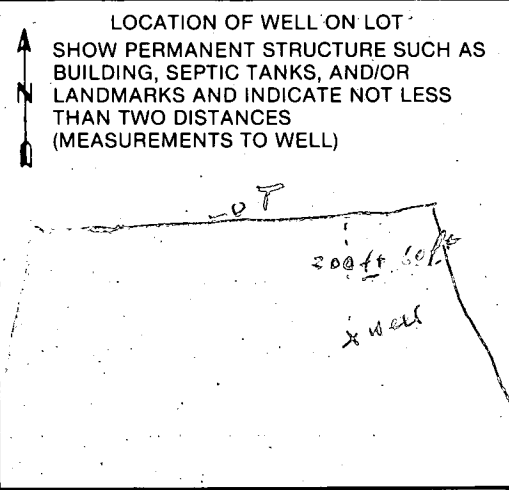

CIRCLE APPROPRIATE LETTER
A A WELL WAS ABANDONED AND SEALED WHEN THIS WELL WAS COMPLETED
E ELECTRIC LOG OBTAINED
P TEST WELL CONVERTED TO PRODUCTION WELL

I HEREBY CERTIFY THAT THIS WELL HAS BEEN CONSTRUCTED IN ACCORDANCE WITH COMAR 10.17.13 "WELL CONSTRUCTION" AND IN CONFORMANCE WITH ALL CONDITIONS STATED IN THE ABOVE CAPTIONED PERMIT, AND THAT THE INFORMATION PRESENTED HEREIN IS ACCURATE AND COMPLETE TO THE BEST OF MY KNOWLEDGE.

DRILLERS IDENT. NO. 209
DRILLERS SIGNATURE (MUST MATCH SIGNATURE ON APPLICATION)

SITE SUPERVISOR (sign. of driller or journeyman responsible for sitework if different from permittee)

B 1 3449

SEQUENCE NO. (OEP USE ONLY) 7/6/83
12:00 Great

STATE OF MARYLAND
PERMIT TO DRILL WELL
please print or type

OEP PERMIT NUMBER
HO-81-0153
fill in this form completely

Date Received

060983

OWNER INFORMATION

SPOKES ALBERT
Last Name Owner First Name

7730 CARTER RD
Street or RFD

SYKESVILLE MD 21784
Town State Zip

DRILLER INFORMATION

Howard Dillon
Driller's Name License No. 809

Dillon Bros Inc
Firm Name

6514 N VERNON AVE
Address

Baltimore MD 21215
Signature Date 6/8/83

B 3

LOCATION OF WELL

HOWARD
8 COUNTY

GLEN MARY ESTATES
23 SUBDIVISION


SECTION CLARKSVILLE LOT 1

JARROVILLE
52 NEAREST TOWN

MILES FROM TOWN (enter 0 if in town) 0 MI

B 4

DIRECTION OF WELL FROM TOWN (CIRCLE BOX)

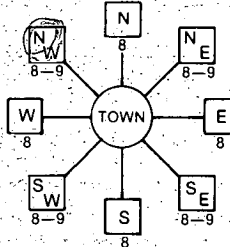

CHAMBLIS Drive
11 NEAR WHAT ROAD 30

ON WHICH SIDE OF ROAD (CIRCLE APPROPRIATE BOX)



500
34 DISTANCE FROM ROAD 37

ENTER FT or MI FT

NOT TO BE FILLED IN BY DRILLER
HEALTH DEPARTMENT APPROVAL

HOWARD
COUNTY NAME

A32532
COUNTY NO.

OEP SIGNATURE DATE ISSUED
STATE HEALTH INSERT-S

062283 Frank Shearin 12/22/83
43 CO SIGNATURE 48 EXP. DATE

NORTH GRID 504000 EAST GRID 0812000
50 55 57 63

APPROXIMATE DEPTH OF WELL 500 FEET

APPROXIMATE DIAMETER OF WELL 6 INCH

METHOD OF DRILLING (circle one)

BORED (or Augered) JETTED Jetted & DRIVEN
AIR-ROTary AIR-PERCUSSION ROTARY (Hydraulic Rotary)
CABLE REVERSE-ROTary Drive-POINT
other

REPLACEMENT OR DEEPEMED WELLS (CIRCLE APPROPRIATE BOX)

N THIS WELL WILL NOT REPLACE AN EXISTING WELL
Y THIS WELL WILL REPLACE A WELL THAT WILL BE ABANDONED AND SEALED
S THIS WELL WILL REPLACE A WELL THAT WILL BE USED AS A STANDBY
D THIS WELL WILL DEEPEM AN EXISTING WELL

PERMIT NUMBER OF WELL TO BE REPLACED OR DEEPEMED (IF AVAILABLE)

Not to be filled in by driller (OEP USE ONLY)

APPROP. PERMIT NUMBER GAP

FORCE INITIALS PERMIT No. HO-81-0153


SPECIAL CONDITIONS

SHOW MAJOR FEATURES OF BOX & LOCATE WELL WITH AN X


SOURCES OF DRILLING WATER

- 1.
- 2.
- 3.

WRITE THE BOX NUMBER FROM THE MAP HERE

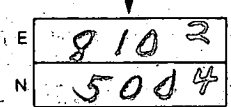

DRAW A SKETCH BELOW SHOWING LOCATION OF WELL IN RELATION TO NEARBY TOWNS AND ROADS AND GIVE DISTANCE FROM WELL TO NEAREST ROAD JUNCTION

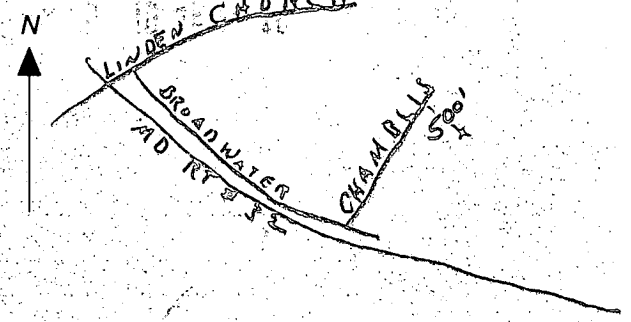

7/6/83

- ① LOCATION OK WELL IS 182 FT from
NEAREST PERC HOLE
- ② 40 FT CASING
- ③ 39 FT OPEN HOLE
- ④ 8 BAGS
- ⑤ WELL OK
- ⑥ Yield test today

R. Hodges