

5-19-86
ASAP

Septic Repair
OK
②

TAX# 05 356423

PERMIT

P. 37015
A. REPAIR

SEWAGE DISPOSAL SYSTEM
MARYLAND STATE DEPARTMENT OF HEALTH

HOWARD COUNTY
BUREAU OF ENVIRONMENTAL HEALTH
~~XXXXXXX~~
461-9933

ELLICOTT CITY
DISTRICT _____
DATE 5/22/86

INDEXED

Jack Fyock IS PERMITTED TO INSTALL _____ ALTER X

ADDRESS _____ PHONE 988-9270

SUBDIVISION Moorestfield ROAD 7430 Cherry Tree Drive LOT 5, Section 4

PROPERTY OWNER John Lee Lane

ADDRESS _____

IF GARBAGE GRINDER IS USED INCREASE SEPTIC TANK CAPACITY BY 50% AND ABSORPTION AREA BY 22%.

GARBAGE GRINDER? YES probably NO _____
(House 13 years old)
SEPTIC TANK CAPACITY 750 GALLONS NUMBER OF BEDROOMS 3

REPAIR - CALL FOR INSPECTION WHEN GROUND IS OPENED UP SO SANITARIAN CAN RECOMMEND

REPAIR.

Good soils. Britty sandy mica loam uniform after
4+ of red/orange clay layer.

PLANS APPROVED BY C. Williams DATE 5/15/86

COVER NO WORK UNTIL INSPECTED AND APPROVED.

NEITHER THE HOWARD COUNTY COUNCIL NOR THE HEALTH DEPARTMENT IS RESPONSIBLE FOR THE SUCCESSFUL OPERATION OF ANY SYSTEM.

NOTE: IF TRENCH IS USED CALL FOR INSPECTION BEFORE AND AFTER PLACING GRAVEL IN TRENCH.

NOTE: NO DRY WELL SHALL EXCEED 15 FOOT IN DIAMETER. NO ABSORPTION TRENCH TO EXCEED 100 FEET IN LENGTH.

NOTE: ALL PIPE FROM HOUSE TO SEPTIC TANK MUST BE CAST IRON OR SCHEDULE 40 PVC OR ABS.

PERMIT VOID AFTER THREE YEARS.


NOTE: INSTALL STAND PIPE ON SEPTIC TANK AND DRY WELL. STAND PIPES MUST BE 6 INCHES IN DIAMETER. CAST IRON, CONCRETE OR TERRA COTTA, OR PVC OR ABS ACCEPTED. IF TOP OF SEPTIC TANK IS DEEPER THAN 3 FEET MANHOLE TO GRADE REQUIRED.

***INSTALLER IS RESPONSIBLE FOR OBTAINING FINAL APROVAL ON THIS PERMIT**

CALL 992-2330 FOR INSPECTION OF SEPTIC SYSTEMS.

EH - 2-1082

REPAIR
37015

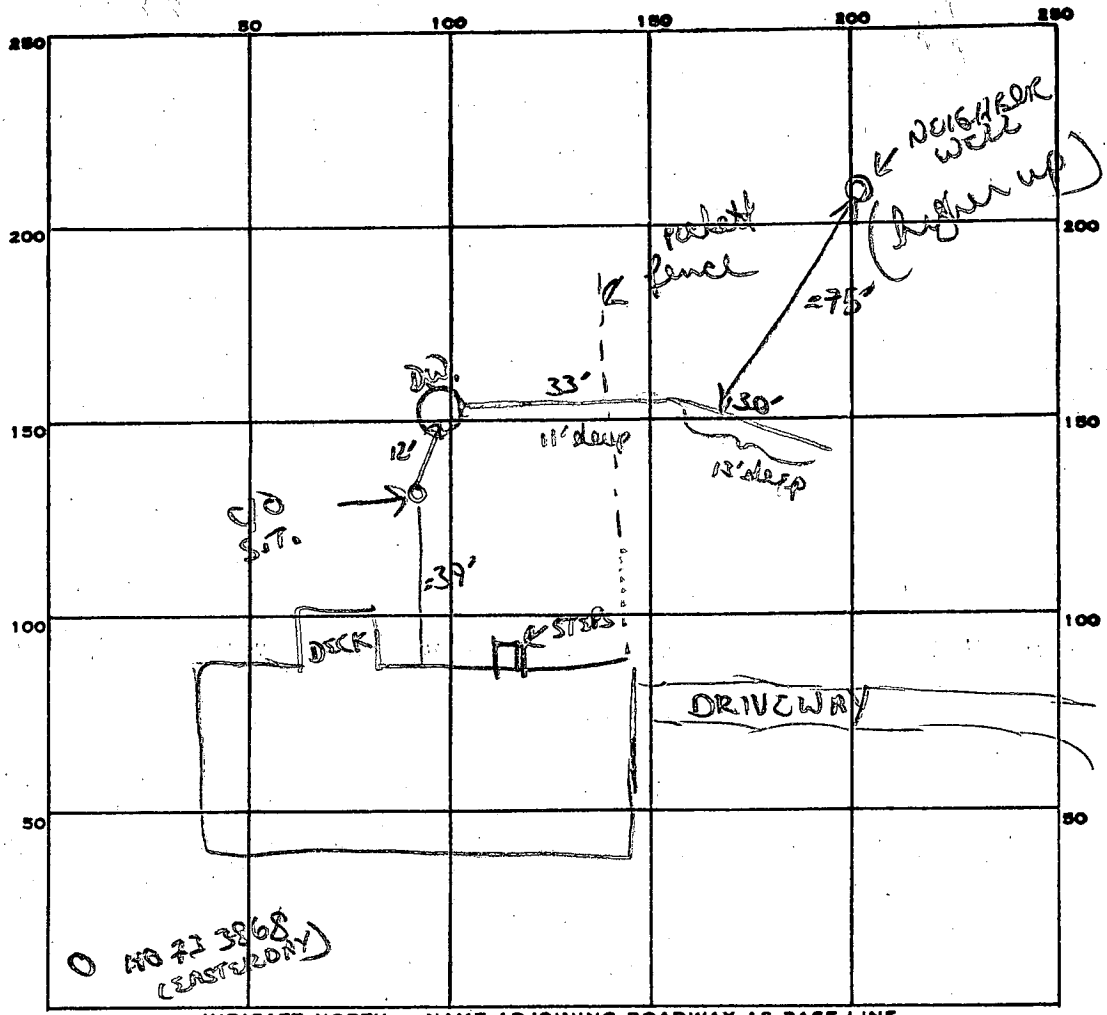

O NO 72 3868
(EASTERN)

INDICATE NORTH. - NAME ADJOINING ROADWAY AS BASE LINE.

TERRACE

PERMIT CARD ✓ fuel CHERRY TREE DR

SEPTIC TANK, LEVEL existing (750 or 1000 gal) CLEANOUTS 1 New one on S/T

DISTRIBUTION BOX, LEVEL _____

TILE FIELD, DEPTH 11 1/2 FT. TRENCH WIDTH 2 FT.

GRAVEL DEPTH 5 1/2 to 7 1/2 FT. TOTAL LENGTH = 63' FT.

NUMBER OF TRENCHES 1 TOTAL BOTTOM AREA = 410

SEEPAGE PITS, INSIDE DIAMETER ? FT. DEPTH BELOW INLET ? FT.

ABSORBENT AREA 410 SQ. FT.

125
3
375 min

63
6.5
31.5
378
409.5

REMARKS 5/19/86 OK to add trench off dry well. Soils good.
OK to add stone pipe, paper to trench OK to cover
trench & all work.

DATE SYSTEM APPROVED 5/19/86 INSPECTOR B. Wiper