

03-288560

8-1388

8/8/86
9:30
8/12/86

Approved
Signed

P 37401
A REPAIR

PERMIT

SEWAGE DISPOSAL SYSTEM

MARYLAND STATE DEPARTMENT OF HEALTH

HOWARD COUNTY
BUREAU OF ENVIRONMENTAL HEALTH
X892X2330
461-9933

INDEXED

ELLCOTT CITY
DISTRICT _____

DATE 7/17/86

FORMERLY
STEVE KATZ PROPERTY

James B. Brickell, Jr. 489 7733 IS PERMITTED TO INSTALL _____ ALTER X

ADDRESS Carl S. Carlson PHONE 795-1499

SUBDIVISION _____ ROAD 12201 Howard Lodge Drive LOT _____

PROPERTY OWNER _____ James B. Brickell, Jr.

ADDRESS Farm at end of Howard Lodge Rd

IF GARBAGE GRINDER IS USED INCREASE SEPTIC TANK CAPACITY BY 50% AND ABSORPTION AREA BY 22%.

GARBAGE GRINDER? YES NO _____

SEPTIC TANK CAPACITY 1500 GALLONS NUMBER OF BEDROOMS 4

1250
625
1250
600
18050

REPAIR - CALL FOR INSPECTION WHEN GROUND IS OPENED UP SO SANITARIAN CAN RECOMMEND REPAIR.

PURPOSE OF REPAIR IS TO STOP OVERFLOW

REPLACE OLD CESSPOOL WITH NEW TANK

EXISTING TRENCH IS DRY. SEWAGE IS NOT

GETTING TO TRENCH, CESSPOOL PARTLY CAVED IN.

8/8/86 - DISCUSSED WITH GRAIG OK TO HAVE 1500

GAL TANK OK TO USE OLD TRENCH

PUT IN CLEANOUT ON HOUSE SEWER. IF IT IS NECESSARY TO REPLACE HOUSE SEWER

PLANS APPROVED BY C. Williams DATE 7/25/86

COVER NO WORK UNTIL INSPECTED AND APPROVED.

NEITHER THE HOWARD COUNTY COUNCIL NOR THE HEALTH DEPARTMENT IS RESPONSIBLE FOR THE SUCCESSFUL OPERATION OF ANY SYSTEM.

NOTE: IF TRENCH IS USED CALL FOR INSPECTION BEFORE AND AFTER PLACING GRAVEL IN TRENCH.

NOTE: NO DRY WELL SHALL EXCEED 15 FOOT IN DIAMETER. NO ABSORPTION TRENCH TO EXCEED 100 FEET IN LENGTH.

NOTE: ALL PIPE FROM HOUSE TO SEPTIC TANK MUST BE CAST IRON OR SCHEDULE 40 PVC OR ABS.

PERMIT VOID AFTER THREE YEARS.


NOTE: INSTALL STAND PIPE ON SEPTIC TANK AND DRY WELL. STAND PIPES MUST BE 6 INCHES IN DIAMETER. CAST IRON, CONCRETE OR TERRA COTTA, OR PVC OR ABS ACCEPTED. IF TOP OF SEPTIC TANK IS DEEPER THAN 3 FEET MANHOLE TO GRADE REQUIRED.

***INSTALLER IS RESPONSIBLE FOR OBTAINING FINAL APPROVAL ON THIS PERMIT**

*CALL 992-2330 FOR INSPECTION OF SEPTIC SYSTEMS.

EH - 2-1082

P 37401

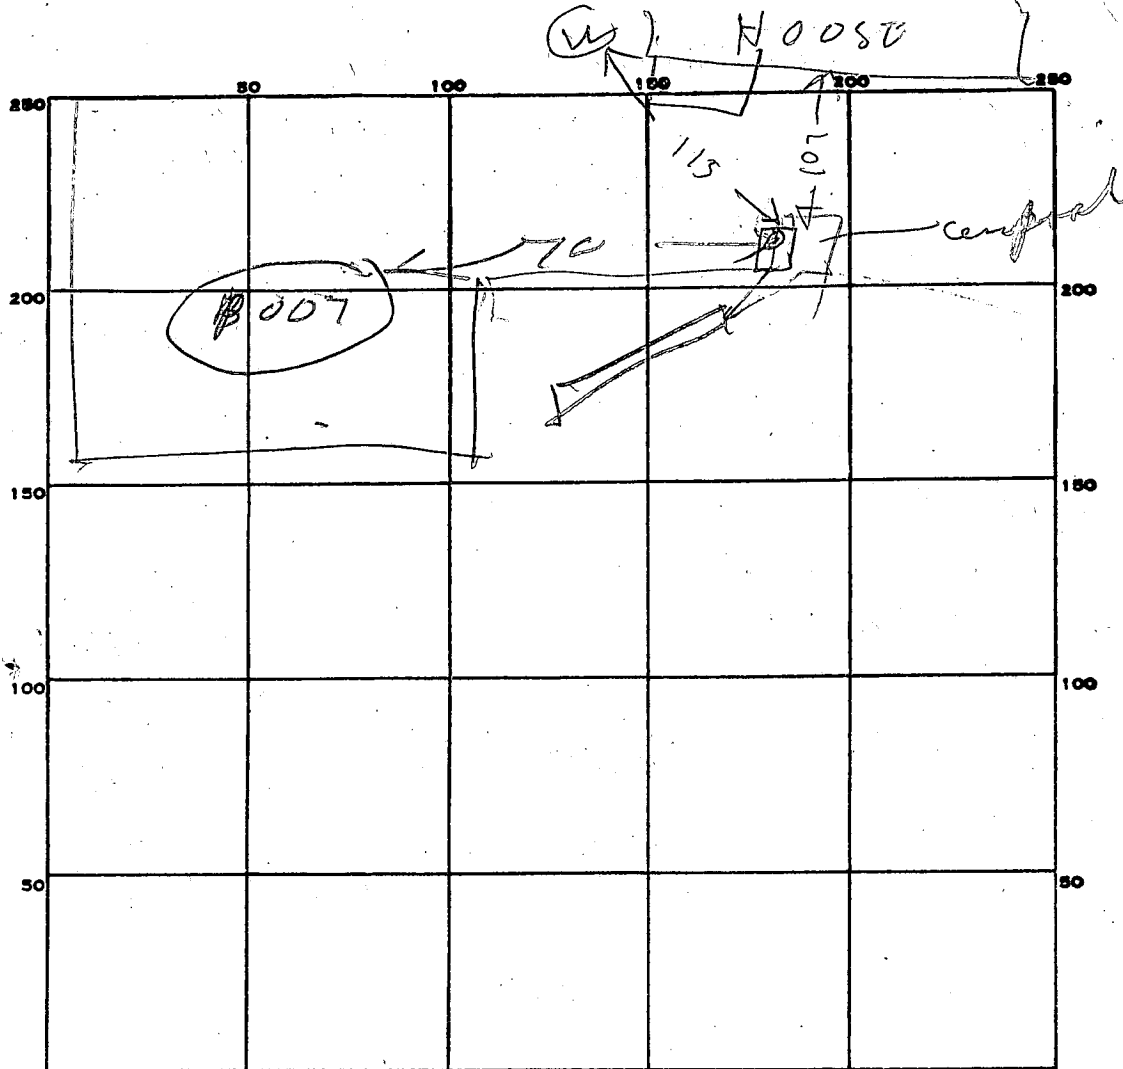

INDICATE NORTH. - NAME ADJOINING ROADWAY AS BASE LINE.

PERMIT CARD

SEPTIC TANK, LEVEL 1500 GAL

CLEANOUTS 1ST

DISTRIBUTION BOX, LEVEL

TILE FIELD, DEPTH EXISTING TRENCH FT. TRENCH WIDTH _____ FT.

GRAVEL DEPTH _____ IN. TOTAL LENGTH _____ FT.

NUMBER OF TRENCHES _____ TOTAL BOTTOM AREA _____

SEEPAGE PITS, INSIDE DIAMETER _____ FT. DEPTH BELOW INLET _____ FT.

ABSORBENT AREA _____ SQ. FT.

REMARKS TANK REPLACED, CONNECTS TO EXISTING TRENCH.

DATE SYSTEM APPROVED 8-13-84

INSPECTOR S. M. R.

PERMIT

25313

P 25313

SEWAGE DISPOSAL SYSTEM

A _____

MARYLAND STATE DEPARTMENT OF HEALTH

HOWARD COUNTY

ELLICOTT CITY

*Repair St. use tee,
cement around perimeter 150 sq ft bedrooms / 4 bedrooms
Trench aug depth 10' 8' stone. 18" min. width or*

DISTRICT

3

DATE

2-28-77

160' Trench 10" wide 10' deep 8' stone

INDEXED

Steve Katz

IS PERMITTED TO INSTALL

ALTER

ADDRESS Sunset Hills Farm, Howard Lodge Rd.

PHONE 774 22 2909

A SEWAGE DISPOSAL SYSTEM LOCATED AT same

SUBDIVISION NA

ROAD Howard Lodge Rd.

LOT _____

PROPERTY OWNER Katz,

ADDRESS same

SPECIFICATIONS

DRAIN FIELD _____ DEPTH _____ FEET, BOTTOM AREA _____ SQ. FT.

SEEPAGE PITS _____ ABSORBENT SIDE-WALL AREA _____ SQ. FT.

SEPTIC TANK CAPACITY _____ GALLONS

FOR GARBAGE GRINDER, INCREASE DISPOSAL AREA 22% & TANK CAPACITY 50%.

OTHER Sanitarian to test one hole to check for repair area 50-75' from cesspool.

Check Cesspool, if it is unsatisfactory require addition of sanitary tees and

specify repair system, (dry well or trench). DJO'N 2-28-77.

PLANS APPROVED BY

DJO'N


DATE

2/28/77

FILL SEPTIC TANK AND DISTRIBUTION BOX WITH WATER BEFORE CALLING FOR AN INSPECTION. COVER NO WORK UNTIL INSPECTED AND APPROVED.

NEITHER THE HOWARD COUNTY COMMISSIONERS NOR THE HEALTH DEPARTMENT IS RESPONSIBLE FOR THE SUCCESSFUL OPERATION OF ANY SYSTEM.

P 25313

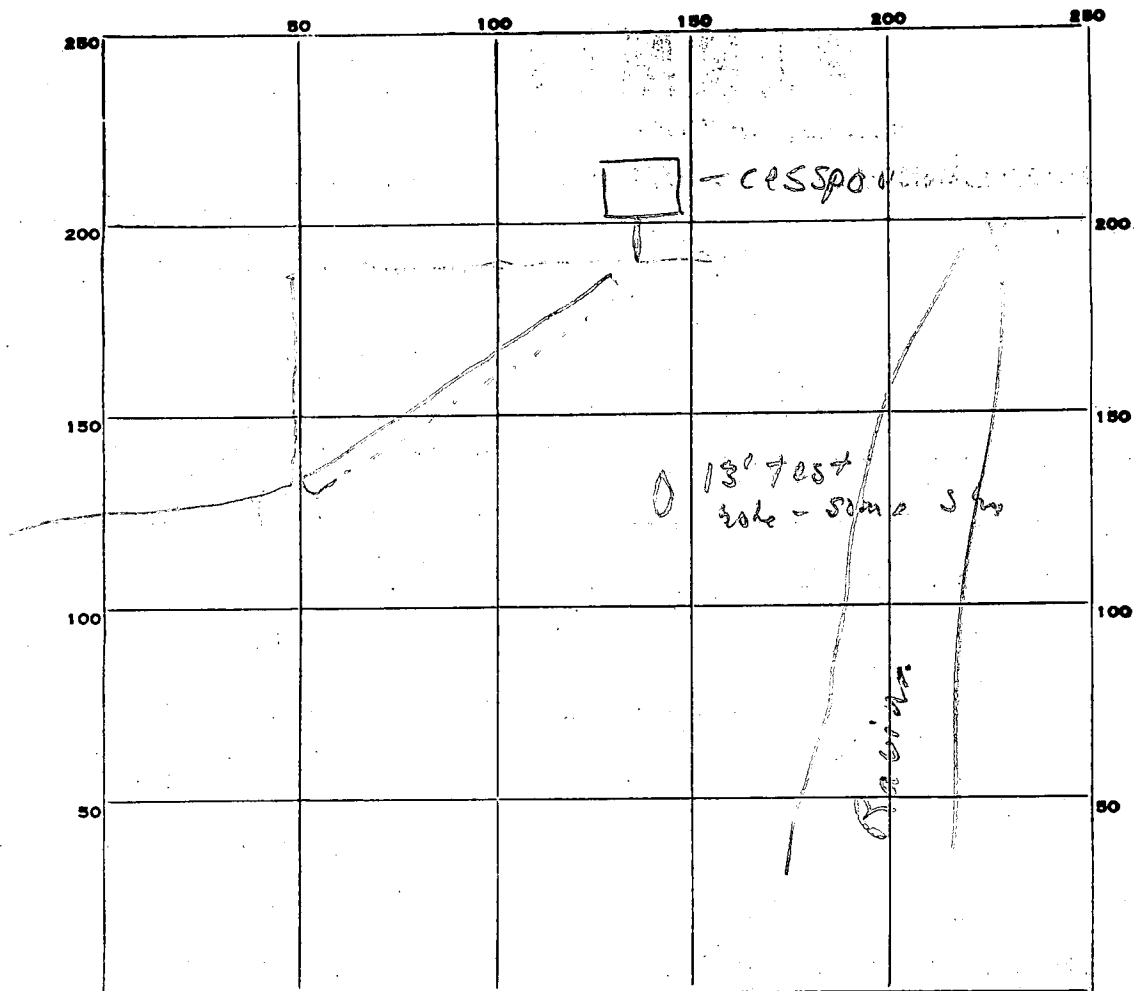

INDICATE NORTH. - NAME ADJOINING ROADWAY AS BASE LINE.

PERMIT CARD _____

SEPTIC TANK, LEVEL _____

CLEANOUTS _____

DISTRIBUTION BOX, LEVEL _____

TILE FIELD, DEPTH _____ FT. TRENCH WIDTH _____ FT.

GRAVEL DEPTH _____ IN. TOTAL LENGTH _____ FT.

NUMBER OF TRENCHES _____ TOTAL BOTTOM AREA _____

SEEPAGE PITS, INSIDE DIAMETER _____ FT. DEPTH BELOW INLET _____ FT.

ABSORBENT AREA _____ SQ. FT.

REMARKS _____

DATE SYSTEM APPROVED _____

INSPECTOR _____

PERMIT

SEWAGE DISPOSAL SYSTEM

MARYLAND STATE DEPARTMENT OF HEALTH

HOWARD COUNTY

ELLICOTT CITY

DISTRICT _____

DATE _____

P _____

A _____

Steve Katz

IS PERMITTED TO INSTALL ALTER _____

ADDRESS Sunset Hill Farm

PHONE _____

A SEWAGE DISPOSAL SYSTEM LOCATED AT Above. Go to end of Howard ledge Rd.

SUBDIVISION Original Farm House ROAD Howard ledge LOT _____

PROPERTY OWNER Katz

ADDRESS _____

SPECIFICATIONS

DRAIN FIELD _____ DEPTH _____ FEET, BOTTOM AREA _____ SQ. FT.

SEEPAGE PITS _____ ABSORBENT SIDE-WALL AREA _____ SQ. FT.

SEPTIC TANK CAPACITY _____ GALLONS

| | |
|-------|-----|
| 75 | 84 |
| 8 | 6 |
| <hr/> | |
| 600 | 516 |

FOR GARBAGE GRINDER, INCREASE DISPOSAL AREA 22% & TANK CAPACITY 50%.

OTHER 1. Place Sanitary Tee in Septic 2. Seal Septic with concrete wall around existing cesspool

3. OK to use plastic too 4. Trench 75' 2' wide or 100' 10" wide 1 in 2' man aug depths 10' Bottom of Trench and dist line to be ~ level.

96
6
6

PLANS APPROVED BY DPD/PFW


DATE 4/15/99

FILL SEPTIC TANK AND DISTRIBUTION BOX WITH WATER BEFORE CALLING FOR AN INSPECTION. COVER NO WORK UNTIL INSPECTED AND APPROVED.

NEITHER THE HOWARD COUNTY COMMISSIONERS NOR THE HEALTH DEPARTMENT IS RESPONSIBLE FOR THE SUCCESSFUL OPERATION OF ANY SYSTEM.

Existing Septic Cesspool may be cleaned and sealed to upgrade to septic tank

DPD

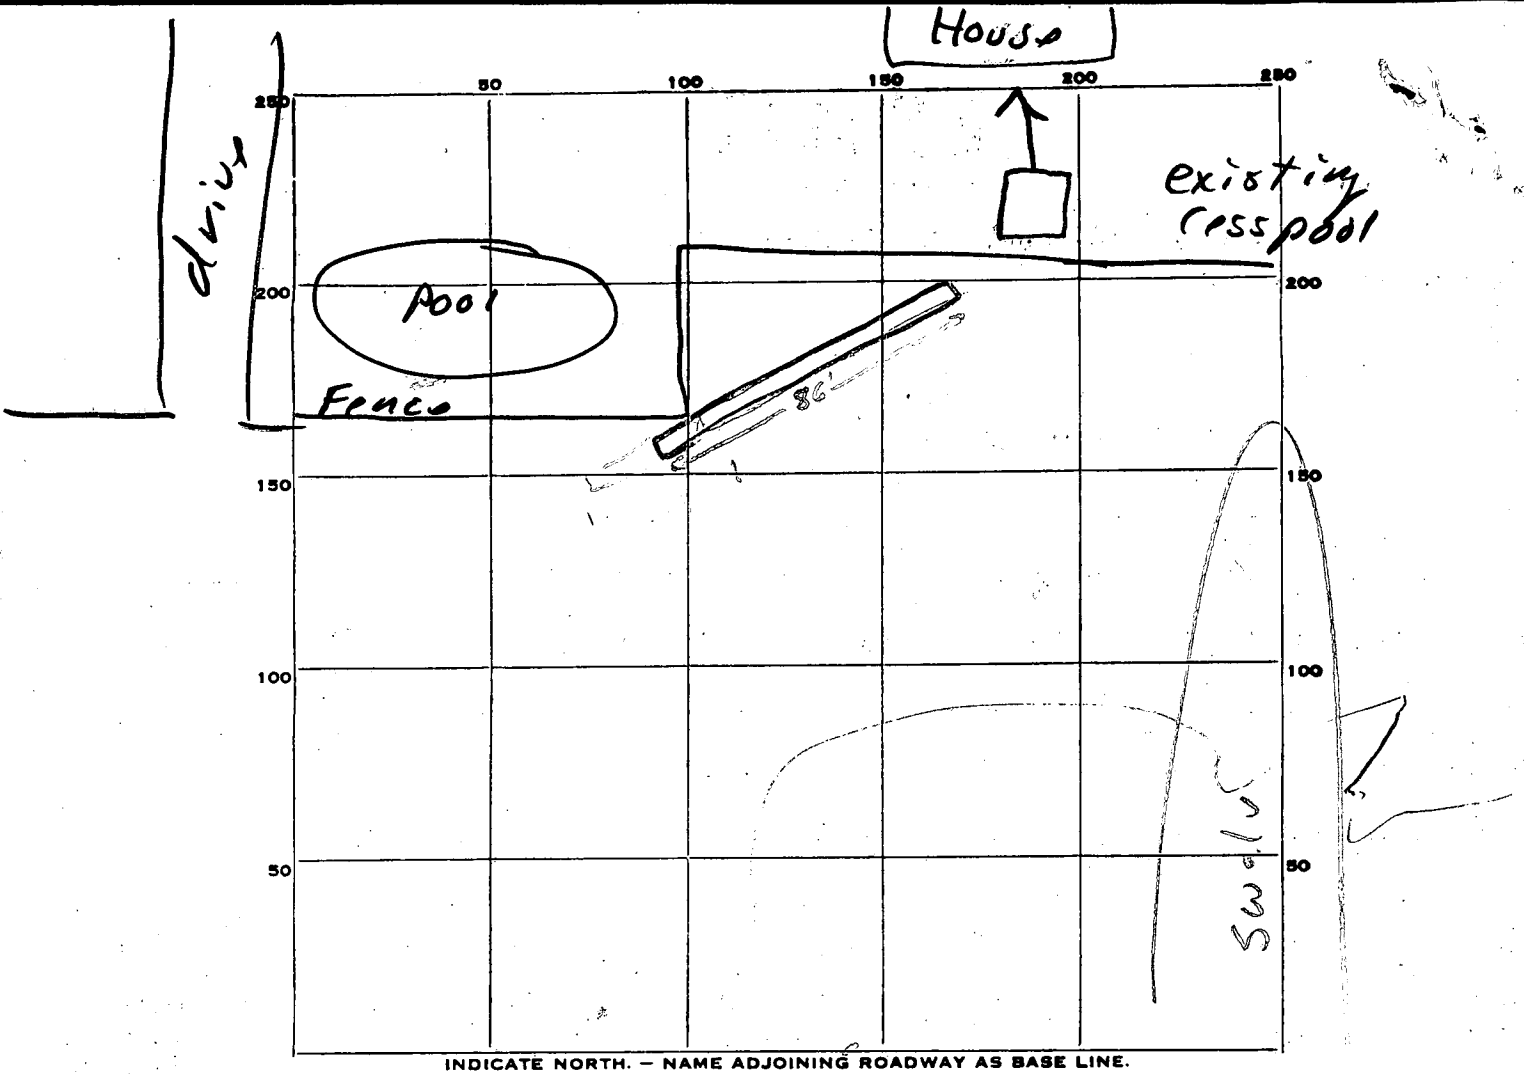

PERMIT CARD _____

SEPTIC TANK, LEVEL _____ CLEANOUTS _____

DISTRIBUTION BOX, LEVEL _____

TILE FIELD, DEPTH _____ FT. TRENCH WIDTH _____ FT.

GRAVEL DEPTH _____ IN. TOTAL LENGTH _____ FT.

NUMBER OF TRENCHES _____ TOTAL BOTTOM AREA _____

SEEPAGE PITS, INSIDE DIAMETER _____ FT. DEPTH BELOW INLET _____ FT.

ABSORBENT AREA _____ SQ. FT.

REMARKS check Katy Permit for P# 4/18/77 trench dug 86' long 2' wide 18' deep
 O.K. to dig out trench to 100' in length and to add gravel to trench F.S.
 4/19/77 spoke w one of owners (name below). Entire SS has been covered
 except where pipe goes fr. old cesspool to trench. Corrugated plastic pipe
 apparently installed w holes up, no metal stakes. No work done to cesspool.
 system satisfactory to owner M. Wagner
 Refer to FS, POP and DWM. WWB

DATE SYSTEM APPROVED _____ INSPECTOR _____

2104 4/25/77 WWB 4/25/77

1 **1** **5135** SEQUENCE NO. (WRA USE ONLY)

1 2 3 (SEQ. NO.) 6
 (THIS NUMBER IS TO BE PUNCHED IN COLS. 3-6 ON ALL CARDS)

STATE OF MARYLAND
WATER RESOURCES ADMINISTRATION
TAWES STATE OFFICE BLDG., ANNAPOLIS, MARYLAND 21401
APPLICATION FOR PERMIT TO DRILL WELL

WRA PERMIT NUMBER

FILL IN THIS FORM COMPLETELY

DATE RECEIVED (WRA USE ONLY)

8-13

OWNER Stoneman Russell
 COL 15 LAST NAME FIRST NAME COL 34

STREET OR RFD 3575 Powder Mill Rd.
 COL 36 COL 66

POST OFFICE Beltville Md.
 COL 87 COL 76

B 1 CONTINUED **DRILLER INFORMATION**

1 2 3 (SEQ. NO.) 6

DATE 7/10/77 LICENSE NUMBER 42
 77 80

FIRST NAME S. H. Easterday DRILLER LAST NAME

SIGNATURE S. H. Easterday

B 3 **LOCATION OF WELL**

1 2 3 (SEQ. NO.) 6

COUNTY Stow (DO NOT ABANDON (STATE COUNTY NAME)) 21

SUBDIVISION Brookfield Park 42

SECTION 4 LOT 4
 44 48 60

NEAREST TOWN Fulton 52

MILES FROM TOWN (ENTER 0 IF IN TOWN) 2 M I 70 77 78

B 2 **WELL INFORMATION**

1 2 3 (SEQ. NO.) 6

MAXIMUM PUMPING RATE (GALLONS PER MINUTE) 5
 8 .12

AVERAGE DAILY QUANTITY NEEDED (GALLONS PER DAY) 600
 14 20

USE FOR WATER (CIRCLE APPROPRIATE BOX)

D HOME (SINGLE OR DOUBLE HOUSEHOLD UNIT ONLY)

F FARMING, AGRICULTURE, IRRIGATION

I INDUSTRIAL, COMMERCIAL, STATE AND FEDERAL GOVERNMENT.

M MUNICIPAL WATER SUPPLY

P PRIVATE WATER COMPANY

TEST

MUST HAVE STATE HEALTH DEPT. APPROVAL

B 4 **DIRECTION FROM TOWN (CIRCLE APPROPRIATE BOX)**

1 2 3 (SEQ. NO.) 6

N NORTH E EAST NE NORTHEAST SE SOUTHEAST

S SOUTH W WEST NW NORTHWEST SW SOUTHWEST

NEAR WHAT ROAD Reservoir Rd.
 8 11 NORTH SOUTH EAST WEST 50

ON WHICH SIDE OF ROAD (CIRCLE APPROPRIATE BOX) N S E W 32 32 32

DISTANCE FROM ROAD (ENTER DISTANCE AND CIRCLE APPROPRIATE BOX) 300 34 M I 30 32

DRAW A SKETCH BELOW SHOWING LOCATION OF WELL IN RELATION TO NEARBY TOWNS, ROADS AND STREAMS WITH NORTH IN THE DIRECTION OF THE ARROW, AND GIVE DISTANCE FROM WELL TO NEAREST ROAD JUNCTION OR STREAM CROSSING SHOWN ON SKETCH. (SEE REVERSE SIDE OF APPLICATION FOR DETAILS)

Note.


Bill Zepp reports some difficulties in construction (holes in distribution pipe up).

I approve this system with defects due to the following circumstances.

1. Owner accepts system.
2. Trench is level ~~so~~, and lower than cesspool so sewage should flow into Trench without running out on ground surface.

WJW 4/25/77

WWZ 4/25/77

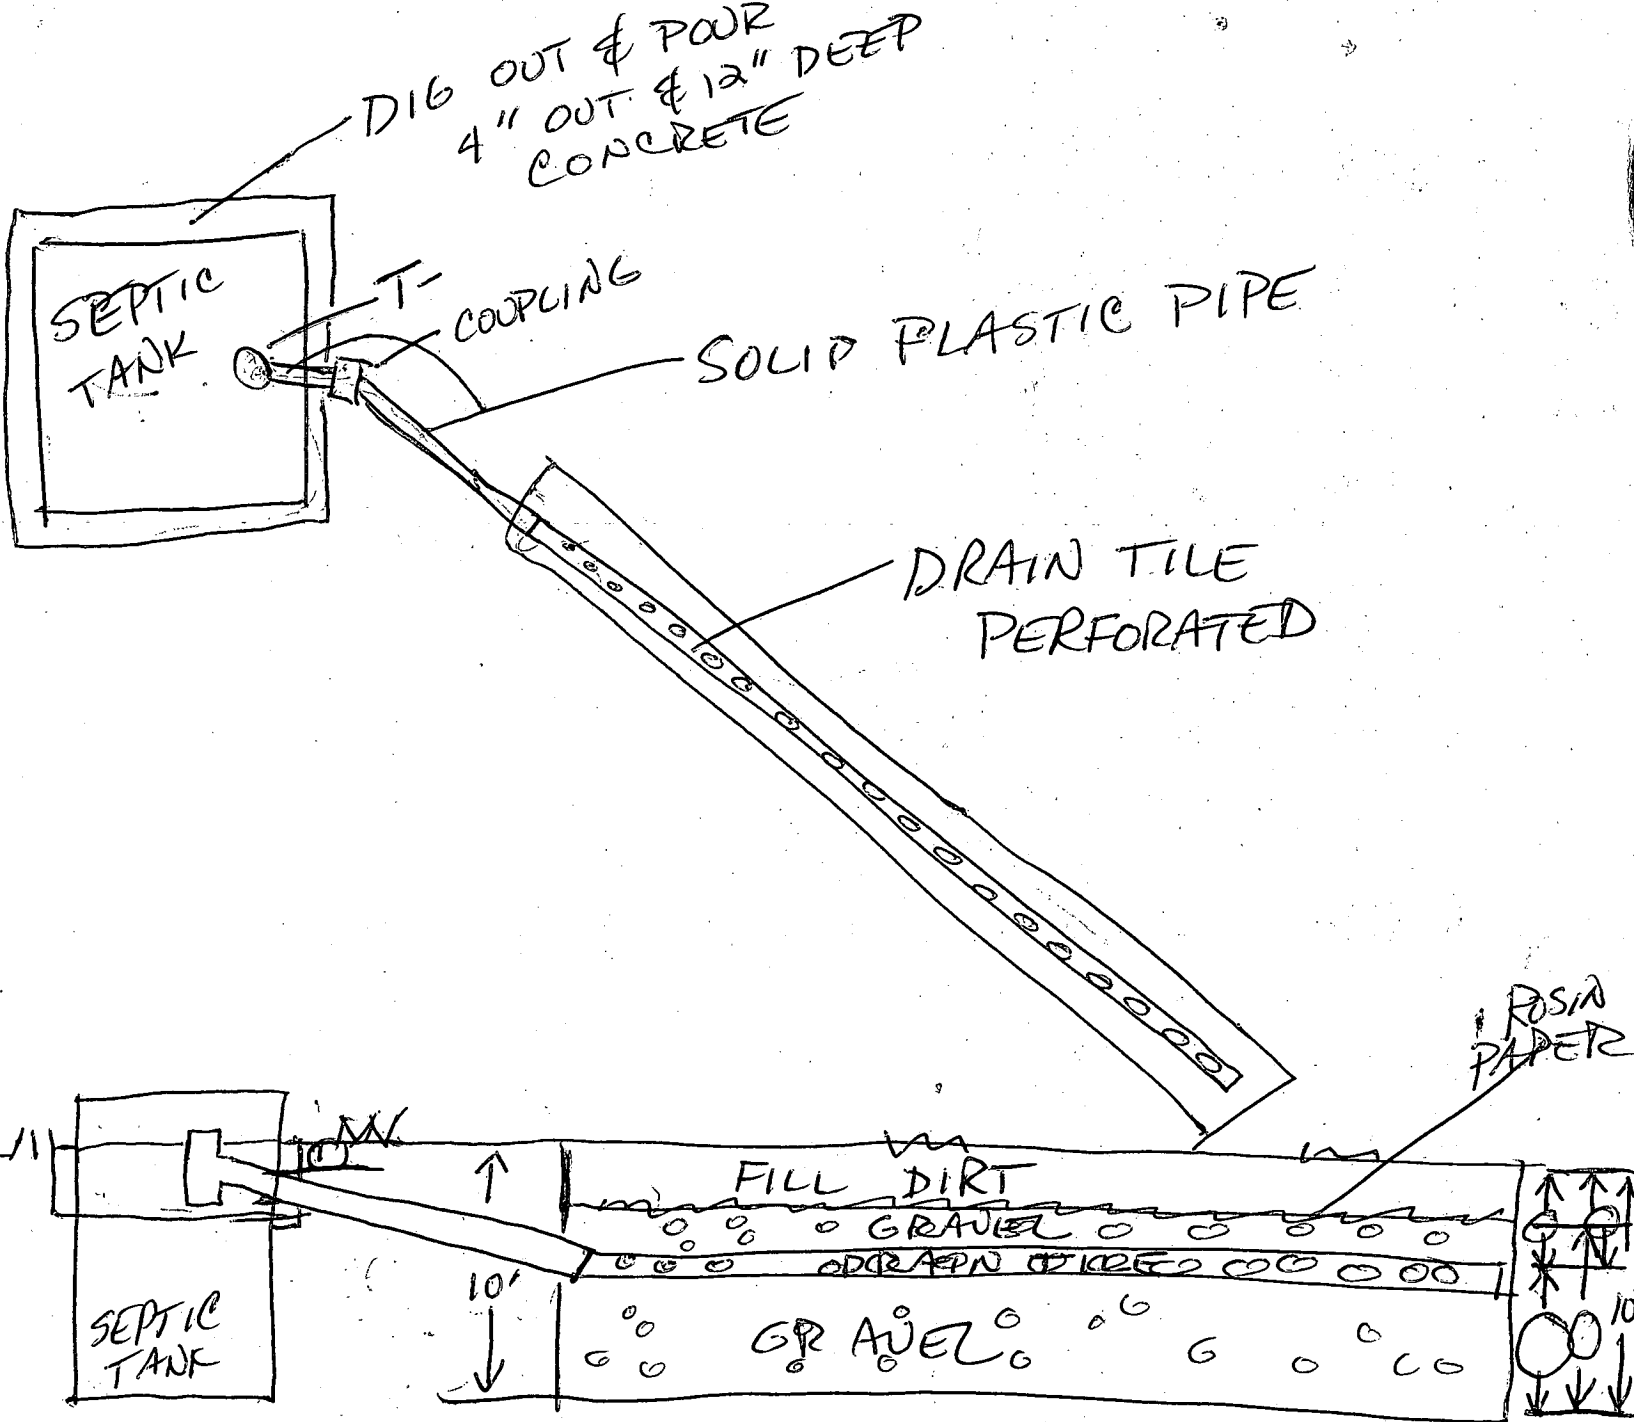

DISTANCE OUT OF TANK OF PLASTIC PIPE FROM N.G.
 DISTANCE TO TOP OF DRAIN TILE FROM NAT.
 DISTANCE TO TOP OF STONE FROM N.G. GROUND

~~PAC GLOBE~~

John DAVIS
JOB SUPERINTENDANT
PINWOOD HOMES
GREAT FALLS, VA.
703-759-9091

26" TO 30" TO TOP OF DRAIN TILE FROM
NATURAL GROUND
18" TO 24" TO TOP OF GRAVEL FROM
NATURAL GROUND

