

03 - 280950

APPROVED
10/30/86
RHP 37942

PERMIT

SEWAGE DISPOSAL SYSTEM

A REPAIR

MARYLAND STATE DEPARTMENT OF HEALTH

10/30/86
ASAP
AM

HOWARD COUNTY
BUREAU OF ENVIRONMENTAL HEALTH
XXXXXXXXXX
992-2330
461-9933

ELLICOTT CITY
DISTRICT _____

DATE 10/30/86

INDEXED

Norman Collins IS PERMITTED TO INSTALL _____ ALTER X

ADDRESS _____ PHONE _____

SUBDIVISION _____ ROAD 571 Deer Hill Valley Rd LOT _____

PROPERTY OWNER Charles Bronk

ADDRESS 571 Deer Hill Valley Rd
Sykesville, Maryland 21784

IF GARBAGE GRINDER IS USED INCREASE SEPTIC TANK CAPACITY BY 50% AND ABSORPTION AREA BY 22%.

GARBAGE GRINDER? YES _____ NO X

SEPTIC TANK CAPACITY _____ GALLONS NUMBER OF BEDROOMS 3

Require 400 \$ for 3BR
3'-9" 6" STONE

420

REPAIR - CALL FOR INSPECTION WHEN GROUND IS OPENEN UP SO SANITARIAN CAN RECOMMEND REPAIR.

TRENCH 70' LONG IF POSSIBLE. 10/30/86 TRENCH DUG 9" DIA OK
9-10 FT DEEP 6 FT STONE 70 FT LONG
OFF OLD DRY WELL NEAR GARAGE
TEE PIPE TO BE PUT IN OLD DRY WELL

PLANS APPROVED BY C. Williams DATE 10/28/86

COVER NO WORK UNTIL INSPECTED AND APPROVED.

NEITHER THE HOWARD COUNTY COUNCIL NOR THE HEALTH DEPARTMENT IS RESPONSIBLE FOR THE SUCCESSFUL OPERATION OF ANY SYSTEM.

NOTE: IF TRENCH IS USED CALL FOR INSPECTION BEFORE AND AFTER PLACING GRAVEL IN TRENCH.

NOTE: NO DRY WELL SHALL EXCEED 15 FOOT IN DIAMETER. NO ABSORPTION TRENCH TO EXCEED 100 FEET IN LENGTH.

NOTE: ALL PIPE FROM HOUSE TO SEPTIC TANK MUST BE CAST IRON OR SCHEDULE 40 PVC OR ABS.

PERMIT VOID AFTER THREE YEARS.


NOTE: INSTALL STAND PIPE ON SEPTIC TANK AND DRY WELL. STAND PIPES MUST BE 6 INCHES IN DIAMETER. CAST IRON, CONCRETE OR TERRA COTTA, OR PVC OR ABS ACCEPTED. IF TOP OF SEPTIC TANK IS DEEPER THAN 3 FEET MANHOLE TO GRADE REQUIRED.

***INSTALLER IS RESPONSIBLE FOR OBTAINING FINAL APROVAL ON THIS PERMIT**

*CALL 992-2330 FOR INSPECTION OF SEPTIC SYSTEMS.

EH - 2-1082

37942
A REPAIR

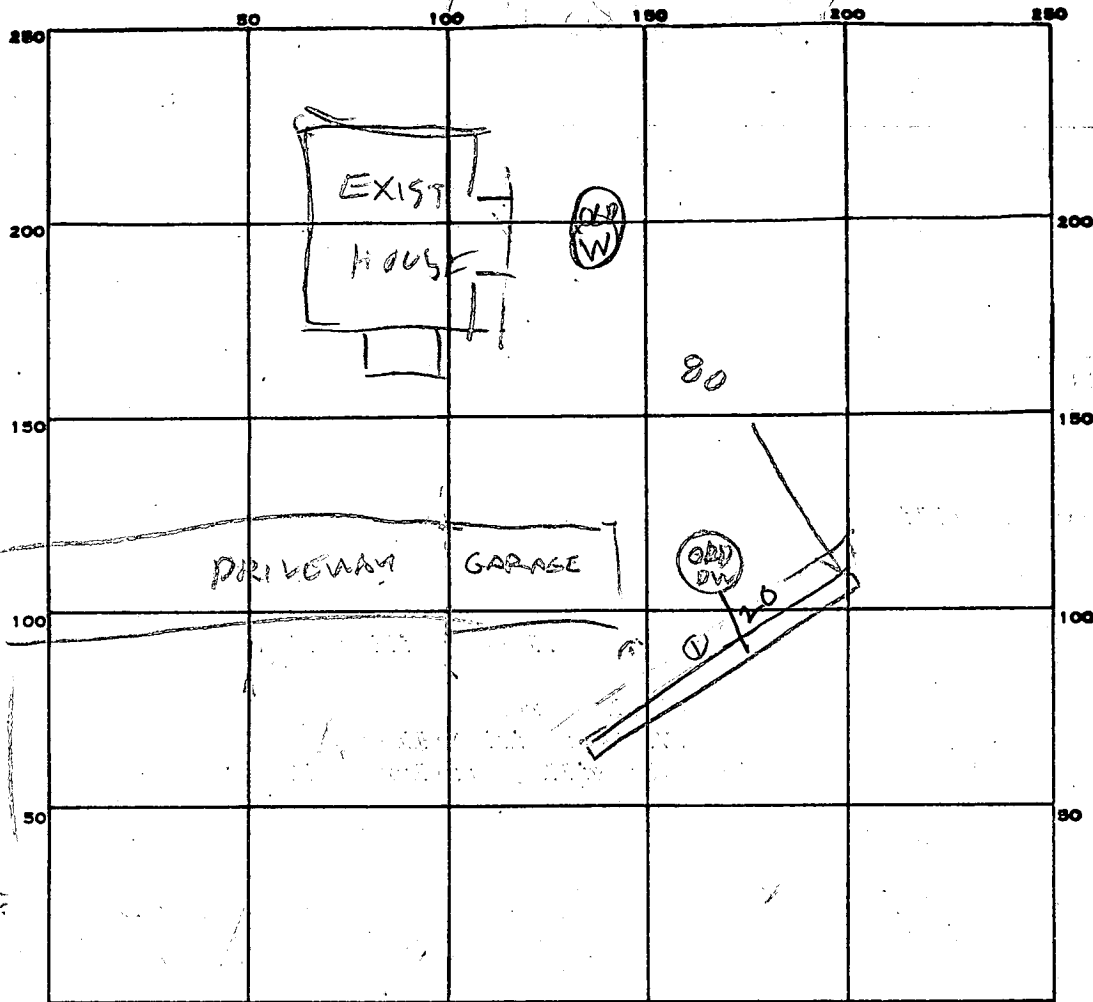

INDICATE NORTH. - NAME ADJOINING ROADWAY AS BASE LINE.

PERMIT CARD _____

SEPTIC TANK, LEVEL _____

CLEANOUTS Cleanout on old Dry Well

DISTRIBUTION BOX, LEVEL _____

TILE FIELD, DEPTH 9-10 FT. TRENCH WIDTH 2 FT.

GRAVEL DEPTH _____ IN. TOTAL LENGTH 70-75 FT.

NUMBER OF TRENCHES 1 TOTAL BOTTOM AREA _____

SEEPAGE PITS, INSIDE DIAMETER _____ FT. DEPTH BELOW INLET _____ FT.

ABSORBENT AREA _____ SQ. FT.

REMARKS 10/20/86 AM SOIL OK TRENCH DUG 1130 ADD STONE ALL OF
TRENCH 1ST 20 FT OF TRENCH STONE ADDED 7 FT OF STONE RH
10/30/86 PM COLLINGZ CALLED CRAIG & CRAIG SAID
OK TO COVER EVERYTHING COVERED
CLEANOUT ON OLD DW R/H

DATE SYSTEM APPROVED 10/30/86

INSPECTOR B J Dodge