

SEPTIC TANK LEVEL OK 1500 GAL CLEANOUTS OK

DISTRIBUTION BOX LEVEL OK - BAFFLE IN

DRAIN FIELD/TILE FIELD DEPTH 6.5-7.5 FT. TRENCH WIDTH 2 FT. INLET DEPTH 22-24 FT.

EFFECTIVE GRAVEL DEPTH 4.5-5/5 FT. TOTAL LENGTH 103 FT.

NUMBER OF TRENCHES 2 ONE SIDEWALL/BOTTOM AREA 360/515 SQ. FT.

DRYWELL INSIDE DIAMETER _____ FT. EFFECTIVE DEPTH BELOW INLET _____ FT.

ABSORBENT AREA 875 SQ. FT.

REMARKS 1/22/90 NOT READY FOR INSP., NOTHING COMPLETE
UNAVOIDABLE SLOPE LAST 40' OF TRENCH (1), PIPE & BOTTOM
LEVEL 1/23/90 #1 OK TO STONE MR 1/23/90 #1 OK TO
COVER HOUSE TO END OF TRENCH (1); TRENCH (2) TO BE STARTED
IN 2-4 WKS MR 2/23/90 #1 OK TO STONE TRENCH (2) MR
2/23/90 #2 OK TO CONTINUE & COVER WHEN READY MR

DATE SYSTEM APPROVED 2/23/90 INSPECTOR M. Rifein

APPLICATION

PERCOLATION TESTING

A 36002

P _____

HOWARD COUNTY HEALTH DEPARTMENT
BUREAU OF ENVIRONMENTAL HEALTH
P.O. BOX 476 ELLICOTT CITY, MARYLAND 21043
TELEPHONE: 461-9933

DISTRICT 3rd

DATE 2-17-86

TO: THE COUNTY HEALTH OFFICER
ELLICOTT CITY, MARYLAND

I, HEREBY, APPLY FOR THE NECESSARY TEST IN ORDER TO CONSTRUCT (OR RECONSTRUCT) A SEWAGE DISPOSAL SYSTEM.

PROPERTY OWNER J. C. Matherley Williamsburg Builders - 997-8800

ADDRESS Sumner Hill Farm Rt 32 Great Friendship PHONE 489-4642

PROSPECTIVE BUYER Howard County Land Services, Inc

ADDRESS 10176 Baltimore Water Pipe PHONE 465-5855

PROPERTY LOCATION:

SUBDIVISION ~~Matherley Property~~ KING'S GRANT new 9
LOT NO. 3206 PLAT 6/86

ROAD AND DESCRIPTION Rt 32 old Irving Road Parliament Pl.

TAX MAP 22 PARCEL # 7

SIZE OF LOT 3.0 ac TYPE BLDG. Single Family
(SINGLE FAMILY DWELLING OR COMMERCIAL)

THE SYSTEM INSTALLED UNDER THIS APPLICATION IS ACCEPTABLE ONLY UNTIL PUBLIC FACILITIES BECOME AVAILABLE. I FULLY UNDERSTAND THE FEE CONNECTED WITH THE FILING OF THIS PERC TEST APPLICATION IS NON-REFUNDABLE UNDER ANY CIRCUMSTANCES. I ALSO AGREE TO COMPLY WITH ALL M.O.S.H.A. REQUIREMENTS IN TESTING THIS LOT.

J. C. Matherley, Jr.
(SIGNATURE OF APPLICANT)

APPROVED BY _____ FOR _____ DATE _____

REJECTED BY _____ FOR _____ DATE _____

HOLD PENDING FURTHER TESTS _____ DATE _____







REASONS FOR REJECTION OR HOLDING 7/22/85 Existing Well must be sealed

Lot Lot lines changed RD

BLDG. PERMIT SIGNED
AND RETURNED 7/18/89
Serial # 26671
SFD-4 Bedrooms

THIS IS NOT A PERMIT

SOIL PROFILE

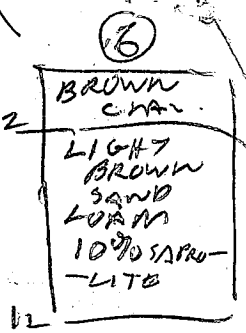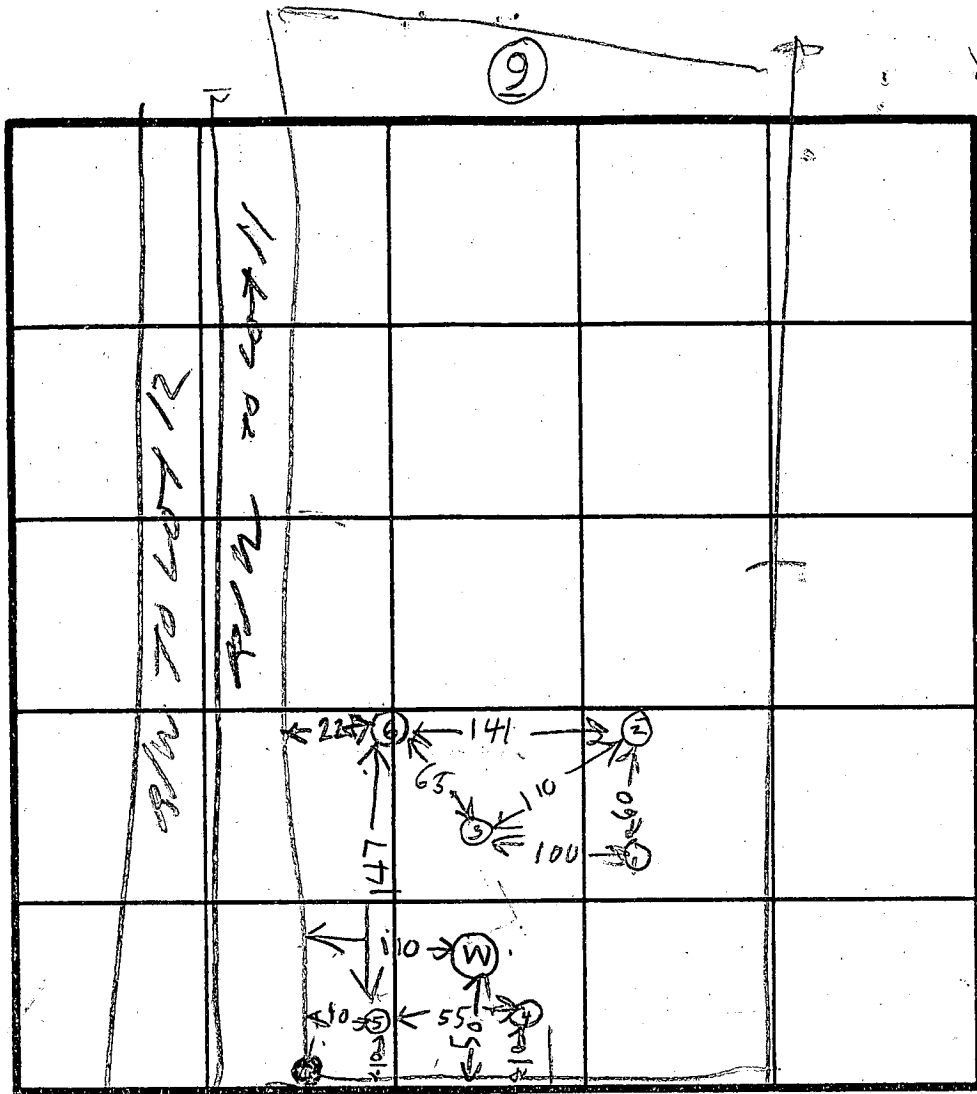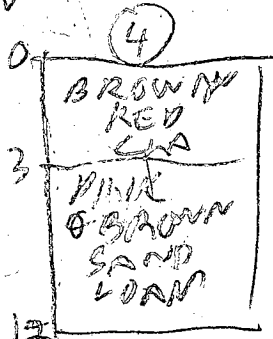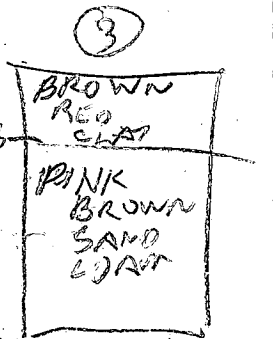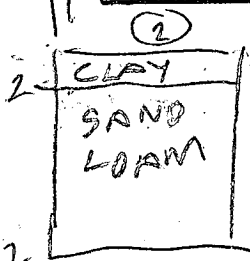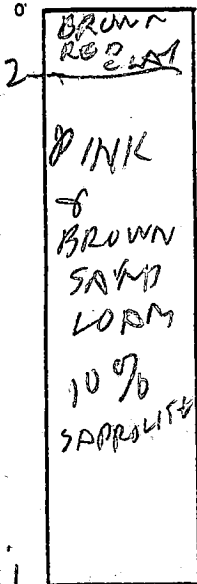


W = EXISTING WELL
 HU 810142

DATE	TEST NO.	DEPTH	PRE-WET		TEST - 1" DROP		TIME
			START	STOP	START	STOP	
7/23/96	1S	3	1211	1212	1212	1215	3
	1V	3	1211	1212	1212	1215	3
	1V	11	LOOKS OK				
	2S	2 1/2	1240	1245	1245	1249	4
	2V	12	LOOKS OK				
	3V	12	LOOKS OK				
	4S	3	1233	1235	1235	1238	3
	4V	12	LOOKS OK				
	5S	3 1/2	1236	1237	1237	1241	4
	5V	11	LOOKS OK				
	6S	3	1244	1245	1245	1248	3
	6V	12	LOOKS OK				


Don't figure Max Depth of water
 Tell well sealed 8/20/96
 & lot lines changed

REMARKS: NOT PER PLAT WELL TO BE SEALED & HOUSE PUT AT THAT SITE
 TYPE OF SOIL: R HODGE
 TESTED BY: R HODGE
 ALSO PRESENT: POP KETTERMAN, O. KETTERMAN


All topography is based upon Howard County aerial topography and must be field verified prior to construction

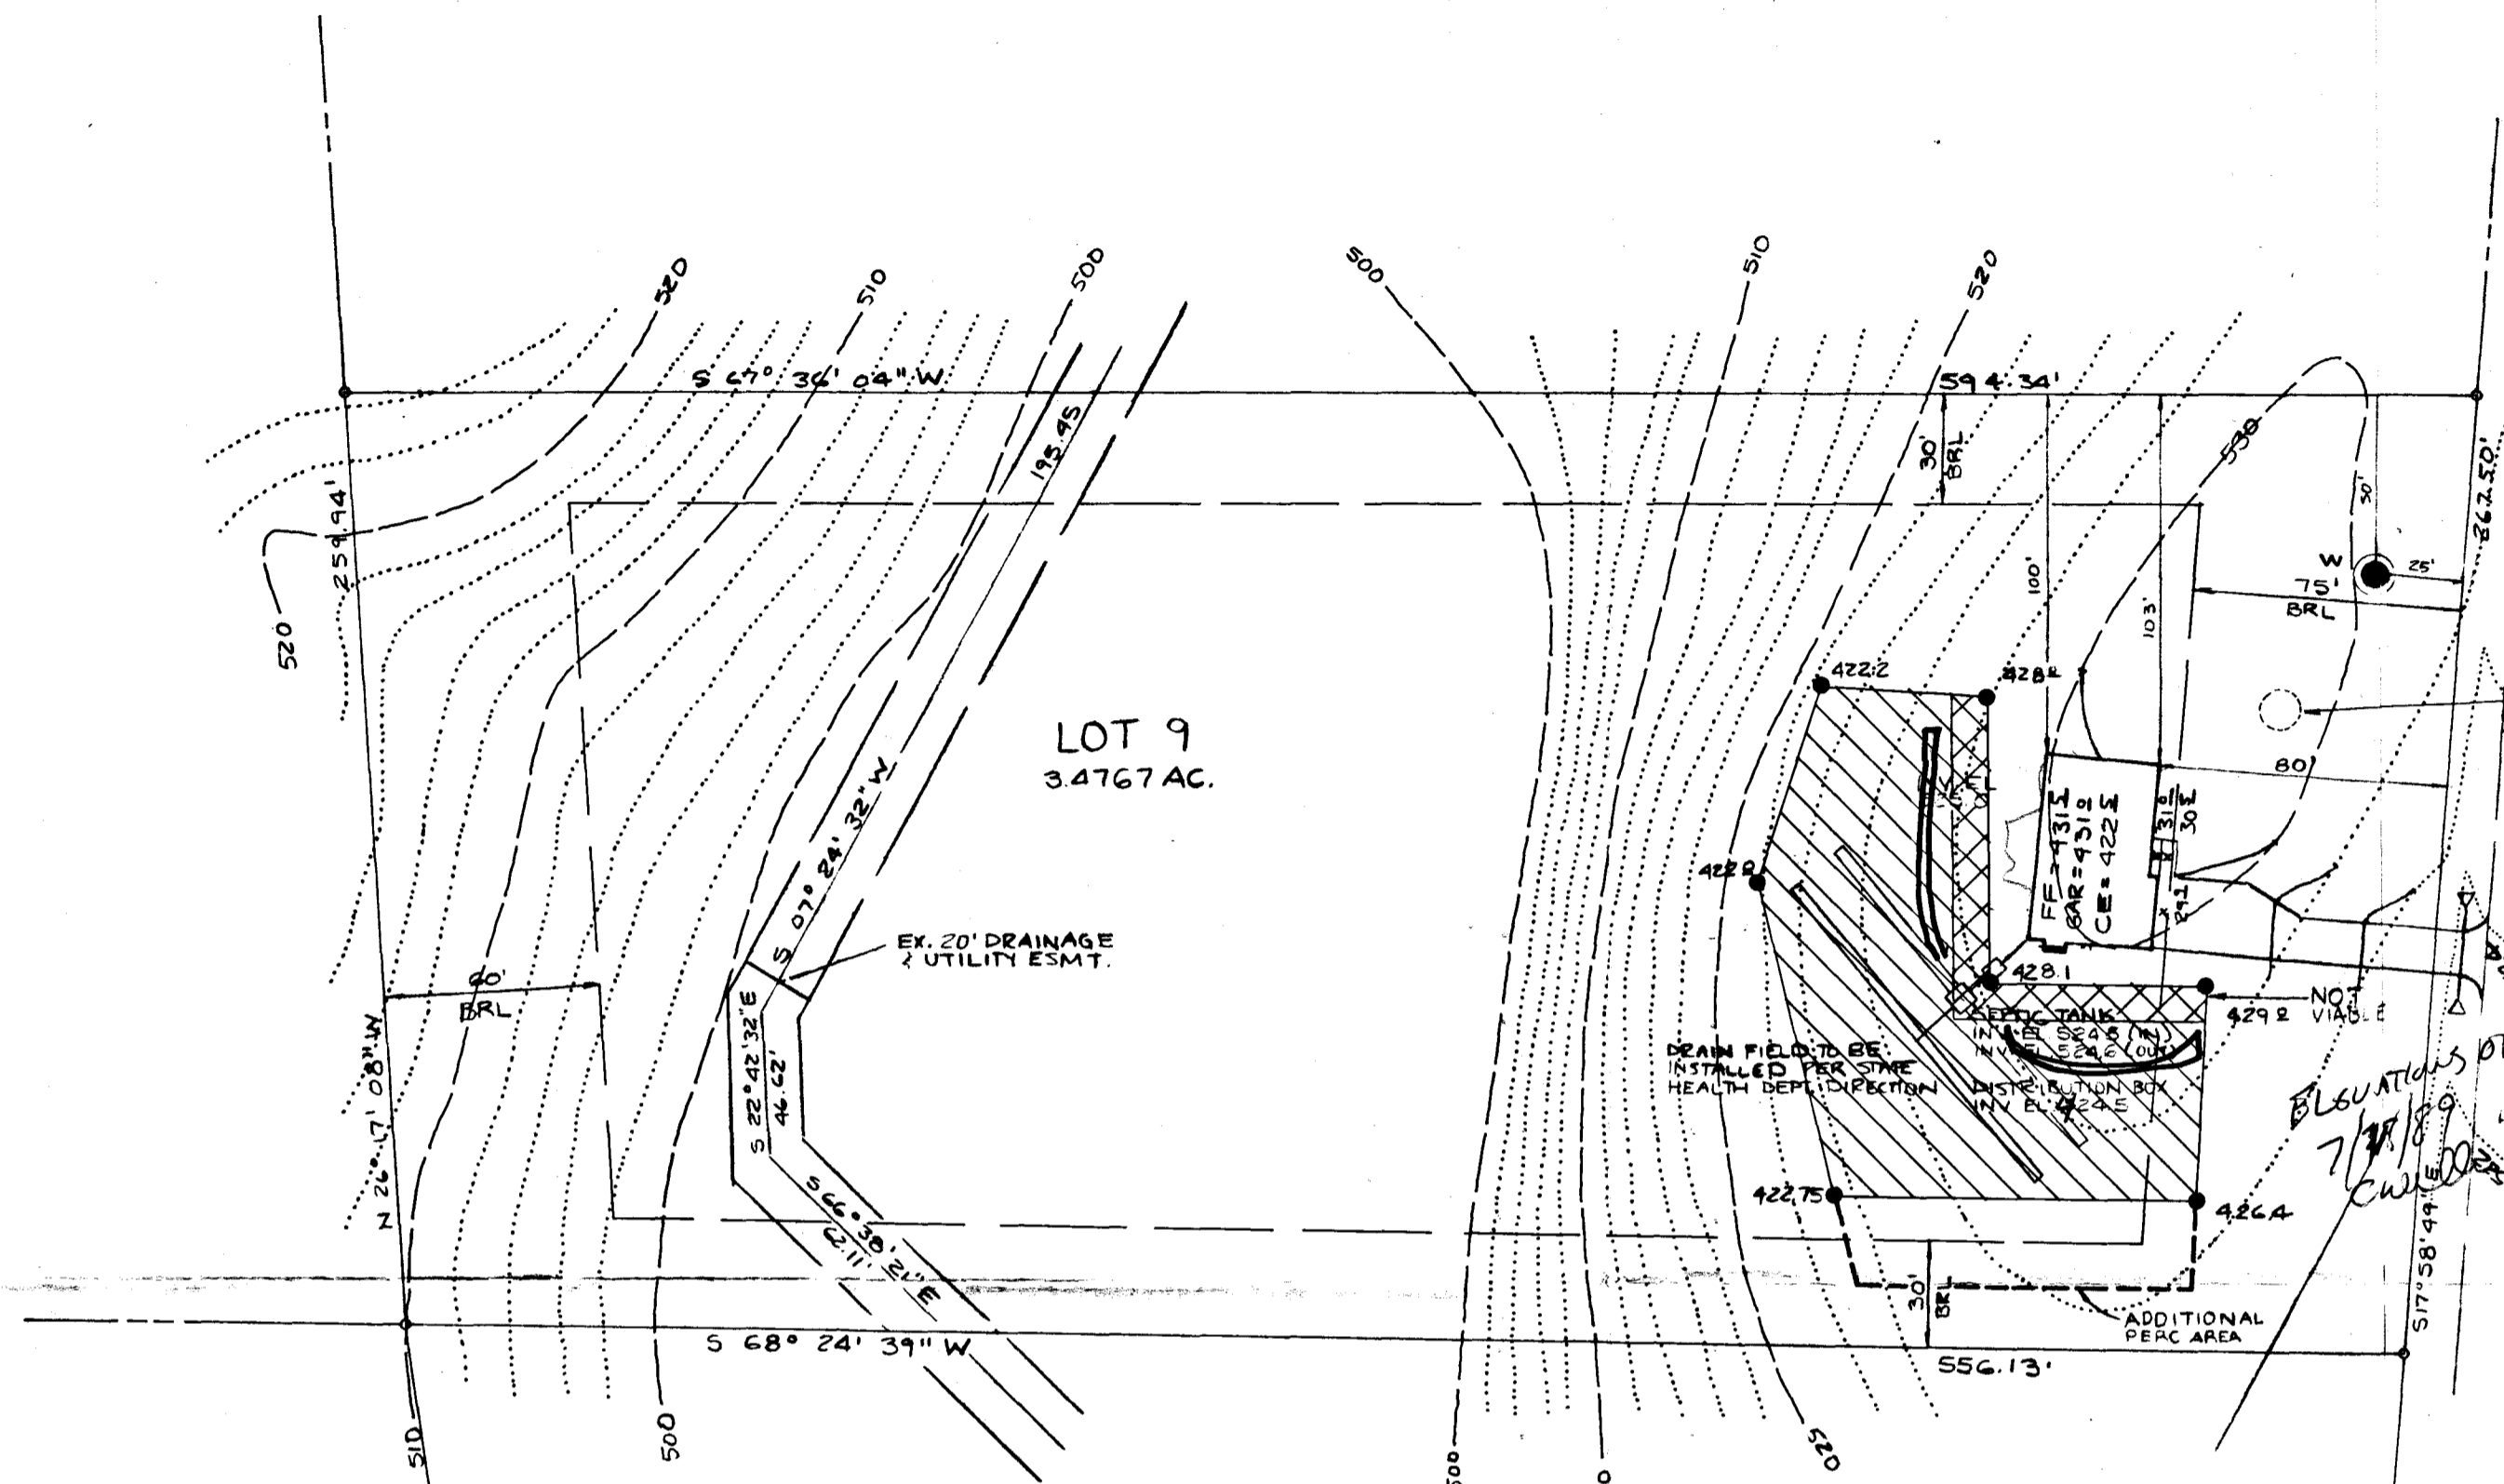

PARLIAMENT PLACE

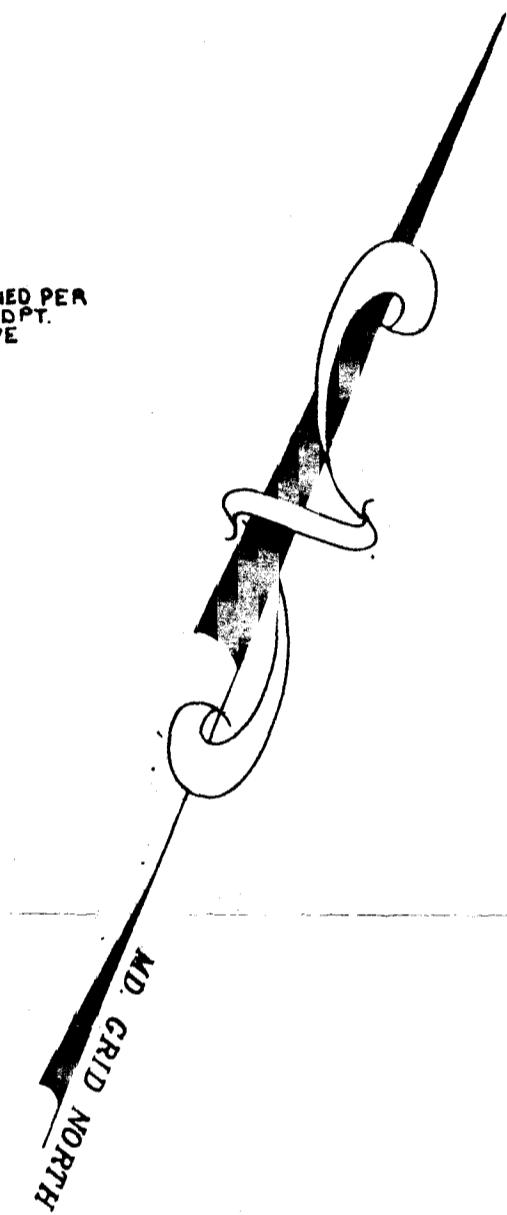

15" DIAMETER CULVERTS TO BE PLACED AT DRIVEWAY ENTRANCE PER STD. DETAIL R-6.06

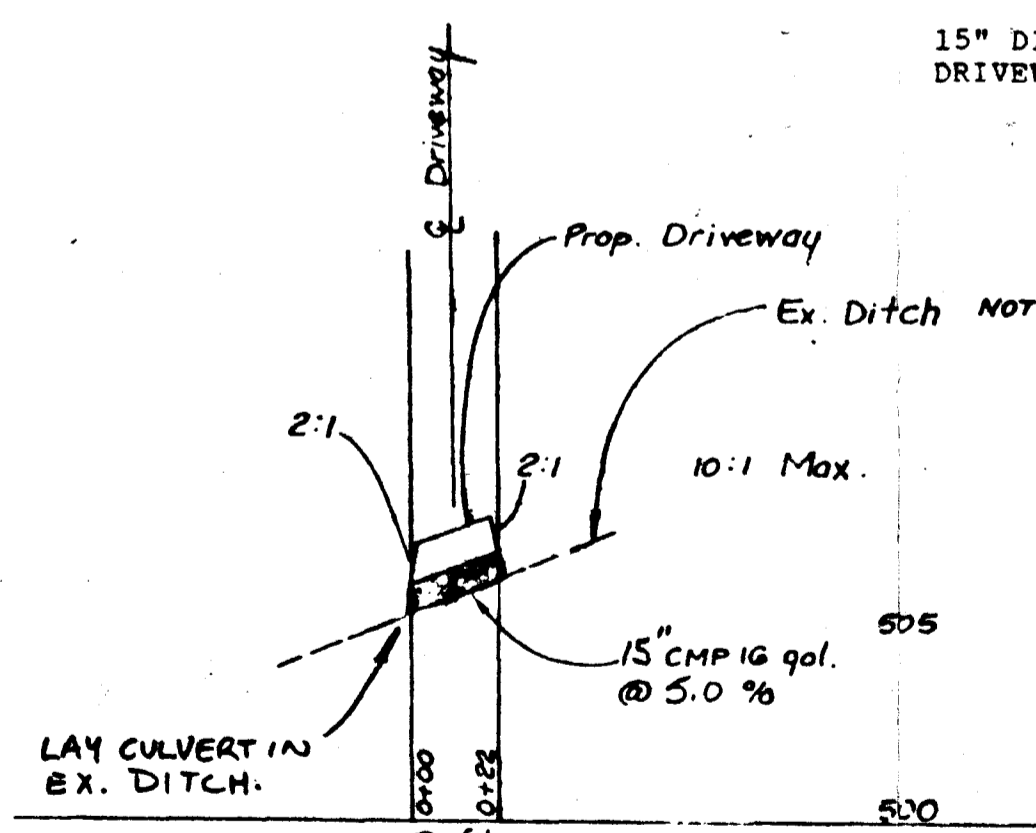

NOTE: Provide No. Co. Std. 50 5.01 Metal End Sections each end of culvert.


Q₁₀ = 2.85 CFS *
V = 3.96 fps
S₁₀₀ = 5.0 %
N = 0.24

* See F-87-196 Sheet 9 of 11

I CERTIFY THAT ALL MEASUREMENTS AND ELEVATIONS ARE CORRECT FOR THIS PROPERTY.



5-25-89
DATE

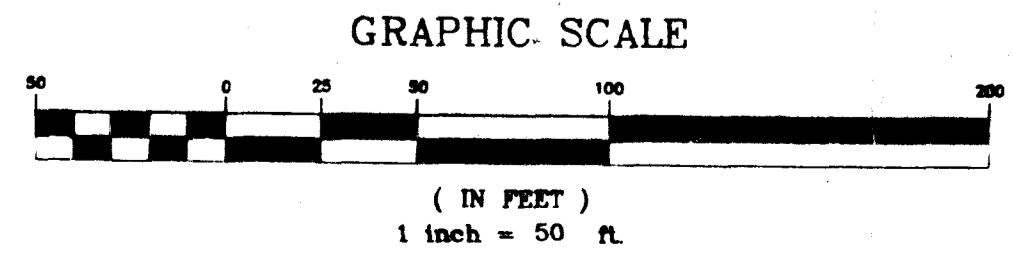

OWNER / DEVELOPER
WILLIAMSBURG BUILDERS
P.O. BOX 1018
COLUMBIA, MD. 21044
(301) 997 8800

PLOT PLAN
KINGS GRANT
SECTION ONE
LOT 9 / TYPE 'E'

ZONED : R F 89-107
TAX MAP : 22 PARCEL : 7
THIRD ELECTION DISTRICT
HOWARD COUNTY, MARYLAND.

PREPARED BY
AMERICAN ENGINEERING, INC.
609 B MAIN STREET LAUREL, MD. 20707
BALTO. (301) 880-3039
WASH. (301) 953-1221

DATE : MAY, 1989 SCALE : 1" = 50' DWG. BY : FTTJR CHK. BY : D.C.W SHT. 1 OF 1

... aerial to prior to

DECK IMPACTS INSTALLED TRENCH LOC. MR 3/26/90

ADDITIONAL DETAIL SUBMITTED SHOWS 4/2/90 7' EDGE OF DECK TO PARLIAMENT

GRATION CLEARANCE TO POSTINGS,

ACCEPTED 4/2/90 C. W. [Signature]

PARLIAMENT PLACE

3206 - Parliament Place
LOT 9
34767 AC.


EX. 30' DRAINAGE UTILITY ESMT.

DRAIN FIELD TO BE INSTALLED PER STATE HEALTH DEPT. DIRECTIVE

EX. WELL ABANDONED PER HEALTH DPT. DIRECTIVE

ADDITIONAL REL. AREA

MD. GRID NORTH

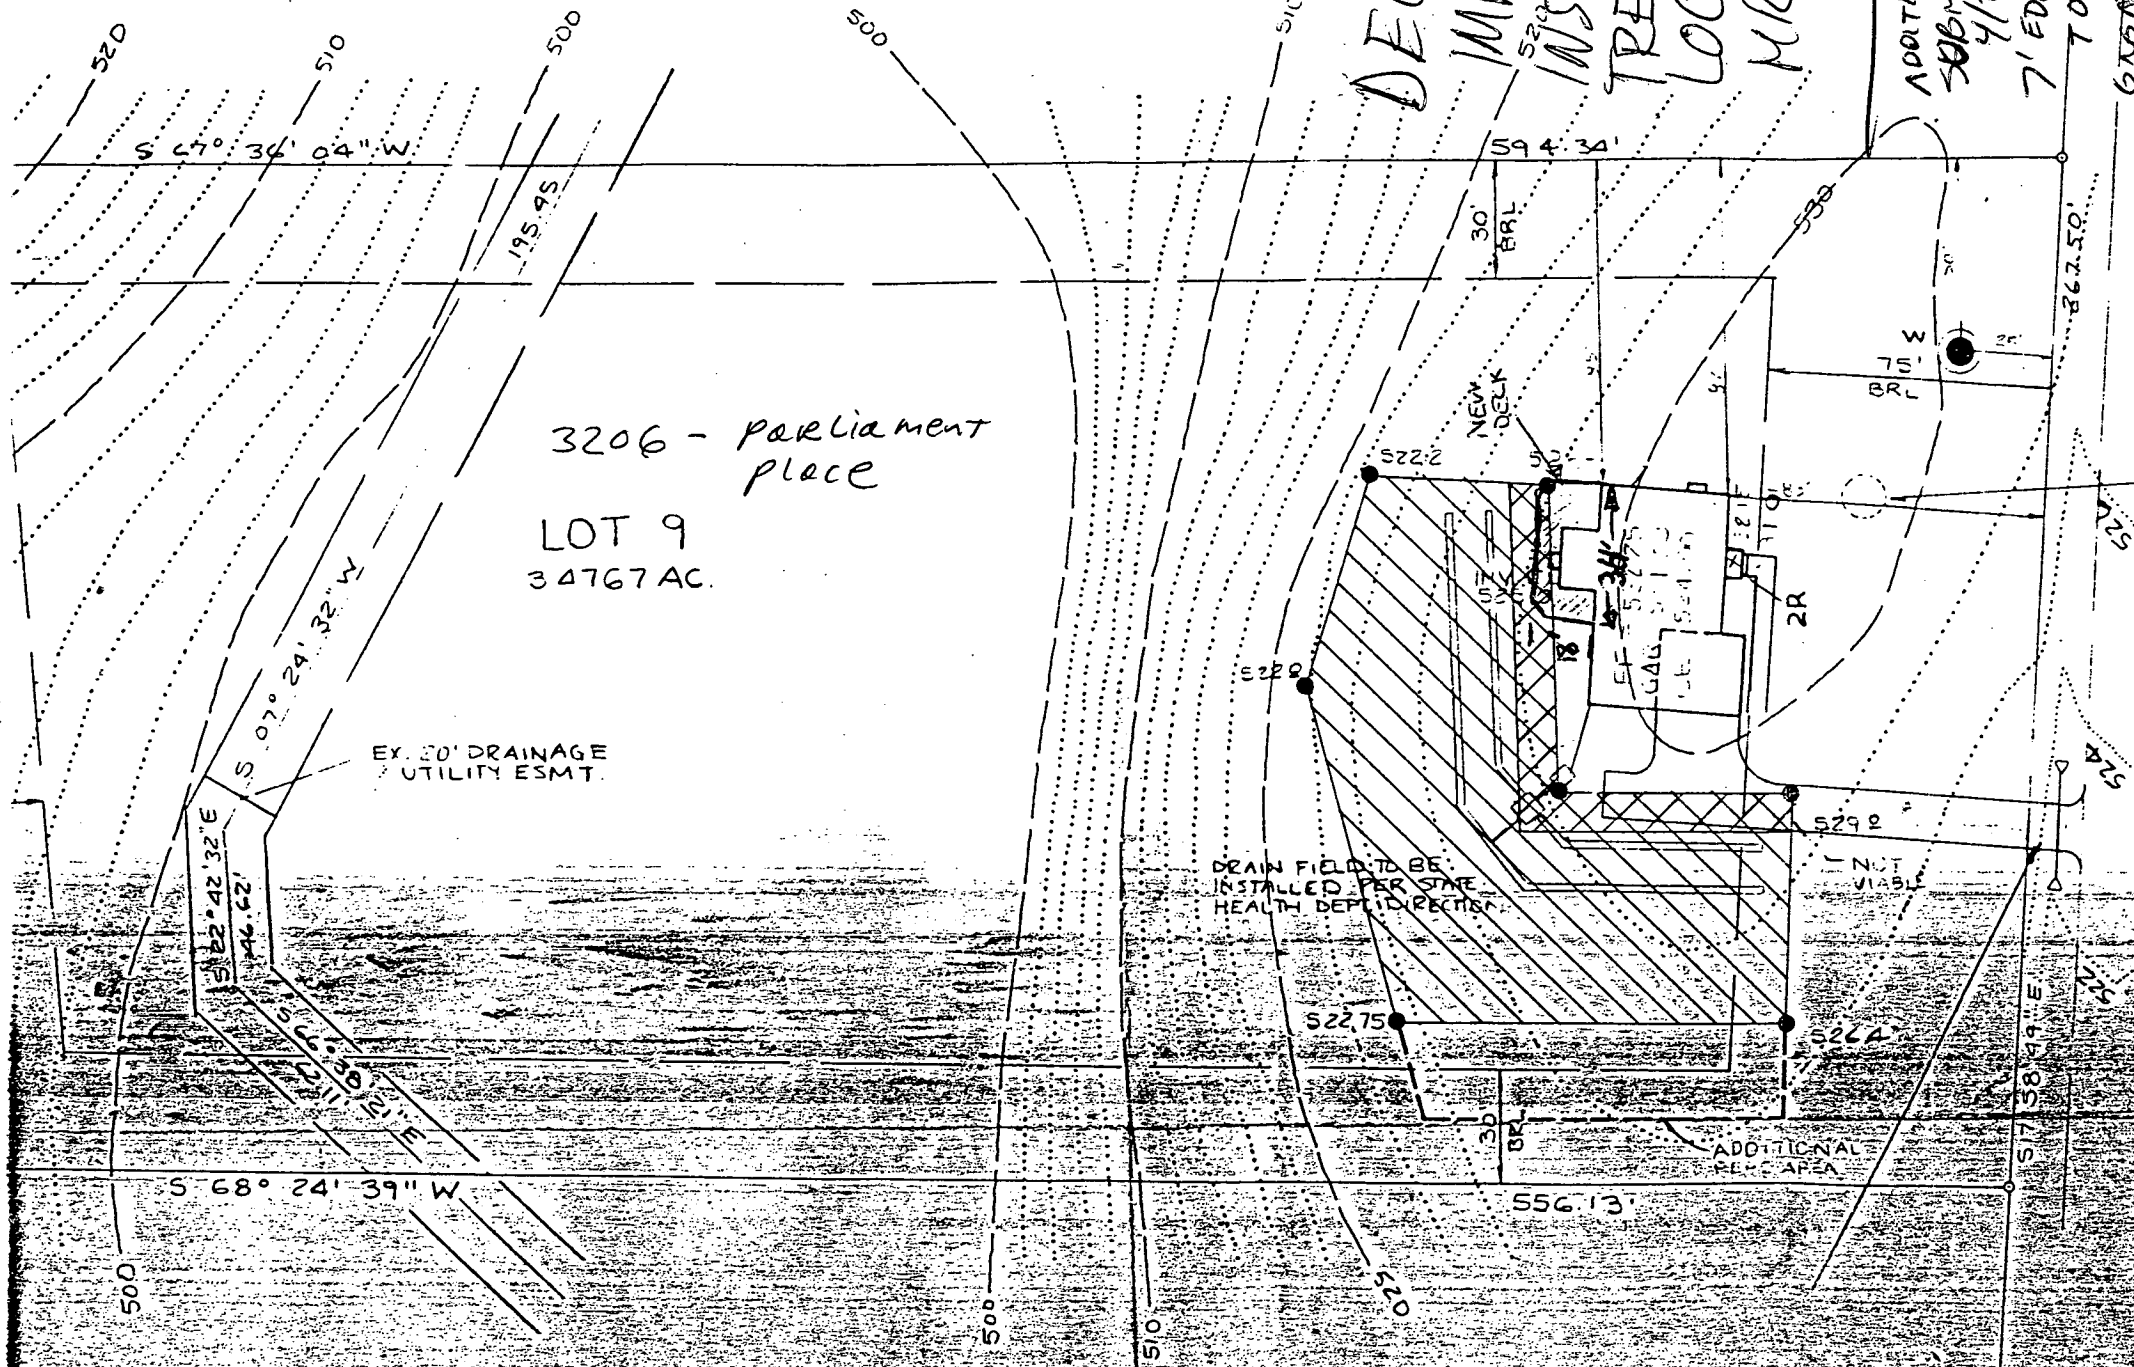

WELL ABANDONMENT REPORT

Date 9-20-88

Well Number of abandoned well (if any)

110-81-0142

Driller's Name

Howard Est Depp
Last First

TAG RETURNED
+ DESTROYED
9/23/88
Cwellin

Owner's Name


Easterday, Franklin J
Last First

Well Location:

County Howard
Subdivision _____
Section _____ Lot _____
Nearest Town Glenela
Address Rt 32 lot 9

Maryland Grid Location

Box Number
E 807
N 508

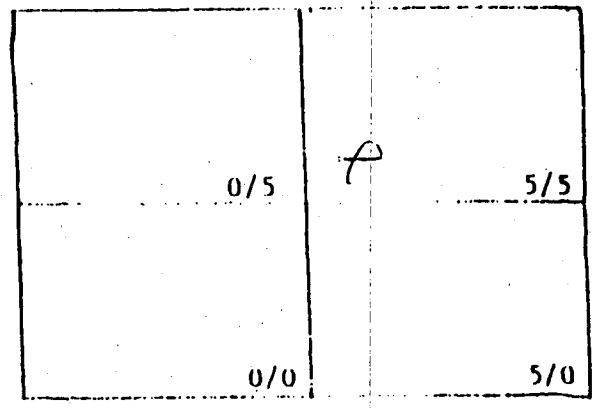

Show well location by (x) within box

Type of Well

- Drilled
- Jetted
- Bored or Augered
- Other, Specify _____

Depth of Well 260 Ft.

Type of Casing

- Steel
- Plastic
- Concrete
- Other, Specify _____

Size of Casing 6 In.

Was any case removed yes no
If yes amount removed 6 Ft.
Was casing ripped or perforated yes no

Log of Sealing Material

Materials	Feet	
	From	To
Grauel	260	35
Bentonite	35	30
Cerent	30	5
Top Soil	5	0

Driller [Signature]
Signature

License # 269

C1 9539

SEQUENCE NO. (DENV USE ONLY)

STATE OF MARYLAND WELL COMPLETION REPORT

THIS REPORT MUST BE SUBMITTED WITHIN 45 DAYS AFTER WELL IS COMPLETED.

(THIS NUMBER IS TO BE PUNCHED IN COLS. 3-6 ON ALL CARDS)

COUNTY NUMBER A 36002

DATE Received

DATE WELL COMPLETED

Depth of Well

PERMIT NO. FROM "PERMIT TO DRILL WELL"

DATE Received grid

DATE WELL COMPLETED grid

Depth of Well grid

PERMIT NO. grid

OWNER: SCRIFFLES TOM; STREET OR RFD: Parliament Pl.; TOWN: CLEVERLE; SUBDIVISION: KING'S GRANT SECTION; LOT: 9

WELL LOG Not required for driven wells STATE THE KIND OF FORMATIONS PENETRATED, THEIR COLOR, DEPTH, THICKNESS AND IF WATER BEARING

Table with columns: DESCRIPTION (Use additional sheets if needed), FEET (FROM, TO), Check if water bearing. Rows include Top Soil, Red clay, Red slate, Tan slate, Blue slate.

GROUTING RECORD WELL HAS BEEN GROUTED (Y/N); TYPE OF GROUTING MATERIAL: CEMENT (CM), BENTONITE CLAY (BC); NO. OF BAGS: 15; NO. OF POUNDS: 1500; GALLONS OF WATER: 75; DEPTH OF GROUT SEAL: from 0 to 58 ft.

CASING RECORD casing types insert appropriate code below; MAIN CASING TYPE: ST (STEEL); Nominal diameter: 6 inches; Total depth of main casing: 65 feet.

OTHER CASING (if used) diameter inch, depth (feet) from to

SCREEN RECORD screen type or open hole insert appropriate code below; SCREEN TYPE: ST (STEEL); BR (BRASS); HO (OPEN HOLE); PL (PLASTIC); OT (OTHER).


DEPTH (nearest ft.) grid; SLOT SIZE 1, 2, 3; DIAMETER OF SCREEN (NEAREST INCH) grid

GRAVEL PACK IF WELL DRILLED WAS FLOWING WELL INSERT F IN BOX 68

OEP USE ONLY (NOT TO BE FILLED IN BY DRILLER) TELESCOPE CASING, LOG INDICATOR, OTHER DATA

PUMPING TEST HOURS PUMPED (nearest hour) 3; PUMPING RATE (gal. per min. to nearest gal.) 12; METHOD USED TO MEASURE PUMPING RATE: Bucket; WATER LEVEL (distance from land surface) BEFORE PUMPING: 37; WHEN PUMPING: 49; TYPE OF PUMP USED (for test): S (submersible)

PUMP INSTALLED DRILLER WILL INSTALL PUMP YES NO; IF DRILLER INSTALLS PUMP, THIS SECTION MUST BE COMPLETED FOR ALL WELLS EXCEPT HOME USE; TYPE OF PUMP INSTALLED: S; CAPACITY: GALLONS PER MINUTE (to nearest gallon); PUMP HORSE POWER; PUMP COLUMN LENGTH (nearest ft.); CASING HEIGHT (circle appropriate box and enter casing height): + above, - below; LAND SURFACE (nearest foot): 2

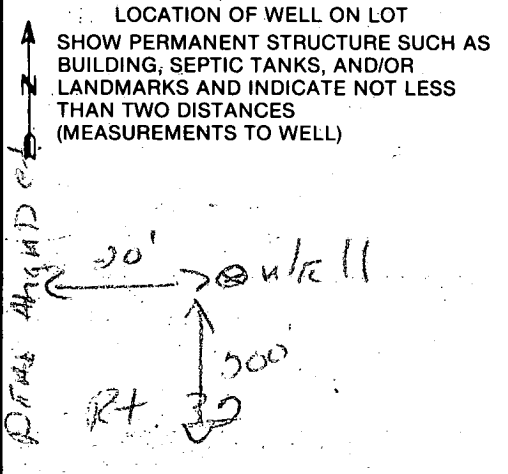

A A WELL WAS ABANDONED AND SEALED WHEN THIS WELL WAS COMPLETED; E ELECTRIC LOG OBTAINED; P TEST WELL CONVERTED TO PRODUCTION WELL

I HEREBY CERTIFY THAT THIS WELL HAS BEEN CONSTRUCTED IN ACCORDANCE WITH COMAR 10.17.13 "WELL CONSTRUCTION" AND IN CONFORMANCE WITH ALL CONDITIONS STATED IN THE ABOVE CAPTIONED PERMIT, AND THAT THE INFORMATION PRESENTED HEREIN IS ACCURATE AND COMPLETE TO THE BEST OF MY KNOWLEDGE.

DRILLERS IDENT. NO. 40; DRILLERS SIGNATURE: George T. Eastman; SITE SUPERVISOR (sign. of driller or journeyman responsible for sitework if different from permittee): Clarence J. Shomo

B 1 6981

SEQUENCE NO. (DP USE ONLY)

STATE OF MARYLAND PERMIT TO DRILL WELL

STATE PERMIT NUMBER

HO-81-2754

(THIS NUMBER IS TO BE PUNCHED IN COLS. 3-6 ON ALL CARDS)

please print or type

fill in this form completely

Date Received (APA)

091689

OWNER INFORMATION

SCRIVENER TOM

POB 567

ELLIOTT CITY MD 21043

B 3

LOCATION OF WELL R-41266

HOWARD COUNTY

CLENELE KING'S GRANT

SECTION 1 LOT 9

CLENELE

MILES FROM TOWN (enter 0 if in town) 2 MI

DRILLER INFORMATION

George F. Easterday 40

Driller's Name 77 License No. 80

L. Franklin Easterday, Inc.

9265 Brown Church Rd., Mt. Airy, Md. 21771


Address

George F. Easterday 3-15-88

Signature Date

B 4


DIRECTION OF WELL FROM TOWN (CIRCLE BOX)

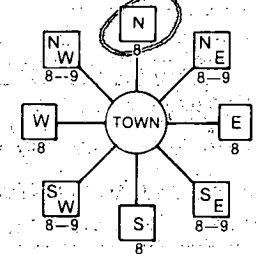

NEAR WHAT ROAD

Parliament Pl.

ON WHICH SIDE OF ROAD (CIRCLE APPROPRIATE BOX)

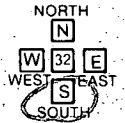

30 37

DISTANCE FROM ROAD ENTER FT or MI

B 2

WELL INFORMATION

APPROX. PUMPING-RATE (GAL. PER MIN.) 5

AVERAGE DAILY QUANTITY NEEDED (GAL. PER DAY) 500

USE FOR WATER (CIRCLE APPROPRIATE BOX)

- Home (single or double household unit only)
Farming (livestock watering & agricultural irrigation)
Industrial, commercial, state and federal gov. other (requires appropriation permit)
Public or private water company (requires appropriation permit and state health department approval)
Test, observation, monitoring (may require appropriation permit)

APPROXIMATE DEPTH OF WELL 200 FEET

APPROXIMATE DIAMETER OF WELL 6 INCH

METHOD OF DRILLING (circle one)

- Bored (or Augered) Jetted Jetted & Driven
Air-Rotary Air-PerCussion Rotary (Hydraulic Rotary)
Cable Reverse-Rotary Drive-Point

REPLACEMENT OR DEEPEMED WELLS (CIRCLE APPROPRIATE BOX)

- This well will not replace an existing well
This well will replace a well that will be abandoned and sealed
This well will replace a well that will be used as a standby
This well will deepen an existing well

PERMIT NUMBER OF WELL TO BE REPLACED OR DEEPEMED (IF AVAILABLE)

Not to be filled in by driller (OEP USE ONLY)

APPROP. PERMIT NUMBER GAP

FORCE 66 INITIALS IN BOX PERMIT No. HO-81-2754

SPECIAL CONDITIONS

NOT TO BE FILLED IN BY DRILLER HEALTH DEPARTMENT APPROVAL


Howard A36002
COUNTY NAME COUNTY NO.
STATE SIGNATURE INSERT S
DATE ISSUED 051888
CO SIGNATURE EXP. DATE
NORTH GRID 523000 EAST GRID 0803000

SHOW MAJOR FEATURES OF BOX & LOCATE WELL WITH AN X

SOURCES OF DRILLING WATER

- 1. WELL
2.
3.

WRITE THE BOX NUMBER FROM THE MAP HERE

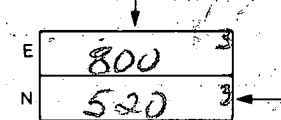

DRAW A SKETCH BELOW SHOWING LOCATION OF WELL IN RELATION TO NEARBY TOWNS AND ROADS AND GIVE DISTANCE FROM WELL TO NEAREST ROAD JUNCTION

