


A# 01719

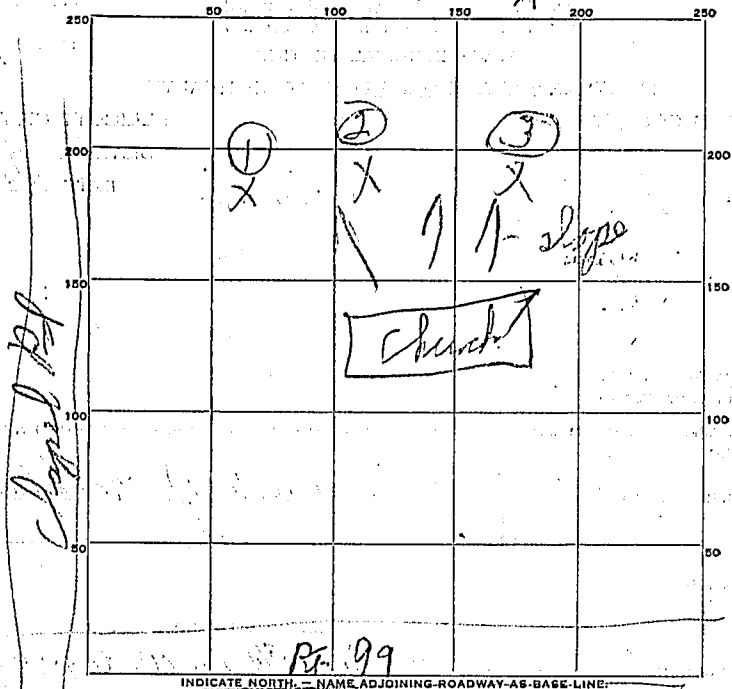

INDICATE NORTH. - NAME ADJOINING ROADWAY AS BASE LINE.

DATE	TEST NO.	DEPTH	PRE-WET		TEST - 1" DROP		TIME
			START	STOP	START	STOP	
9/23/59	1	3	11:30	11:40	11:40	11:55	15
↓	2	3	11:31	11:39	11:39	11:54	15
↓	3	3	11:32	11:41	11:41	12:01	20

SOIL AUGER FINDING Sand

TESTED BY Palmer F. Wine

REMARKS _____

✓ ALSO PRESENT Rev. J. R. Brunner LOT NO. 6 acres