

# APPLICATION

SEWAGE DISPOSAL TESTING

MARYLAND STATE DEPARTMENT OF HEALTH

HOWARD COUNTY

ELLICOTT CITY

DISTRICT \_\_\_\_\_

DATE 9-18-61

A 04266

P 444

*750 Tank  
500 sq. ft. tile field  
in area tested -  
or 20 X 30 brooding bed.*

TO: THE COUNTY HEALTH OFFICER  
ELLICOTT CITY, MARYLAND

I, HEREBY, APPLY FOR THE NECESSARY TESTS IN ORDER TO CONSTRUCT (OR RECONSTRUCT) A SEWAGE DISPOSAL SYSTEM.

PROPERTY OWNER Evangelical Paul  
Trinity Episcopal Brother Hood Parish

ADDRESS Rt. 99 and Chaple Ave. PHONE \_\_\_\_\_

PROPERTY LOCATION:

SUBDIVISION \_\_\_\_\_ LOT NO. \_\_\_\_\_

ROAD AND DESCRIPTION On the corner of Rt. 99 and the corner Chaple Ave.

OCCUPANT \_\_\_\_\_ PHONE \_\_\_\_\_

PERSON TO CONSTRUCT SYSTEM \_\_\_\_\_

ADDRESS \_\_\_\_\_ PHONE \_\_\_\_\_

SIZE OF LOT 4 acres TYPE BLDG. Home 3 NUMBER OF BEDROOMS \_\_\_\_\_

IF NOT SINGLE RESIDENCE DESCRIBE \_\_\_\_\_

SIGNATURE OF APPLICANT (i.e. of woman)


APPROVED BY JW FOR tile field DATE 9/19/61  
(KIND OF SYSTEM)

REJECTED BY \_\_\_\_\_ FOR \_\_\_\_\_ DATE \_\_\_\_\_  
(KIND OF SYSTEM)

HOLD PENDING FURTHER TESTS \_\_\_\_\_ DATE \_\_\_\_\_

REASONS FOR REJECTION OR HOLDING \_\_\_\_\_

## THIS IS NOT A PERMIT

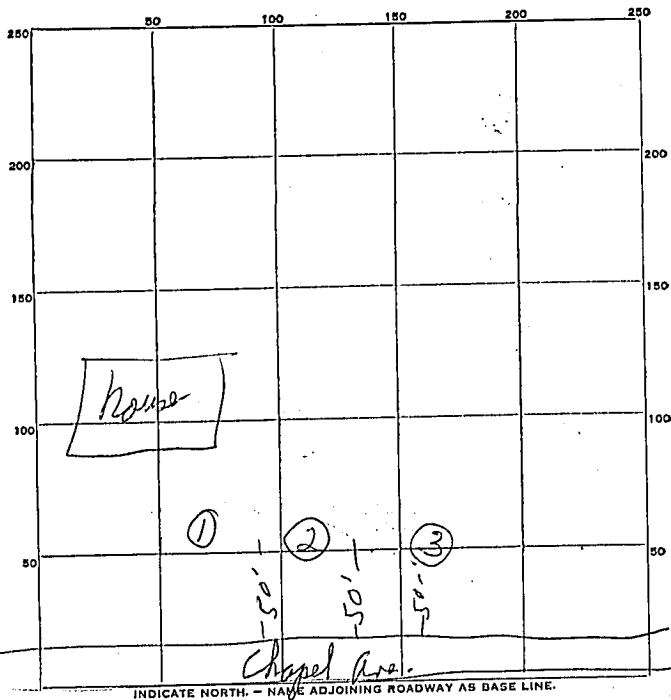

INDICATE NORTH. - NAME ADJOINING ROADWAY AS BASE LINE.

DATE	TEST NO.	DEPTH	PRE-WET		TEST - 1" DROP		TIME
			START	STOP	START	STOP	
9/19/61	1#	3'	2:10	2:11	2:11	2:12	1
	2#	3'	2:12	2:18	2:18	2:38	20
	3#	3'	2:13	2:25	2:25		

SOIL AUGER FINDING Sand

TESTED BY Wene

REMARKS \_\_\_\_\_

✓ ALSO PRESENT Alto Samuel LOT NO. \_\_\_\_\_