

11/3/61
Afternoon

Approved
PERMIT

04464
P ~~6246~~
A 04266

INDEXED

SEWAGE DISPOSAL SYSTEM

MARYLAND STATE DEPARTMENT OF HEALTH

HOWARD COUNTY

ELLICOTT CITY

INDEXED

DISTRICT _____

DATE 11/3/61

Ernest German

IS PERMITTED TO INSTALL _____ ALTER _____

ADDRESS _____ PHONE _____

A SEWAGE DISPOSAL SYSTEM LOCATED AT Trinity Evangelical Church - Home
at the corner of Rt 99 & Chapel Ave.

SUBDIVISION _____ ROAD _____ LOT _____

PROPERTY OWNER Trinity Evangelical Church

ADDRESS _____

SPECIFICATIONS

DRAIN FIELD X DEPTH _____ FEET, BOTTOM AREA 500 SQ. FT. to be installed
in area tested
SEEPAGE PITS _____ ABSORBENT SIDE-WALL AREA _____ SQ. FT.
SEPTIC TANK CAPACITY _____ GALLONS

FOR GARBAGE GRINDER, INCREASE DISPOSAL AREA 22% & TANK CAPACITY 50%.


OTHER OK to put 4 septic tanks in
Septic Tank cannot be installed more than 3 feet
below original grade

PLANS APPROVED BY Palmer Wine DATE 9/19/61

FILL SEPTIC TANK AND DISTRIBUTION BOX WITH WATER BEFORE CALLING FOR AN INSPECTION. COVER NO WORK UNTIL INSPECTED AND APPROVED.

NEITHER THE HOWARD COUNTY COMMISSIONERS NOR THE HEALTH DEPARTMENT IS RESPONSIBLE FOR THE SUCCESSFUL OPERATION OF ANY SYSTEM.

A 04366

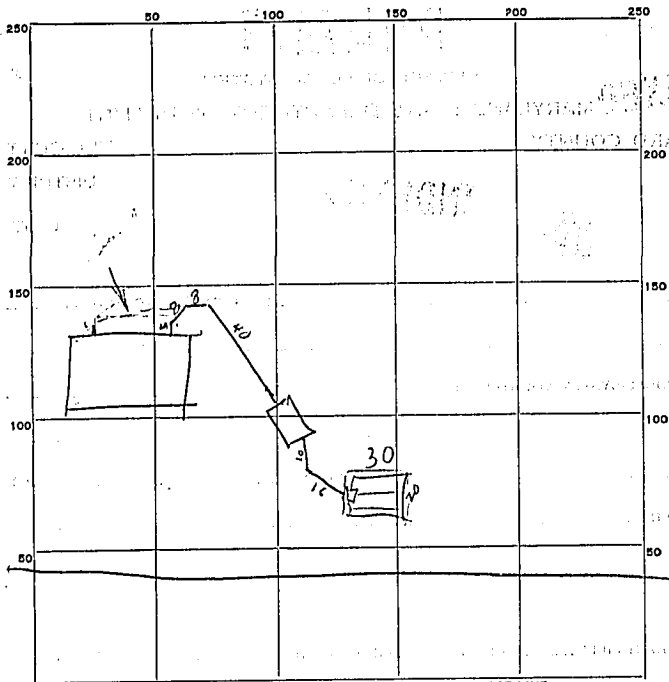

INDICATE NORTH - NAME ADJOINING ROADWAY AS BASE LINE.

PERMIT CARD yes

SEPTIC TANK, LEVEL OK 750 steel
top 3 ft below grade

CLEANOUTS OK

DISTRIBUTION BOX, LEVEL _____

TILE FIELD, DEPTH _____ FT. TRENCH WIDTH _____ FT.

GRAVEL DEPTH _____ IN. TOTAL LENGTH _____ FT.

NUMBER OF TRENCHES _____ TOTAL BOTTOM AREA _____

SEEPAGE PITS, INSIDE DIAMETER _____ FT. DEPTH BELOW INLET _____ FT.

ABSORBENT AREA _____ SQ. FT.

REMARKS Leaching Bed 20' x 30' = 600

sq ft Depth = 4 ft to 6 ft

DATE SYSTEM APPROVED 3 NOV 61

INSPECTOR Raymond Hedges