

8/6/92  
8/7/92 10:00  
8/7/92 12:00  
8/7/92 2:00  
8/7/92

# PERMIT

*File*

8/6 MOON-  
O.P.C.O. C.B.S.  
P 48/98  
8/6 O.P.C.O. C.B.S.  
A 36593

## SEWAGE DISPOSAL SYSTEM

DEPARTMENT OF HEALTH AND MENTAL HYGIENE

03-313859

DISTRICT 3rd

HOWARD COUNTY HEALTH DEPARTMENT

DATE 8/2/92

BUREAU OF ENVIRONMENTAL HEALTH

DATE SYSTEM APPROVED 8/7/92

461-9933

INDEXED

INSPECTOR C.K.S.

Van Sant Plumbing & Heating, Inc. IS PERMITTED TO INSTALL  ALTER

ADDRESS 3 North Main Street, Mt. Airy, Maryland 21771 PHONE 795-6566

SUBDIVISION King's Grant LOT 10 ROAD 3200 Parliament Place

PROPERTY OWNER Patriot Homes Robert G. Pusheck

ADDRESS \_\_\_\_\_

SEPTIC TANK CAPACITY 1250 GALLONS

NUMBER OF BEDROOMS 4

210 SQUARE FEET PER BEDROOM

LINEAR FEET OF TRENCH REQUIRED 210

TRENCHES - Trench to be 2 feet wide. Inlet 3 feet below original grade. Bottom maximum depth 7 feet below original grade. Effective area begins at 3 feet below original grade. 4 feet of stone below distribution pipe.

LOCATION - Start the first trench approximately 30 feet from the front lot line and 120 feet from the right lot line. Run trenches along court toward right side of lot. Distribution box should be at least 100 feet from well.

NOTES - No trench to exceed 100 feet in length. Provide 6" - 8" diameter cleanout and cap to grade or above on septic tank. *OK 5/21/92 R/A*

PLANS APPROVED BY C. Williams DATE 12/15/88

COVER NO WORK UNTIL INSPECTED AND APPROVED

NEITHER THE HOWARD COUNTY COUNCIL NOR THE HEALTH DEPARTMENT IS RESPONSIBLE FOR THE SUCCESSFUL OPERATION OF ANY SYSTEM

NOTE: CLEANOUT REQUIRED EVERY 70 FEET OF SEWER LINE AND/OR AT 90° SWEEPS IN LINES FROM HOUSE TO DRAIN FIELDS, 90° ELBOWS NOT ACCEPTABLE.

NOTE: ALL PARTS OF SEPTIC SYSTEMS (I.E. TANK, DISTRIBUTION BOX TRENCHES) TO BE 100 FEET FROM WELL (UNLESS OTHERWISE SPECIFICALLY AUTHORIZED)

NOTE: IF DEEP TRENCH(ES) ARE USED CALL FOR INSPECTION BEFORE AND AFTER PLACING GRAVEL IN TRENCH(ES)

NOTE: NO DRY WELL SHALL EXCEED 15 FOOT IN DIAMETER NO ABSORPTION TRENCH TO EXCEED 100 FEET IN LENGTH

NOTE: ALL PIPE FROM HOUSE TO SEPTIC TANK MUST BE CAST IRON OR SCHEDULE 35/40 PVC OR ABS

PERMIT VOID AFTER TWO YEARS

NOTE: INSTALL STAND PIPE ON SEPTIC TANK AND DRY WELL STAND PIPES MUST BE 6 INCHES IN DIAMETER CAST IRON. CONCRETE OR TERRA COTTA OR PVA OR ABS ACCEPTED. IF TOP OF SEPTIC TANK IS DEEPER THAN 3 FEET. MANHOLE TO GRADE REQUIRED.

NOTE: DISTRIBUTION BOXES MUST HAVE BAFFLES


BLDG. PERMIT SIGNED AND RETURNED 12/2/92

*Serial # 57468*

*Deck*

\*INSTALLER IS RESPONSIBLE FOR OBTAINING FINAL APPROVAL ON THIS PERMIT

A 36593

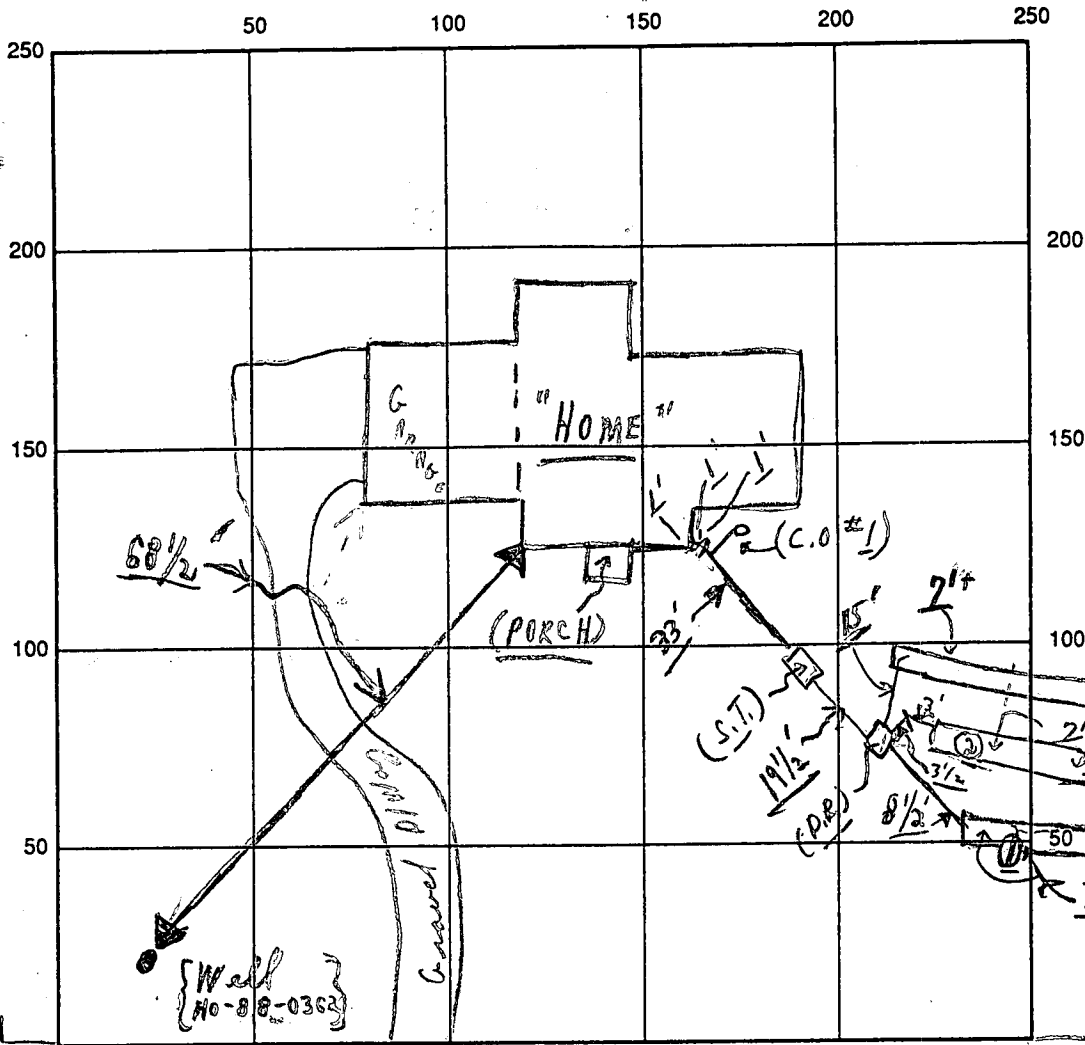

SEPTIC TANK LEVEL OK Parliament Place CLEANOUTS 8/7 S.T. OK / C.O. #1 OK

DISTRIBUTION BOX LEVEL OK (Baffles in)

DRAIN FIELD/TITLE DEPTH 7<sup>①</sup> 7<sup>②</sup> FT. TRENCH WIDTH 0...2' FT. INLET DEPTH 3 FT.

EFFECTIVE GRAVEL DEPTH 4<sup>③</sup> FT. TOTAL LENGTH  $\left\{ \begin{array}{l} ① 70' \\ ② 70' \\ ③ 7' \end{array} \right. \text{ FT.} = \left. \right\} = \underline{211}$

NUMBER OF TRENCHES 3 ONE SIDEWALL/BOTTOM AREA 844 SQ. FT.

DRYWALL INSIDE DIAMETER — FT. EFFECTIVE DEPTH BELOW INLET — FT.

ABSORBENT AREA 844 SQ. FT.

REMARKS: Partial 8/6/92 - Trench # ① ok for stones only; and ok to cover from  
Dist. Box. to S. enter Tank only; c.B.S. Partial "HOLD FOR A CALL"  
(A.M.) 8/7/92 Partial; ok to cover from house to septic tank; ok to stones in ②  
(NOON) 8/7/92 ok to cover # ② trench and stones # ③ trench; c.B.S. trench  
(2:00) 8/7/92 ok to cover # ③ trench and all work; Final c.B.S.  
8/6 W.P.I. - ok to cover all work. Final c.B.S.

DATE SYSTEM APPROVED 8/7/92 - INSPECTOR Charles, Bryan, Sheak

# APPLICATION

PERCOLATION TESTING

A 36593

P \_\_\_\_\_

HOWARD COUNTY HEALTH DEPARTMENT  
BUREAU OF ENVIRONMENTAL HEALTH  
P.O. BOX 476 ELLICOTT CITY, MARYLAND 21043  
TELEPHONE: 461-9933

DISTRICT 3rd

DATE 2-17-86

TO: THE COUNTY HEALTH OFFICER  
ELLICOTT CITY, MARYLAND

I, HEREBY, APPLY FOR THE NECESSARY TEST IN ORDER TO CONSTRUCT (OR RECONSTRUCT) A SEWAGE DISPOSAL SYSTEM. Patriot Homes - 997-5328

PROPERTY OWNER J.C. Mahoney Williamsburg Builders - 997-8800

ADDRESS Sumner Hill Farm Rt 32 West Friendship PHONE 489-4642

PROSPECTIVE BUYER Howard County Fuel Services, Inc

ADDRESS 16176 Baltimore National Pike PHONE 465-5855

PROPERTY LOCATION: ~~6600~~ KING'S GRANT # PAGE 10

SUBDIVISION Mahoney Property LOT NO. 45

ROAD AND DESCRIPTION Rt 32 - ~~add Drury Road~~ Parliament Pl.

TAX MAP 22 PARCEL # 7

SIZE OF LOT 6.0 ac TYPE BLDG. Single Family  
(SINGLE FAMILY DWELLING OR COMMERCIAL)

THE SYSTEM INSTALLED UNDER THIS APPLICATION IS ACCEPTABLE ONLY UNTIL PUBLIC FACILITIES BECOME AVAILABLE. I FULLY UNDERSTAND THE FEE CONNECTED WITH THE FILING OF THIS PERC TEST APPLICATION IS NON-REFUNDABLE UNDER ANY CIRCUMSTANCES. I ALSO AGREE TO COMPLY

WITH ALL M.O.S.H.A. REQUIREMENTS IN TESTING THIS LOT J.C. Mahoney  
(SIGNATURE OF APPLICANT)

APPROVED BY \_\_\_\_\_ FOR \_\_\_\_\_ DATE \_\_\_\_\_

REJECTED BY \_\_\_\_\_ FOR \_\_\_\_\_ DATE \_\_\_\_\_

HOLD PENDING FURTHER TESTS \_\_\_\_\_ DATE \_\_\_\_\_

REASONS FOR REJECTION OR HOLDING \_\_\_\_\_

BLDG. PERMIT SIGNED

AND RETURNED 4/28/82  
Serial # 41787 - SFD  
4 Bedrooms

BLDG. PERMIT SIGNED

AND RETURNED 7/18/82  
Serial # 26973  
SFD - 4 Bedrooms

# THIS IS NOT A PERMIT

Handwritten scribbles in the top right corner.

SOIL PROFILE

Vertical rectangular box for soil profile drawing.

Large empty grid for soil profile data, consisting of 5 columns and 5 rows.

INDICATE NORTH - NAME ADJOINING ROADWAY AS BASE LINE.

DATE	TEST NO.	DEPTH	PRE-WET		TEST - 1" DROP		TIME
			START	STOP	START	STOP	

REMARKS \_\_\_\_\_

TYPE OF SOIL \_\_\_\_\_

TESTED BY \_\_\_\_\_ ALSO PRESENT \_\_\_\_\_

EH-12-1079

# APPLICATION

PERCOLATION TESTING

A 36593

P \_\_\_\_\_

HOWARD COUNTY HEALTH DEPARTMENT  
BUREAU OF ENVIRONMENTAL HEALTH  
P.O. BOX 476 ELLICOTT CITY, MARYLAND 21043  
TELEPHONE: 461-9933

DISTRICT \_\_\_\_\_

DATE \_\_\_\_\_

TO: THE COUNTY HEALTH OFFICER  
ELLICOTT CITY, MARYLAND

I, HEREBY, APPLY FOR THE NECESSARY TEST IN ORDER TO CONSTRUCT (OR RECONSTRUCT) A SEWAGE DISPOSAL SYSTEM.

PROPERTY OWNER \_\_\_\_\_

ADDRESS \_\_\_\_\_ PHONE \_\_\_\_\_

PROSPECTIVE BUYER \_\_\_\_\_

ADDRESS \_\_\_\_\_ PHONE \_\_\_\_\_

PROPERTY LOCATION:

SUBDIVISION MOBERLY PROP LOT NO. 45

ROAD AND DESCRIPTION Rt 32 off West Ivory Rd

TAX MAP \_\_\_\_\_ PARCEL # \_\_\_\_\_

SIZE OF LOT \_\_\_\_\_ TYPE BLDG. \_\_\_\_\_  
(SINGLE FAMILY DWELLING OR COMMERCIAL)

THE SYSTEM INSTALLED UNDER THIS APPLICATION IS ACCEPTABLE ONLY UNTIL PUBLIC FACILITIES BECOME AVAILABLE. I FULLY UNDERSTAND THE FEE CONNECTED WITH THE FILING OF THIS PERC TEST APPLICATION IS NON-REFUNDABLE UNDER ANY CIRCUMSTANCES. I ALSO AGREE TO COMPLY WITH ALL M.O.S.H.A. REQUIREMENTS IN TESTING THIS LOT.

(SIGNATURE OF APPLICANT)

APPROVED BY \_\_\_\_\_ FOR \_\_\_\_\_ DATE \_\_\_\_\_

REJECTED BY \_\_\_\_\_ FOR \_\_\_\_\_ DATE \_\_\_\_\_

HOLD PENDING FURTHER TESTS \_\_\_\_\_ DATE \_\_\_\_\_

REASONS FOR REJECTION OR HOLDING \_\_\_\_\_

\_\_\_\_\_  
\_\_\_\_\_


# THIS IS NOT A PERMIT

67  
45  
NUMBER  
PROP

(10)

STAKE  
LOT  
448 LOT 45

EXISTING  
WELL

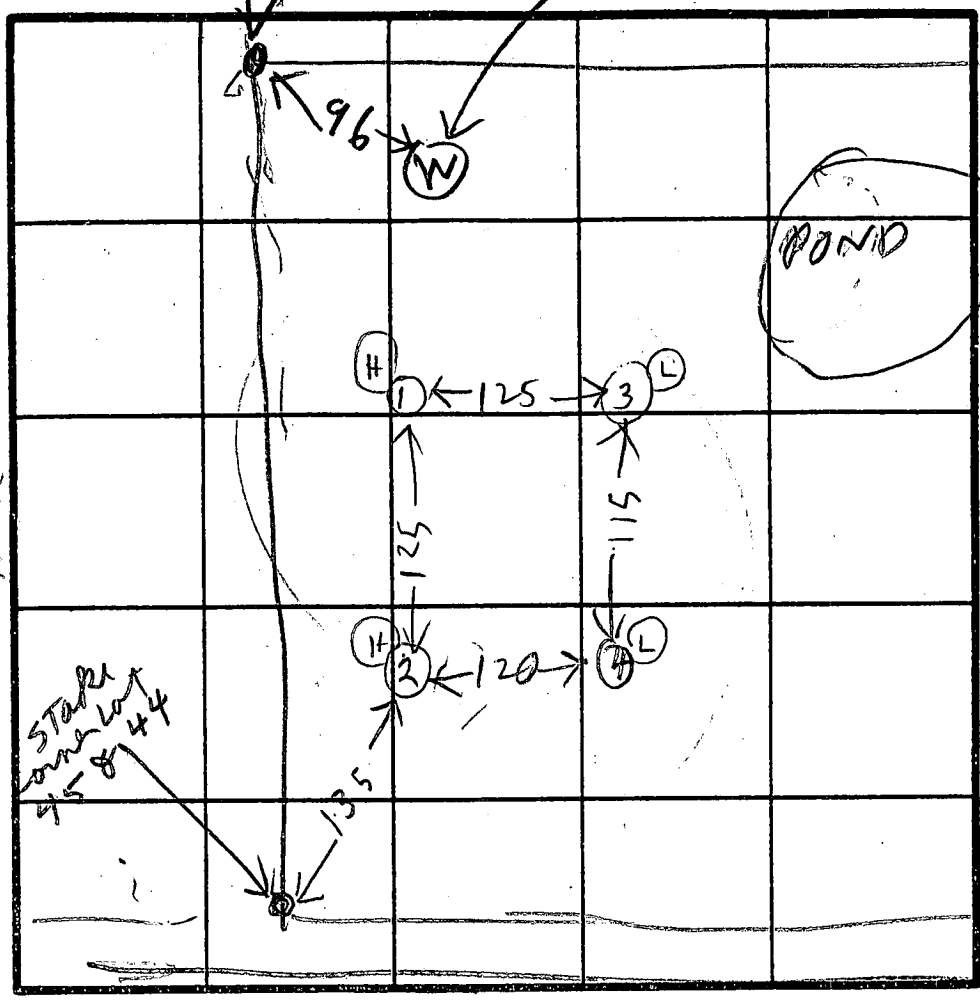

Street B

HOLE  
ELEVATION

(1)(2) = HIGH

(3)(4) = LOW

INDICATE NORTH - NAME ADJOINING ROADWAY AS BASE LINE.

RT 32

SOIL PROFILE  
 0  
 BROWN  
CLAY  
LOAM  
 3  
 BROWN  
SAND  
LOAM  
& A  
FEW  
COBBLES  
 54  
125  
 11

(2)  
 BROWN  
CLAY  
LOAM  
 BROWN  
SAND  
LOAM  
 4  
 12

(3)  
 TAN CLAY  
TOPSOIL  
 RED BROWN  
SAND  
LOAM  
 2  
 14

(4)  
 RED  
CLAY  
 BROWN  
GREEN  
SAND  
LOAM  
 2  
 12  
 EH-12-1079

DATE	TEST NO.	DEPTH	PRE-WET		TEST - 1" DROP		TIME
			START	STOP	START	STOP	
2/27/86	1S	3.5	219	224	224	231	7
	1V	7	226	227	227	224	2
	1V	11	LOOKS	OK			
2/27/86	2S	5	229	242	242	252	12
	2V	12	200	230	230		
	3S	4	234	235	235	237	2
	3V	14	LOOKS	OK			
	4S	3.5	240	244	244	248	4
	4V	12	LOOKS	OK			

REMARKS: Holes Not dug per surveyor plan


TYPE OF SOIL: R. HODGES

ALSO PRESENT: KETTERMANS

A36593

A ~~36588~~

MUBBERLY  
PROP  
LOT NEW 10

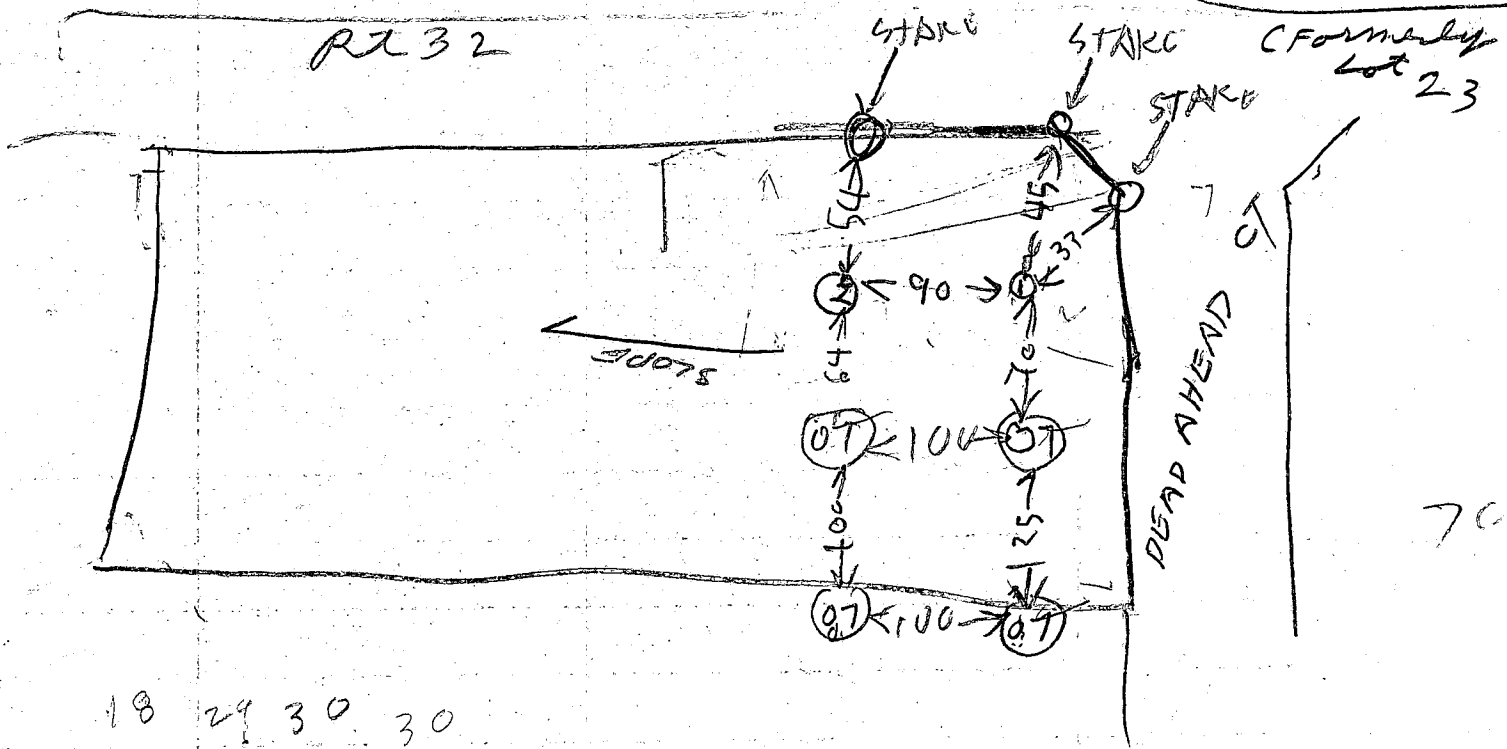

18 29 30 30  
29

(5) = OLD TESTS

7/22/88	13	3 1/2	1134	1140	1140	1151	11
	IV	13	LOOKS OK				
	25	2 1/2	1134	1138	1138	1146	8
	2V	14	LOOKS OK				

9  
3  
17  
8  
24  
51  
19

Don't  
figure  
Max. depth  
& volume  
Till Well.  
Sealed on  
Lot 9  
8/20/86

also present Kellerman  
Test by B. Hodger

B 1 **7812** SEQUENCE NO. (DP USE ONLY)  
 (THIS NUMBER IS TO BE PUNCHED IN COLS. 3-6 ON ALL CARDS)

STATE OF MARYLAND  
 PERMIT TO DRILL WELL  
 please print or type

STATE PERMIT NUMBER  
**HO-98-0362**  
 fill in this form completely

Date Received (APA) **12/14/88**  
 OWNER INFORMATION  
**HOWARD** ESTATES **DEV**  
 15 Last Name Owner First Name  
**PO BOX 1018**  
 36 Street or RFD 55  
**COLUMBIA** **MD 21044**  
 57 Town 70 State 72 Zip 76

B 3 LOCATION OF WELL **R-43209**  
**12/14/88**  
**10:50**  
**HOWARD**  
 8 COUNTY 21  
~~HOWARD~~ **WALKER/ING'S GRANT**  
 23 SUBDIVISION 42  
 SECTION **10** LOT **10**  
 44 46 48 50  
**Glennelig**  
 52 NEAREST TOWN 71  
 MILES FROM TOWN (enter 0 if in town) **1** **M** **1**  
 73 76 77 78

DRILLER INFORMATION  
**George Easterday**  
 40  
 77 License No. 80  
 Driller's Name  
**L.F. Easterday, Inc.**  
 Firm Name  
**9265 Brown Church Rd., Mt. Airy, Md. 21771**  
 Address  
 Signature *George Easterday* Date **12-5-88**

B 4 DIRECTION OF WELL FROM TOWN (CIRCLE BOX)  
  
 NEAR WHAT ROAD **Parliament Pl.**  
 ON WHICH SIDE OF ROAD (CIRCLE APPROPRIATE BOX)  
 NORTH  WEST  EAST  SOUTH   
 DISTANCE FROM ROAD **40**  
 34 37  
 ENTER FT or MI **FT**  
 38 39

B 2 WELL INFORMATION  
 APPROX. PUMPING RATE (GAL. PER MIN.) **5**  
 8 12  
 AVERAGE DAILY QUANTITY NEEDED (GAL. PER DAY) **500**  
 14 20

USE FOR WATER (CIRCLE APPROPRIATE BOX)  
 HOME (SINGLE OR DOUBLE HOUSEHOLD UNIT ONLY)  
 FARMING (LIVESTOCK WATERING & AGRICULTURAL IRRIGATION)  
 INDUSTRIAL, COMMERCIAL, STATE AND FEDERAL GOV. OTHER (REQUIRES APPROPRIATION PERMIT)  
 PUBLIC OR PRIVATE WATER COMPANY (REQUIRES APPROPRIATION PERMIT AND STATE HEALTH DEPARTMENT APPROVAL)  
 TEST, OBSERVATION, MONITORING (MAY REQUIRE APPROPRIATION PERMIT)

NOT TO BE FILLED IN BY DRILLER HEALTH DEPARTMENT APPROVAL  
**HOWARD** **A#36593**  
 COUNTY NAME COUNTY NO.  
 STATE SIGNATURE \_\_\_\_\_ INSERT S \_\_\_\_\_ 41  
 DATE ISSUED **12/23/89**  
 43 48 CO SIGNATURE *Charles Bryan* EXP. DATE **12/23/89**  
 NORTH GRID **527000** EAST GRID **0807000**  
 50 55 57 63

APPROXIMATE DEPTH OF WELL **200** FEET  
 24 28

APPROXIMATE DIAMETER OF WELL **6** INCH  
 NEAREST INCH

METHOD OF DRILLING (circle one)  
 BORED (or Augered) JETTED Jetted & DRIVEN  
 AIR-ROTary AIR-PERcussion ROTARY (Hydraulic Rotary)  
 CABLE REVERSE-ROTary DRIVE-POINT  
 other \_\_\_\_\_

REPLACEMENT OR DEEPEMED WELLS (CIRCLE APPROPRIATE BOX)  
 THIS WELL WILL NOT REPLACE AN EXISTING WELL  
 THIS WELL WILL REPLACE A WELL THAT WILL BE ABANDONED AND SEALED  
 THIS WELL WILL REPLACE A WELL THAT WILL BE USED AS A STANDBY  
 THIS WELL WILL DEEPEM AN EXISTING WELL  
 PERMIT NUMBER OF WELL TO BE REPLACED OR DEEPEMED (IF AVAILABLE) \_\_\_\_\_

Not to be filled in by driller (OEP USE ONLY)  
 APPROP. PERMIT NUMBER \_\_\_\_\_ GAP \_\_\_\_\_  
 54 E: 63  
 FORCE **CM** WRITE INITIALS IN BOX PERMIT NO. **HO-98-0362**  
 67 68 70 71 72 73 74 75 76 77 78 79

SHOW MAJOR FEATURES OF BOX & LOCATE WELL WITH AN X  
 SOURCES OF DRILLING WATER  
 1. well  
 2.  
 3.  
 WRITE THE BOX NUMBER FROM THE MAP HERE  
  
 DRAW A SKETCH BELOW SHOWING LOCATION OF WELL IN RELATION TO NEARBY TOWNS AND ROADS AND GIVE DISTANCE FROM WELL TO NEAREST ROAD JUNCTION **35**

**2-2-89**  
**10AM**  
**60' CASING** **GROUT**  
**54' OPEN** **OBS'D**  
**14 BAGS**  
**2 1/2' CASING A.G.**  
**MP**  
**TAG OK 6/2/89**  
**Barrit woods**  
**DEC 15 8 35 AM '88**  
**Glennelig**  
**Triadelphia**  
**HEALTH DEPT**  
**HOWARD COUNTY**  
**BERRY**

C1 6694

SEQUENCE NO. (DENV USE ONLY)

STATE OF MARYLAND WELL COMPLETION REPORT

THIS REPORT MUST BE SUBMITTED WITHIN 45 DAYS AFTER WELL IS COMPLETED.

(THIS NUMBER IS TO BE PUNCHED IN COLS. 3-6 ON ALL CARDS)

COUNTY NUMBER R 36593

DATE RECEIVED

DATE WELL COMPLETED

DEPTH OF WELL

PERMIT NO. FROM "PERMIT TO DRILL WELL"

DATE RECEIVED grid

DATE WELL COMPLETED grid: 060287

DEPTH OF WELL grid: 200

PERMIT NO. grid: 40-88-0362

OWNER: HOWARD ESTATES DEV. STREET OR RFD: Parliament Place... TOWN: GLENELG SUBDIVISION: GLEN MOOR SECTION: LOT: 10

WELL LOG

Not required for driven wells

STATE THE KIND OF FORMATIONS PENETRATED, THEIR COLOR, DEPTH, THICKNESS AND IF WATER BEARING

Table with columns: DESCRIPTION (Use additional sheets if needed), FEET (FROM, TO), Check if water bearing. Rows include: TOP SOIL, RED CLAY, BR. MICA, TAN MICA, BLUE MICA.

GROUTING RECORD

WELL HAS BEEN GROUTED (YES/NO), TYPE OF GROUTING MATERIAL (CEMENT, BENTONITE CLAY), NO. OF BAGS, NO. OF POUNDS, GALLONS OF WATER, DEPTH OF GROUT SEAL.

CASING RECORD

MAIN CASING TYPE, Nominal diameter, Total depth of main casing, OTHER CASING (if used) diameter and depth.

SCREEN RECORD

screen type or open hole (insert appropriate code below), SCREEN RECORD (STEEL, BRASS, OPEN HOLE, PLASTIC, OTHER).

C2

DEPTH (nearest ft.) grid, SLOT SIZE, DIAMETER OF SCREEN (NEAREST INCH).

GRAVEL PACK, IF WELL DRILLED WAS FLOWING WELL INSERT F IN BOX 68.

OEP USE ONLY (NOT TO BE FILLED IN BY DRILLER), TELESCOPE CASING, LOG INDICATOR, OTHER DATA.

C3


PUMPING TEST

HOURS PUMPED, PUMPING RATE, METHOD USED TO MEASURE PUMPING RATE, WATER LEVEL, BEFORE PUMPING, WHEN PUMPING, TYPE OF PUMP USED.

PUMP INSTALLED

DRILLER WILL INSTALL PUMP (YES/NO), TYPE OF PUMP INSTALLED PLACE, CAPACITY, GALLONS PER MINUTE, PUMP HORSE POWER, PUMP COLUMN LENGTH, CASING HEIGHT.

LOCATION OF WELL ON LOT SHOW PERMANENT STRUCTURE SUCH AS BUILDING, SEPTIC TANKS, AND/OR LANDMARKS AND INDICATE NOT LESS THAN TWO DISTANCES (MEASUREMENTS TO WELL)

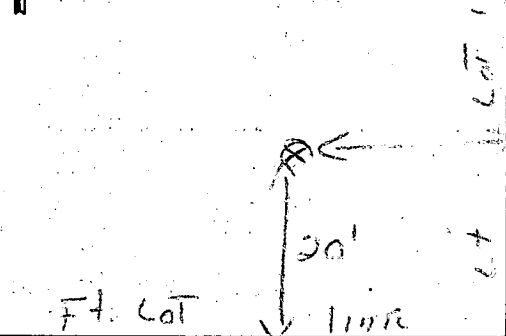

CIRCLE APPROPRIATE LETTER A WELL WAS ABANDONED AND SEALED WHEN THIS WELL WAS COMPLETED, E ELECTRIC LOG OBTAINED, P TEST WELL CONVERTED TO PRODUCTION WELL.

I HEREBY CERTIFY THAT THIS WELL HAS BEEN CONSTRUCTED IN ACCORDANCE WITH COMAR 10.17.13 "WELL CONSTRUCTION" AND IN CONFORMANCE WITH ALL CONDITIONS STATED IN THE ABOVE CAPTIONED PERMIT...

DRILLERS IDENT. NO., DRILLERS SIGNATURE, SITE SUPERVISOR (Sign. of driller or journeyman responsible for sitework if different from permittee).

COUNTY



8/6/92  
HOWARD COUNTY HEALTH DEPARTMENT  
Bureau of Environmental Health  
3525-H Ellicott Mills Drive  
Ellicott City, MD 21043  
461-9933

8/6/92  
Final  
ok  
C.B.D.

APPLICATION FOR PITLESS ADAPTER, WELL LINE PUMP AND PRESSURE TANK INSTALLATION

New Installation X  
Replacement \_\_\_\_\_

Receipt # 48197  
Date 6/2/92

Name of Installer Van Sant Plbg & Htg  
Hanford A. Van Sant

Telephone 795-6566

License Number 1467  
Certified Well Pump Installer \_\_\_\_\_ Well Driller \_\_\_\_\_ Registered Plumber X

Name of Property Owner Patriot Homes Telephone 997-8800  
Subdivision Kings Grant Lot # 10 Well Tag # 40-88-0362  
Site Address 3200 Parliament Place West Friendship, MD 21794

8/6/92  
C.B.D.

Pump

- Type  
a. Deep well jet \_\_\_\_\_  
b. Shallow well jet \_\_\_\_\_  
c. Submersible
- Make Good
- Model # \_\_\_\_\_
- Capacity \_\_\_\_\_ GPM
- Pump exceeds well capacity Yes \_\_\_\_\_ No
- If Yes, is low pressure cutoff switch installed? Yes \_\_\_\_\_ No
- What methods are used to protect the pump and electrical wiring from vibrations? Torque arrestors \_\_\_\_\_ Cable guards  Other \_\_\_\_\_

Motor

- Horsepower \_\_\_\_\_
- RPM \_\_\_\_\_
- Voltage \_\_\_\_\_  
a. 110 \_\_\_\_\_  
b. 220

Pitless Adapter

- Make Cambrel
- Model # B10-7
- Depth 48"

Tank

- Capacity 100
- Pressure relief valve?

Piping

- Type Poly
- Size 1"
- NSF and/or BOCA Code approved
- Depth of supply line 48"

Well data

- Depth \_\_\_\_\_ ft.
- Yield \_\_\_\_\_ GPM
- Static water level \_\_\_\_\_ ft.
- Will water supply be disinfected by installer? NO

I understand that it is my responsibility to notify the Howard County Health Department when the installation is ready for inspection (otherwise this permit is null and void).

All information given above is true to the best of my knowledge.

Signature of Applicant: Hanford A. Van Sant

Date: 5/22/92

Note: A sticker indicating approval/status of the installation will be placed on the well casing at the time of the inspection.

BP 41787  
4/20/92



PRIVATE SEWER EASEMENT

S 67° 36' 04" W  
20' DRAINAGE & UT

594.34

30' B.R.L.

100' B.R.L.

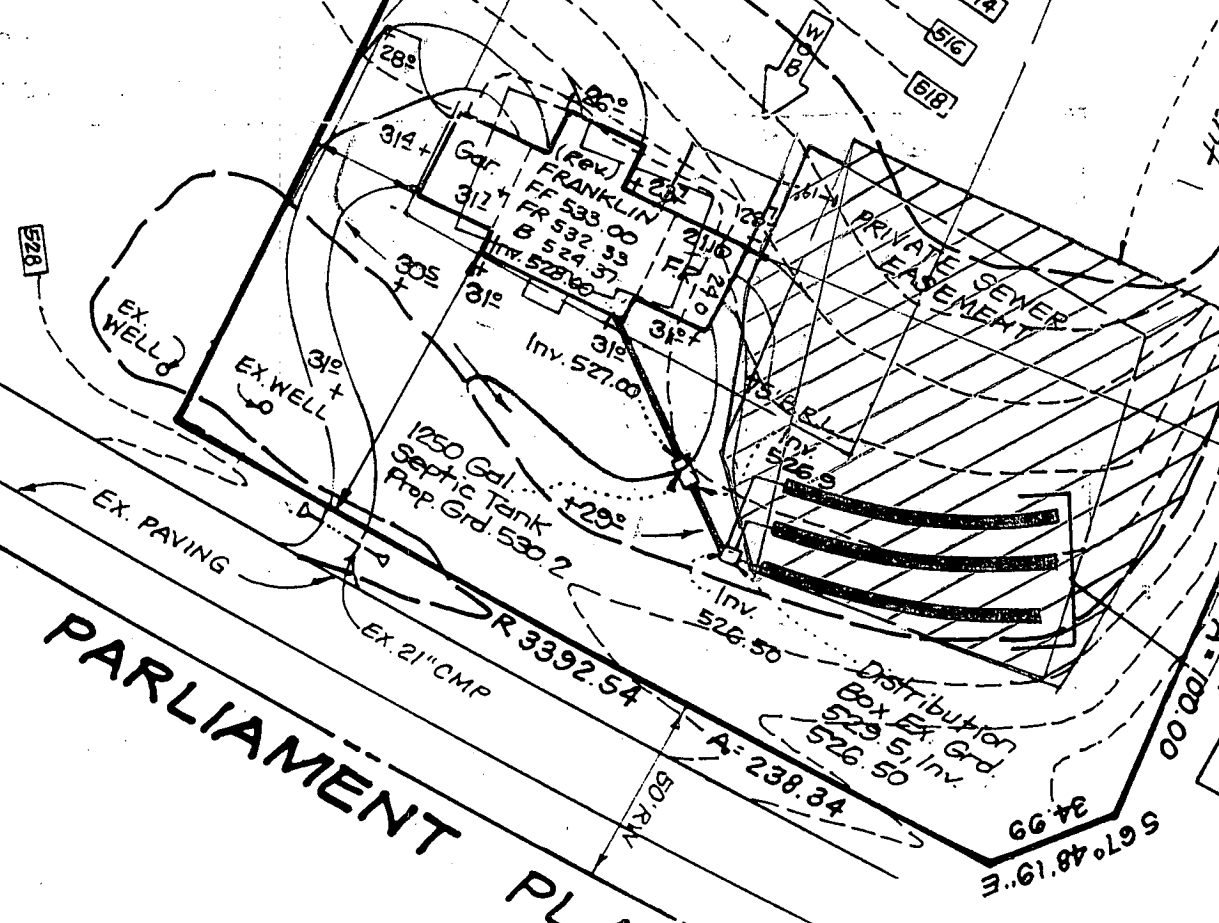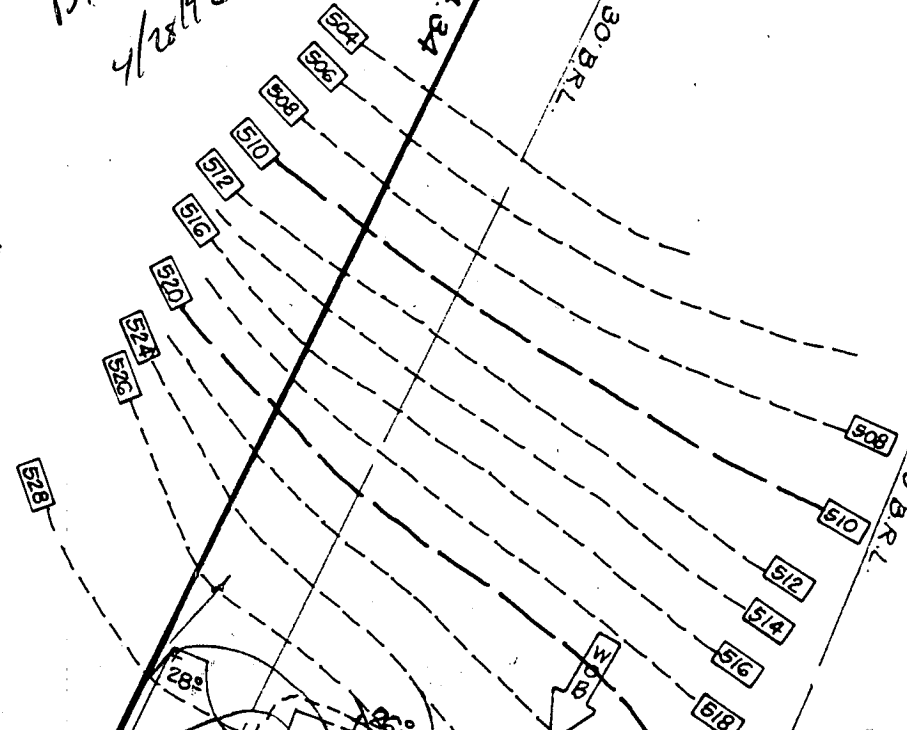

PRIVATE SEWER EASEMENT

PARLIAMENT PL

R 3392.54

A= 238.34

Distribution Box Ex. Grd. Inv. 526.50

567° 48' 19" E  
34.99


A= 100.00

SDA was revised at time of BP to accommodate the desired house site. Proposed deck location will have no impact to existing well or septic. OK to proceed. Any McMillen

12-2-94  
0P57468

# LAND ROUTE

COMMISSION 727-405-3385, 2333

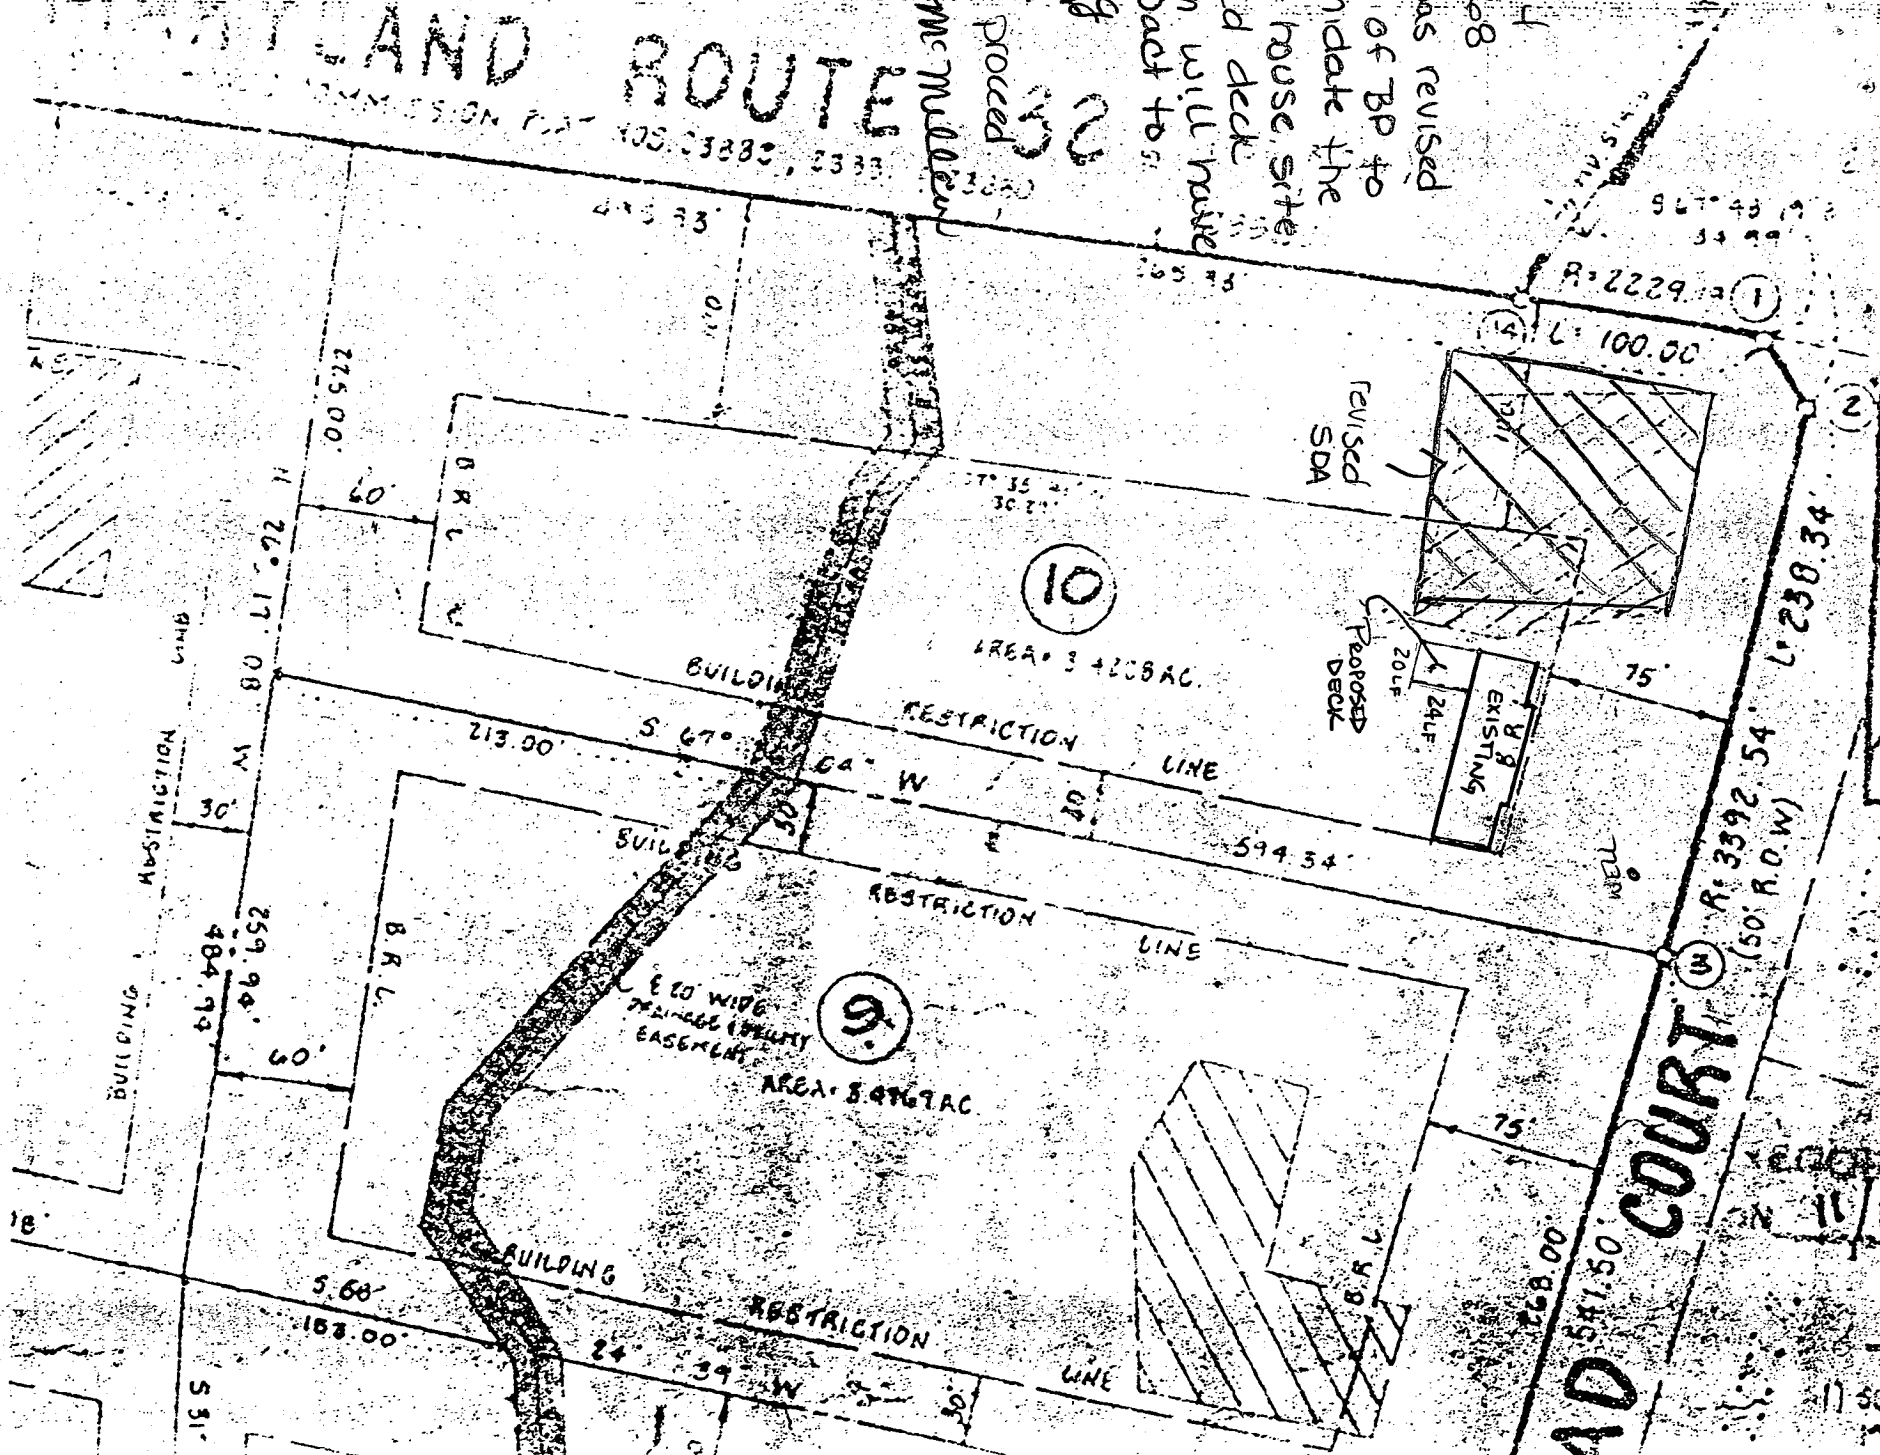

**40 COURT**  
R=3392.54  
(50' R.O.W.)

NOTE  
SUBJECT  
1985 C