

9-2592
 40:00 am
 9/30/92
 3/16/93
 (11:00 to 12:00)
 pm

PERMIT

SEWAGE DISPOSAL SYSTEM

DEPARTMENT OF HEALTH AND MENTAL HYGIENE

03-313891

P 48199

A 36604

DISTRICT 3rd

DATE 6/29/92

DATE SYSTEM APPROVED 3/16/93

INSPECTOR C.B.S.

HOWARD COUNTY HEALTH DEPARTMENT

BUREAU OF ENVIRONMENTAL HEALTH

461-9933

INDEXED

Robert Spicknall IS PERMITTED TO INSTALL ALTER

ADDRESS 11815 Gunpowder Road, Beltsville, Maryland 20705 PHONE

SUBDIVISION King's Grant LOT 14 ROAD 3224 Regents Row

PROPERTY OWNER Robert G. Spicknall 26

ADDRESS

SEPTIC TANK CAPACITY 1250 GALLONS

NUMBER OF BEDROOMS 4

240 SQUARE FEET PER BEDROOM

LINEAR FEET OF TRENCH REQUIRED 320

TRENCHES - Trench to be 3 feet wide. Inlet 3 1/2 feet below original grade. Bottom maximum depth 5 1/2 feet below original grade. Effective area begins at 3 1/2 feet below original grade. 2 feet of stone below distribution pipe.

LOCATION - Place distribution box 160 feet from the rear (362') lot line and 110 feet from the right lot line. This point is approximately 235 feet from the center of Edliss Court. Run trenches along contour toward right side of lot.

NOTES - No trench to exceed 100 feet in length. Provide 6" - 8" diameter cleanout and cap to grade or above on septic tank. ok/cw

* [9/25/92 Section] of C.K.S. 9/25/92 in existing ground
 Fred C. Williams +/or C.B.S. for C.W. DATE 12/16/88

PLANS APPROVED BY

COVER NO WORK UNTIL INSPECTED AND APPROVED

NEITHER THE HOWARD COUNTY COUNCIL NOR THE HEALTH DEPARTMENT IS RESPONSIBLE FOR THE SUCCESSFUL OPERATION OF ANY SYSTEM

NOTE: CLEANOUT REQUIRED EVERY 70 FEET OF SEWER LINE AND/OR AT 90° SWEEPS IN LINES FROM HOUSE TO DRAIN FIELDS, 90° ELBOWS NOT ACCEPTABLE.

NOTE: ALL PARTS OF SEPTIC SYSTEMS (I.E. TANK, DISTRIBUTION BOX TRENCHES) TO BE 100 FEET FROM WELL (UNLESS OTHERWISE SPECIFICALLY AUTHORIZED)

NOTE: IF DEEP TRENCH(ES) ARE USED CALL FOR INSPECTION BEFORE AND AFTER PLACING GRAVEL IN TRENCH(ES)

NOTE: NO DRY WELL SHALL EXCEED 15 FOOT IN DIAMETER NO ABSORPTION TRENCH TO EXCEED 100 FEET IN LENGTH

NOTE: ALL PIPE FROM HOUSE TO SEPTIC TANK MUST BE CAST IRON OR SCHEDULE 35/40 PVC OR ABS


PERMIT VOID AFTER TWO YEARS

NOTE: INSTALL STAND PIPE ON SEPTIC TANK AND DRY WELL STAND PIPES MUST BE 6 INCHES IN DIAMETER CAST IRON. CONCRETE OR TERRA COTTA OR PVA OR ABS ACCEPTED. IF TOP OF SEPTIC TANK IS DEEPER THAN 3 FEET. MANHOLE TO GRADE REQUIRED.

NOTE: DISTRIBUTION BOXES MUST HAVE BAFFLES

***INSTALLER IS RESPONSIBLE FOR OBTAINING FINAL APPROVAL ON THIS PERMIT**

A 36604

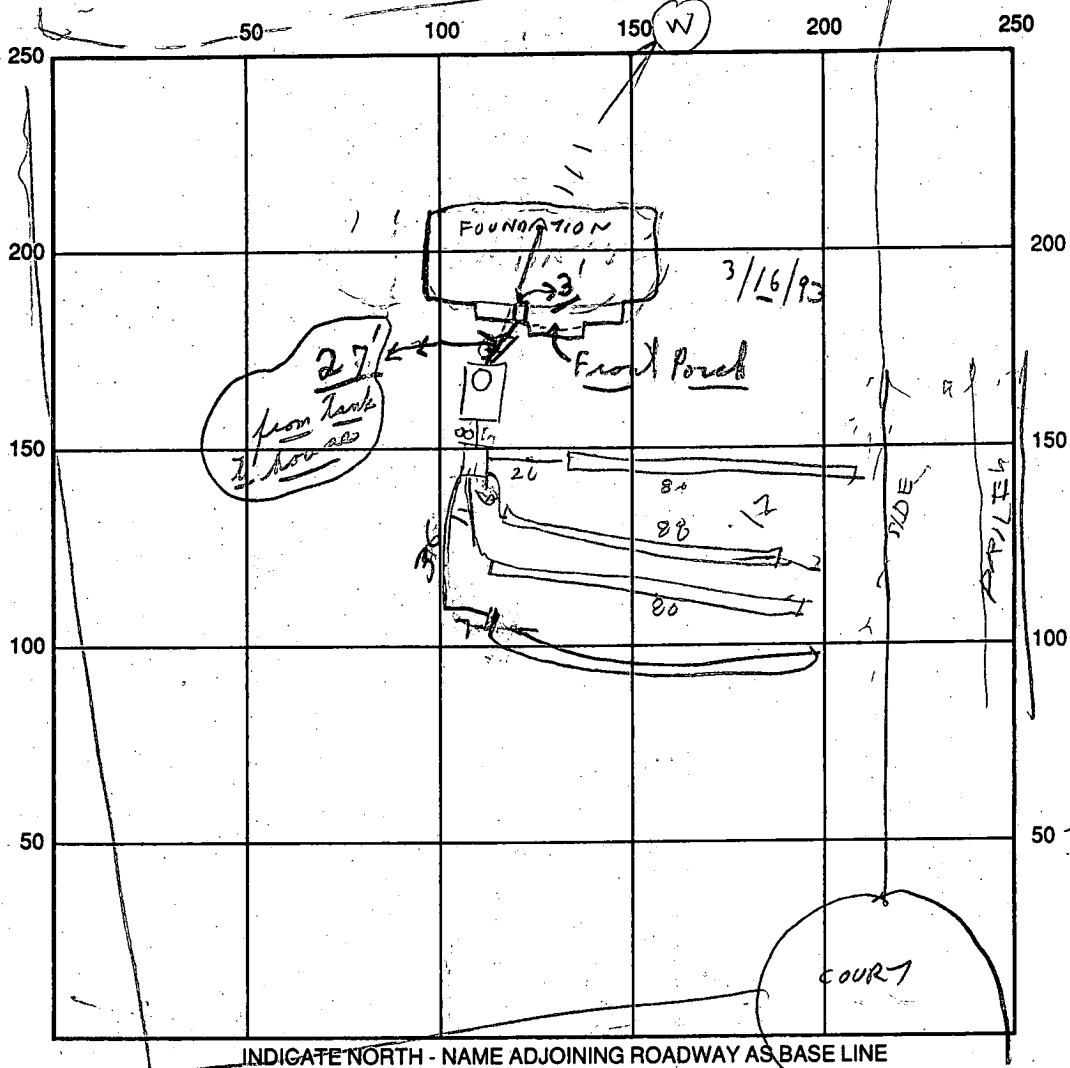

SEPTIC TANK LEVEL 2000 CLEANOUTS MANHOLE

DISTRIBUTION BOX LEVEL OK

DRAIN FIELD/TITLE DEPTH 5-6 FT. TRENCH WIDTH 3 FT. INLET DEPTH _____ FT.

EFFECTIVE GRAVEL DEPTH 2 FT. TOTAL LENGTH 86/99/20 FT. 87

NUMBER OF TRENCHES 4 ONE SIDEWALL/BOTTOM AREA 340 SQ. FT.

DRYWALL INSIDE DIAMETER _____ FT. EFFECTIVE DEPTH BELOW INLET _____ FT.

ABSORBENT AREA _____ SQ. FT.

REMARKS: 9/30/92 TANK + DISTRIBUTION BOX INSTALLED - (CW)

10/11/92^{AM} FIRST THREE TRENCHES OK DIG TRENCH #4

10/1/92^{PM} TRENCH #4 OK, OK TO SIGN BLDG PERMIT W/PLANS OK

CALL FOR INSPECTION OF HOUSE SEWER LATER RH

3/16/93 House connection completed, left card ^{inside} @ garage. CR

Final (Note: 2 of South Circle men at site)

DATE SYSTEM APPROVED 3/16/93 INSPECTOR Charles Bryan Street

SNOW + ICE

APPLICATION

PERCOLATION TESTING

A 36604

P _____

HOWARD COUNTY HEALTH DEPARTMENT
BUREAU OF ENVIRONMENTAL HEALTH
P.O. BOX 476 ELLICOTT CITY, MARYLAND 21043
TELEPHONE: 461-9933

DISTRICT 3rd

DATE 2-17-86

TO: THE COUNTY HEALTH OFFICER
ELLICOTT CITY, MARYLAND

I, HEREBY, APPLY FOR THE NECESSARY TEST IN ORDER TO CONSTRUCT (OR RECONSTRUCT) A SEWAGE DISPOSAL SYSTEM

Robert G. Spicknall

PROPERTY OWNER J.C. Mackenley Williamsburg Boulevard 937-2129

ADDRESS Summit Hill Farm St 35 tent friendship PHONE 489-4644

PROSPECTIVE BUYER Howard County Land Services Inc

ADDRESS 161116 Baltimore National Pike PHONE 465-5855

PROPERTY LOCATION:

SUBDIVISION ~~Mackenley Property~~ KING'S GRANT LOT NO. 3224 NEW 14
ROAD AND DESCRIPTION At 35 old Cherry Road Regent's Row PLAT 6/86

TAX MAP 22 PARCEL # 7

SIZE OF LOT 4.5 ac TYPE BLDG. Single Family
(SINGLE FAMILY DWELLING OR COMMERCIAL)

THE SYSTEM INSTALLED UNDER THIS APPLICATION IS ACCEPTABLE ONLY UNTIL PUBLIC FACILITIES BECOME AVAILABLE. I FULLY UNDERSTAND THE FEE CONNECTED WITH THE FILING OF THIS PERC TEST APPLICATION IS NON-REFUNDABLE UNDER ANY CIRCUMSTANCES. I ALSO AGREE TO COMPLY WITH ALL M.O.S.H.A. REQUIREMENTS IN TESTING THIS LOT.

J.C. Mackenley
(SIGNATURE OF APPLICANT)

APPROVED BY Sidy FOR Standard Arch DATE 5-22-89

REJECTED BY _____ FOR _____ DATE _____

HOLD PENDING FURTHER TESTS _____ DATE _____





REASONS FOR REJECTION OR HOLDING 7/23/86 - DIG MORE (CLAY & ROCK) RH

8/11/86 PERC OK HOLD FOR PLAT RH



BLDG. PERMIT SIGNED AND RETURNED 6/24/86 BLDG. PERMIT SIGNED AND RETURNED 5-26-89
Serial # 43787-5FD-4Bach BP 26182 89

THIS IS NOT A PERMIT

SOIL PROFILE

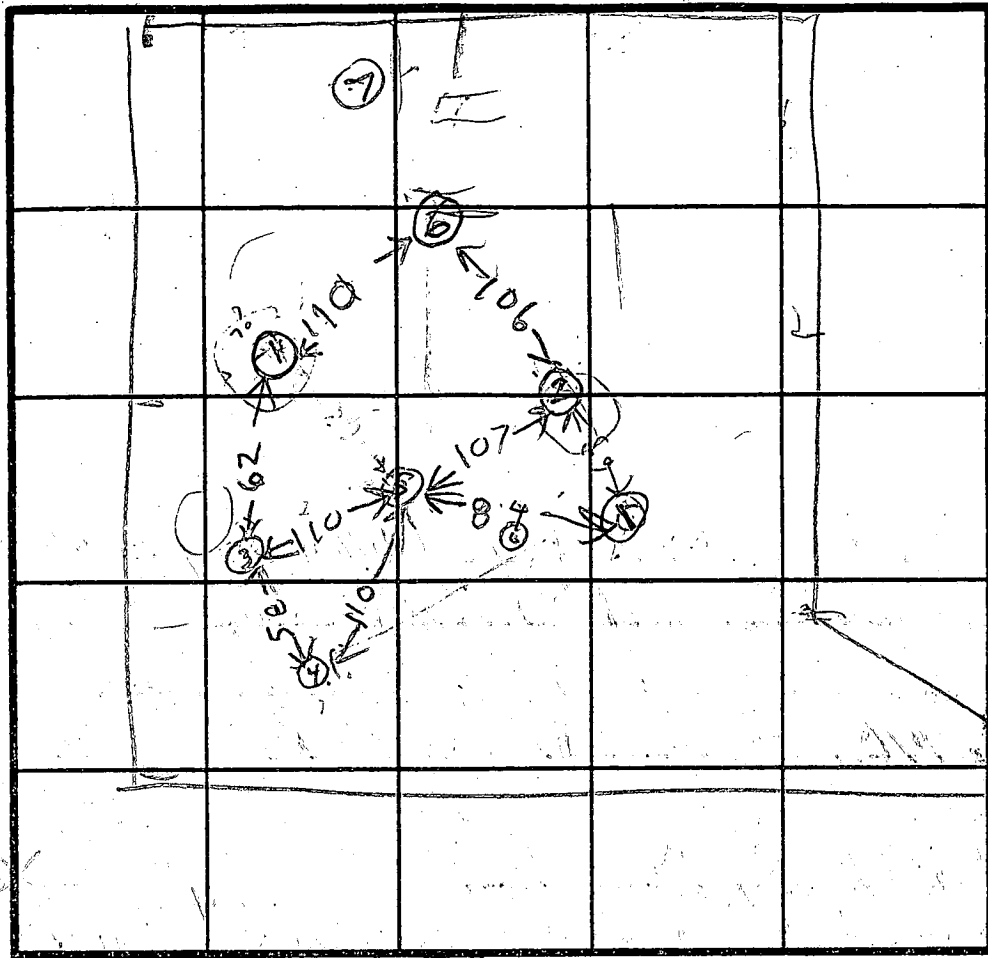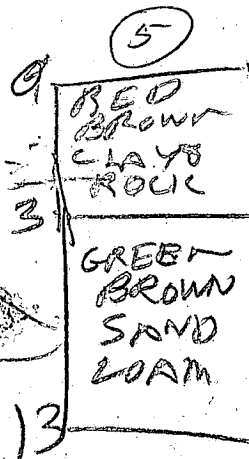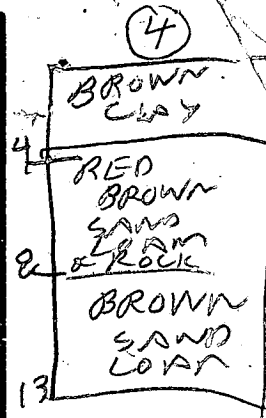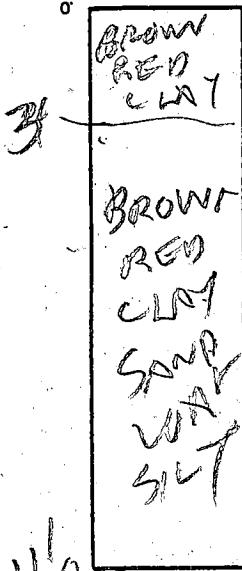

INDICATE NORTH - NAME ADJOINING ROADWAY AS BASE LINE.

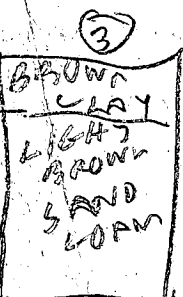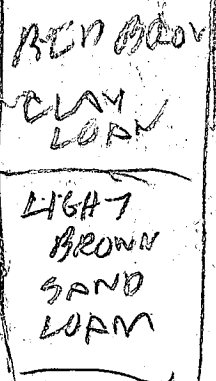

DATE	TEST NO.	DEPTH	PRE-WET		TEST - 1" DROP		TIME	
			START	STOP	START	STOP		
8/22/86	1S	4	304	309	309	317	8	
	1D	7	306	332	332	401	29	
8/11/86	1V	1 1/2	OK	11.5	2			
	2S	4	308	348	348	401	9	
	2V	13	OK	BELOW	5 1/2	17		
	3S	4	326	334	334	358	24	
	3V	11.5	OK					
	4S	6 1/2	328	330	330	335	5	
	4V	13 1/2	OK					
	5V	13	OK					
	2M	5 1/2	400	407	407	419	12	
	6V	7	ROCK & CLAY					
	7V	5	ROCK & CLAY					

401
332
9
max depth
3 ft
at time
16 min
8/18/86
R.H.

REMARKS

7/23/86 - 3 ROCK & CLAY HOLES DUG BUT NOT MEASURED TODAY

TYPE OF SOIL

OTHER HOLE DUG DIFFERENT

TESTED BY

R HODGER

ALSO PRESENT

Z KETERMAN

06.93	807,685.22
17.19	807,113.44
22.81	806,582.21
92.08	807,734.64
50.64	808,090.23
27.22	807,709.95
63.83	807,603.30
95.02	807,530.74
42.90	807,443.07
90.76	807,282.42
92.93	807,262.12
29.52	807,282.70
43.20	807,297.85
95.34	807,458.50
58.74	807,565.15
27.55	807,637.71
79.67	807,725.38
03.08	808,105.66

NOTES SHOWN HEREON ARE
 THE MARYLAND STATE PLANE COORDINATE
 SYSTEM AS PROJECTED BY HOWARD
 CONTROL STATION NOS. 3235001,
 335001.


DATE OF FINAL PLAT
 (SHEET ONLY)

NUMBER OF LOTS AND/OR
 TO BE RECORDED: 10

AREA OF LOTS AND/OR
 TO BE RECORDED: 34.9597 AC.

AREA OF ROADWAYS TO
 BE RECORDED INCLUDING WIDENING
 1.2628 AC.

AREA OF SUBDIVISION TO
 BE RECORDED: 36.2225 AC.

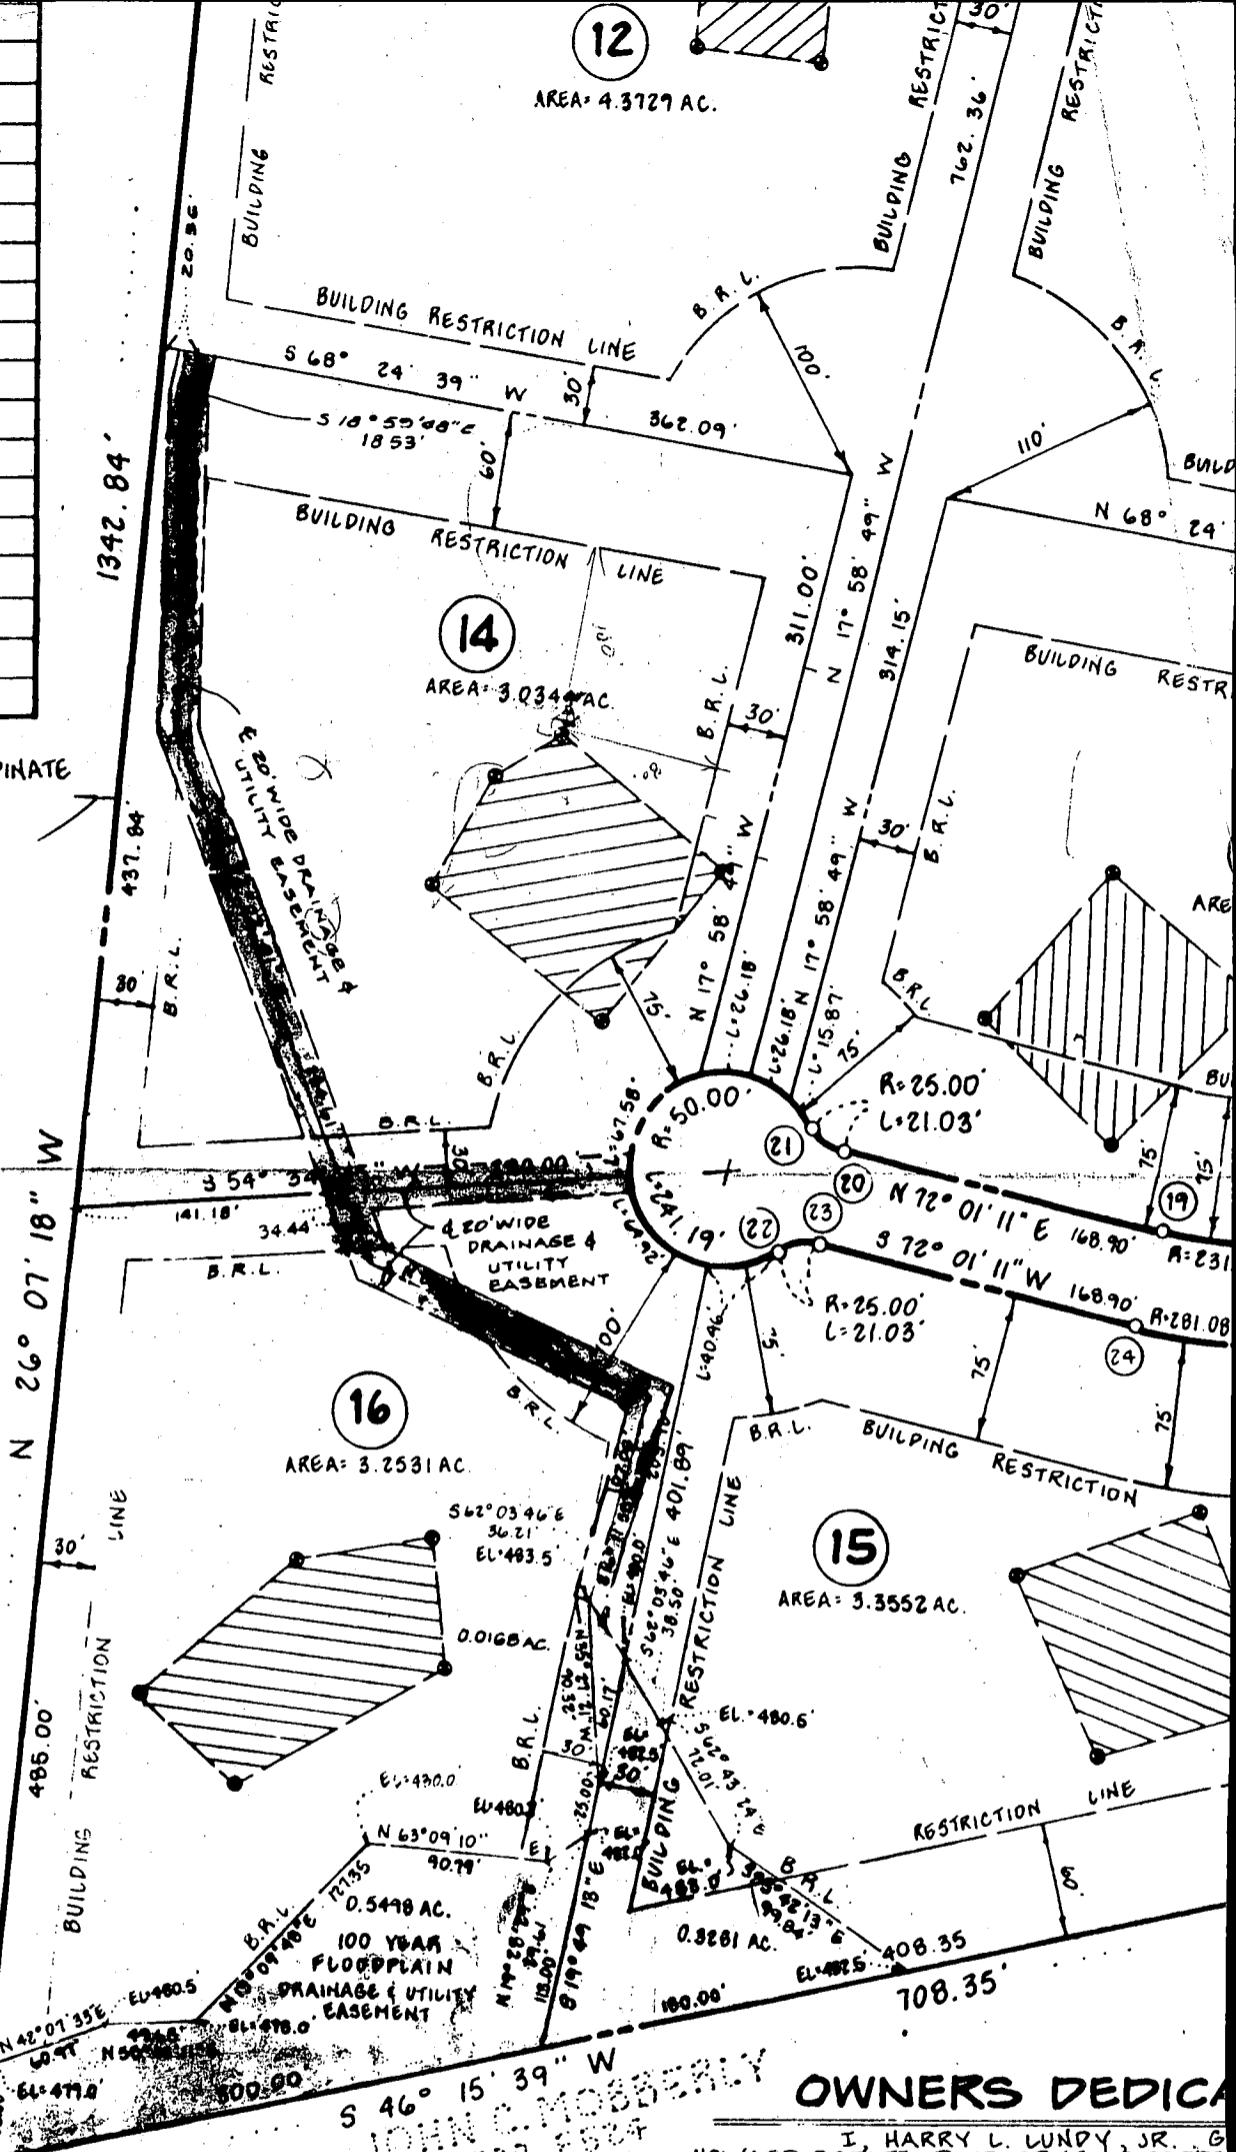

OWNERS DEDICATION

I, HARRY L. LUNDY, JR. OF
 HOWARD ESTATE DEVELOPMENT CORP.
 SHOWN HEREON AND DESCRIBED IN THE SURVEYORS CERTIFICATE
 SUBDIVISION AND IN CONSIDERATION OF THE APPROVAL OF THE
 OFFICE OF PLANNING AND ZONING, ESTABLISH THE BOUNDARIES
 LINES AND GRANT UNTO HOWARD COUNTY, MARYLAND, THE RIGHT TO
 ASSIGNS, (1) THE RIGHT TO LAY, CONSTRUCT, MAINTAIN, REPAIR AND
 WATERPIPES AND OTHER MUNICIPAL UTILITIES AND ROADS AND STREET
 ROADS AND STREET RIGHT OF WAYS AND THE SPACE THEREON; (2) THE
 HEREON; (3) THE RIGHT TO REQUIRE DEDICATION FOR THE CONSTRUCTION,
 STREETS AND/OR ROADS AND FLOODPLAINS AND OPEN SPACE WHERE
 AND FOR GOOD AND OTHER VALUABLE CONSIDERATIONS, THE RIGHT
 OPTION TO HOWARD COUNTY TO ACQUIRE THE RIGHTS OF THE
 THE STREETS AND/OR ROADS AND FLOODPLAINS, OPEN SPACE WHERE
 APPLICABLE; (3) THE RIGHT TO REQUIRE DEDICATION FOR THE
 OF WATERWAYS AND DRAINAGE EASEMENTS AND OTHER VALUABLE
 THEIR CONSTRUCTION, REPAIR AND MAINTENANCE OF ANY KIND
 OR SIMILAR STRUCTURE OF ANY KIND SHALL BE THE RESPONSIBILITY
 SAID EASEMENTS AND RIGHT OF WAYS.

APPROVED: FOR PRIVATE WATER & SEWERAGE SYSTEMS
 HOWARD COUNTY HEALTH DEPARTMENT.

[Signature]
 COUNTY HEALTH OFFICER
 DATE: 3/10/89

APPROVED: HOWARD COUNTY OFFICE OF PLANNING & ZONING
[Signature]
 DIRECTOR
 DATE: 3.22.89

APPROVED: FOR STORM DRAINAGE SYSTEMS & PUBLIC ROADS,
 HOWARD COUNTY DEPARTMENT OF PUBLIC WORKS.

WITNESSED MY HAND

APPLICATION

HOWARD COUNTY

SERIAL NUMBER

43707

PERMIT APPLICATION

DEPARTMENT OF INSPECTIONS, LICENSES & PERMIT
3430 COURT HOUSE DRIVE, ELLICOTT CITY, MARYLAND 21043

BUILDING ADDRESS (HOUSE NO., STREET, TOWN OR AREA)

3226 Regent Row

GRADING/SEDIMENT CONTROL YES NO

SDP #

DESCRIPTION OF WORK AUTHORIZED

Construction of a two story
single family home, frame
construction with brick veneer
attached 2 car garage
4 BR

LOT NO.	PARCEL NO.	SEC.	AREA	BLOCK NO.	LIBER	FOLIO
14	548	1		3	2552	0555

SUB DIVISION	ZONE	ZONE MAP	ELEC. DIST.	CENSUS TR.
	R	22		6030

OWNER NAME AND ADDRESS: Robert G. Spickard
11815 Court House Dr
Ellicott City, MD
PHONE NO.: 937-2129
(W-937-8288)

OCCUPANT'S NAME AND ADDRESS: _____ PHONE NO.: _____

SIZE OF BLDG.	FRONT	DEPTH	HEIGHT
	57'	70'	2 1/2' 30"

TYPE OF BLDG.	AREA	VOLUME	ROOF
B. ROOMS 1			
ROOMS			
BATHS			
FIREPLACES			

FOOTINGS	FOUNDATION	S. WALLS

UTILITIES					
WATERWELL	SEWER/SEPTIC	GAS	ELECTRICITY	TYPE OF HEAT	AC

I have carefully examined and read this application and know the same is true and correct, and that in doing this work, all provisions of Howard County Ordinances and the State Laws of Maryland will be complied with, whether specified or not; and I will notify the Department of Inspections, and Permits twenty-four hours in advance when I am ready for the inspections called for elsewhere in the application; and that no work will be covered up until such inspections have been completed with.

owner
SIGNATURE: _____
DATE: 6-15-92

USE ONLY

FUNCTION	DATE	SIGNATURE APPROVAL
ZONING/PLANNING	X	
SHA	X	
SEDIMENT/GRADING		
BUILDING OFFICIAL	X	
WATER & SEWER		
HEALTH DEPT.	X 6/24/92	Craig Wilke
FIRE PROTECTION		
STORM WATER MGM	X	

APPROVED _____ DATE _____

Distribution of Copies:
 White - Building Official
 Green - Planning & Zoning
 Yellow - Engineering
 Pink - Health Dept.
 Gold - S.H.A.

Howard County Health Department

To: INSPECTIONS OFFICE

BP 43707
3226 REGENTS ROW

PLEASE NOTIFY HEALTH DEPT
(313-2640)
AT TIME OF FOOTING INSP.


From: Craig Wilke

Date: 6/24/92

HD-170

90
27

9/25 of as shown
C.B.D

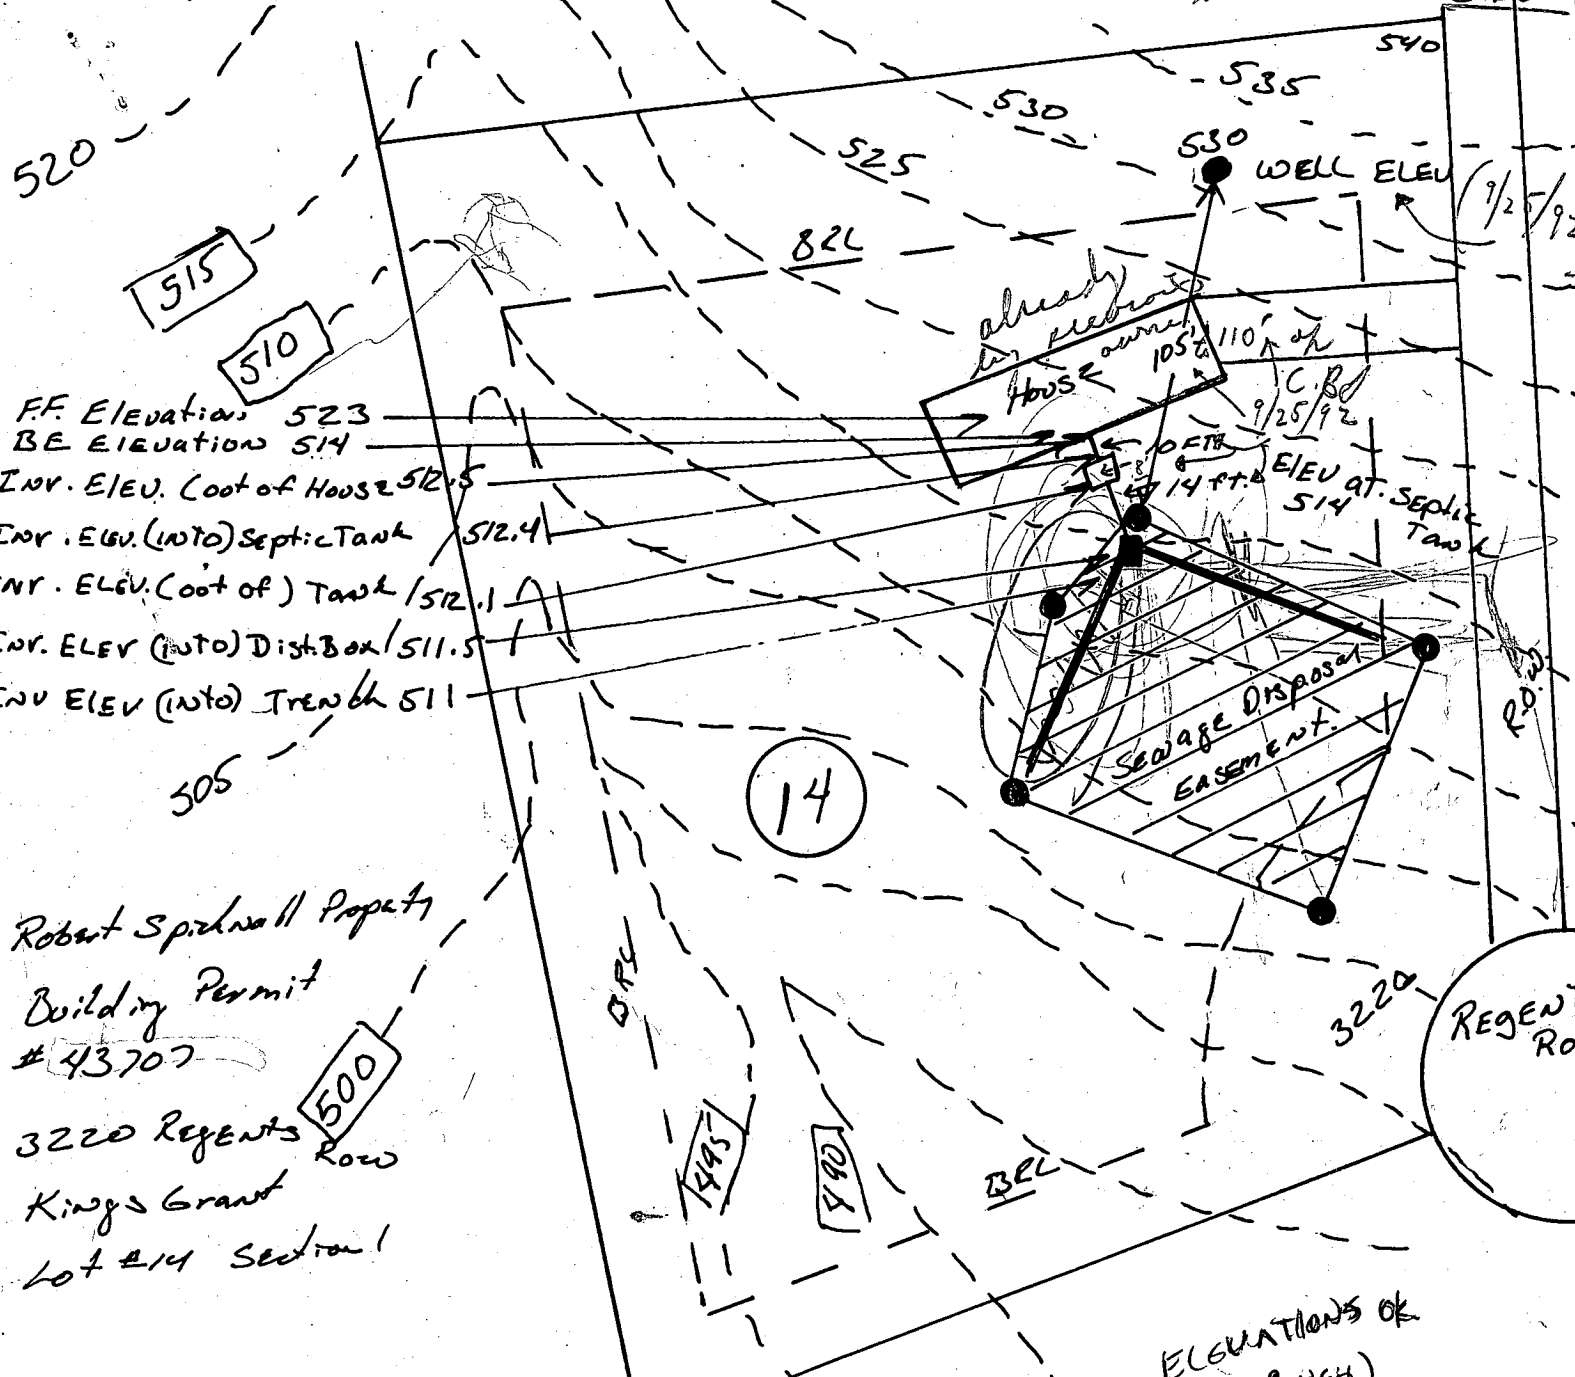

F.F. ELEVATION 523
 B.E. ELEVATION 514
 INV. ELEV. (OOT OF HOUSE) 512.5
 INV. ELEV. (INTO) SEPTIC TANK 512.4
 INV. ELEV. (OOT OF) TANK 512.1
 INV. ELEV. (INTO) DIST. BOX 511.5
 INV. ELEV. (INTO) TRENCH 511

Robert Spitznall Property
 Building Permit
 # 43707
 3220 Regents Row
 Kings Grant
 Lot #14 Section 1

ELEVATIONS OK
 (BUT ROUGH)
 SEPTIC LAYOUT IN DP
 REQUESTED PRIOR TO
 FORMAL INSP.
 6/27/92 CWL

I certify that the above measurements are accurate and correct for this property

Signed Robert Spitznall (Mr. Rick Bldg)

C1 6691

SEQUENCE NO. (DENY USE ONLY)

STATE OF MARYLAND WELL COMPLETION REPORT

THIS REPORT MUST BE SUBMITTED WITHIN 45 DAYS AFTER WELL IS COMPLETED.

(THIS NUMBER IS TO BE PUNCHED IN COLS. 3-6 ON ALL CARDS)

COUNTY NUMBER A 36604

DATE Received

DATE WELL COMPLETED

Depth of Well

PERMIT NO. FROM "PERMIT TO DRILL WELL"

8 13

15 20 050389

22 26 400 (TO NEAREST FOOT)

28 37 10-88-0365

OWNER HOWARD EST. DEVI last-name REGENTS COURT first name TOWN CLEVELG SUBDIVISION KINGS COURT SECTION LOT 14

WELL LOG Not required for driven wells STATE THE KIND OF FORMATIONS PENETRATED, THEIR COLOR, DEPTH, THICKNESS AND IF WATER BEARING

Table with columns: DESCRIPTION, FEET (FROM, TO), Check if water bearing. Rows include Top soil, Shale, Brown Mica, Green mica, Grey mica, Brown M. ca, Grey Mica.

GROUTING RECORD WELL HAS BEEN GROUTED (Circle Appropriate Box) TYPE OF GROUTING MATERIAL CEMENT CM BENTONITE CLAY BC NO. OF BAGS 10 NO. OF POUNDS 1000 GALLONS OF WATER 50 DEPTH OF GROUT SEAL (to nearest foot) from 0 ft. to 37 ft.

CASING RECORD casing types insert appropriate code below MAIN Nominal diameter CASING top (main) casing TYPE (nearest inch) Total depth of main casing (nearest foot)

OTHER CASING (if used) diameter inch depth (feet) from to

SCREEN RECORD screen type or open hole insert appropriate code below

DEPTH (nearest ft.) 1 2 3 100

CIRCLE APPROPRIATE LETTER A WELL WAS ABANDONED AND SEALED WHEN THIS WELL WAS COMPLETED E ELECTRIC LOG OBTAINED P TEST WELL CONVERTED TO PRODUCTION WELL

I HEREBY CERTIFY THAT THIS WELL HAS BEEN CONSTRUCTED IN ACCORDANCE WITH COMAR 10.17.13 "WELL CONSTRUCTION" AND IN CONFORMANCE WITH ALL CONDITIONS STATED IN THE ABOVE CAPTIONED PERMIT, AND THAT THE INFORMATION PRESENTED HEREIN IS ACCURATE AND COMPLETE TO THE BEST OF MY KNOWLEDGE.


DRILLERS IDENT. NO. 46 DRILLERS SIGNATURE SITE SUPERVISOR (sign. of driller or journeyman responsible for sitework if different from permittee)

SLOT SIZE 1 2 3 DIAMETER OF SCREEN (NEAREST INCH) GRAVEL PACK IF WELL DRILLED WAS FLOWING WELL INSERT F IN BOX 68

TELESCOPE CASING LOG INDICATOR OTHER DATA

PUMPING TEST HOURS PUMPED (nearest hour) 3 PUMPING RATE (gal. per min. to nearest gal.) 20 METHOD USED TO MEASURE PUMPING RATE Pressure WATER LEVEL (distance from land surface) BEFORE PUMPING: 20 WHEN PUMPING 134 TYPE OF PUMP USED (for test) C centrifugal R rotary O other (describe below) J jet S submersible

PUMP INSTALLED DRILLER WILL INSTALL PUMP YES (NO) IF DRILLER INSTALLS PUMP, THIS SECTION MUST BE COMPLETED FOR ALL WELLS EXCEPT HOME USE TYPE OF PUMP INSTALLED PLACE (A,C,J,P,R,S,T,O) IN BOX - SEE ABOVE: CAPACITY: GALLONS PER MINUTE (to nearest gallon) PUMP HORSE POWER PUMP COLUMN LENGTH (nearest ft.) CASING HEIGHT (circle appropriate box and enter casing height) LAND SURFACE (nearest foot)

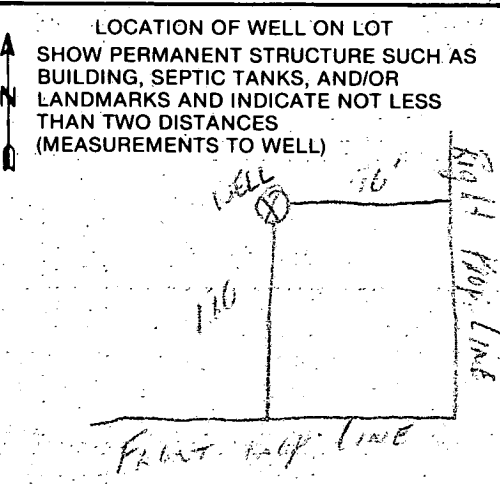

B 1 **7816** SEQUENCE NO. (DP USE ONLY)
 (THIS NUMBER IS TO BE PUNCHED IN COLS 3-6 ON ALL CARDS)

STATE OF MARYLAND
 PERMIT TO DRILL WELL
 please print or type

STATE PERMIT NUMBER
HO-88-0265
 fill in this form completely

Date Received (APA) **121988**
 OWNER INFORMATION
 15 Last Name **Hester** Owner First Name **David**
 36 Street or RFD **PO Box 1018**
 57 Town **Columbia** 70 State **MD** 72 Zip **21044**

B 3 LOCATION OF WELL **R-43207**
 8 COUNTY **Howard** 21
 23 SUBDIVISION **KING'S GRANT** 42
 SECTION **44** 46 LOT **14** 48 50
 52 NEAREST TOWN **Glenchey** 71
 MILES FROM TOWN (enter 0 if in town) **1** 73 **M** 76 **I** 77 **I** 78

DRILLER INFORMATION
George Easterday
 Driller's Name **L.P. Easterday, Inc.** 77 License No. **46** 80
 Firm Name **9265 Brown Church Rd., Mt. Airy, Md. 21771**
 Address **George Easterday** 12-588
 Signature Date

B 4 DIRECTION OF WELL FROM TOWN (CIRCLE BOX)

 NEAR WHAT ROAD **Regents Row**
 ON WHICH SIDE OF ROAD (CIRCLE APPROPRIATE BOX)
 NORTH WEST EAST SOUTH
 34 **265** 37 DISTANCE FROM ROAD
 ENTER FT or MI

B 2 WELL INFORMATION
 APPROX. PUMPING RATE (GAL. PER MIN.) **5** 8 12
 AVERAGE DAILY QUANTITY NEEDED (GAL. PER DAY) **500** 14 20

NOT TO BE FILLED IN BY DRILLER HEALTH DEPARTMENT APPROVAL
HOWARD COUNTY NAME **R-36604** COUNTY NO.
 STATE SIGNATURE _____ INSERT S
 DATE ISSUED **122388** 43 48 CO SIGNATURE **Charles...** 6/23/89 41
 NORTH GRID **527000** 50 55 EAST GRID **0807000** 57 63

USE FOR WATER (CIRCLE APPROPRIATE BOX)
 HOME (SINGLE OR DOUBLE HOUSEHOLD UNIT ONLY)
 FARMING (LIVESTOCK WATERING & AGRICULTURAL IRRIGATION)
 INDUSTRIAL, COMMERCIAL, STATE AND FEDERAL GOV. OTHER (REQUIRES APPROPRIATION PERMIT)
 PUBLIC OR PRIVATE WATER COMPANY (REQUIRES APPROVAL PERMIT AND STATE HEALTH DEPARTMENT APPROVAL)
 TEST, OBSERVATION, MONITORING (MAY REQUIRE APPROPRIATION PERMIT)

APPROXIMATE DEPTH OF WELL **500** 24 28 FEET

APPROXIMATE DIAMETER OF WELL **6** NEAREST INCH

METHOD OF DRILLING (circle one)
 BORED (or Augered) JETTED Jetted & DRIVEN
 AIR-ROTary AIR-PERcussion ROTARY (Hydraulic Rotary)
 CABLE REVerse-ROTary DRive-POINT
 other _____

SHOW MAJOR FEATURES OF BOX & LOCATE WELL WITH AN X
 SOURCES OF DRILLING WATER
 1. **well**
 2.
 3.
 WRITE THE BOX NUMBER FROM THE MAP HERE

 000
 000

REPLACEMENT OR DEEPEMED WELLS (CIRCLE APPROPRIATE BOX)
 THIS WELL WILL NOT REPLACE AN EXISTING WELL
 THIS WELL WILL REPLACE A WELL THAT WILL BE ABANDONED AND SEALED
 THIS WELL WILL REPLACE A WELL THAT WILL BE USED AS A STANDBY
 THIS WELL WILL DEEPEM AN EXISTING WELL
 PERMIT NUMBER OF WELL TO BE REPLACED OR DEEPEMED (IF AVAILABLE) 41 _____ 52

DRAW A SKETCH BELOW SHOWING LOCATION OF WELL IN RELATION TO NEARBY TOWNS AND ROADS AND GIVE DISTANCE FROM WELL TO NEAREST ROAD JUNCTION


 DEC 8
 300 W. 88
 335 W. 88
 Trade...

Not to be filled in by driller (OEP USE ONLY)
 APPROP. PERMIT NUMBER _____ GAP _____ 54 63
 FORCE **CM** WRITE INITIALS IN BOX PERMIT No. **HO-88-0365** 70 71 72 73 74 75 76 77 78 79

SPECIAL CONDITIONS

All topography is based upon Howard County aerial topography and must be field verified prior to construction

15" DIAMETER CULVERTS TO BE PLACED AT DRIVEWAY ENTRANCE PER STD.DETAIL R-6.06

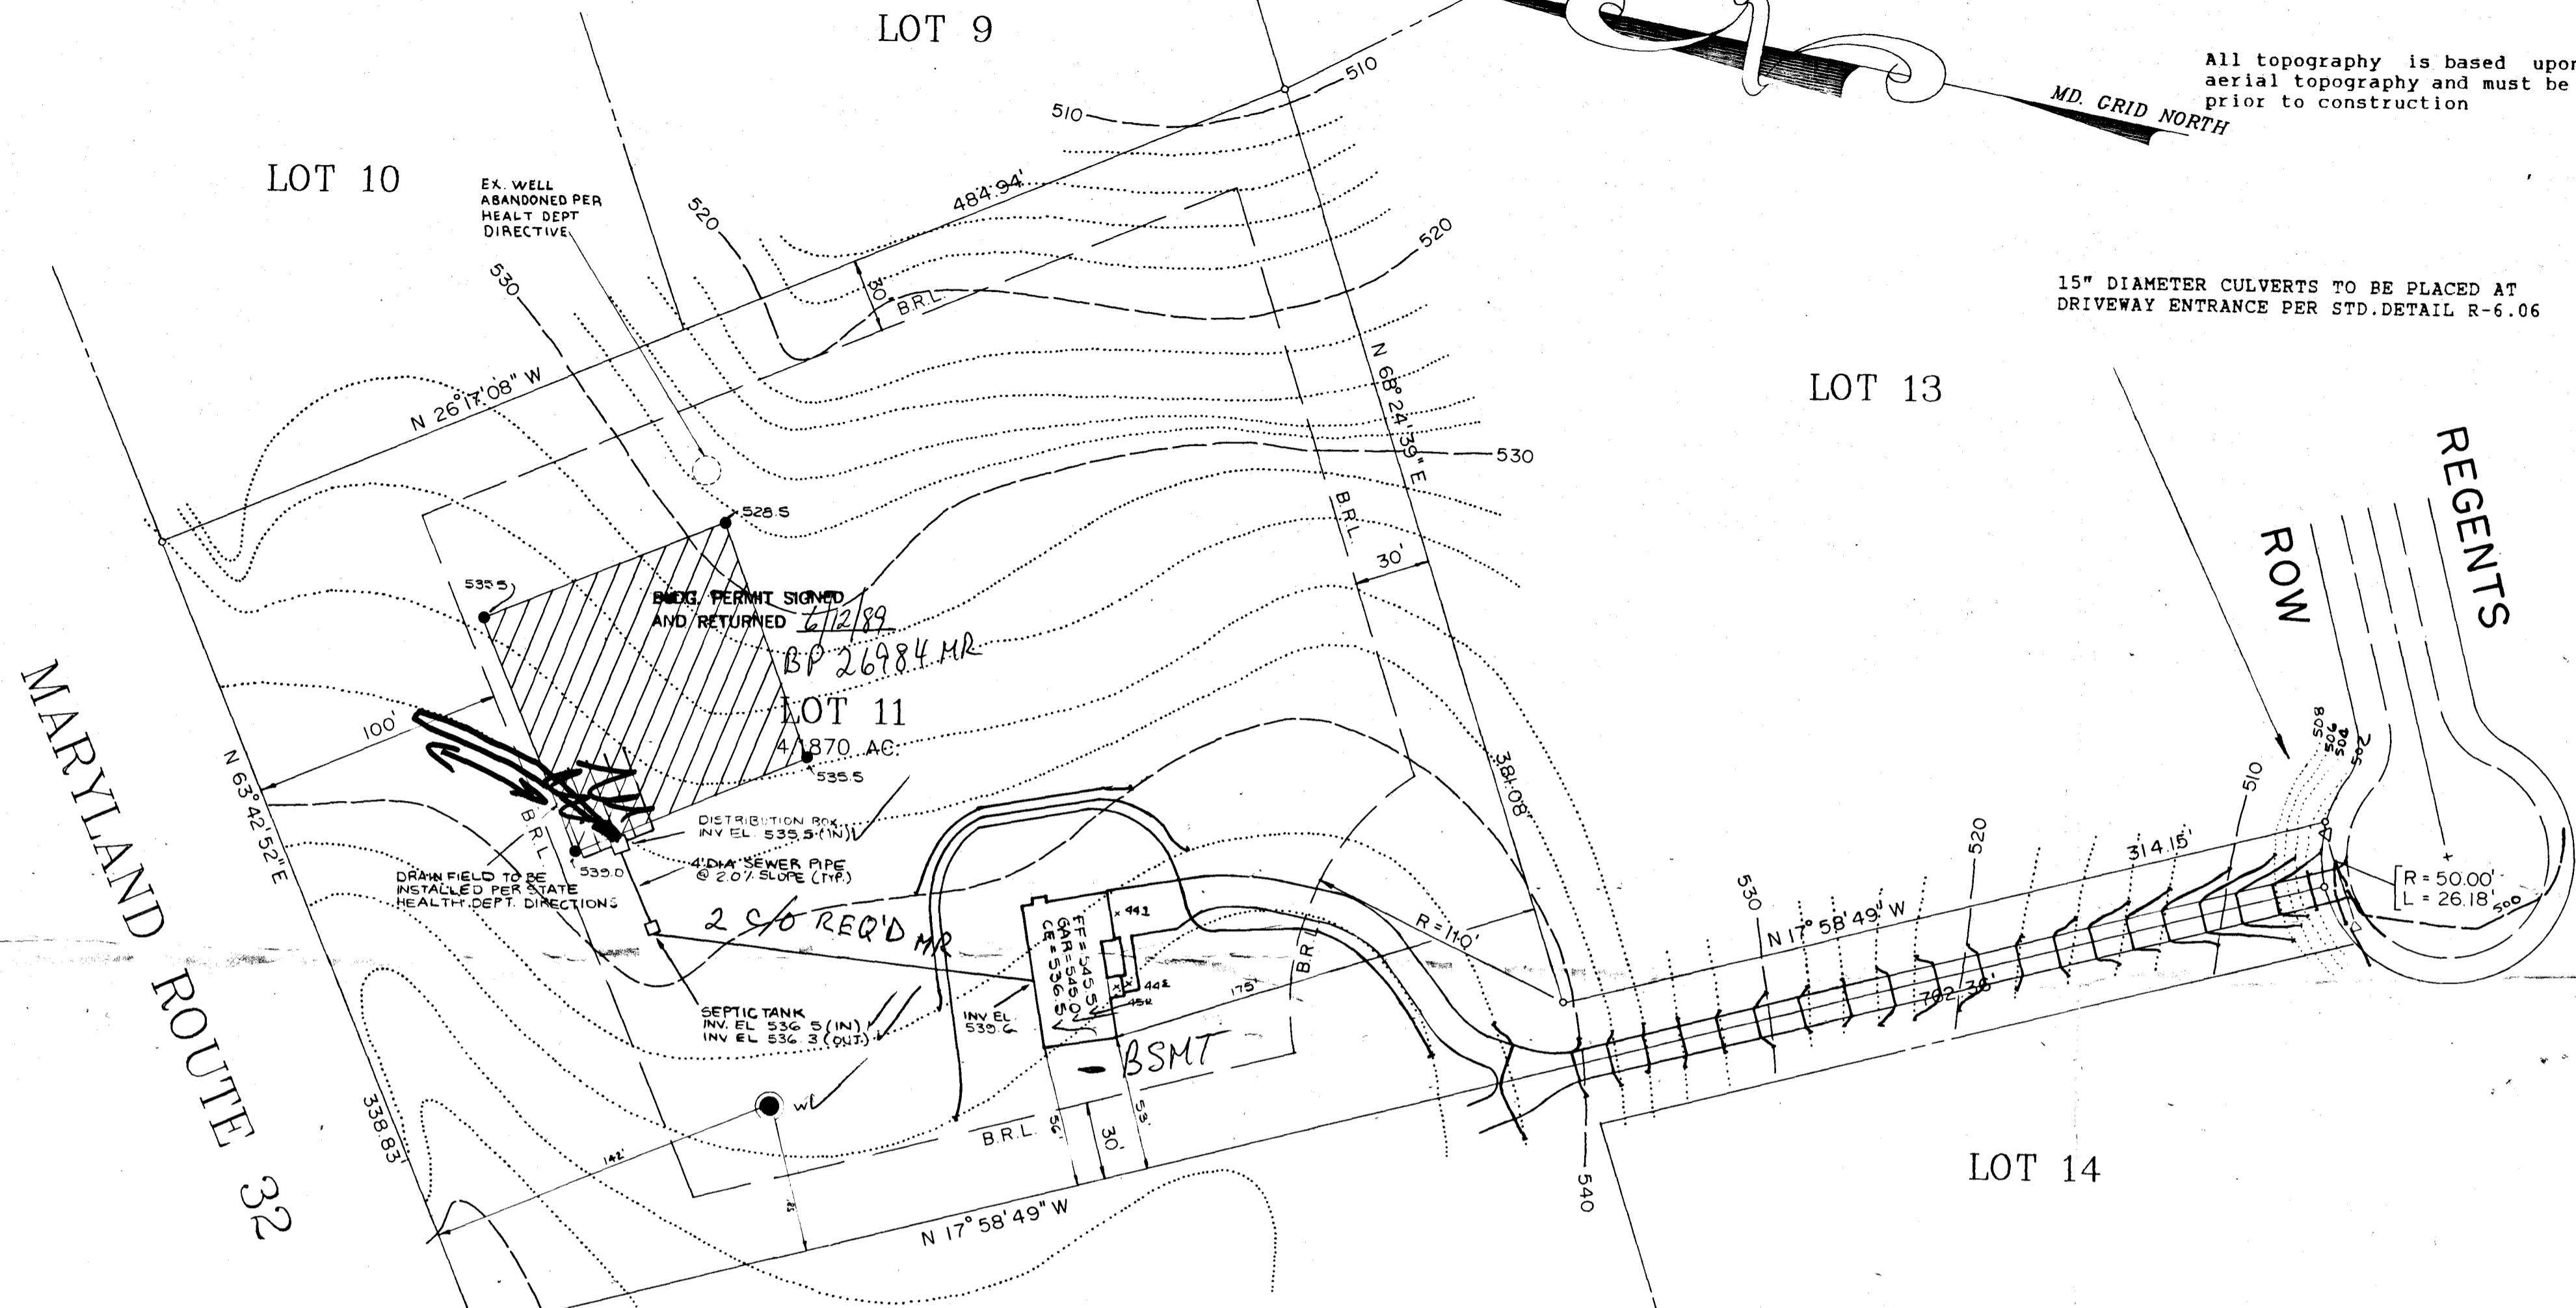

MARYLAND ROUTE 32

REGENTS
RON


PLOT PLAN
KINGS GRANT
SECTION ONE
LOT 11 / TYPE 'D'

ZONED : R F 89-107
TAX MAP : 22 PARCEL : 7
THIRD ELECTION DISTRICT
HOWARD COUNTY, MARYLAND.

I CERTIFY THAT ALL MEASUREMENTS AND ELEVATIONS ARE CORRECT FOR THIS PROPERTY.



David C. Wilson

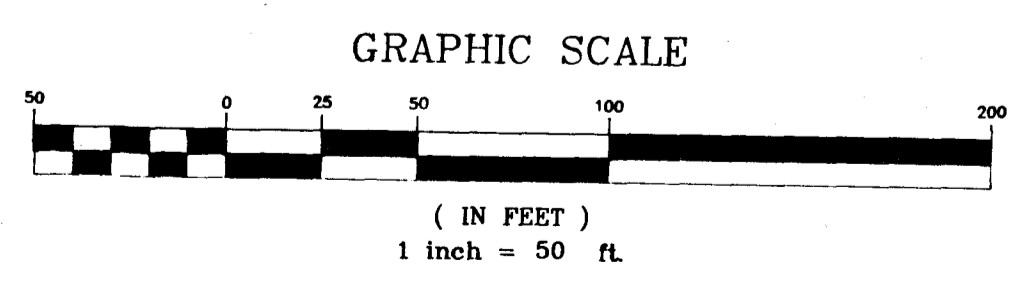

OWNER / DEVELOPER
WILLIAMSBURG BUILDERS
P.O. BOX 1018
COLUMBIA, MD. 21044
(301) 997 8800

PREPARED BY :
AMERICAN ENGINEERING, INC.
609-B MAIN STREET LAUREL, MARYLAND 20707
BALTO. (301) 880 3039
WASH. (301) 953 1221

DATE: 5-81	SCALE: 1"=50'	DWG. BY:	CHK BY:	SHT. OF
------------	---------------	----------	---------	---------