

# APPLICATION

SEWAGE DISPOSAL TESTING

STATE OF MARYLAND - DEPARTMENT OF HEALTH AND MENTAL HYGIENE

A 31172  
P \_\_\_\_\_

HOWARD COUNTY HEALTH DEPARTMENT  
ENVIRONMENTAL HEALTH SERVICES  
P O BOX 476 ELLICOTT MARYLAND 21043  
TELEPHONE 992-2330

DISTRICT 5th Elec. Dist.

DATE 2-17-81

TO THE COUNTY HEALTH OFFICER  
ELLICOTT CITY MARYLAND

I HEREBY APPLY FOR THE NECESSARY TEST IN ORDER TO CONSTRUCT (OR RECONSTRUCT) A SEWAGE DISPOSAL SYSTEM

PROPERTY OWNER Ms. Corraine D. Hebb/c/o Edward Kasemeyer LEE Applerback

ADDRESS 9051 Baltimore National Pike PHONE 992-0213  
Ellicott City, Maryland 21043 (301) 465-7474

PROPERTY LOCATION

SUBDIVISION Chapel Chase LOT NO. 22 A-5

ROAD AND DESCRIPTION Linden Church Road Off of Maryland Route 32  
(12731 Chapel Chase Drive)

SIZE OF LOT 3.01 Acres TYPE BLDG Single-Family Detached

THE SYSTEM INSTALLED UNDER THIS APPLICATION IS ACCEPTABLE ONLY UNTIL PUBLIC FACILITIES BECOME AVAILABLE.

I FULLY UNDERSTAND THE FEE CONNECTED WITH THE FILING OF THIS PERC TEST APPLICATION IS NON-REFUNDABLE UNDER ANY CIRCUMSTANCES.

SIGNATURE OF APPLICANT [Signature] BLDG. PERMIT SIGNED AND RETURNED 6/06/81  
Serial # 53877-3FD-4Bm

APPROVED BY \_\_\_\_\_ FOR \_\_\_\_\_ DATE \_\_\_\_\_

REJECTED BY \_\_\_\_\_ FOR \_\_\_\_\_ DATE \_\_\_\_\_

HOLD PENDING FURTHER TESTS \_\_\_\_\_ DATE \_\_\_\_\_

REASONS FOR REJECTION OR HOLDING 3/13/81 HOLD FOR MORE TESTS - 11/6/81  
LOW - THIS DATE ONLY. C.R.D. 3/12/81 MAKE TESTS


DING  
C.R.D.

# THIS IS NOT A PERMIT

New # A-5

FENCE T (CORN FIELD)

A-9

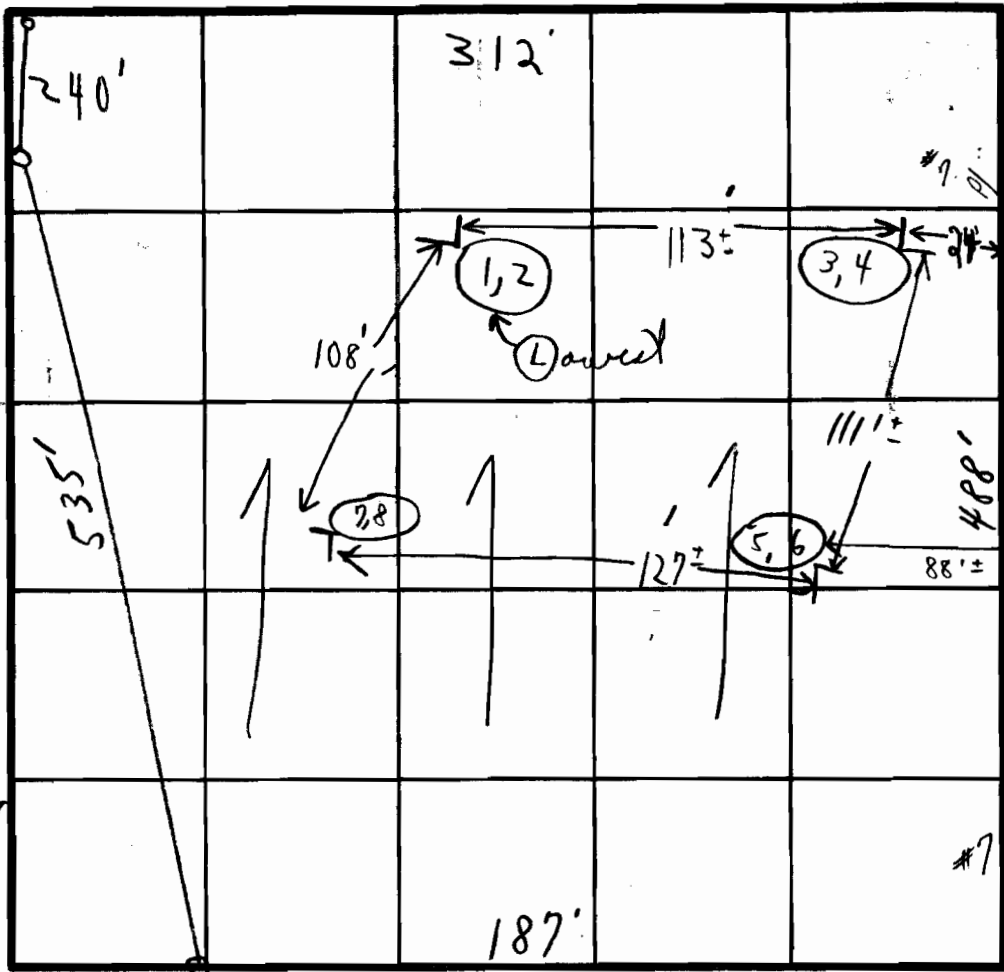

SOIL PROFILE



FIELD SHEET

INDICATE NORTH - NAME ADJOINING ROADWAY AS BASE LINE  
UN NAMED ROAD

SOIL PROFILE

	DATE	TEST NO	DEPTH	PRE-WET		TEST - 1" DROP		TIME
				START	STOP	START	STOP	
1' - 4 1/2' clay	3/17/81	1	4'	3:24	3:26	3:26	3:28	2m
4' loam 14'		2	14'		MICA + LOAM	4'-14'	DRY	
1' - 5 1/2" CLAY	3/19/81	3	5 1/2"	12:54	12:56	12:56	12:58	2m
5 1/2" - 14" LOAM		4	14'-10"	←	LOAM	→	→	
1' - 5 1/2" CLAY		5	5 1/2"	12:55	1:00	1:00	1:13	13m
5 1/2" - 14 1/2" LOAM		(H) 6	14 1/2"	←	LOAM	→	→	
4' CLAY		7	4"	12:56	12:57	12:57	12:59	2m
14' 8" LOAM		(H) 8	14'-8"	←	LOAM	→	→	4:19

NOTE SOME SMALL QUARTZ RICK 3'-4 1/2' 1 End only

Depth 4' Wood ground 4 1/2' 5 1/2' 5 min average

REMARKS: MACHINE - STOP PER J.A.D. HEAVILY BACK FILLED HOLES WOODED LOT @ 3:30 HOLD FOR CERTIFIED HOLES

TYPE OF SOIL: [ 3/17/81 HOLES OPEN @ ARRIVAL ] (2) PERCS STAKED HIGHER THAN ORIGINAL-STAKE.

TESTED BY: C. B. [ ] ALSO PRESENT: J.A.D. + DIGGER