

11/30/86 APPROVED 11/31/86 RH 36356

Hoffman

PERMIT

SEWAGE DISPOSAL SYSTEM

MARYLAND STATE DEPARTMENT OF HEALTH

HOWARD COUNTY
BUREAU OF ENVIRONMENTAL HEALTH
461-9933

INDEXED

ELLICOTT CITY
DISTRICT 5ch
DATE 12/30/85

T. R. R. Plumbing & Heating, Inc.

IS PERMITTED TO INSTALL ALTER

ADDRESS 11974 Scribbleville Road, Pulton, MD 20759 PHONE 725-2392

SUBDIVISION Hedgerow ROAD 5418 Harris Farm Lane LOT 19A

PROPERTY OWNER Russell Christian Karen Caccia Duffy

ADDRESS _____

IF GARBAGE GRINDER IS USED INCREASE SEPTIC TANK CAPACITY BY 50% AND ABSORPTION AREA BY 25%.

GARBAGE GRINDER? YES _____ NO

SEPTIC TANK CAPACITY 1250 GALLONS NUMBER OF BEDROOMS 4

*Addition - Garage
BLDG PERMIT SIGNED
AND RETURNED 4/19/96
Serial # 62,224*

TRENCHES - 158 sq. ft. per bedroom. Trench to be 2 feet wide. Inlet 4 feet below original grade. Bottom maximum depth 9 feet below original grade. Effective area begins at 4 feet below original grade. 4 1/2 feet of stone below distribution pipe.

LOCATION: Start the trench 200 feet from the front 175 ft. lot line and 25 feet from the right 587 ft. lot line as seen when facing the lot from right-of-way. Run trench on contour toward left 613.01 ft. lot line as seen from right-of-way.

NOTE: No trench to exceed 100 feet in length. If more than one trench used, a distribution box is required. Call for inspection of trench(es) before and after gravel is installed. Provide 6" - 8" diameter cleanout and cap to grade or above of septic tank.

*1/2/86 - OK TO MAKE INLET 5 FT DEEP & ONLY
PUT IN 4 FT OF STONE*

*BLDG PERMIT SIGNED
AND RETURNED 5/18/86
Serial # 53578*

PLANS APPROVED BY B. Abel DATE 11/25/85

COVER NO WORK UNTIL INSPECTED AND APPROVED.

NEITHER THE HOWARD COUNTY COUNCIL NOR THE HEALTH DEPARTMENT IS RESPONSIBLE FOR THE SUCCESSFUL OPERATION OF ANY SYSTEM.

NOTE: IF TRENCH IS USED CALL FOR INSPECTION BEFORE AND AFTER PLACING GRAVEL IN TRENCH.

NOTE: NO DRY WELL SHALL EXCEED 18 FOOT IN DIAMETER. NO ABSORPTION TRENCH TO EXCEED 100 FEET IN LENGTH.

NOTE: ALL PIPE FROM HOUSE TO SEPTIC TANK MUST BE CAST IRON OR SCHEDULE 40 PVC OR ABS.

PERMIT VOID AFTER THREE YEARS

NOTE: INSTALL STAND PIPE ON SEPTIC TANK AND DRY WELL. STAND PIPES MUST BE 6 INCHES IN DIAMETER. CAST IRON, COPPER, OR TERRA COTTA OR PVC OR ABS ACCEPTED. IF TOP OF SEPTIC TANK IS DEEPER THAN 3 FEET MANHOLE TO GRADE REQUIRE _____

***INSTALLER IS RESPONSIBLE FOR OBTAINING FINAL APPROVAL ON THIS PERMIT**

_____ FOR INSPECTION OF SEPTIC SYSTEMS.


*BLDG PERMIT SIGNED
AND RETURNED 4/18/01*

*Box 2966
CBS, IFB, HBS, 3BR Mobile Home Schultz model*

36356

191

22308

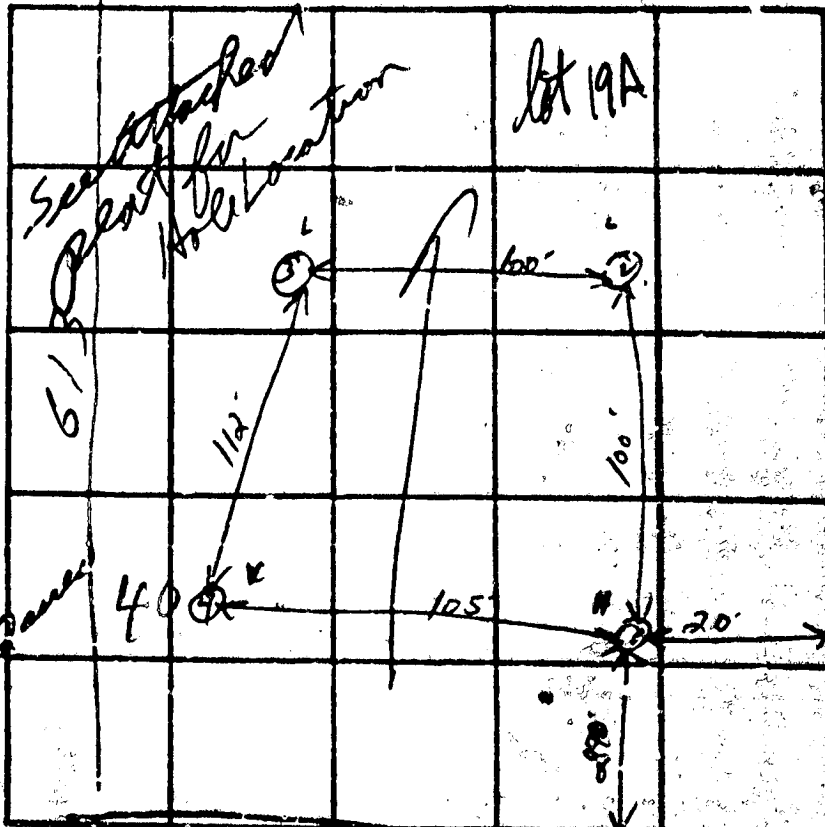

Lot 19A

61' 20' 44' 20'

Row

DATE	TEST NO.	DEPTH	PRE-WET		TEST - 1" DROP		TSS
			START	STOP	START	STOP	
11-25-75	15	4 1/2'	1140	1150	1150	1153	13
↑	10	13'	1140	1150	1150	1155	5
	25	23'	1144	1146	1146	1150	4
	20	12 1/2'	1145	1150	1150	1157	7
	30	5'	1155	1157	1157	1203	6
	30	12'	1155	1200	1200	1207	7
	4	11'	VISUAL	GOOD	AFTER	20' 5' CRUI	
✓							

NOTE - X

REMARKS _____

TYPE OF SOIL _____

TESTED BY HV - RM ALSO PRESENT: James

Property known as:

THIS PLAT CAN NOT BE USED TO ESTABLISH PROPERTY LINES OR CORNERS.

Lot 19A

Liber 2117 Folio 79

No. Co. Dept. of Public Works
Plat No. J-4078-66-1


8th Election District

Howard County, Md.



sp. records
Health Dept.
T.D. 700
4-13-94

Sept
system

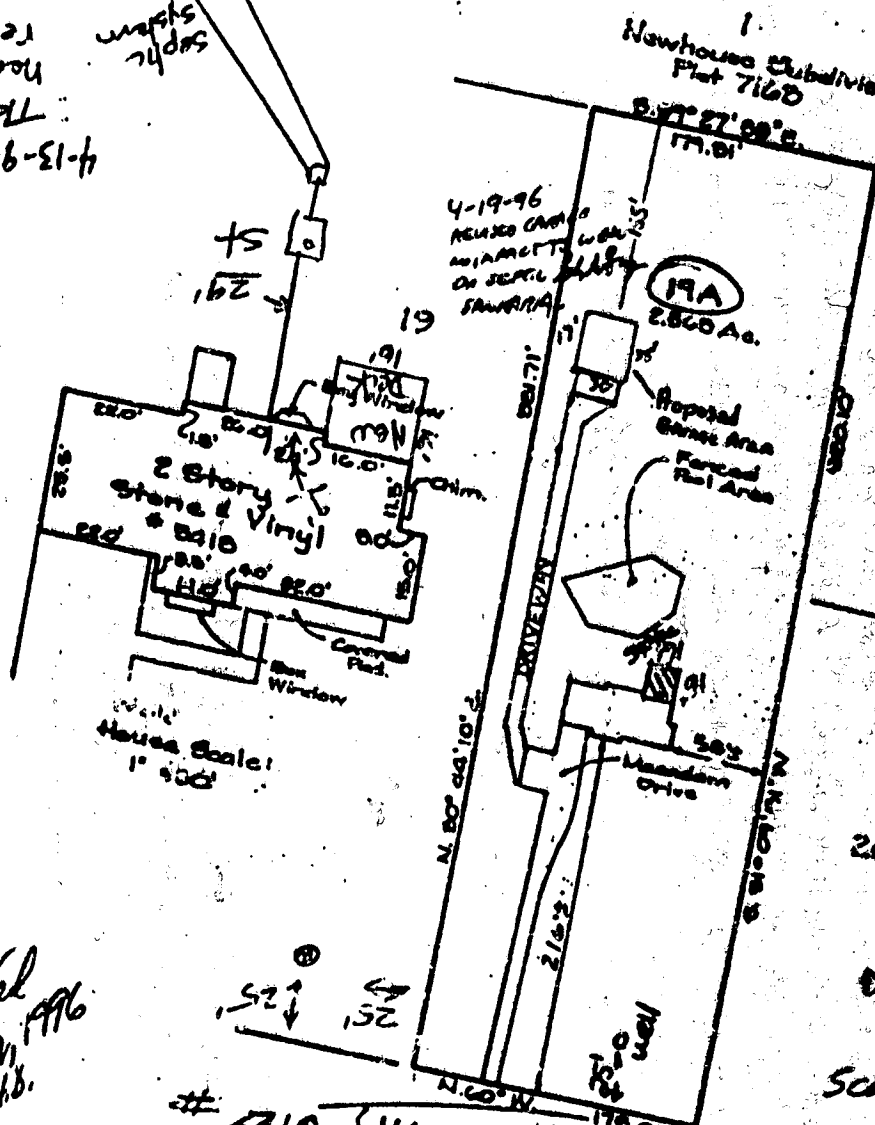

20B

20P

sell
D. Wayne Wilson


Scale 1" = 100'

and Dan G.
48-715-1070

Rec. - Received
Apr. 13, 1996
H.C., H.D.

5718 CHARRIS FARM LANE
80' R/W.

A
22308

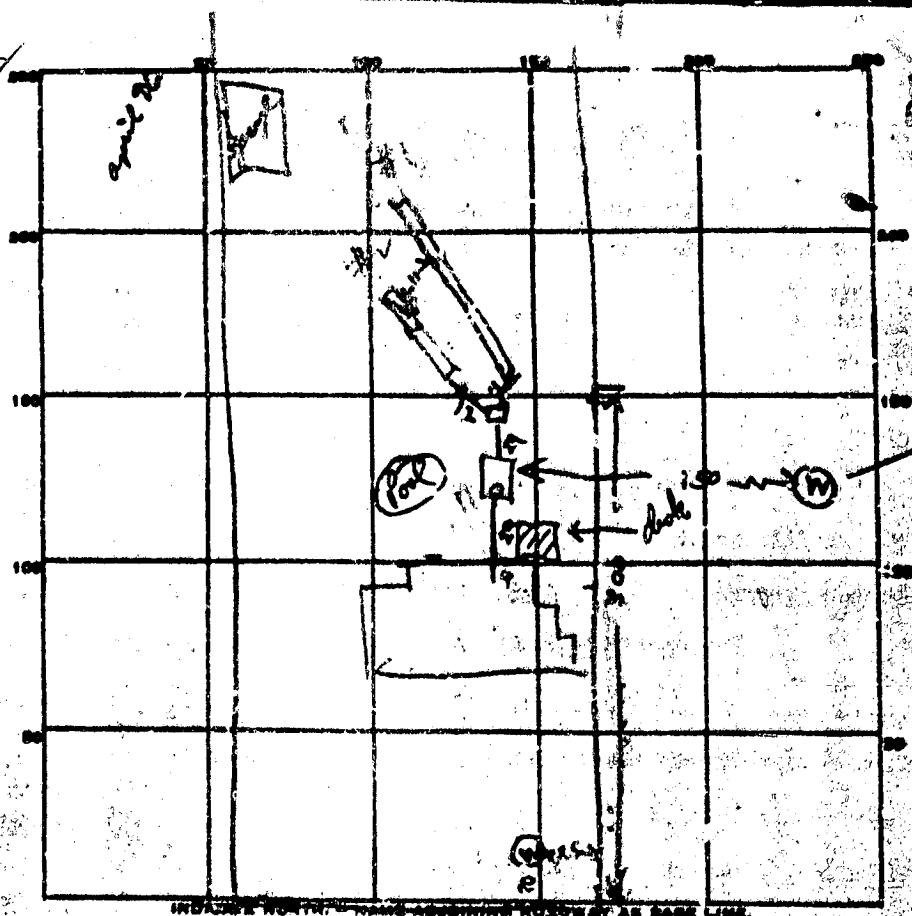

19A

WELL ON NEIGH LOT

5718 Harris Dr

PERMIT CARD _____

SEPTIC TANK LEVEL 12.50 CLEANOUTS 0/0

DISTRIBUTION BOX LEVEL 12.00 TANK TOP NOW ONLY 2 1/2 FT

TILE FIELD, DEPTH 9 FT. TRENCH WIDTH 2 FT.

	#1	#2	#1	#2	TOTAL
GRAVEL DEPTH	5	5	5	5	18
NUMBER OF TRENCHES	2		2		2
TOTAL LENGTH	65		103		168
TOTAL BOTTOM AREA	518		290		808

BEVERAGE PIT, INSIDE DIAMETER _____ FT. DEPTH BELOW INLET _____ FT.

ABSORBENT AREA _____ SQ. FT.

REMARKS: 1/2/86 - LOCATION OK PER PLAN. 1ST 65 FT OF FIRST TRENCH ON TANK SET. FINISH DIGGING TRENCH #1. VIG TRENCH #2. ADD STONE TO FIRST PART OF TRENCH #1. MANHOLE NEEDED ON TANK UNLESS GROUND CUT 1 FT OVER. 1/2/86 - DIG TRENCH #2 LOWER & ADD STONE TO BOTH TRENCHES. RE 1/3/86 TRENCH #2 NO LONGER BH 10/89. 63L SQ FT NEEDED. DOC INSTALLED. GROUND CUT NEAR T.

DATE SYSTEM APPROVED 1/3/86 INSPECTOR L. J. [Signature]