

3/12/86
9:30 AM

02-210894

approval
3/13/86 C Williams

153
5
790

PERMIT

SEWAGE DISPOSAL SYSTEM

MARYLAND STATE DEPARTMENT OF HEALTH

A REPAIR

73
11) 800
72
80

HOWARD COUNTY
BUREAU OF ENVIRONMENTAL HEALTH

81800

ELLICOTT CITY

~~462-9933~~
462-9933

INDEXED

DISTRICT _____

DATE 3/11/86

14
3
11

Bud Arnold IS PERMITTED TO INSTALL _____ ALTER

ADDRESS _____ PHONE 795-7873

SUBDIVISION _____ ROAD 3582 Church Road LOT _____

PROPERTY OWNER Ken Jahn

3582 Church Road

ADDRESS Ellicott City, Maryland 21043

IF GARBAGE GRINDER IS USED INCREASE SEPTIC TANK CAPACITY BY 50% AND ABSORPTION AREA BY 22%.

CITY WATER HERE

GARBAGE GRINDER? YES _____ NO _____

SEPTIC TANK CAPACITY 1500 GALLONS NUMBER OF BEDROOMS 5

REPAIR - CALL FOR INSPECTION WHEN GROUND IS OPENED UP SO SANITARIAN CAN RECOMMEND REPAIR.

TRENCH - 2 FT WIDE 14 FT DEEP 73 FT LONG
11 FT OF STONE (800 SQ FT SIDE WALL AREA ON ONE
SIDE OF TRENCH) START THE TRENCH AT A POINT
36 FT FROM THE CORNER OF THE HOUSE & 31 FT FROM
THE ELECTRIC POLE. RUN THE TRENCH AWAY FROM
THE HOUSE. RH

PLANS APPROVED BY C. Williams DATE 3/11/86

COVER NO WORK UNTIL INSPECTED AND APPROVED.

NEITHER THE HOWARD COUNTY COUNCIL NOR THE HEALTH DEPARTMENT IS RESPONSIBLE FOR THE SUCCESSFUL OPERATION OF ANY SYSTEM.

NOTE: IF TRENCH IS USED CALL FOR INSPECTION BEFORE AND AFTER PLACING GRAVEL IN TRENCH.

NOTE: NO DRY WELL SHALL EXCEED 15 FOOT IN DIAMETER. NO ABSORPTION TRENCH TO EXCEED 100 FEET IN LENGTH.

NOTE: ALL PIPE FROM HOUSE TO SEPTIC TANK MUST BE CAST IRON OR SCHEDULE 40 PVC OR ABS. **PERMIT SIGNED**

PERMIT VOID AFTER THREE YEARS.

AND RETURNED 3/18/86

NOTE: INSTALL STAND PIPE ON SEPTIC TANK AND DRY WELL. STAND PIPES MUST BE 6 INCHES IN DIAMETER. CAST IRON, CONCRETE OR TERRA COTTA, OR PVC OR ABS ACCEPTED. IF TOP OF SEPTIC TANK IS DEEPER THAN 3 FEET MANHOLE TO GRADE REQUIRED. 2 car garage


*INSTALLER IS RESPONSIBLE FOR OBTAINING FINAL APPROVAL ON THIS PERMIT

CALL 992-2330 FOR INSPECTION OF SEPTIC SYSTEMS.

EH - 2-1082

REPAIR
36644

①
 RED BROWN CLAY TOPSOIL
 BROWN TAN SAND LOAM

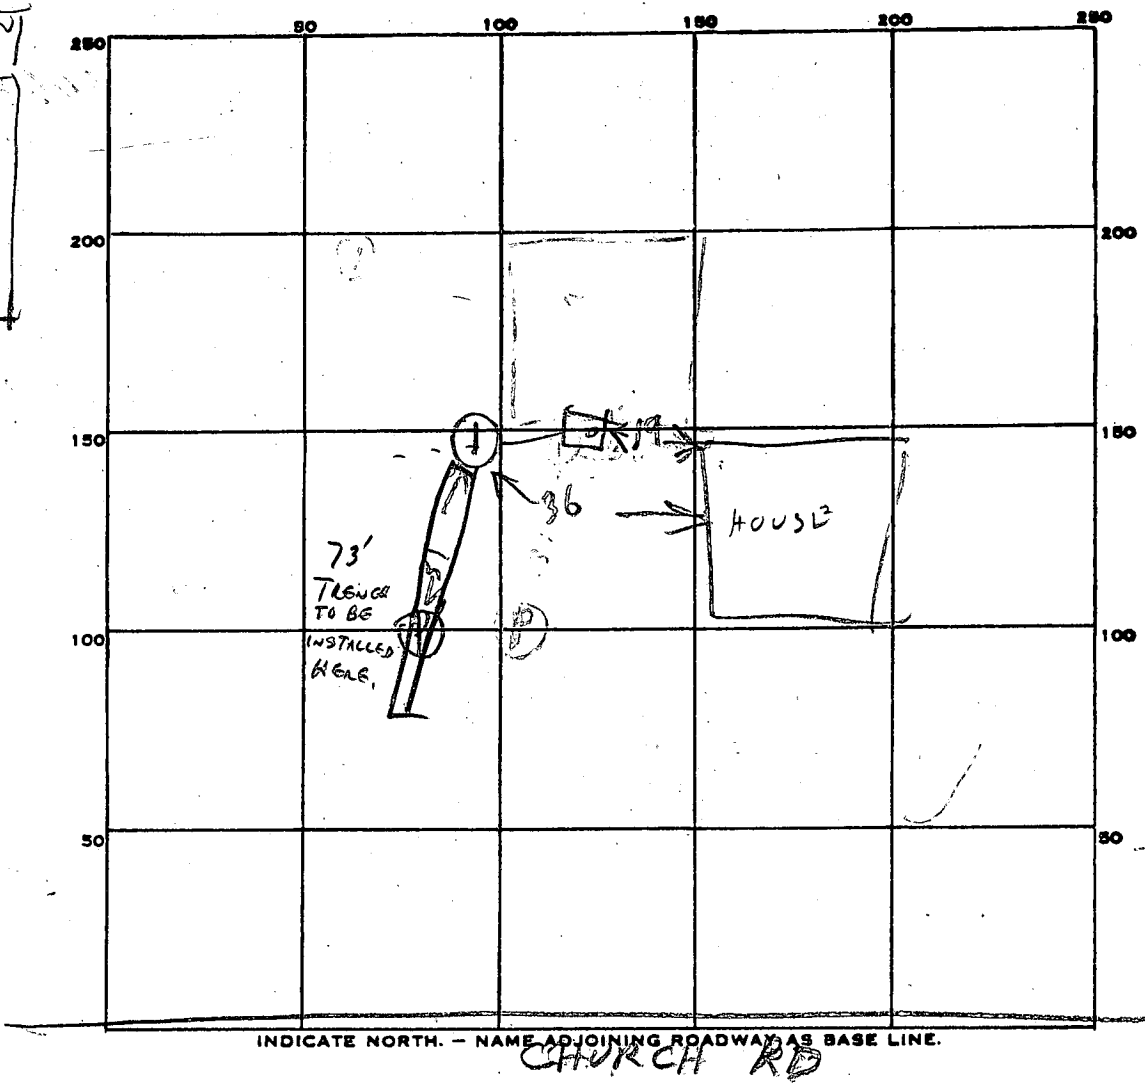

① ELECTRIC POLES

4 YRS
 NO KNOWN PROBLEM UNTIL 3 WKS. AGO.
 WASHING MACHINE

PERMIT CARD _____

ST

SEPTIC TANK, LEVEL OK

CLEANOUTS OK

DISTRIBUTION BOX, LEVEL _____

TILE FIELD, DEPTH 14 FT. TRENCH WIDTH 2 FT.

GRAVEL DEPTH 11 FT IN. TOTAL LENGTH 73 FT.

NUMBER OF TRENCHES _____ TOTAL BOTTOM AREA _____

SEEPAGE PITS, INSIDE DIAMETER _____ FT. DEPTH BELOW INLET _____ FT.

ABSORBENT AREA 500 SQ. FT.

REMARKS 3/12/86 - SOIL OK - DECIDED DEEP TRENCH

3/12/86 - TANK IN PLACE. SOIL COLLAPSING, STONE NOT YET AT SITE. OK TO

INSTALL STONE AND COVER WITHOUT INSPECTION - HEAVY RAIN EXPECTED. C. WILLIAMS


3/13/86 - TANK COVERED & CLEANOUTS OK. BEWARE DOGS RH

3/13/86 SYSTEM INSTALLED WITHOUT INSPECTION. INSTALLED AS INDICATED 73 FT TRENCH WITH 11 FT STONE. C.W.

DATE SYSTEM APPROVED 3/13/86

INSPECTOR C. Williams

CHURCH ROAD

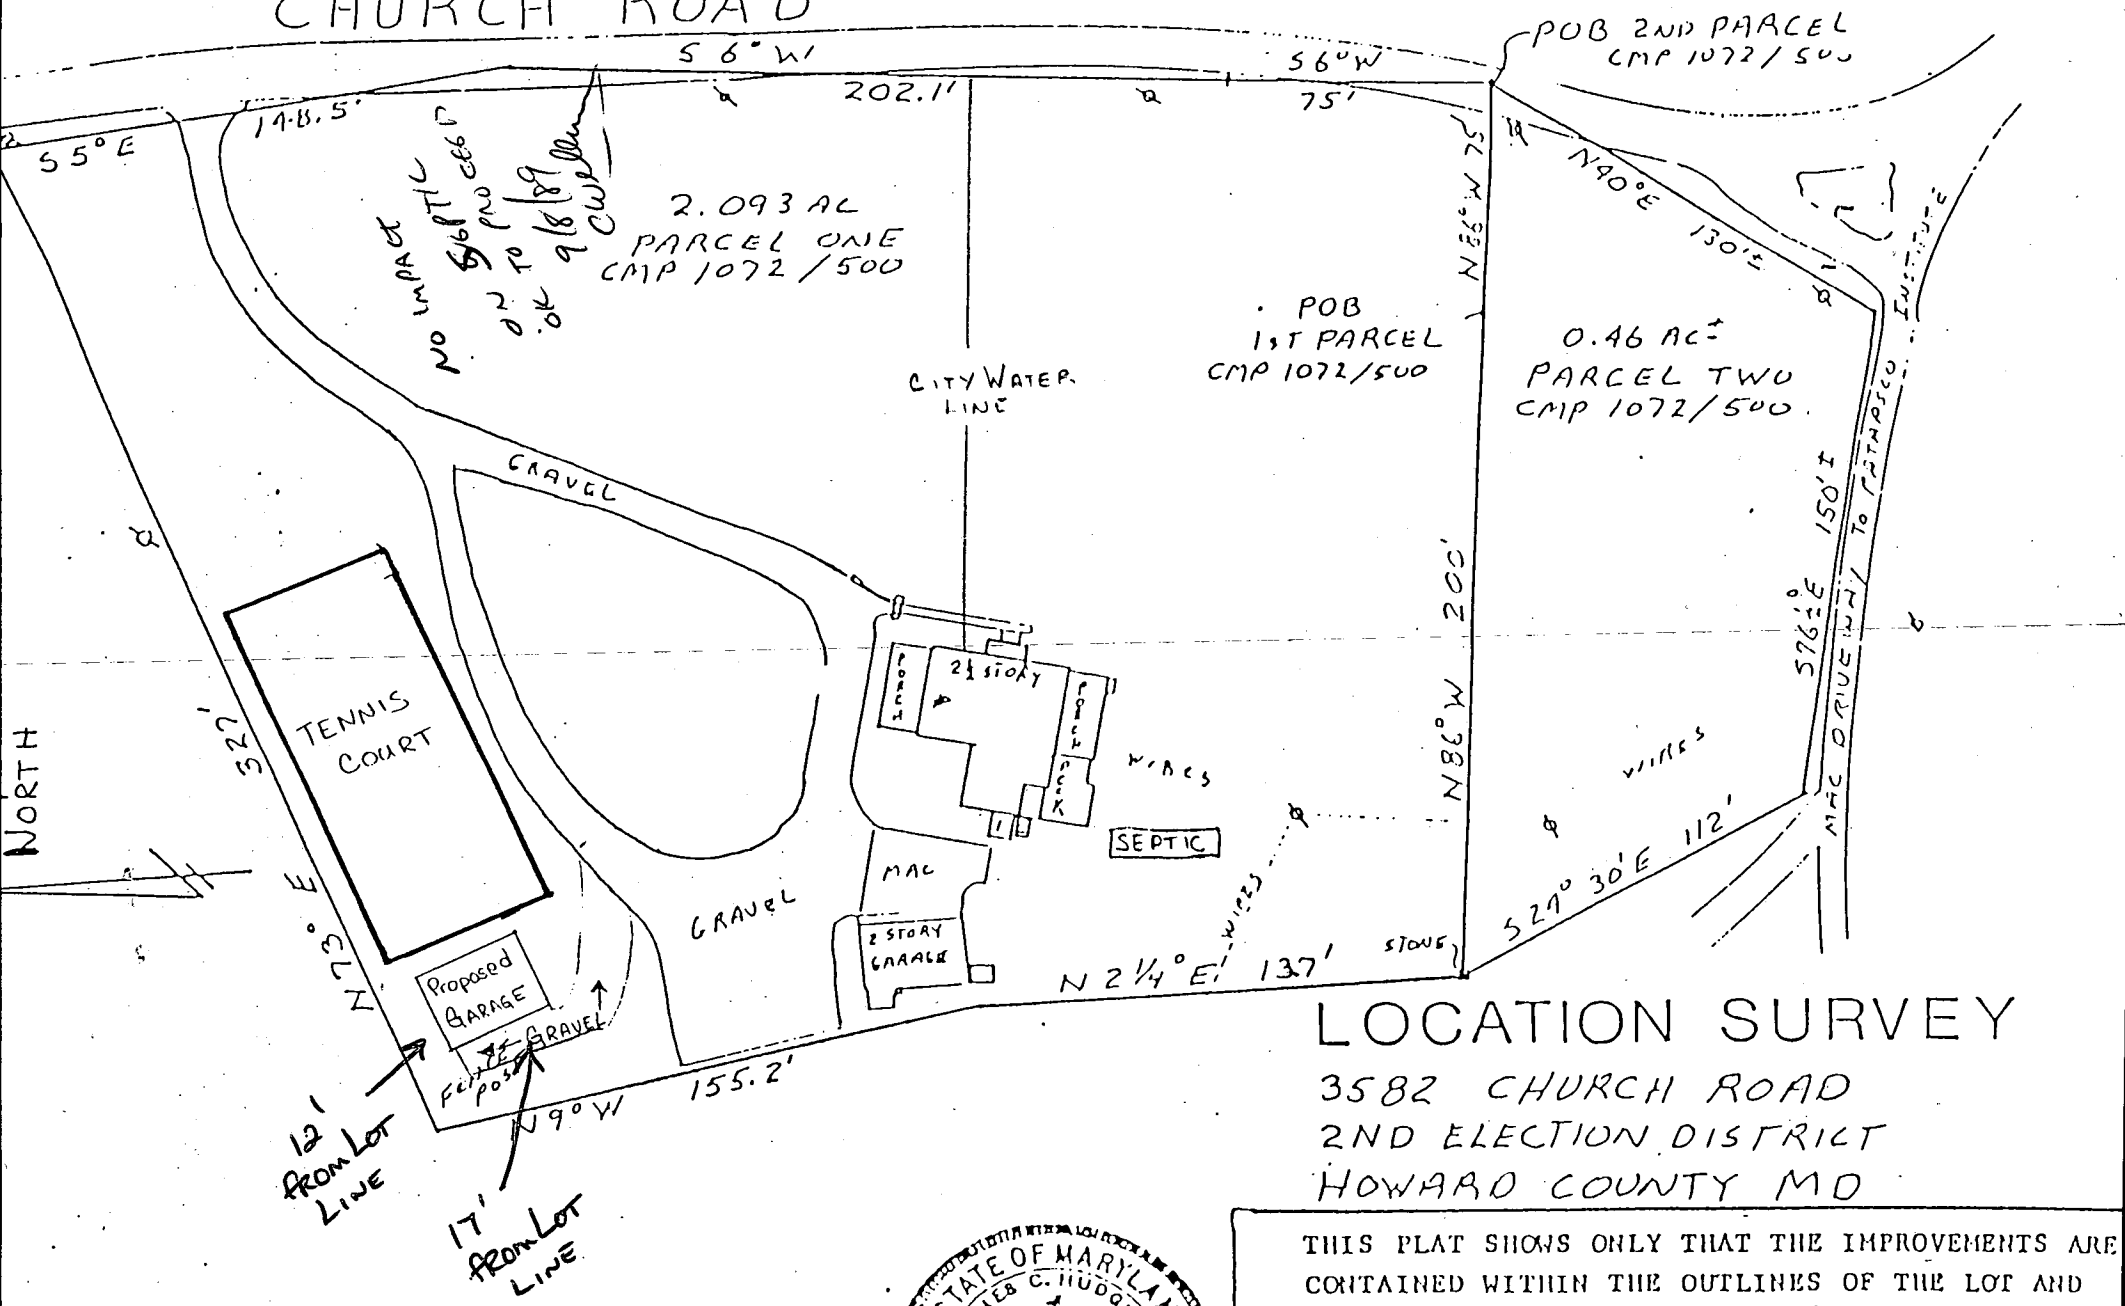

LOCATION SURVEY

3582 CHURCH ROAD
 2ND ELECTION DISTRICT
 HOWARD COUNTY MD

THIS PLAT SHOWS ONLY THAT THE IMPROVEMENTS ARE CONTAINED WITHIN THE OUTLINES OF THE LOT AND IS NOT TO BE USED TO ESTABLISH PROPERTY LINES.

NTI ASSOCIATES INC. 16205 OLD FREDERICK ROAD
 ME. AIRY, MARYLAND PHONE 646-5521 or 442-2031

SCALE 1" = 60'
 DATE 11/25/81

FIELD BY JCH
 DRAWN BY JCH

DRAWING NUMBER



James C. Hudgin
 J. Carl Hudgin PLS 096