

4/7/86  
NOON

APPROVED  
4/7/86  
P. 31277  
A REPAIR

# PERMIT

SEWAGE DISPOSAL SYSTEM

MARYLAND STATE DEPARTMENT OF HEALTH

HOWARD COUNTY  
BUREAU OF ENVIRONMENTAL HEALTH

ELLICOTT CITY

DISTRICT \_\_\_\_\_

~~461-9933~~  
461-9933

INDEXED

DATE 4/8/86

Jack Fyock IS PERMITTED TO INSTALL \_\_\_\_\_ ALTER X

ADDRESS \_\_\_\_\_ PHONE 988-9270

SUBDIVISION \_\_\_\_\_ ROAD 10858 Harmel Drive LOT \_\_\_\_\_

PROPERTY OWNER Wayland

ADDRESS \_\_\_\_\_

IF GARBAGE GRINDER IS USED INCREASE SEPTIC TANK CAPACITY BY 50% AND ABSORPTION AREA BY 22%.

GARBAGE GRINDER? YES  NO

SEPTIC TANK CAPACITY 1000 GALLONS NUMBER OF BEDROOMS 3

REPAIR - CALL FOR INSPECTION WHEN GROUND IS OPENED UP SO SANITARIAN CAN RECOMMEND

REPAIR. 4 17 86 NEW 1000 GAL TANK  
& TRENCH OFF DRY WELL 10 1/2 FT DEEP  
INLET 3 FT TO 4 FT DEEP 6 1/2 - 7 FT STONE  
375 SQ FT ABSORBENT AREA RH

PLANS APPROVED BY C. Williams DATE 4/04/86

COVER NO WORK UNTIL INSPECTED AND APPROVED.

NEITHER THE HOWARD COUNTY COUNCIL NOR THE HEALTH DEPARTMENT IS RESPONSIBLE FOR THE SUCCESSFUL OPERATION OF ANY SYSTEM.

NOTE: IF TRENCH IS USED CALL FOR INSPECTION BEFORE AND AFTER PLACING GRAVEL IN TRENCH.

NOTE: NO DRY WELL SHALL EXCEED 15 FOOT IN DIAMETER. NO ABSORPTION TRENCH TO EXCEED 100 FEET IN LENGTH.

NOTE: ALL PIPE FROM HOUSE TO SEPTIC TANK MUST BE CAST IRON OR SCHEDULE 40 PVC OR ABS.



PERMIT VOID AFTER THREE YEARS.

NOTE: INSTALL STAND PIPE ON SEPTIC TANK AND DRY WELL. STAND PIPES MUST BE 6 INCHES IN DIAMETER. CAST IRON, CONCRETE OR TERRA COTTA, OR PVC OR ABS ACCEPTED. IF TOP OF SEPTIC TANK IS DEEPER THAN 3 FEET MANHOLE TO GRADE REQUIRED.

**\*INSTALLER IS RESPONSIBLE FOR OBTAINING FINAL APROVAL ON THIS PERMIT**

~~CALL 987-2330~~ FOR INSPECTION OF SEPTIC SYSTEMS.

36227  
A REPAIR

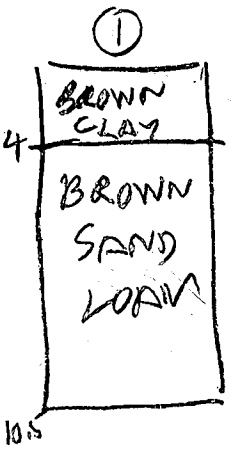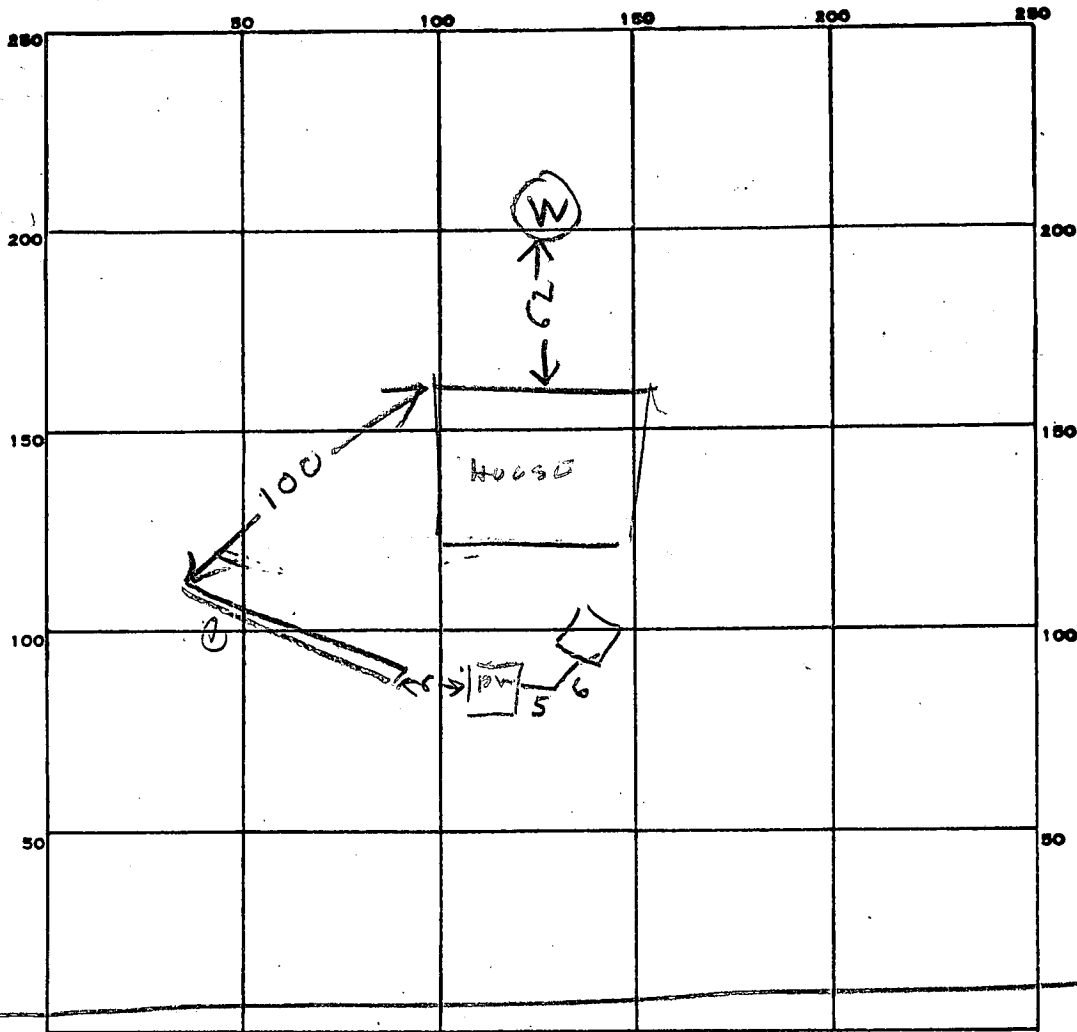

PERMIT CARD \_\_\_\_\_

SEPTIC TANK, LEVEL OK CLEANOUTS OK ST

DISTRIBUTION BOX, LEVEL \_\_\_\_\_

TILE FIELD, DEPTH 10 1/2 FT. TRENCH WIDTH 2 FT. 56  
7  
392

GRAVEL DEPTH 7 1/2 IN. TOTAL LENGTH 56 FT.

NUMBER OF TRENCHES 1 TOTAL BOTTOM AREA 392 below 3 1/2 FT CLAY

SEEPAGE PITS, INSIDE DIAMETER \_\_\_\_\_ FT. DEPTH BELOW INLET \_\_\_\_\_ FT.

ABSORBENT AREA \_\_\_\_\_ SQ. FT.

REMARKS 4/7/86 - SOIL VERY GOOD OLD STEEL TANK  
REPLACED WITH 1000 GAL CONCRETE TANK. ADD STONE  
TO TRENCH  
4/7/86 <sup>209</sup> - STONE ADDED. RJH

DATE SYSTEM APPROVED 4/7/86 INSPECTOR Raymond Hodges