


A# 06386

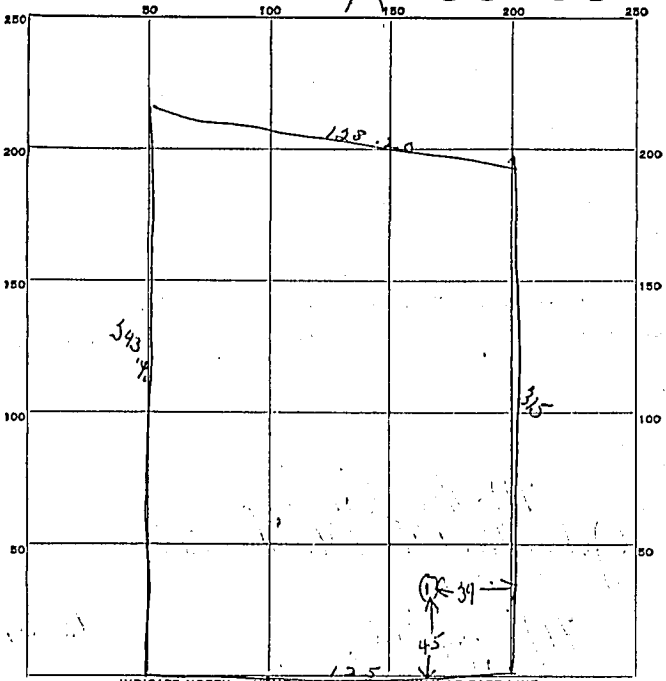

INDICATE NORTH - NAME ADJOINING ROADWAY AS BASE LINE.

Cherry Tree Lane

DATE	TEST NO.	DEPTH	PRE-WET		TEST - 1" DROP		TIME
			START	STOP	START	STOP	
5/14/13	1	10	1016	1020	1020	1028	8min
	1A	4	1017	no perc			

SOIL AUGER FINDING clay - sand - mostly sand

TESTED BY EW 77 - 3/14/13

REMARKS \_\_\_\_\_

ALSO PRESENT Donald E. Sandlin LOT NO. 16 (etc Plot)