

# APPLICATION

SEWAGE DISPOSAL TESTING

STATE OF MARYLAND - DEPARTMENT OF HEALTH AND MENTAL HYGIENE

HOWARD COUNTY HEALTH DEPARTMENT  
ENVIRONMENTAL HEALTH SERVICES

P. O. BOX 476 ELLICOTT CITY, MARYLAND 21043  
TELEPHONE 992-2330

A 42738  
P \_\_\_\_\_  
DISTRICT 4  
DATE August 2, 1988

BLDG. PERMIT SIGNED  
AND RETURNED 8/20/88  
Serial # B01 018617  
SFD - 4Brom

TO: THE COUNTY HEALTH OFFICER  
ELLICOTT CITY, MARYLAND

I, HEREBY, APPLY FOR THE NECESSARY TEST IN ORDER TO CONSTRUCT (OR RECONSTRUCT) A SEWAGE DISPOSAL SYSTEM.

PROPERTY OWNER Paul V. & Dong Cha Broesenne Mr. & Mrs. Gillespie  
ADDRESS 694 Morgan Station Road Woodbine, MD-21797 PHONE 489-4052

PROPERTY LOCATION: Prospective Buyer: Lambert Cissell 442-5671  
SE Corner of 3425 Hipsley Mill Rd. Woodbine, MD 21797 **NEW 24**

SUBDIVISION "Chessie Crossing" Morgan Woodbine Rd. & Morgan Station Rd. LOT NO. 10

ROAD AND DESCRIPTION New Road = Road A, Tax Map 3, Parcel 4  
(754 Chessie Crossing)

SIZE OF LOT 3 acres +/- TYPE BLDG. single family residence  
(NUMBER OF BEDROOMS)

THE SYSTEM INSTALLED UNDER THIS APPLICATION IS ACCEPTABLE ONLY UNTIL PUBLIC FACILITIES BECOME AVAILABLE. I FULLY UNDERSTAND THE FEE CONNECTED WITH THE FILING OF THIS PERC TEST APPLICATION IS NON-REFUNDABLE UNDER ANY CIRCUMSTANCES. I ALSO AGREE TO COMPLY WITH ALL M.O.S.H.A. REQUIREMENTS IN TESTING THIS LOT.

James L Newburn (997-3815)  
(SIGNATURE OF APPLICANT)

APPROVED BY \_\_\_\_\_ FOR \_\_\_\_\_ DATE \_\_\_\_\_  
James L. Newburn Agent for Lambert Cissel



REJECTED BY \_\_\_\_\_ FOR \_\_\_\_\_ DATE \_\_\_\_\_

HOLD PENDING FURTHER TESTS \_\_\_\_\_ DATE \_\_\_\_\_

REASONS FOR REJECTION OR HOLDING 1/19/89 Recommend Visual Hold  
in wet season B/H 2/27/89 RECEIVED VISUAL  
HOLD & WET SEASON AFTER REVIEWING A MORE  
ACCURATE PLAT B/H

# THIS IS NOT A PERMIT




Lot 102  
 A 42  
 Lot near 24  
 138

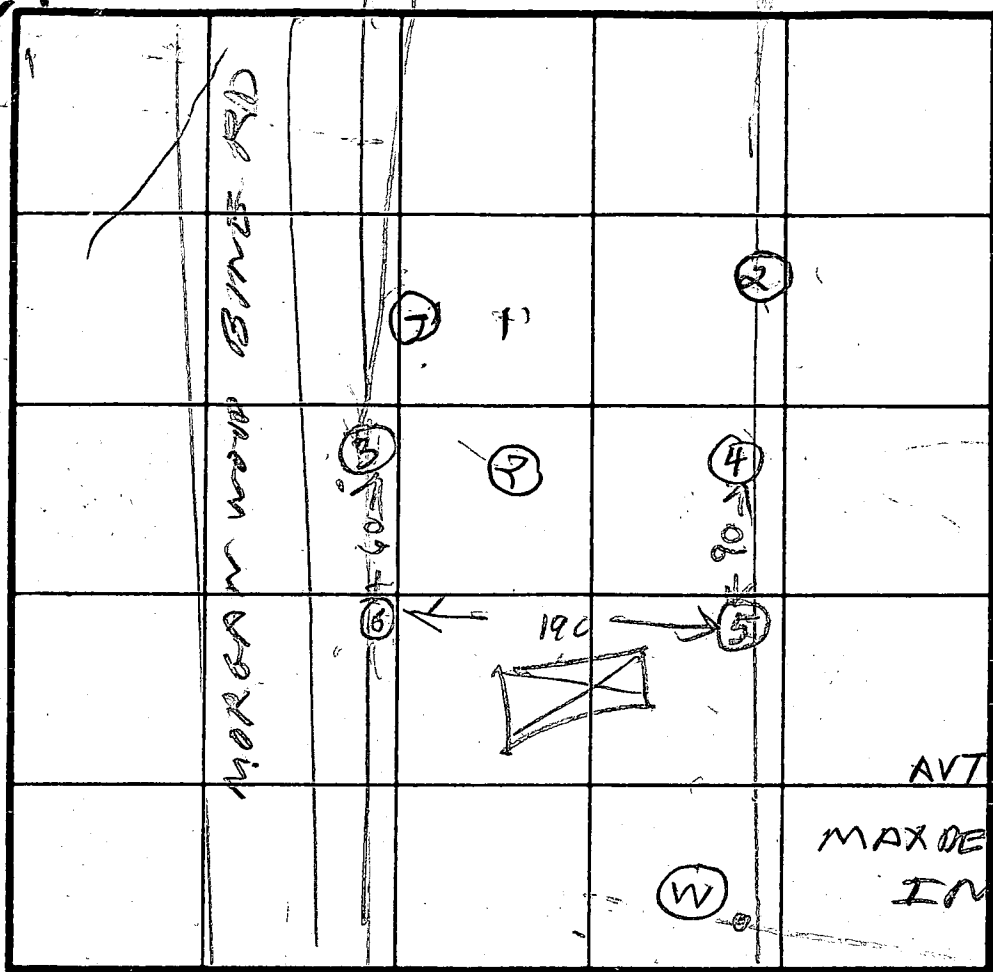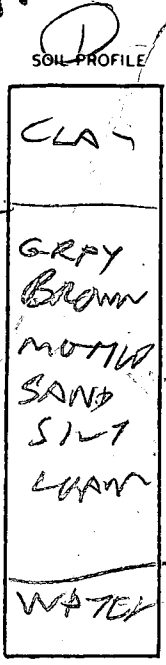

AV TIME 7 MIN

MAX DEPTH INLET 2 FT

INDICATE NORTH - NAME ADJOINING ROADWAY AS BASE LINE

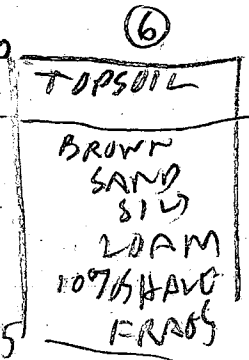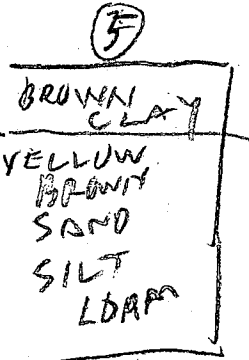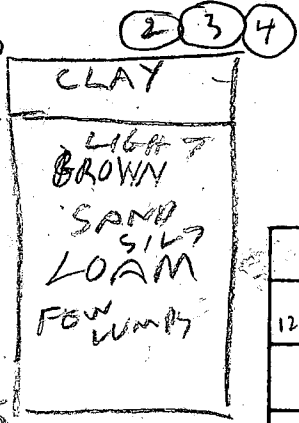

DATE	TEST NO.	DEPTH	PRE-WET		TEST - 1" DROP		TIME
			START	STOP	START	STOP	
12/13/88	1V	10	WATER	9 1/2 FT	UNSAT		
	2V	11.5	OK				
	3V	3.5	345	347	347	352	5
	3V	11	OK				
	4V	3.5	351	354	354	410	6
	4V	11					
	5V	12	OK				
	6V	3 1/2	415	417	417	420	3
	6V	7	415	421	421	422	11
	6V	11.5	OK				

ONLINE LOT 9810  
 ON LINE LOT 9810

REMARKS: Not dug Different from Test Plot  
See RED MARKED AREA ON TEST PLAT

TYPE OF SOIL \_\_\_\_\_  
 TESTED BY: R. HARVE  
 ALSO PRESENT: OKETERMAN 850N  
SONNY CASSE