

APPROVED
04-312732419/85 RH

PERMIT

P 35233

A REPAIR

SEWAGE DISPOSAL SYSTEM

MARYLAND STATE DEPARTMENT OF HEALTH

HOWARD COUNTY
BUREAU OF ENVIRONMENTAL HEALTH
992-2330

INDEXED

ELLICOTT CITY

DISTRICT _____

DATE 4/3/85

Purpose of Repair
to stop overflow

Jack Fuock IS PERMITTED TO INSTALL _____ ALTER

ADDRESS _____ PHONE 988-9270

SUBDIVISION taxmap 2, parcel 116 ROAD 309 EAST Watersville Road LOT _____

PROPERTY OWNER Mr. & Mrs. Darby ^{Eleanor} MAIN HOUSE
309 Watersville Road

ADDRESS _____

IF GARBAGE GRINDER IS USED INCREASE SEPTIC TANK CAPACITY BY 50% AND ABSORPTION AREA BY 22%.

GARBAGE GRINDER? YES _____ NO

SEPTIC TANK CAPACITY 1250 GALLONS NUMBER OF BEDROOMS 4

REPAIR - CALL FOR INSPECTION WHEN GROUND IS OPENED UP SO SANITARIAN CAN RECOMMEND REPAIR.

4/9/85 SHALLOW LEACHING BED
500 SQ FT BOTTOM AREA BEHIND
HOUSE 4 FT DEEP 2 FT ROCK

PLANS APPROVED BY Craig Williams DATE 4/02/85

COVER NO WORK UNTIL INSPECTED AND APPROVED.

NEITHER THE HOWARD COUNTY COUNCIL NOR THE HEALTH DEPARTMENT IS RESPONSIBLE FOR THE SUCCESSFUL OPERATION OF ANY SYSTEM.

NOTE: IF TRENCH IS USED CALL FOR INSPECTION BEFORE AND AFTER PLACING GRAVEL IN TRENCH.

NOTE: NO DRY WELL SHALL EXCEED 15 FOOT IN DIAMETER. NO ABSORPTION TRENCH TO EXCEED 100 FEET IN LENGTH.

NOTE: ALL PIPE FROM HOUSE TO SEPTIC TANK MUST BE CAST IRON OR SCHEDULE 40 PVC OR ABS.

PERMIT VOID AFTER THREE YEARS.

NOTE: INSTALL STAND PIPE ON SEPTIC TANK AND DRY WELL. STAND PIPES MUST BE 6 INCHES IN DIAMETER. CAST IRON, CONCRETE OR TERRA COTTA, OR PVC OR ABS ACCEPTED. IF TOP OF SEPTIC TANK IS DEEPER THAN 3 FEET MANHOLE TO GRADE REQUIRED.

*INSTALLER IS RESPONSIBLE FOR OBTAINING FINAL APROVAL ON THIS PERMIT


*CALL 992-2330 FOR INSPECTION OF SEPTIC SYSTEMS.

EH - 2-1082

P 35233

VISUAL HOLE

①
CLAY
SHALE
SAND
HARD
BOTTOM

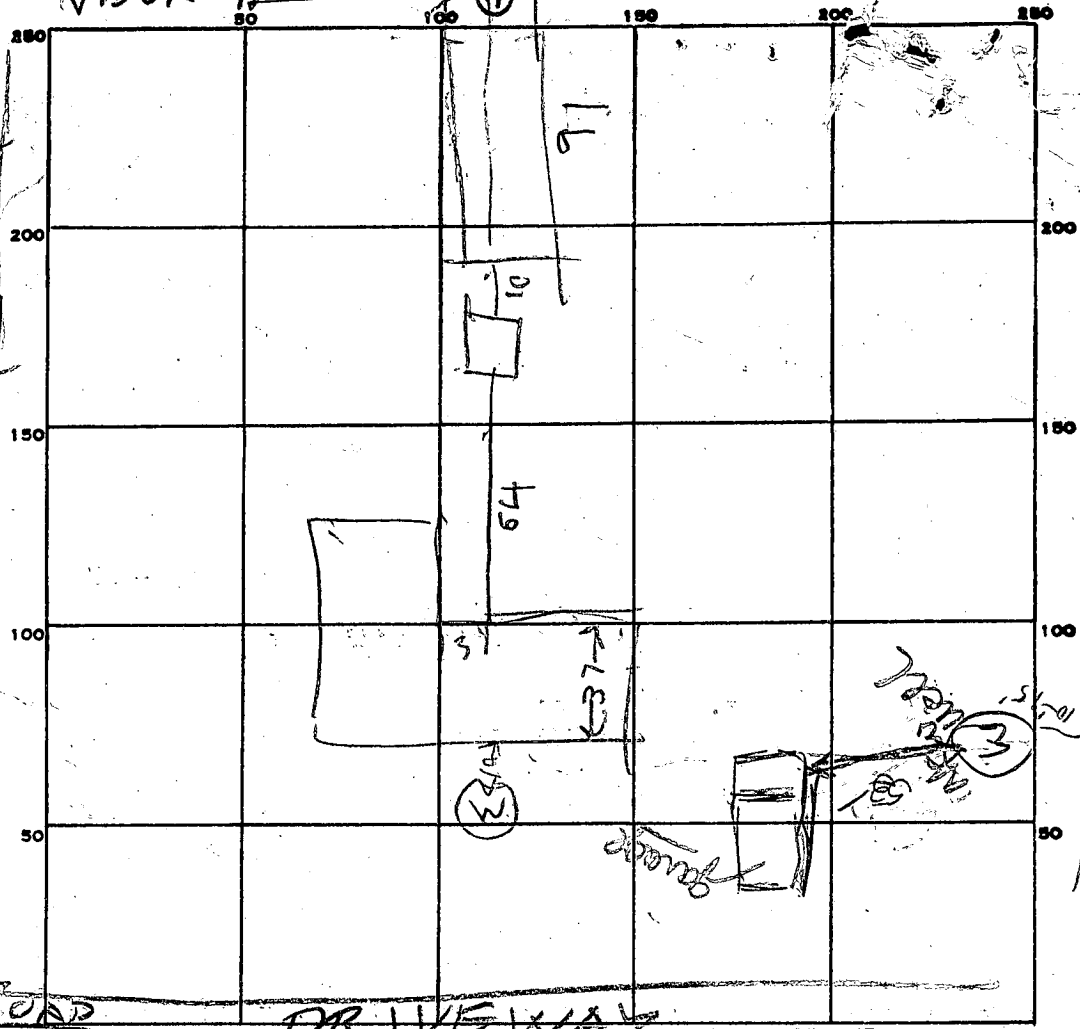

55
70
9
125
596
500
91
5
546

Perce
line

INDICATE NORTH. NAME ADJOINING ROADWAY AS BASE LINE.

PERMIT CARD _____

SEPTIC TANK, LEVEL 1500
TOP 2 FT BOG

CLEANOUTS ST
OK

150
4
530

DISTRIBUTION BOX, LEVEL _____

TILE FIELD, DEPTH 4 1/2 FT. TRENCH WIDTH 6 FT.

GRAVEL DEPTH 2 IN. TOTAL LENGTH 91 FT.

NUMBER OF TRENCHES 1 TOTAL BOTTOM AREA 546

SEEPAGE PITS, INSIDE DIAMETER _____ FT. DEPTH BELOW INLET _____ FT.

4/9/85 ABSORBENT AREA _____ SQ. FT.

REMARKS OK LEACHING BED SHALLOW
SOIL NEAR TANK HOLE GOOD TO 8 FT
SOIL NEAR END OF BED HAS ROCK BOTTOM
BED DUG OK WAITED FOR STONE TO BE
ADDED

DATE SYSTEM APPROVED 4/9/85 INSPECTOR Raymond Hoelger

C1 5991

SEQUENCE NO. (DENV USE ONLY)

STATE OF MARYLAND WELL COMPLETION REPORT

THIS REPORT MUST BE SUBMITTED WITHIN 45 DAYS AFTER WELL IS COMPLETED.

(THIS NUMBER IS TO BE PUNCHED IN COLS. 3-6 ON ALL CARDS)

COUNTY NUMBER 50473B

ST/CO USE ONLY DATE Received

DATE WELL COMPLETED

Depth of Well 400 (TO NEAREST FOOT)

PERMIT NO. FROM "PERMIT TO DRILL WELL" H0-94-0280

OWNER: last name: Coyne, first name: Robert; STREET OR RFD: 309 B. Watersville Rd; TOWN: MT AIRY; SUBDIVISION: ; SECTION: ; LOT: #1

WELL LOG Not required for driven wells STATE THE KIND OF FORMATIONS PENETRATED, THEIR COLOR, DEPTH, THICKNESS AND IF WATER BEARING

Table with columns: DESCRIPTION (Use additional sheets if needed), FEET (FROM, TO), Check if water bearing. Rows include Top Soil, Brown Shale, Tan Slate, Brown Slate, Tan Slate, Brown Slate, Tan Slate, Blue Slate.

GROUTING RECORD WELL HAS BEEN GROUTED (Y/N) TYPE OF GROUTING MATERIAL CEMENT (CM) BENTONITE CLAY (BC) NO. OF BAGS 8 NO. OF POUNDS 800

CASING RECORD casing types insert appropriate code below ST CO STEEL CONCRETE PL OT PLASTIC OTHER

MAIN CASING TYPE Nominal diameter top (main) casing (nearest inch) Total depth of main casing (nearest foot) ST 6 40

OTHER CASING (if used) diameter inch depth (feet) from to

SCREEN RECORD screen type or open hole insert appropriate code below ST BR HO STEEL BRASS OPEN HOLE PL OT PLASTIC BRONZE HOLE OTHER

IN HARD ROCK AREAS, IDENTIFY SPECIFICALLY WHERE SATURATED FRACTURES WERE OBSERVED. WELL HYDROFRACTURED (Y/N)

Table with columns: DEPTH (nearest ft.), SLOT SIZE 1, 2, 3, DIAMETER OF SCREEN (NEAREST INCH). Rows 1-3.

CIRCLE APPROPRIATE LETTER A WELL WAS ABANDONED AND SEALED WHEN THIS WELL WAS COMPLETED E ELECTRIC LOG OBTAINED P TEST WELL CONVERTED TO PRODUCTION WELL

I HEREBY CERTIFY THAT THIS WELL HAS BEEN CONSTRUCTED IN ACCORDANCE WITH COMAR 26.04.04 "WELL CONSTRUCTION" AND IN CONFORMANCE WITH ALL CONDITIONS STATED IN THE ABOVE CAPTIONED PERMIT...

DRILLERS IDENT NO. 40; DRILLERS SIGNATURE; SITE SUPERVISOR (sign. of driller or journeyman responsible for sitework if different from permittee)

GRAVEL PACK IF WELL DRILLED WAS FLOWING WELL INSERT F IN BOX 68

MDE USE ONLY (NOT TO BE FILLED IN BY DRILLER) T (E.R.O.S.) W.O. TELESCOPE CASING LOG INDICATOR OTHER DATA

PUMPING TEST HOURS PUMPED (nearest hour) 3 PUMPING RATE (gal. per min. to nearest gal.) 2 METHOD USED TO MEASURE PUMPING RATE Bucket WATER LEVEL (distance from land surface) BEFORE PUMPING 5 WHEN PUMPING 400 TYPE OF PUMP USED (for test) A air P piston T turbine C centrifugal R rotary O other (describe below) J jet S submersible

PUMP INSTALLED DRILLER WILL INSTALL PUMP YES NO (CIRCLE) (YES or NO) IF DRILLER INSTALLS PUMP, THIS SECTION MUST BE COMPLETED FOR ALL WELLS EXCEPT HOME USE TYPE OF PUMP INSTALLED PLACE (A,C,J,P,R,S,T,O) IN BOX - SEE ABOVE: CAPACITY: GALLONS PER MINUTE (to nearest gallon) PUMP HORSE POWER PUMP COLUMN LENGTH (nearest ft.) CASING HEIGHT (circle appropriate box and enter casing height) LAND SURFACE (nearest foot)

LOCATION OF WELL ON LOT SHOW PERMANENT STRUCTURE SUCH AS BUILDING, SEPTIC TANKS, AND/OR LANDMARKS AND INDICATE NOT LESS THAN TWO DISTANCES (MEASUREMENTS TO WELL)

DRILLER

C1 **5605** SEQUENCE NO. (DENV USE ONLY)
 (THIS NUMBER IS TO BE PUNCHED IN COLS. 3-6 ON ALL CARDS)

STATE OF MARYLAND
WELL COMPLETION REPORT
 FILL IN THIS FORM COMPLETELY PLEASE PRINT OR TYPE

THIS REPORT MUST BE SUBMITTED WITHIN 45 DAYS AFTER WELL IS COMPLETED.
 COUNTY NUMBER **50473B**

DATE/CO USE ONLY
 ST/CE Received: DATE WELL COMPLETED **012695**

Depth of Well **400**
 (TO NEAREST FOOT)

PERMIT NO. FROM "PERMIT TO DRILL WELL"
H0-94-0346

OWNER **CONNIE BOB**
 STREET OR RFD last name **BOB** first name **CONNIE** TOWN **Mt. Airy**
 SUBDIVISION SECTION LOT

WELL LOG
 Not required for driven wells
 STATE THE KIND OF FORMATIONS PENETRATED, THEIR COLOR, DEPTH, THICKNESS AND IF WATER BEARING

DESCRIPTION (Use additional sheets if needed)	FEET		Check if water bearing
	FROM	TO	
Topsoil	0	1	
Clay	1	3	
Clay & Shale	3	6	
Shale	6	16	
Br. Slate	16	28	
Tan Slate	28	51	
Br. Slate	51	55	✓
Tan Slate	55	64	
Gray Slate	64	85	
Tan Slate	85	90	
Gray Slate	90	122	
Tan Slate	122	124	
Gray Slate	124	310	
Bl. Slate	310	400	

* 1 3/4 CFM
 200' DRY
 well-filled in 10' deep

GROUTING RECORD
 WELL HAS BEEN GROUTED (Circle Appropriate Box) **Y** **N**
 TYPE OF GROUTING MATERIAL
 CEMENT **CM** BENTONITE CLAY **BC**
 NO. OF BAGS **12** NO. OF POUNDS **1200**
 GALLONS OF WATER **60**
 DEPTH OF GROUT SEAL (to nearest foot)
 from **0** ft. to **37** ft.
 (enter 0 if from surface)

CASING RECORD
 casing types insert appropriate code below
ST **CO**
 STEEL CONCRETE
PL **OT**
 PLASTIC OTHER

MAIN CASING TYPE
 Nominal diameter top (main) casing (nearest inch) **6** Total depth of main casing (nearest foot) **40**
ST **6** **40**
 60 61 63 64 66 70

EACH CASING
 diameter (inch) depth (feet) from to

SCREEN RECORD
 screen type or open hole insert appropriate code below
ST **BR** **HO**
 STEEL BRASS OPEN HOLE
PL **OT**
 PLASTIC OTHER


C2
 DEPTH (nearest ft.)
 EACH SCREEN **H0** **38** **400**
 8 9 11 15 17 21
 23 24 26 30 32 36
 38 39 41 45 47 51
 SLOT SIZE 1 2 3
 DIAMETER OF SCREEN (NEAREST INCH) **56** **60**
 from to

GRAVEL PACK IF WELL DRILLED WAS FLOWING WELL INSERT F IN BOX 68 **LED 53**

OEP USE ONLY (NOT TO BE FILLED IN BY DRILLER)
 T (E.R.O.S.) W Q 74-75-76
 70 72
 TELESCOPE CASING LOG INDICATOR OTHER DATA

C3
PUMPING TEST
 HOURS PUMPED (nearest hour) **3**
 PUMPING RATE (gal. per min. to nearest gal.) **27**
 METHOD USED TO MEASURE PUMPING RATE **bucket**
 WATER LEVEL (distance from land surface)
 BEFORE PUMPING **50**
 WHEN PUMPING **400**
 TYPE OF PUMP USED (for test)
A air **P** piston **T** turbine
C centrifugal **R** rotary **O** other (describe below)
J jet **S** submersible

PUMP INSTALLED
 DRILLER WILL INSTALL PUMP YES **NO**
 (CIRCLE) (YES OR NO)
 IF DRILLER INSTALLS PUMP, THIS SECTION MUST BE COMPLETED FOR ALL WELLS EXCEPT HOME USE
 TYPE OF PUMP INSTALLED PLACE (A,C,J,P,R,S,T,O) IN BOX - SEE ABOVE: **29**
 CAPACITY: GALLONS PER MINUTE (to nearest gallon) **31** **35**
 PUMP HORSE POWER **37** **41**
 PUMP COLUMN LENGTH (nearest ft.) **43** **47**
 CASING HEIGHT (circle appropriate box and enter casing height)
+ above **LAND SURFACE** **2** (nearest foot)
- below **50** **51**

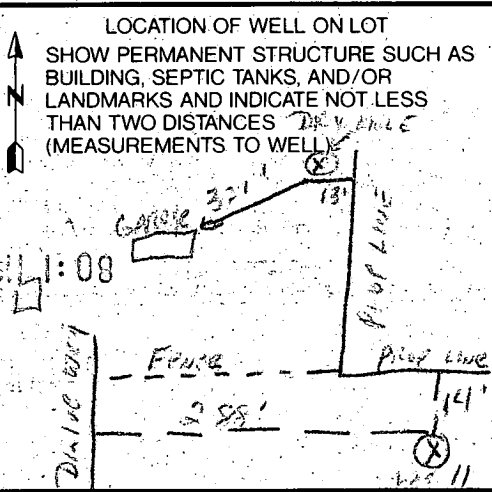

CIRCLE APPROPRIATE LETTER
A A WELL WAS ABANDONED AND SEALED WHEN THIS WELL WAS COMPLETED
E ELECTRIC LOG OBTAINED
P TEST WELL CONVERTED TO PRODUCTION WELL

I HEREBY CERTIFY THAT THIS WELL HAS BEEN CONSTRUCTED IN ACCORDANCE WITH COMAR 26.04.04 "WELL CONSTRUCTION" AND IN CONFORMANCE WITH ALL CONDITIONS STATED IN THE ABOVE CAPTIONED PERMIT, AND THAT THE INFORMATION PRESENTED HEREIN IS ACCURATE AND COMPLETE TO THE BEST OF MY KNOWLEDGE.

DRILLERS IDENT. NO. **40**

DRILLERS SIGNATURE (MUST MATCH SIGNATURE ON APPLICATION)
Wesley Blanginist

SITE SUPERVISOR (sign. of driller or journeyman responsible for sitework if different from permittee)

WATER WELL ABANDONMENT-SEALING REPORT FORM

SUBMIT COPIES OF COMPLETED FORM TO:

- * COUNTY ENVIRONMENT AGENCY (contact MDE, WMA if address needed)
- * WELL OWNER
- * MDE, WATER MANAGEMENT ADMINISTRATION, WELL PROGRAM

DATE WELL ABANDONED: 1/11/95 (month/day/year)

N/A

PERMIT NUMBER OF ABANDONED WELL (if any)

PERMIT NUMBER OF REPLACEMENT WELL


H0-94-0280

PERSON ABANDONING WELL: L. Franklin Eastday Jr. WELL DRILLERS LICENSE NUMBER: 269

OWNER'S NAME: Robert Coyne

WELL LOCATION: 309 E Watersville Rd

COUNTY: Howard
 NEAREST TOWN: _____
 TAX MAP 3 BLOCK A5 PARCEL _____
 SUBDIVISION: _____
 SECTION: _____ LOT: _____

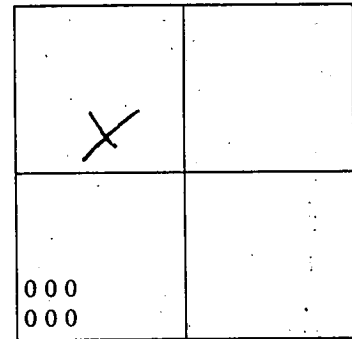

SHOW WELL LOCATION BY X WITHIN BOX

MARYLAND GRID COORDINATES

BOX NUMBER E 772
 N 558

TYPE OF WELL BEING ABANDONED:

- DRILLED
- BORED/AUGURED
- OTHER (specify) _____
- JETTED
- HAND DUG

USE CODE:

- DOMESTIC
- IRRIGATION
- TEST/OBSERVATION
- MUNICIPAL/PUBLIC
- INDUSTRIAL

TYPE OF CASING:

- STEEL
- CONCRETE
- PLASTIC
- OTHER (specify) _____

SIZE OF CASING: 8 INCHES IN DIAMETER

DEPTH OF WELL: 190 FEET DEEP

WAS ANY CASING REMOVED? YES NO
 if yes, length removed, in feet: _____

WAS CASING RIPPED OR PERFORATED? YES NO

SIGNATURE-MASTER WELL DRILLER OR SUPERVISING SANITARIAN [Signature] LICENSE # 269 DATE 1/11/95

LOG OF SEALING MATERIAL

MATERIAL	FEET	
	FROM	TO
Gravel	190	20
Benonite/Cement	20	4
Pit	4	0

February 15, 1995

MEMORANDUM

TO: File

FROM: DKS

RE: Replacement wells for 309 E. Watersville Road

Telephoned Easterday (9:00 a.m. no answer) 10:15 a.m.--obtained the following information:

HO-94-0280: well #1, hydrofractured, operated for two weeks, then "failed" according to driller

Driller reports original failing well was properly abandoned and that abandonment report would be forthcoming

Second well drilled to be permitted today (February 15, 1995)--two new replacement wells to be maintained as total water supply

MEET
DRILLER, 1:00 1/6/95
OWNER

SITE INSPECTION SHEET

OWNER: Robert Coyne

DATE REQUESTED: 1/6/94

SITE ADDRESS: 309 E. Watersville Rd

DRILLER: Easterday


WELL TAG # _____

COUNTY # _____

PROPOSAL: RENTED HOUSE (TENANT: LORD) IS OUT OF WATER;
EMERGENCY WELL SITE REQUESTED

500'

LOCATION DIAGRAM

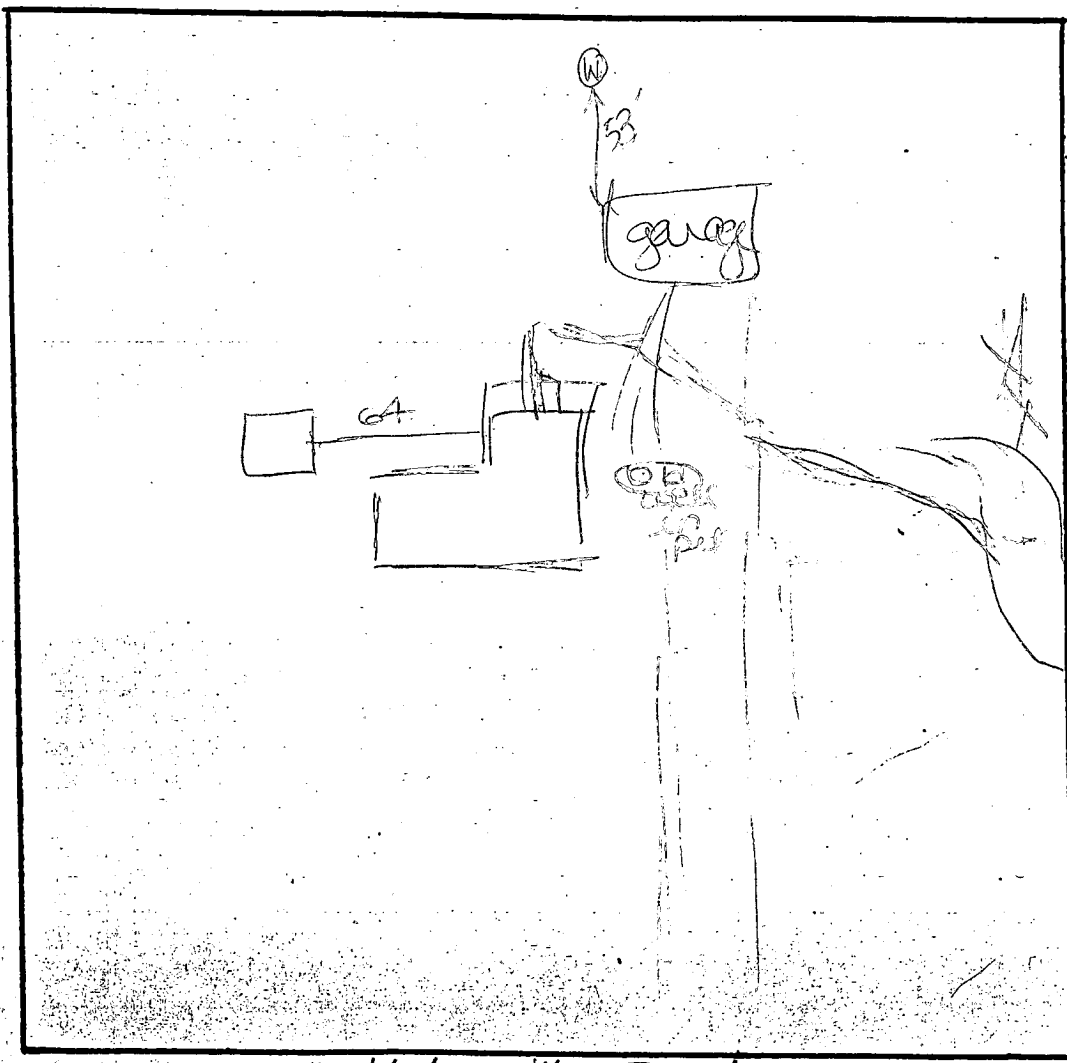


E. Watersville Road

COMMENTS: 1/6/95 Met w/owner Mr. Coyne and driller Mr.
Easterday. Approved well site location as indicated
on diagram.

DATE: 1/6/95

INSPECTOR: [Signature]

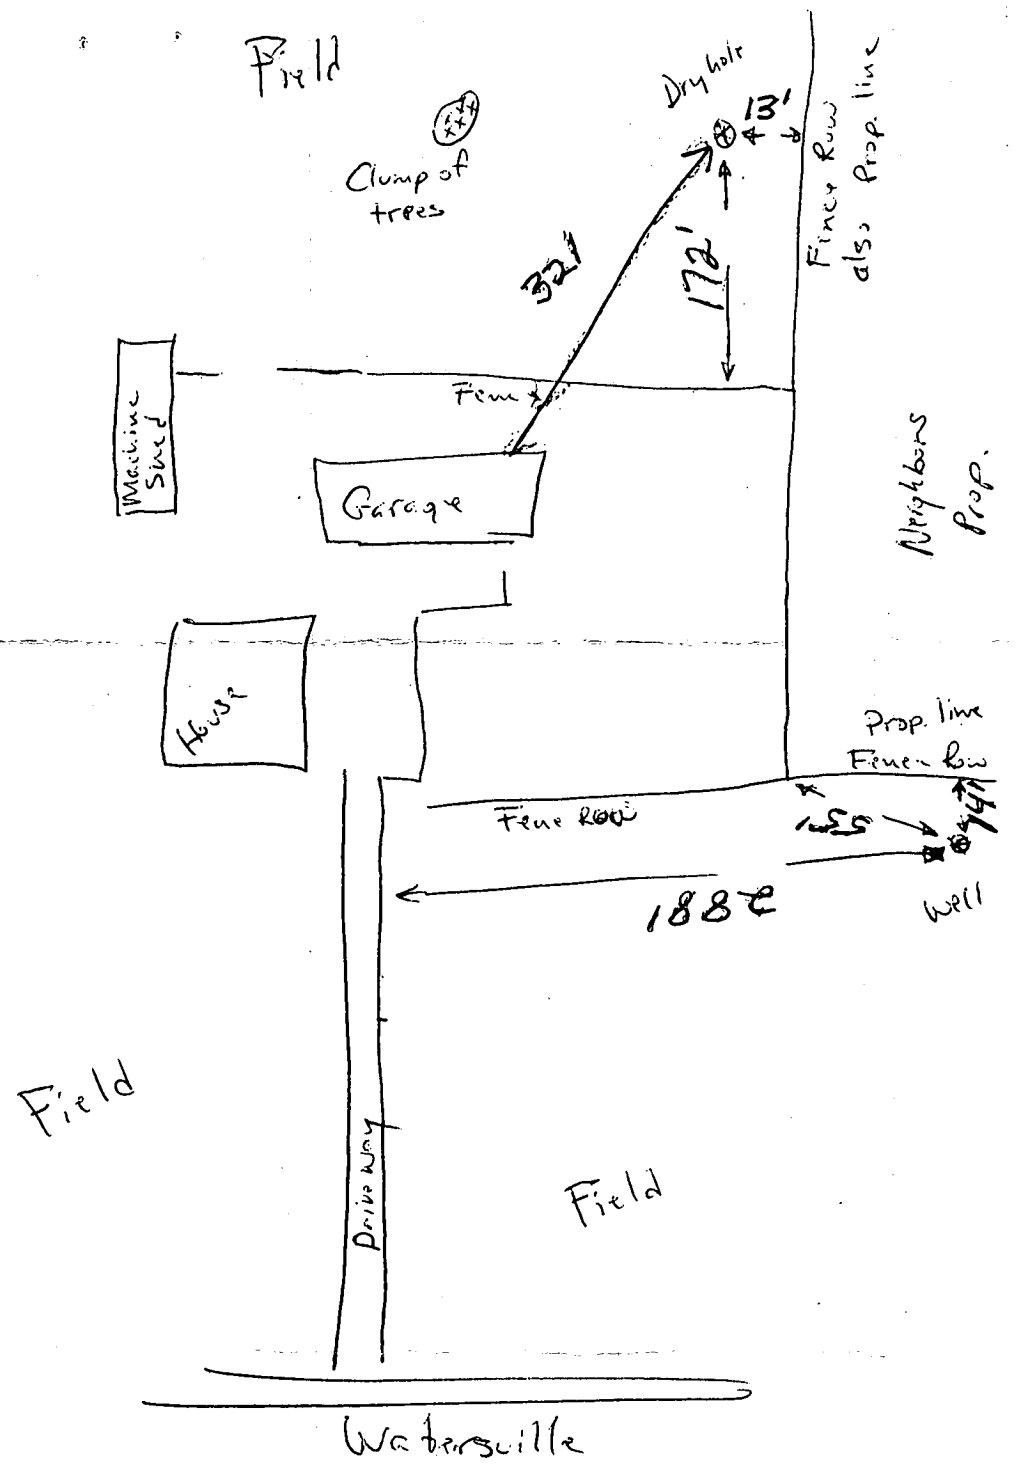



HOWARD COUNTY HEALTH DEPARTMENT

Joyce M. Boyd, M.D., County Health Officer

February 15, 1995

MEMORANDUM

TO: George F. Easterday
L. Franklin Easterday, Inc.
9265 Brown Church Road
Mt. Airy, Maryland 21771

FROM: Craig Williams, Director (CW)
Water and Sewerage Program
Bureau of Environmental Health

RE: Well permit applications for replacement wells
309 E. Watersville Road

Permit applications for two replacement wells were approved subject to the following conditions:

- 1) replacement well drilled under permit #HO-94-0280 was indicated as the replacement well for the failing well to be kept as a standby water source; however, after two weeks of use, this replacement well reportedly "failed". In order for this well to be considered an acceptable contributor to the water supply, the status of this well should be described as possessing a "declining yield".
- 2) submittal of the well abandonment report for the original failed well.

CW:dks



cc: Mr. Robert Coyne, property owner

COORDINATE TABLE			CURVE DATA						
NO	NORTH	EAST	NO	RADIUS	ARC LENGTH	Δ	TANGENT	CHORD BEAR' & DISTANCE	
1	558,667.55	771,007.11	2-0	2114.00'	239.49'	06° 29' 27"	119.07'	S 21° 50' 10" E 239.36'	
2	558,680.27	771,034.28	7-1	2084.00'	236.09'	06° 29' 27"	118.17'	N 21° 50' 10" W 235.96'	
3	558,777.65	771,242.34							
4	558,103.93	771,438.68							
5	558,125.49	771,235.19							
6	558,115.22	771,206.76							
7	558,440.51	771,094.88							
8	558,458.08	771,123.32							

THE COORDINATES SHOWN HEREON ARE BASED ON THE MARYLAND STATE GRID SYSTEM.

EASEMENT TABLE		
NO.	BEARING	DISTANCE
1	N 25° 04' 57" W	115.21'
2	N 33° 56' 08" W	78.68'
3	N 27° 28' 39" W	53.31'
4	N 13° 37' 46" E	50.16'
5	N 19° 21' 05" E	47.59'
6	N 12° 20' 43" E	62.02'

AREA TABULATION	
NO. OF LOTS TO BE RECORDED	- 1
TOTAL AREA OF LOTS	- 3.000 AC. ±
TOTAL AREA OF ROAD DEDICATION	- 0.400 AC. ±
TOTAL AREA OF SUBDIVISION	- 3.400 AC. ±

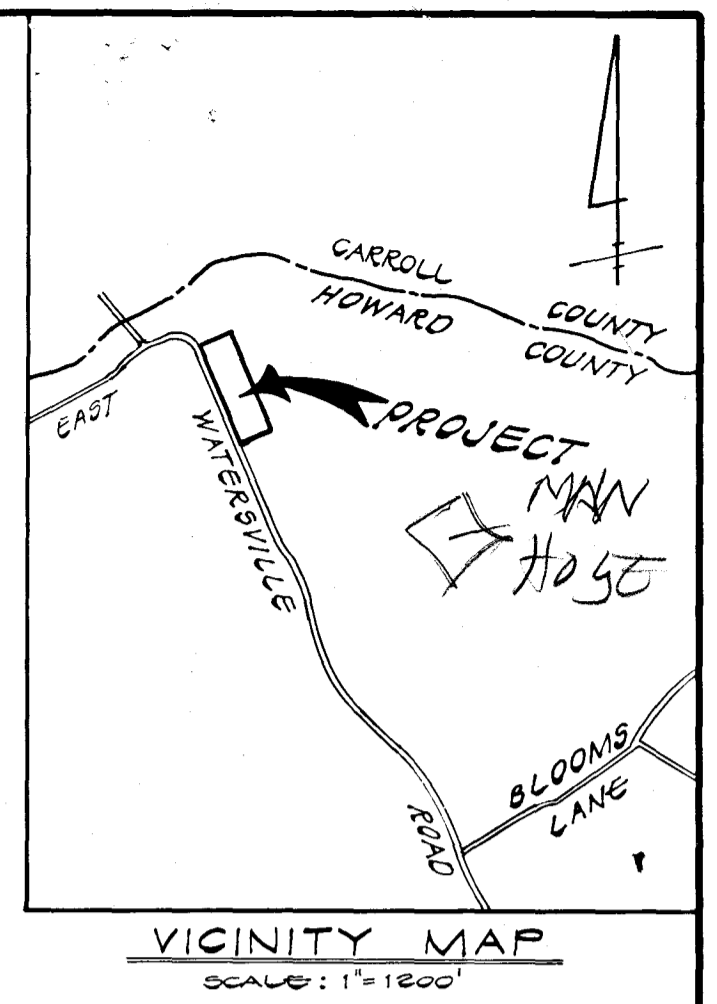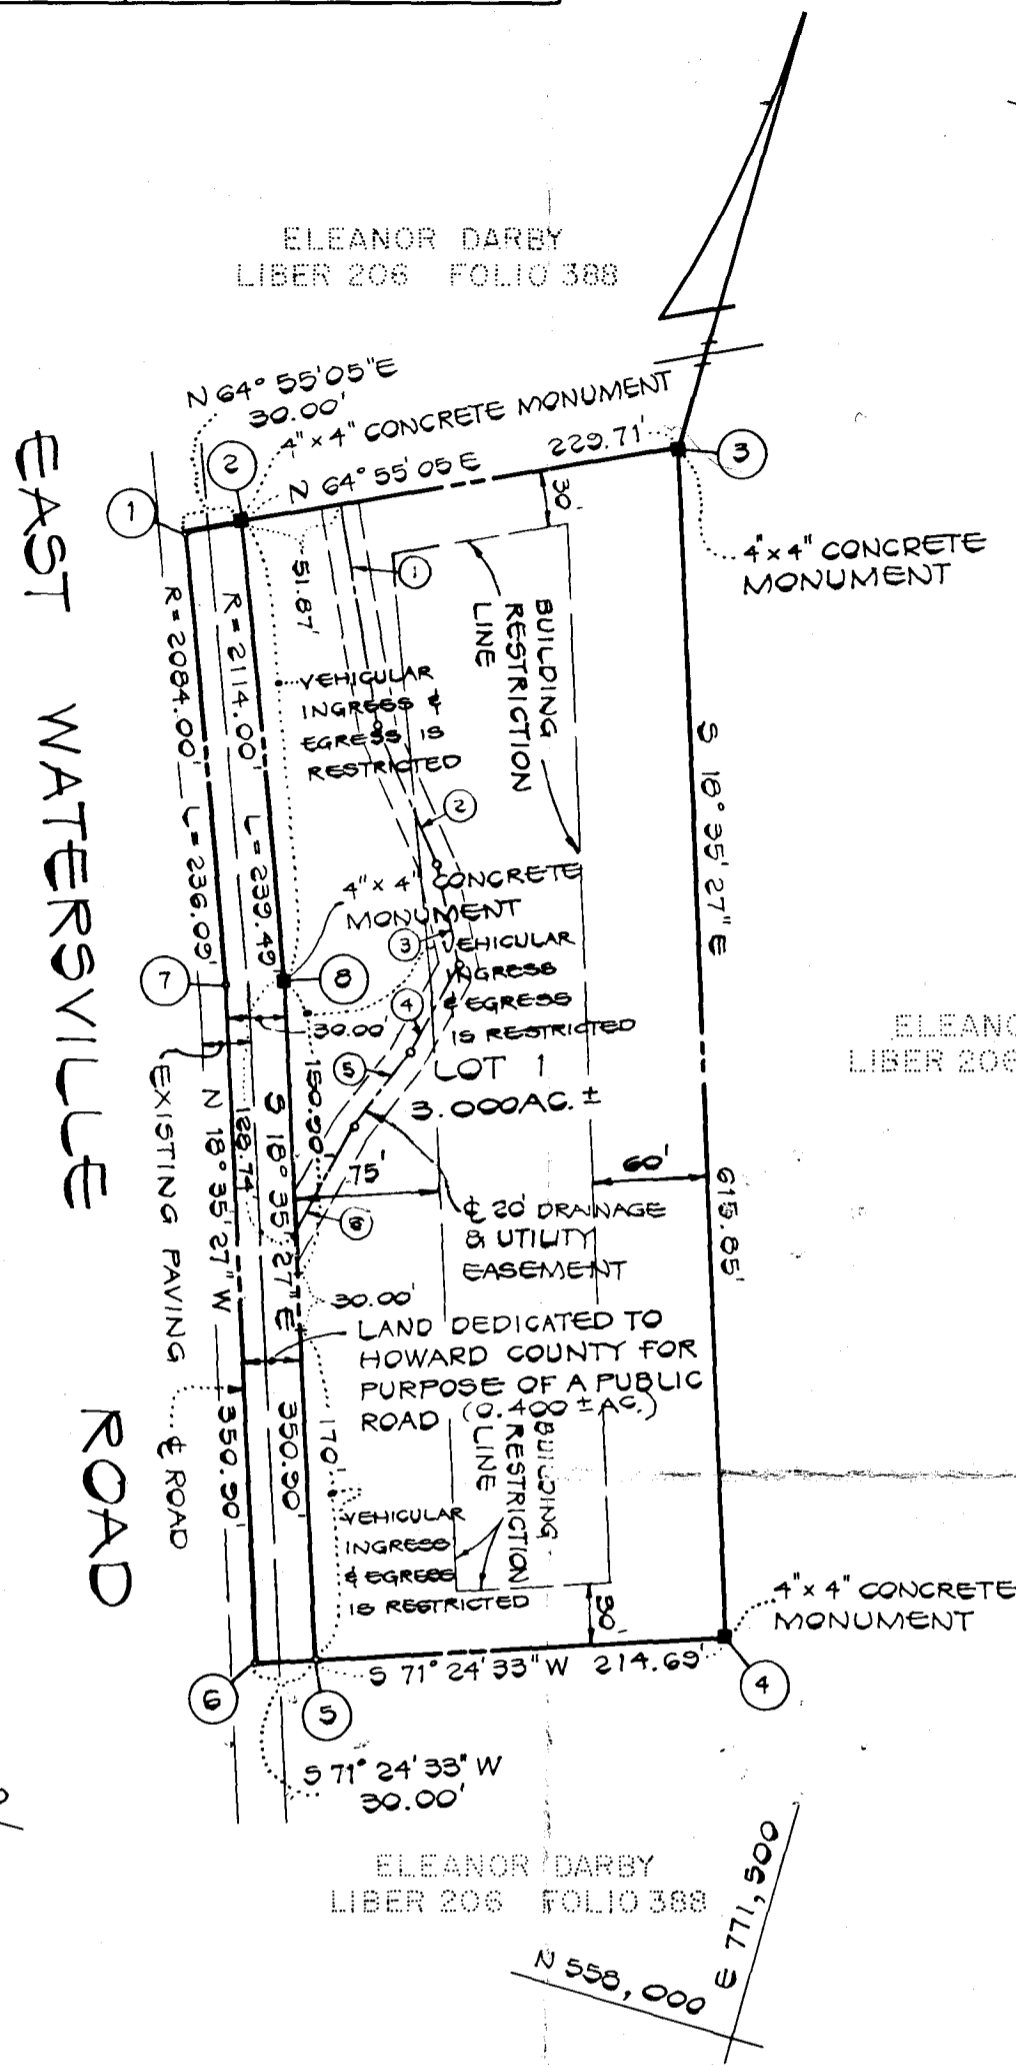

RECORDED PLAT 5649
ON 10-24-83 AMONG THE LAND RECORDS OF
HOWARD COUNTY, MD

- NOTES:
1. THE LOT SHOWN HEREON COMPLIES WITH THE MINIMUM OWNERSHIP WIDTH AND LOT AREA AS REQUIRED BY THE MARYLAND STATE DEPARTMENT OF HEALTH AND MENTAL HYGIENE.
 2. SUBJECT PROPERTY ZONED "R" PER 10/3/77 COMPREHENSIVE ZONING PLAN.
 3. EXISTING STRUCTURES ON LOT 1.
 4. FINAL PLAT SUBJECT TO VP-83-88.

FISHER, COLLINS AND CARTER, INC.
CONSULTING ENGINEERS AND LAND SURVEYORS
8388 COURT AVENUE
ELLCOTT CITY, MARYLAND 21043
TELEPHONE: (301) 461-2855

OWNER & DEVELOPER
MRS. ELEANOR DARBY
309 EAST WATERSVILLE ROAD
MT. AIRY, MARYLAND 21771

APPROVED: FOR PRIVATE WATER AND PRIVATE SEWERAGE SYSTEMS, HOWARD COUNTY HEALTH DEPARTMENT.
HOWARD COUNTY HEALTH OFFICER _____ DATE _____
APPROVED: HOWARD COUNTY OFFICE OF PLANNING AND ZONING.
DIRECTOR _____ DATE _____
APPROVED: FOR STORM DRAINAGE SYSTEMS, AND PUBLIC ROADS.
HOWARD COUNTY DEPARTMENT OF PUBLIC WORKS
DIRECTOR _____ DATE _____

OWNER'S CERTIFICATE
I, ELEANOR M. DARBY, OWNER OF THE PROPERTY SHOWN AND DESCRIBED HEREON, HEREBY ADOPT THIS PLAN OF SUBDIVISION, AND IN CONSIDERATION OF THE APPROVAL OF THIS FINAL PLAT BY THE OFFICE OF PLANNING AND ZONING, ESTABLISH THE MINIMUM BUILDING RESTRICTION LINES AND GRANT UNTO HOWARD COUNTY, MARYLAND, ITS SUCCESSORS AND ASSIGNS, (1) THE RIGHT TO LAY, CONSTRUCT AND MAINTAIN SEWERS, DRAINS, WATER PIPES AND OTHER MUNICIPAL UTILITIES AND SERVICES, IN AND UNDER ALL ROADS AND STREET RIGHT-OF-WAYS AND THE SPECIFIC EASEMENT AREAS SHOWN HEREON; (2) THE RIGHT TO REQUIRE DEDICATION FOR PUBLIC USE THE BEDS OF THE STREETS AND/OR ROADS, THE FLOODPLAINS AND OPEN SPACE WHERE APPLICABLE AND FOR GOOD AND OTHER VALUABLE CONSIDERATION, HEREBY GRANT THE RIGHT AND OPTION TO HOWARD COUNTY TO ACQUIRE THE FEE SIMPLE TITLE TO THE BEDS OF THE STREETS AND/OR ROADS AND FLOODPLAINS, STORM DRAINAGE FACILITIES AND OPEN SPACE WHERE APPLICABLE; AND (3) THE RIGHT TO REQUIRE DEDICATION OF WATERWAYS AND DRAINAGE EASEMENTS FOR THE SPECIFIC PURPOSE OF THEIR CONSTRUCTION, REPAIR AND MAINTENANCE; AND (4) THAT NO BUILDING OR SIMILAR STRUCTURE OF ANY KIND SHALL BE ERRECTED ON OR OVER THE SAID EASEMENTS AND RIGHT-OF-WAYS.
WITNESS MY/OUR HANDS THIS 8TH DAY OF July, 1983.
Eleanor M. Darby
ELEANOR M. DARBY

SURVEYOR'S CERTIFICATE
I HEREBY CERTIFY THAT THE FINAL PLAT SHOWN HEREON IS CORRECT; THAT IT IS A SUBDIVISION OF PART OF THE LANDS CONVEYED BY THOMAS C. CUNNINGHAM AND WINIFRED G. CUNNINGHAM, HIS WIFE, TO HUGH H. DARBY AND ELEANOR M. DARBY, HIS WIFE, BY DEED DATED OCTOBER 19, 1948 AND RECORDED IN THE LAND RECORDS OF HOWARD COUNTY, MARYLAND IN LIBER 206 AT FOLIO 388, AND THAT ALL MONUMENTS ARE IN PLACE, OR WILL BE IN PLACE PRIOR TO THE ACCEPTANCE OF THE STREETS AND THE SUBDIVISION BY HOWARD COUNTY AS SHOWN IN ACCORDANCE WITH THE ANNOTATED CODE OF MARYLAND, AS AMENDED.
Kerrell A. Fisher
KERRELL A. FISHER L.S. #10692
DATE July 8, 1983

LOT #1
Property of
ELEANOR DARBY
TAX MAP # 2 PARCEL # 16
4th ELECTION DISTRICT
HOWARD COUNTY, MARYLAND
SCALE: 1" = 100' JUNE 23, 1983