

4/10/85
A.M.

03-293688

Approved 4-10-85

Stayed

P 35250

PERMIT

A REPAIR

SEWAGE DISPOSAL SYSTEM

MARYLAND STATE DEPARTMENT OF HEALTH

HOWARD COUNTY
BUREAU OF ENVIRONMENTAL HEALTH
992-2330

ELLICOTT CITY

DISTRICT _____

DATE 4/8/85

INDEXED

Jenkins IS PERMITTED TO INSTALL _____ ALTER

ADDRESS Route 144, Ellicott City, Maryland 21043 PHONE 465-6646

SUBDIVISION _____ ROAD 11160 Douglas Road LOT _____

PROPERTY OWNER T. M. Franklin

ADDRESS 11160 Douglas Road
Marriottsville, Maryland 21104

IF GARBAGE GRINDER IS USED INCREASE SEPTIC TANK CAPACITY BY 50% AND ABSORPTION AREA BY 22%.

GARBAGE GRINDER? YES _____ NO _____

SEPTIC TANK CAPACITY _____ GALLONS NUMBER OF BEDROOMS _____

REPAIR - CALL FOR INSPECTION WHEN GROUND IS OPENED UP SO SANITARIAN CAN RECOMMEND REPAIR.

SEW. PERMIT VOID

AND RETURNED 4/19/85
Serial # 53477
Interior Alterations

PLANS APPROVED BY Craig Williams DATE 4/4/85

COVER NO WORK UNTIL INSPECTED AND APPROVED.

NEITHER THE HOWARD COUNTY COUNCIL NOR THE HEALTH DEPARTMENT IS RESPONSIBLE FOR THE SUCCESSFUL OPERATION OF ANY SYSTEM.

NOTE: IF TRENCH IS USED CALL FOR INSPECTION BEFORE AND AFTER PLACING GRAVEL IN TRENCH.

NOTE: NO DRY WELL SHALL EXCEED 15 FOOT IN DIAMETER. NO ABSORPTION TRENCH TO EXCEED 100 FEET IN LENGTH.

NOTE: ALL PIPE FROM HOUSE TO SEPTIC TANK MUST BE CAST IRON OR SCHEDULE 40 PVC OR ABS.

PERMIT VOID AFTER THREE YEARS.


NOTE: INSTALL STAND PIPE ON SEPTIC TANK AND DRY WELL. STAND PIPES MUST BE 6 INCHES IN DIAMETER. CAST IRON, CONCRETE OR TERRA COTTA, OR PVC OR ABS ACCEPTED. IF TOP OF SEPTIC TANK IS DEEPER THAN 3 FEET MANHOLE TO GRADE REQUIRED.

***INSTALLER IS RESPONSIBLE FOR OBTAINING FINAL APROVAL ON THIS PERMIT**

*CALL 992-2330 FOR INSPECTION OF SEPTIC SYSTEMS.

EH - 2-1082

P 35250

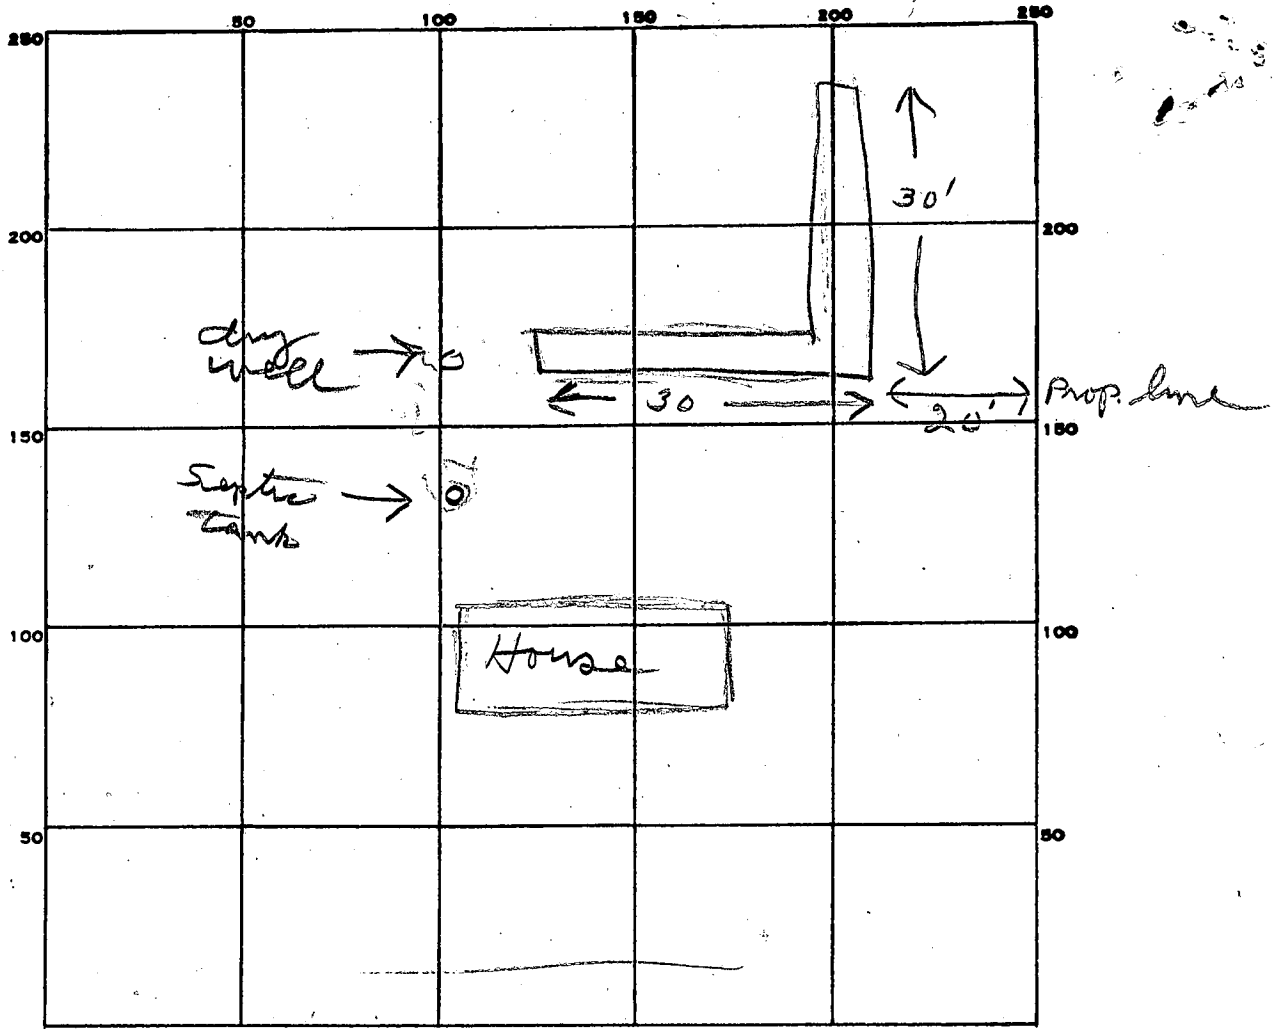

INDICATE NORTH - NAME ADJOINING ROADWAY AS BASE LINE.

Douglas Rd

PERMIT CARD _____

SEPTIC TANK, LEVEL _____

CLEANOUTS _____

DISTRIBUTION BOX, LEVEL _____

TILE FIELD, DEPTH 10 FT. TRENCH WIDTH 2 FT.

GRAVEL DEPTH 6 1/2 IN. TOTAL LENGTH 60 FT.

6.8
3900

NUMBER OF TRENCHES 1 TOTAL BOTTOM AREA 390

SEEPAGE PITS, INSIDE DIAMETER _____ FT. DEPTH BELOW INLET _____ FT.

ABSORBENT AREA 390 SQ. FT.

REMARKS EXISTING DAYWELL WITH VERY SHALLOW TRENCH RUNNING DOWN HILL.

SHALLOW TRENCH TO BE DISCONNECTED AND 60' TRENCH 9 FT DEEP W/TH 6 FT STONE TO BE ADDED. CW

4-10-85 TRENCH OK TO ADD STONE. CW

4-10-85 OK TO COVER ALL WORK. JS

DATE SYSTEM APPROVED 4-10-85

INSPECTOR Stager

APPLICATION

HOWARD COUNTY

PERMIT APPLICATION

SERIAL NUMBER
53477

DEPARTMENT OF INSPECTIONS, LICENSES & PERMIT
3430 COURT HOUSE DRIVE, ELICOTT CITY, MARYLAND 21043

BUILDING ADDRESS (HOUSE NO., STREET, TOWN OR AREA)
11170 Douglas Road
Merriottsville, Md 21104

GRADING/SEDIMENT CONTROL YES NO
SDP #

DESCRIPTION OF WORK AUTHORIZED
Build bedroom in basement
Build powder room 1st floor
Build closet 1st floor
Studs, sheetrock, trim, partitions

LOT NO.	PARCEL NO.	SEC.	AREA	BLOCK NO.	LIBER.	FOLIO
SUB DIVISION		ZONE	ZONE MAP	ELEC. DIST.	CENSUS TR.	

OWNER NAME AND ADDRESS
Thomas Franklin
Same as above
PHONE NO.

SIZE OF BLDG.	FRONT	DEPTH	HEIGHT
35' x 22'	30'	22'	1 story

OCCUPANT'S NAME AND ADDRESS
Thomas Franklin
11170 Douglas Road
PHONE NO.

TYPE OF BLDG.	AREA	VOLUME	ROOF
B. ROOMS			
ROOMS			
BATHS			
FIREPLACES			

ARCHITECT OR ENGINEER'S NAME AND ADDRESS
None
PHONE NO.

FOOTINGS	FOUNDATION	S. WALLS

CONTRACTOR'S NAME AND ADDRESS
Green Associates
591 Gather Road
Sikeville, Md.
PHONE NO. 442-1674

UTILITIES				
WATER/WELL	SEWER/SEPTIC	GAS	ELECTRICITY	TYPE OF HEAT
<input checked="" type="checkbox"/>	<input checked="" type="checkbox"/>			Oil
				AC No

I have carefully examined and read this application and know the same is true and correct, and that in doing this work, all provisions of Howard County Ordinances and the State Laws of Maryland will be complied with, whether specified or not; and I will notify the Department of Inspections, and Permits twenty-four hours in advance when I am ready for the inspections called for elsewhere in the application; and that no work will be covered up until such inspections have been completed with.

EXISTING USE
Residential SFD
PROPOSED USE
Residential SFD

Thomas Franklin
SIGNATURE
TITLE
DATE 4/19/94

EST. CONSTRUCTION COST \$12,000
LICENSE NUMBER 25791
PERMIT FEE

FOR OFFICE USE ONLY

DISTRICT IN FEET FROM R/W LINE TO FRONT BUILDING LINE _____
SIDE YARD _____
(DISTANCE IN FEET FROM SIDE BLDG. LINE TO SIDE PROPERTY LINE)
TO SIDE BUILDING LINE _____
DISTANCE IN FEET, REAR YD. REQUIRING SET
BACK _____ (CORNER LOT ONLY) SDP #

FUNCTION	DATE	SIGNATURE APPROVAL
ZONING/PLANNING	<input checked="" type="checkbox"/>	
SHA		
SEDIMENT/GRADING		
BUILDING OFFICIAL	<input checked="" type="checkbox"/>	
WATER & SEWER		
HEALTH DEPT.	4/19/94	Mark E. R. Pflin
FIRE PROTECTION		
STORM WATER MGMT	<input checked="" type="checkbox"/>	

Check payable to: DIRECTOR OF FINANCE OF HOWARD COUNTY

CAUTION
To be in construction before a permit placard has been placed and displayed on the job is a violation of the law.
Use and occupancy permit must be applied for 10 days before it will be issued.

IMPORTANT: PLEASE SHOW ZIP CODES AND AREA CODES WHEREVER REQUIRED.
APPROVED _____ DATE _____
Distribution of Copies:
White - Building Official
Green - Planning & Zoning
Yellow - Engineering
Pink - Health Dept.
Gold - S.H.A.

4/19/94 MR. GREEN REPORTS INTERIOR CHANGES ONLY;
T/C W/OWNER INDICATES EX. HOUSE IS
ONLY 2 BR; OK TO DESIGN BP (NO SITE
PLAN ACCOMPANYING BP APPL.
MR