

APPROVED
5/7/85
RH

P 35327
A REPAIR

PERMIT

SEWAGE DISPOSAL SYSTEM

MARYLAND STATE DEPARTMENT OF HEALTH

HOWARD COUNTY
BUREAU OF ENVIRONMENTAL HEALTH
992-2330

03-287459

ELLICOTT CITY

DISTRICT _____

DATE 5/2/85

Jack Fyock

IS PERMITTED TO INSTALL _____ ALTER X

ADDRESS _____ PHONE 988-9270

SUBDIVISION _____ ROAD 2675 Pfefferkorn LOT _____

PROPERTY OWNER _____
1st Houston Left Part Bridge
Virginia Levering 583-8826

ADDRESS _____
744 Dulaney Valley Road 825-4242
Towson, Maryland

IF GARBAGE GRINDER IS USED INCREASE SEPTIC TANK CAPACITY BY 50% AND ABSORPTION AREA BY 22%.

GARBAGE GRINDER? YES _____ NO _____

SEPTIC TANK CAPACITY _____ GALLONS NUMBER OF BEDROOMS _____

REPAIR - CALL FOR INSPECTION WHEN GROUND IS OPENED UP SO SANITARIAN CAN RECOMMEND

REPAIR. TO REPLACE EXISTING STRAIGHT PIPE DISCHARGE,

CONSTRUCT LEACHING B60 7' x 70' BOTTOM OF LOW SIDE OF B60

NO DEEPER THAN 3'

8' VERTICAL HOLE - SAND CHANGING TO ROCK AT 8' CW

PLANS APPROVED BY Craig Williams DATE 5/7/85

COVER NO WORK UNTIL INSPECTED AND APPROVED.

NEITHER THE HOWARD COUNTY COUNCIL NOR THE HEALTH DEPARTMENT IS RESPONSIBLE FOR THE SUCCESSFUL OPERATION OF ANY SYSTEM.

NOTE: IF TRENCH IS USED CALL FOR INSPECTION BEFORE AND AFTER PLACING GRAVEL IN TRENCH.

NOTE: NO DRY WELL SHALL EXCEED 15 FOOT IN DIAMETER. NO ABSORPTION TRENCH TO EXCEED 100 FEET IN LENGTH.

NOTE: ALL PIPE FROM HOUSE TO SEPTIC TANK MUST BE CAST IRON OR SCHEDULE 40 PVC OR ABS.

PERMIT VOID AFTER THREE YEARS.

NOTE: INSTALL STAND PIPE ON SEPTIC TANK AND DRY WELL. STAND PIPES MUST BE 6 INCHES IN DIAMETER. CAST IRON, CONCRETE OR TERRA COTTA, OR PVC OR ABS ACCEPTED. IF TOP OF SEPTIC TANK IS DEEPER THAN 3 FEET MANHOLE TO GRADE REQUIRED.


***INSTALLER IS RESPONSIBLE FOR OBTAINING FINAL APPROVAL ON THIS PERMIT**

*CALL 992-2330 FOR INSPECTION OF SEPTIC SYSTEMS.

EH - 2-1082

A
Repair
35327

5/7/85
H.S.A.P.

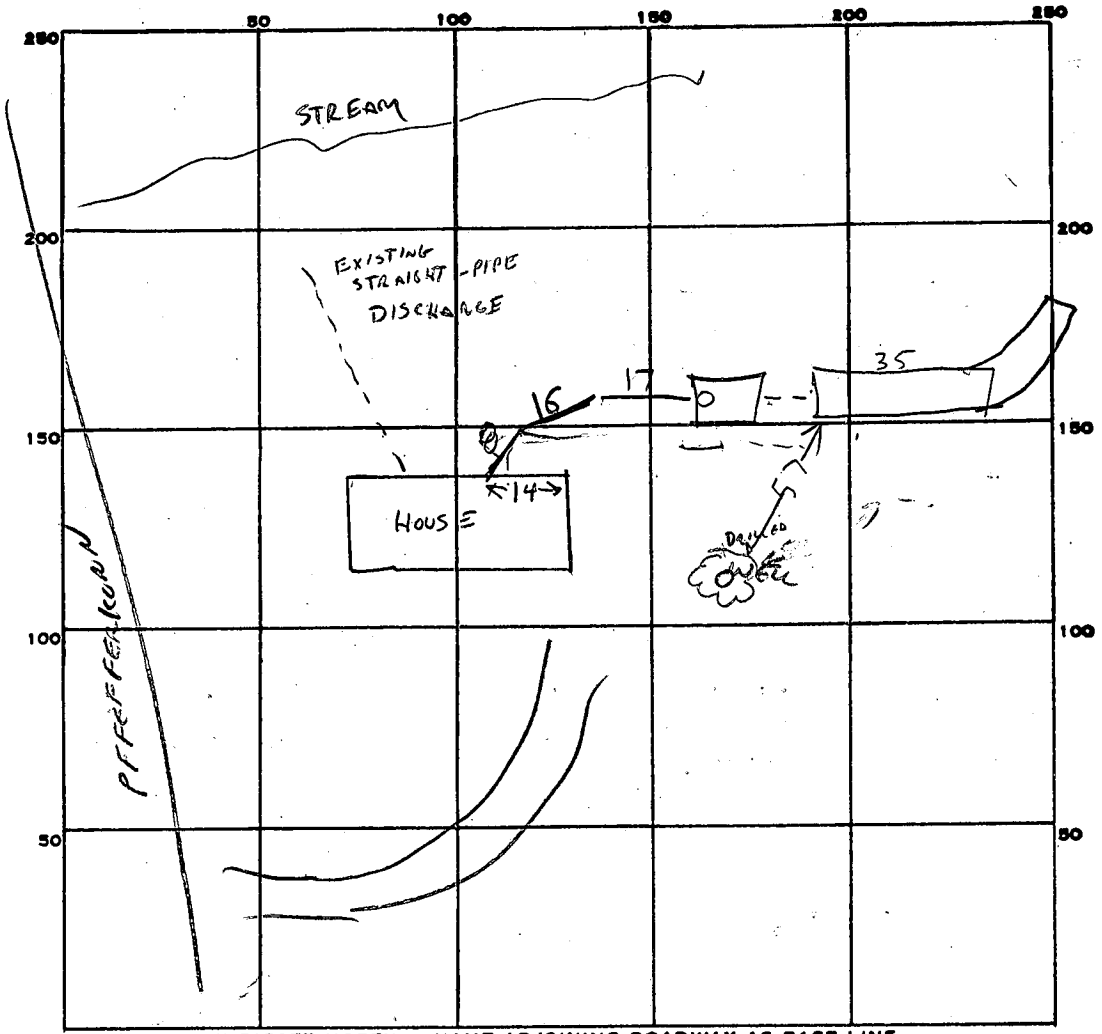

PERMIT CARD _____

SEPTIC TANK, LEVEL OK 1500
TOP 1 FT BOG

CLEANOUTS OK pm

DISTRIBUTION BOX, LEVEL _____

TILE FIELD, DEPTH 3-5 FT. TRENCH WIDTH 7 FT.

GRAVEL DEPTH 2 FT IN. TOTAL LENGTH 3570 FT.

NUMBER OF TRENCHES 1 TOTAL BOTTOM AREA 536

SEEPAGE PITS, INSIDE DIAMETER _____ FT. DEPTH BELOW INLET _____ FT.

ABSORBENT AREA _____ SQ. FT.

REMARKS 5/7/85 - AM - OK TO COVER HOUSE

BOWER FINISH BED

5/7/85 - BED FINISHED AM

DATE SYSTEM APPROVED

5/7/85

INSPECTOR

Raymond Hodges