

1:30 PM

APPLICATION

SEWAGE DISPOSAL TESTING

A 33932

STATE OF MARYLAND - DEPARTMENT OF HEALTH AND MENTAL HYGIENE

P _____

HOWARD COUNTY HEALTH DEPARTMENT
ENVIRONMENTAL HEALTH SERVICES

DISTRICT _____

P. O. BOX 476 ELLICOTT CITY, MARYLAND 21043
TELEPHONE: 992-2330

DATE _____

TO: THE COUNTY HEALTH OFFICER
ELLICOTT CITY, MARYLAND

I, HEREBY, APPLY FOR THE NECESSARY TEST IN ORDER TO CONSTRUCT (OR RECONSTRUCT) A SEWAGE DISPOSAL SYSTEM.

PROPERTY OWNER Robert J. Sparrow

ADDRESS 2921 Chestnut Hill Dr. 21043 PHONE 465-0207

PROPERTY LOCATION:

SUBDIVISION SPARROW PROPERTY LOT NO. # 2

ROAD AND DESCRIPTION Behind 2921 CHESTNUT Hill Dr

SIZE OF LOT .581 AC TYPE BLDG. 3/4
(NUMBER OF BEDROOMS)

THE SYSTEM INSTALLED UNDER THIS APPLICATION IS ACCEPTABLE ONLY UNTIL PUBLIC FACILITIES BECOME AVAILABLE. I FULLY UNDERSTAND THE FEE CONNECTED WITH THE FILING OF THIS PERC TEST APPLICATION IS NON-REFUNDABLE UNDER ANY CIRCUMSTANCES. I ALSO AGREE TO COMPLY WITH ALL M.O.S.H.A. REQUIREMENTS IN TESTING THIS LOT.

[Handwritten Signature]
(SIGNATURE OF APPLICANT)

APPROVED BY _____ FOR _____ DATE _____

REJECTED BY _____ FOR _____ DATE _____

HOLD PENDING FURTHER TESTS _____ DATE _____

REASONS FOR REJECTION OR HOLDING 5/31/24 SLOW PERC & UNDERGROUND WATER RA

R. BARTH SAID C WILLIAMS SAID ONLY
THIS IS NOT A PERMIT
3 HOLE @ 5000 SPTF NEEDED

APPLICATION

SEWAGE DISPOSAL TESTING

A 93932

STATE OF MARYLAND - DEPARTMENT OF HEALTH AND MENTAL HYGIENE

P _____

HOWARD COUNTY HEALTH DEPARTMENT
ENVIRONMENTAL HEALTH SERVICES

P. O. BOX 476 ELLICOTT CITY, MARYLAND 21043
TELEPHONE: 992-2330

DISTRICT 2nd.

DATE 5/28/84

TO: THE COUNTY HEALTH OFFICER
ELLICOTT CITY, MARYLAND

I, HEREBY, APPLY FOR THE NECESSARY TEST IN ORDER TO CONSTRUCT (OR RECONSTRUCT) A SEWAGE DISPOSAL SYSTEM.

PROPERTY OWNER Robert J. Sparrow

ADDRESS 2921 Chestnut Hill Dr. 21043 PHONE 465-0207

PROPERTY LOCATION:

SUBDIVISION SPARROW PROPERTY LOT NO. #2

ROAD AND DESCRIPTION BEHIND 2921 CHESTNUT HILL DR.

SIZE OF LOT .581 AC TYPE BLDG. 3/4
(NUMBER OF BEDROOMS)

THE SYSTEM INSTALLED UNDER THIS APPLICATION IS ACCEPTABLE ONLY UNTIL PUBLIC FACILITIES BECOME AVAILABLE. I FULLY UNDERSTAND THE FEE CONNECTED WITH THE FILING OF THIS PERC TEST APPLICATION IS NON-REFUNDABLE UNDER ANY CIRCUMSTANCES. I ALSO AGREE TO COMPLY WITH ALL M.O.S.H.A. REQUIREMENTS IN TESTING THIS LOT.

Robert J. Sparrow
(SIGNATURE OF APPLICANT)

APPROVED BY _____ FOR _____ DATE _____

REJECTED BY _____ FOR _____ DATE _____


HOLD PENDING FURTHER TESTS _____ DATE _____

REASONS FOR REJECTION OR HOLDING _____




OWNER REQUESTS LETTER OF APPROVAL.

THIS IS NOT A PERMIT

Lot 2

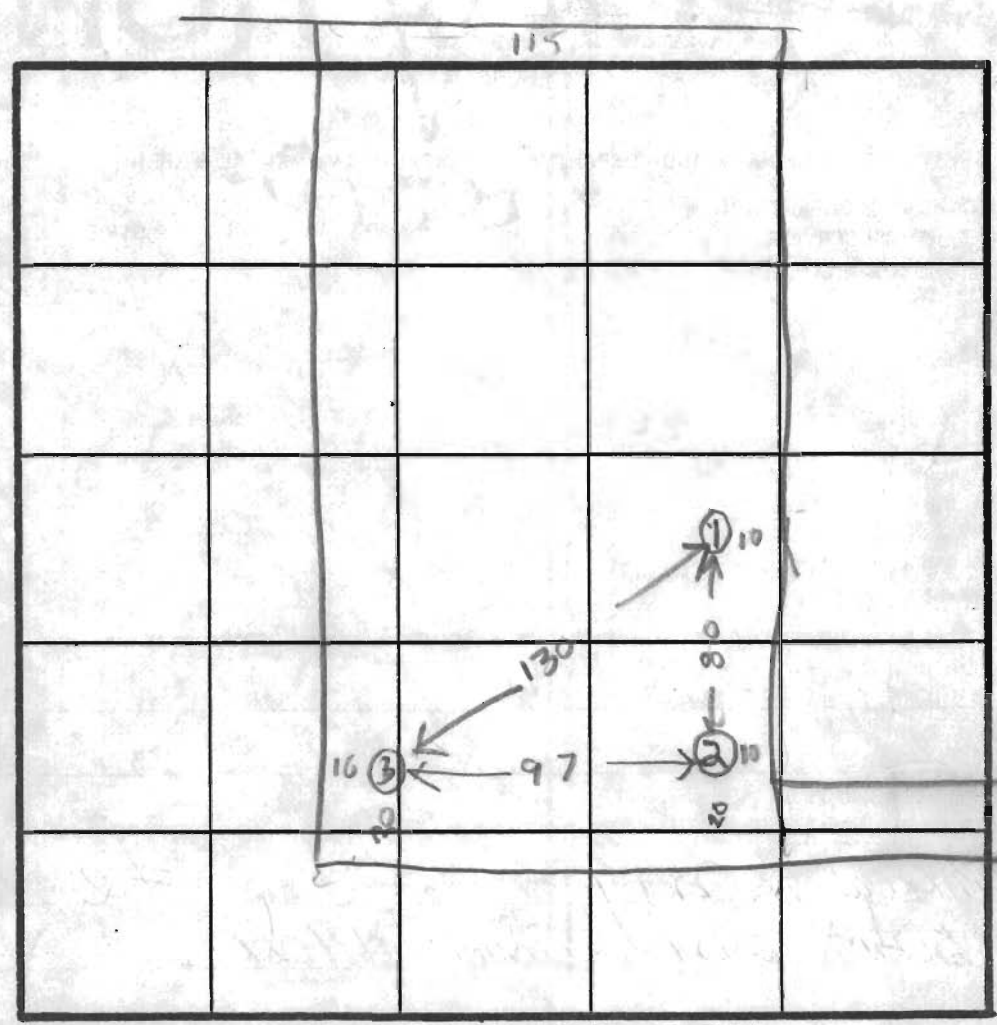

HOLE ELEVATIONS
 ①②=HIGH
 ③=LOW

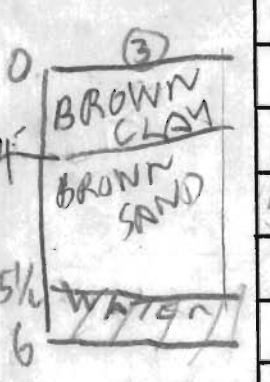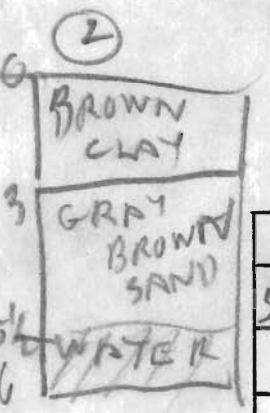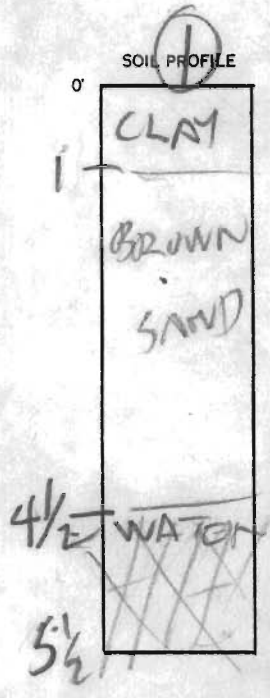

INDICATE NORTH - NAME ADJOINING ROADWAY AS BASE LINE.

DATE	TEST NO.	DEPTH	PRE-WET		TEST - 1" DROP		TIME
			START	STOP	START	STOP	
5/31/84	1V	5 1/2	WATER		4 1/2	F7	
	1S	2	154	156	158	202	4
	2V	6	WATER		5 1/2		
	2S	3	210	235	235	312	37 min
	3V	6	WATER		5 1/2		
5/31/84	3S	2 1/2	226	252	232	324	32

REMARKS: OWNER WANTS SPECIAL APPROVAL BECAUSE HE THINKS PUBLIC SEWER WILL BE AVAILABLE IN NEAR FUTURE

TYPE OF SOIL: B HODGES

TESTED BY: R BARTH WESLEY JOHNSON

EH-12-1079

LOT 1


COLDBERG

LOT 2

PLAT NO. 5108

LOT 3

PROPERTY

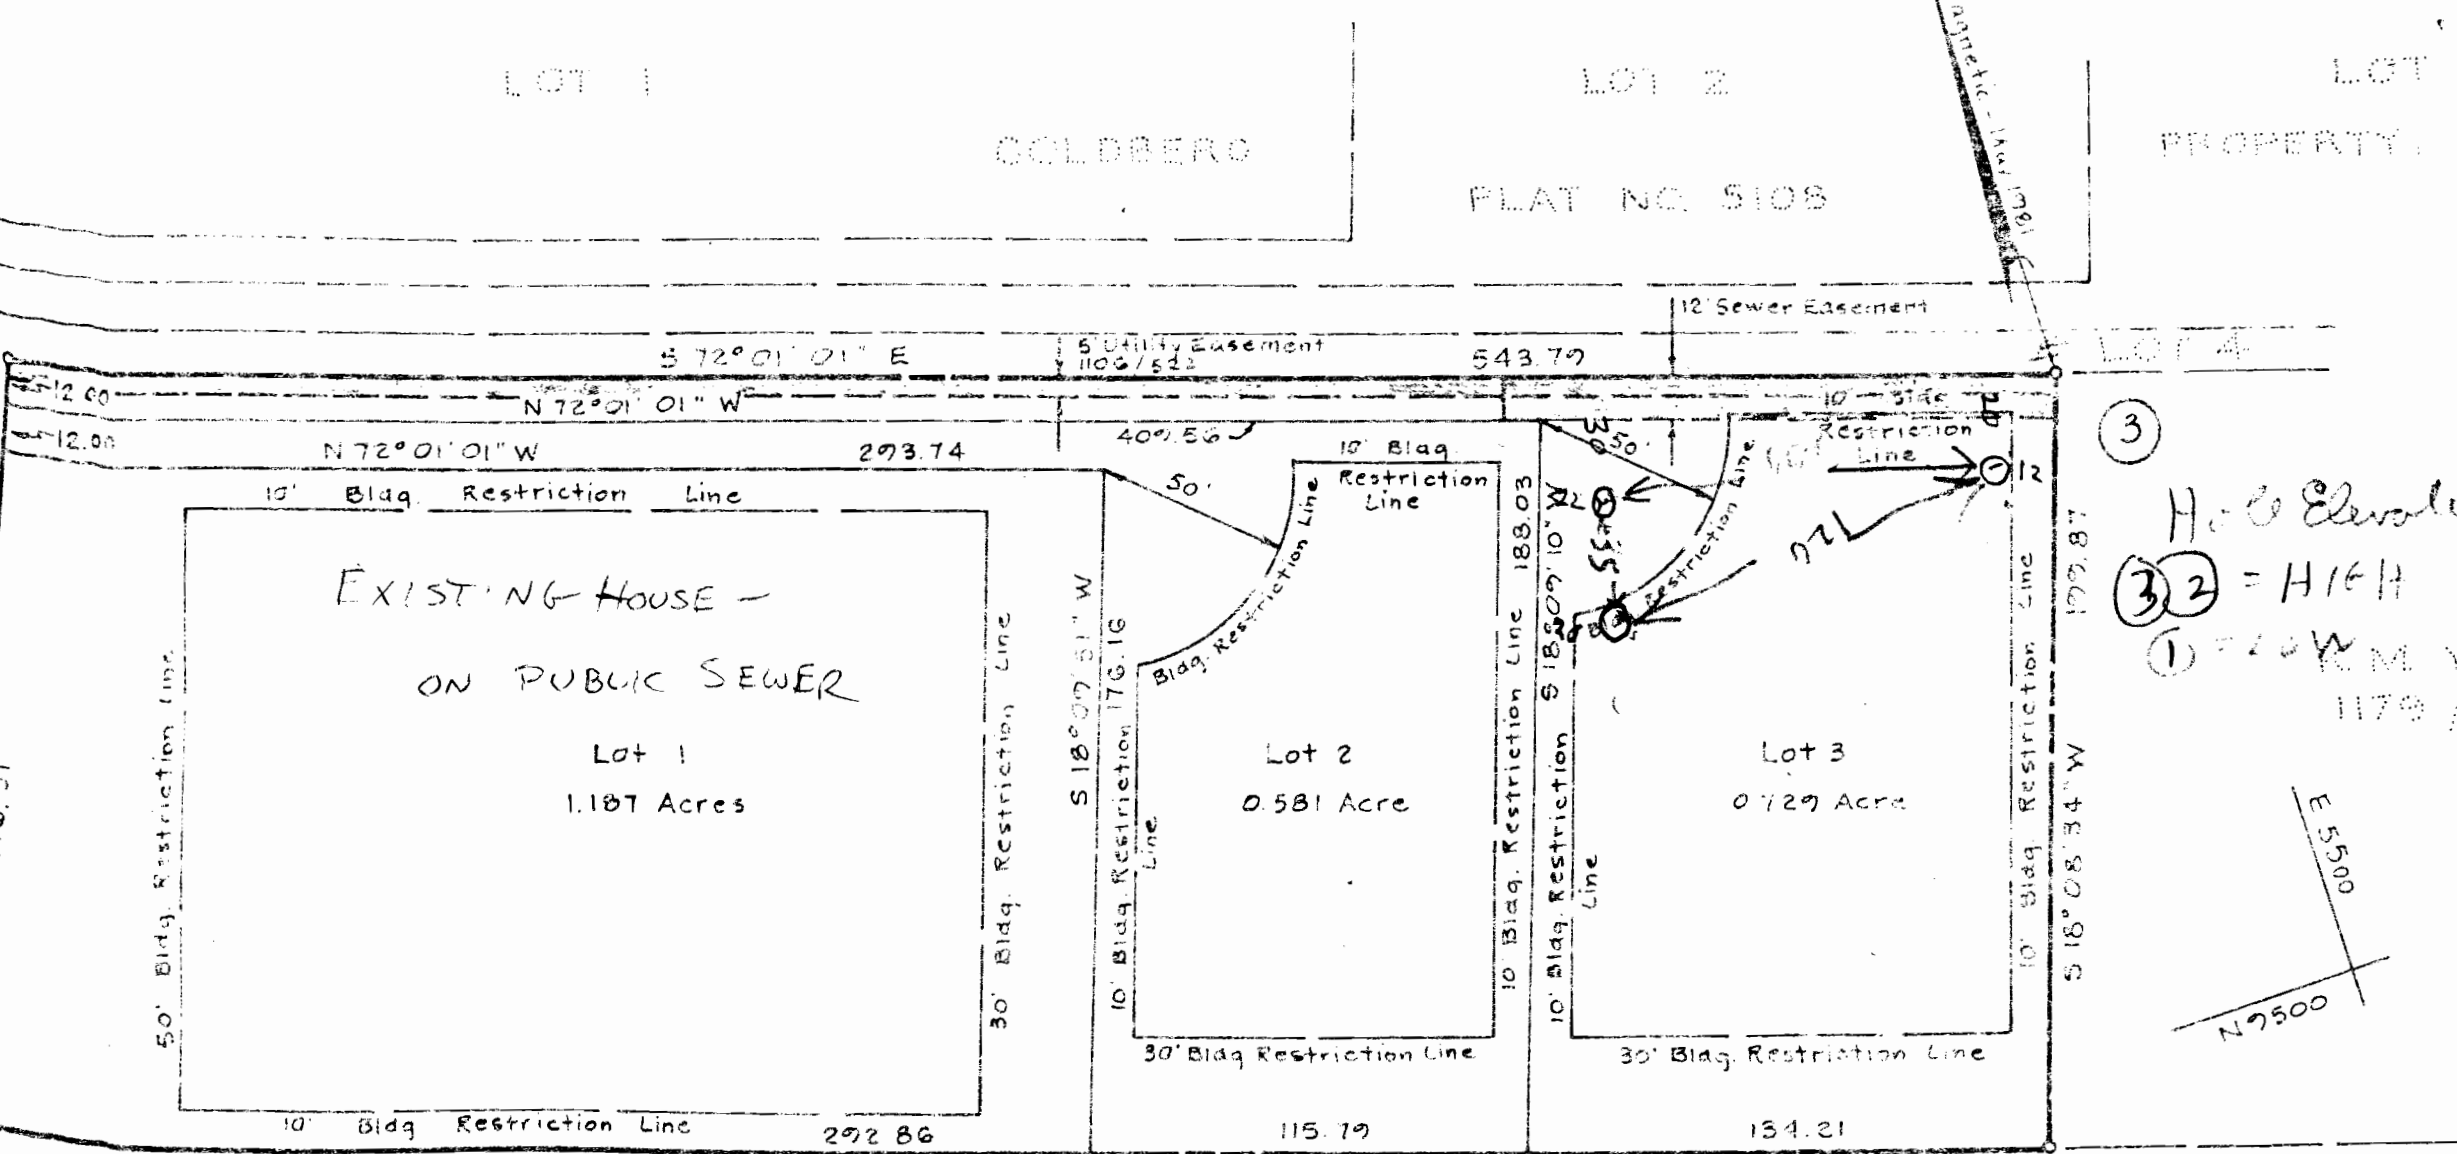

LOT 1

CHESTNUT

LOT 3

P.B. 4

F. 18

LOT 5

HILL

E 5000

Owne

Robar
292
Ellicat


LOT 1

LOT 2

PROPERTY

GOLDBERG

FLAT NO. 5108

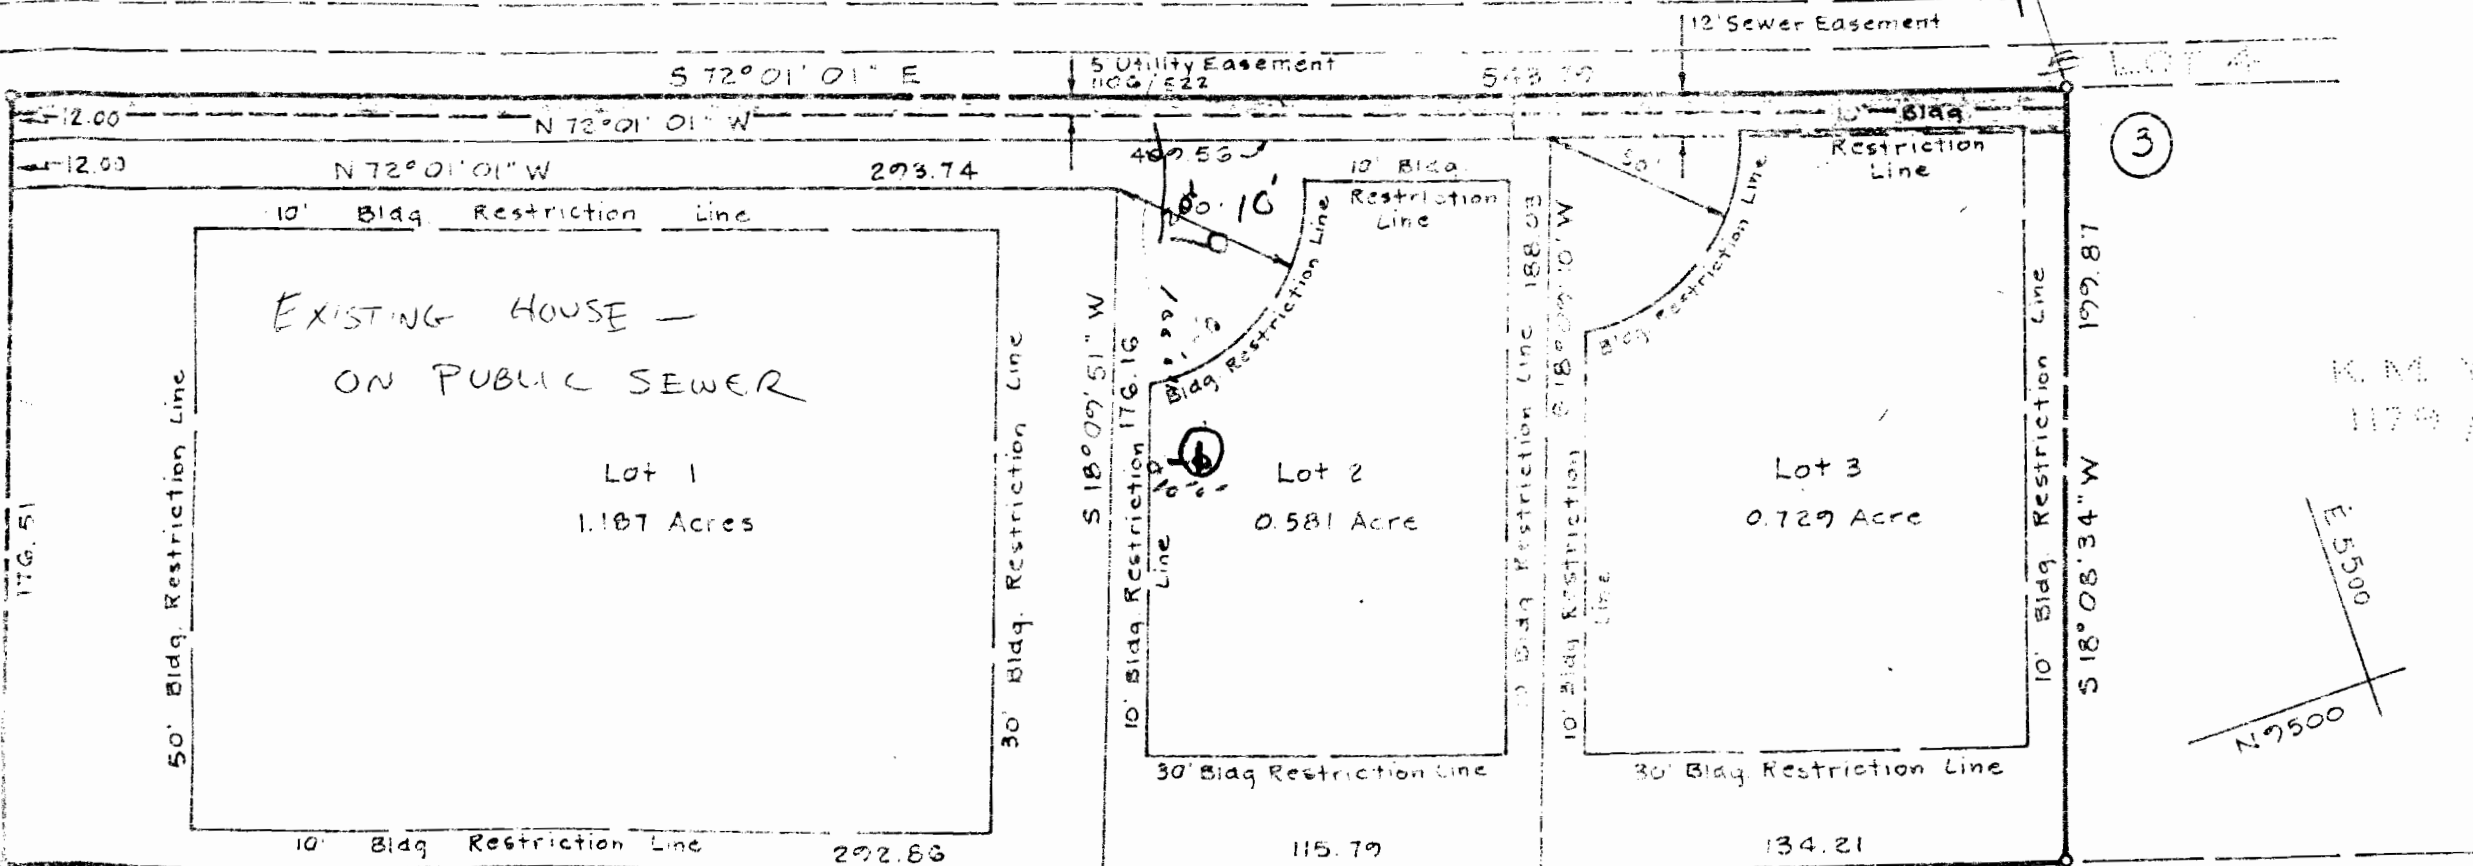

EXISTING HOUSE -
ON PUBLIC SEWER

Lot 1
1.187 Acres

Lot 2
0.581 Acre

Lot 3
0.729 Acre

3

K. M. YUREK
1179 / 385

E 5500
N 9500

LOT 1

CHESTNUT

LOT 3

P. B. 4 P. 18

LOT 5

HILL

4

E 5000

Owner
Robert
2921
Ellicott

HOWARD COUNTY HEALTH DEPARTMENT

JOYCE M. BOYD, M.D., M.P.H.
COUNTY HEALTH OFFICER



BUREAU OF ENVIRONMENTAL HEALTH
TIBER PLACE
8306B FORREST STREET
ELLICOTT CITY, MARYLAND 21043
TELEPHONE: 992-2330

June 4, 1984

Mr. Robert Sparrow
2921 Chestnut Hill Drive
Ellicott City, Maryland 21043

RE: Percolation Testing
Sparrow Property
Lots 2 and 3

Dear Mr. Sparrow:

This is to certify that the above referenced properties failed the percolation tests conducted on June 1, 1984 due to a clay barrier near the surface and a high water table across the lot.

Consequently these properties are considered non-buildable until public sewer becomes available.

If you have any questions relative to this matter, please contact me at 992-2330.

Very truly yours,

Craig Williams, Sanitarian
Water and Sewerage Program

CW:jr

cc: Planning and Zoning Office

GEORGE F. NEIMEYER
DIRECTOR
992-2400

Deaf TDD Number 992-2323




Bureau of Engineering
William E. Riley, Chief
Bureau of Environmental Services
James M. Irvin, Chief
Bureau of Facilities
John Zimyer, Chief
Bureau of Highways
Granville W. Wehland, Chief
Bureau of Inspections, Licenses, and Permits
M. Robert Gemmill, Chief
Bureau of Utilities
Robert M. Beringer, Chief

DEPARTMENT of PUBLIC WORKS of HOWARD COUNTY
3430 COURT HOUSE DRIVE, ELLICOTT CITY, MARYLAND 21043

May 28, 1984

MEMORANDUM

TO: Dr. Joyce M. Boyd
County Health Officer

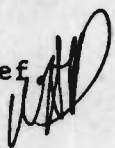FROM: Wayne H. Davis, Acting Chief
Utility Design Division
Bureau of Engineering 

SUBJECT: Chestnut Hills Collector
Capital Project S-6116

The subject effort was expanded in scope to extend the eight-inch sewer approximately 500 linear feet. This extension will provide sewer service to lots 2, 3 and 4 of the Goldberg property, east of Chestnut Hill Drive.

This expanded scope was approved by the County Council on May 24, 1984. The Utility Design Division of the Bureau of Engineering will advertise in July of 1984 for the engineering services to design this 500 linear foot extension.

If further information is required, contact David Woessner, Project Manager, at 992-2070.

WHD/Wa
L2A12

WASTE-NOT



RECYCLE

THOMAS G. HARRIS, JR.
DIRECTOR
992-2350

DEAF TELETYPE NUMBER
992-2323



DIVISION OF LAND DEVELOPMENT
AND ZONING ADMINISTRATION
JOHN W. MUSSELMAN, CHIEF
992-2353

DIVISION OF COMPREHENSIVE AND
TRANSPORTATION PLANNING
AMAR S. BANDEL, CHIEF
992-2357

OFFICE OF PLANNING & ZONING OF HOWARD COUNTY

GEORGE HOWARD BUILDING
3430 COURT HOUSE DRIVE, ELLICOTT CITY, MARYLAND 21043-4589

June 14, 1984

Ms. Virginia L. Donnelly
2921 Chestnut Hill Drive
Ellicott City, MD 21043

RE: Address Change

Dear Ms. Donnelly:

This office regrets the need to change your address, but a recent study of your property has indicated that your address is in error as the number is out of proper sequence as a result of the Sparrow Property Subdivision.

OLD/INCORRECT ADDRESS:


<u>2921</u>	,	<u>Chestnut Hill Drive</u>
(House/Bldg. No.)		(Street, Road, etc. Name)
<u>Lot 1, Map 18</u>	,	<u>Sparrow Property (F-84-185)</u>
(Lot/Par.# & Tax Map #)		(Subdivision Name)

NEW/CORRECT ADDRESS:

<u>2931</u>	,	<u>Chestnut Hill Drive</u>
(House/Bldg.No.)		(Street, Road, etc. Name)
<u>Lot 1, Map 18</u>	,	<u>Sparrow Property (F-84-185)</u>
(Lot/Par.# & Tax Map #)		(Subdivision Name)

The recipient of this letter will be responsible for notifying their local post office, Gas & Electric Company and the telephone company regarding this change of address. We regret any inconvenience this change may cause you, but we feel it is in the best interest of yourself, the post office and most importantly, the fire and police departments, to locate your property in case of emergencies. Should you have any further questions regarding this address change, please contact Len Sheubrooks, 992-2352, at your convenience.

Very truly yours,

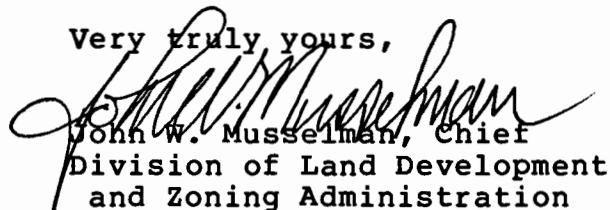
John W. Musselman, Chief
Division of Land Development
and Zoning Administration

JWM/LS:rll

cc: Tax Assessment
Water Billing
Police Department
Building Permits
Bureau of Eng.-Land Dev.

Central Communications
Fire Department
Bd. of Supervisors of Elections
Health Dept.

CERTIFIED MAIL