

7-24-90
3 PM

05-374928

PERMIT

P 49952
A 34922
DISTRICT 5th
DATE 05/18/90
DATE SYSTEM APPROVED 7/25/90
INSPECTOR B.H.

SEWAGE DISPOSAL SYSTEM

MARYLAND STATE DEPARTMENT OF HEALTH

HOWARD COUNTY
BUREAU OF ENVIRONMENTAL HEALTH
461-9933

INDEXED

Paul Schissler/South Carroll Backhoe, Inc. IS PERMITTED TO INSTALL ALTER

ADDRESS 4410 Salem Bottom Road, Westminster, Maryland PHONE 875-4197

SUBDIVISION Glenelg Manor II ROAD 12873 Folly Quarter Rd LOT 27A

PROPERTY OWNER Albert P. and Kathleen M. Free

ADDRESS _____

~~IF GARBAGE GRINDER IS USED INCREASE SEPTIC TANK CAPACITY BY 50% AND ABSORPTION AREA BY 25%~~

~~GARBAGE GRINDER~~ YES NO

BLDG. PERMIT SIGNED
AND RETURNED 7/19/90
Serial # 55200 *Supplement*

SEPTIC TANK CAPACITY 1250 GALLONS NUMBER OF BEDROOMS 4

TRENCHES - 180 sq. ft. per bedroom. Trench to be 3 feet wide. Inlet 3 feet below original grade. Bottom maximum depth 5 feet below original grade. Effective area begins at 3 feet below original grade. 2 feet of stone below distribution pipe.

LOCATION - Place the distribution box 210 feet from the center of Court G and 80 feet from the left side of the lot as seen when facing the lot from Court G. Run the trenches toward both side lines.

NOTE - No trench to exceed 100 feet in length. Provide 6" - 8" diameter cleanout and cap to grade or above on septic tank. Ok/cw

180
PLANS APPROVED BY Raymond Hodges DATE 10/17/89

COVER NO WORK UNTIL INSPECTED AND APPROVED


NEITHER THE HOWARD COUNTY COUNCIL NOR THE HEALTH DEPARTMENT IS RESPONSIBLE FOR THE SUCCESSFUL OPERATION OF ANY SYSTEM.

- NOTE: CLEANOUT REQUIRED EVERY 70 FEET OF SEWER LINE AND/OR AT 90° SWEEPS IN LINES FROM HOUSE TO DRAIN FIELDS
- NOTE: ALL PARTS OF SEPTIC SYSTEMS (I.E. TANK, DISTRIBUTION BOX, TRENCHES) TO BE 100 FEET FROM WELL (UNLESS OTHERWISE SPECIFICALLY AUTHORIZED)
- NOTE: IF DEEP TRENCHES ARE USED CALL FOR INSPECTION BEFORE AND AFTER PLACING GRAVEL IN TRENCHES
- NOTE: NO DRY WELL SHALL EXCEED 15 FOOT IN DIAMETER NO ABSORPTION TRENCH TO EXCEED 100 FEET IN LENGTH.
- NOTE: ALL PIPE FROM HOUSE TO SEPTIC TANK MUST BE CAST IRON OR SCHEDULE 40 PVC OR ABS
- PERMIT VOID AFTER TWO YEARS
- NOTE: INSTALL STAND PIPE ON SEPTIC TANK AND DRY WELL. STAND PIPES MUST BE 6 INCHES IN DIAMETER. CAST IRON, CONCRETE OR TERRA COTTA OR PVC OR ABS ACCEPTED. IF TOP OF SEPTIC TANK IS DEEPER THAN 3 FEET, MANHOLE TO GRADE REQUIRED
- NOTE: DISTRIBUTION BOXES MUST HAVE BAFFLES

***INSTALLER IS RESPONSIBLE FOR OBTAINING FINAL APROVAL ON THIS PERMIT**

*CALL 461-9933 FOR INSPECTION OF SEPTIC SYSTEMS.

A 24922

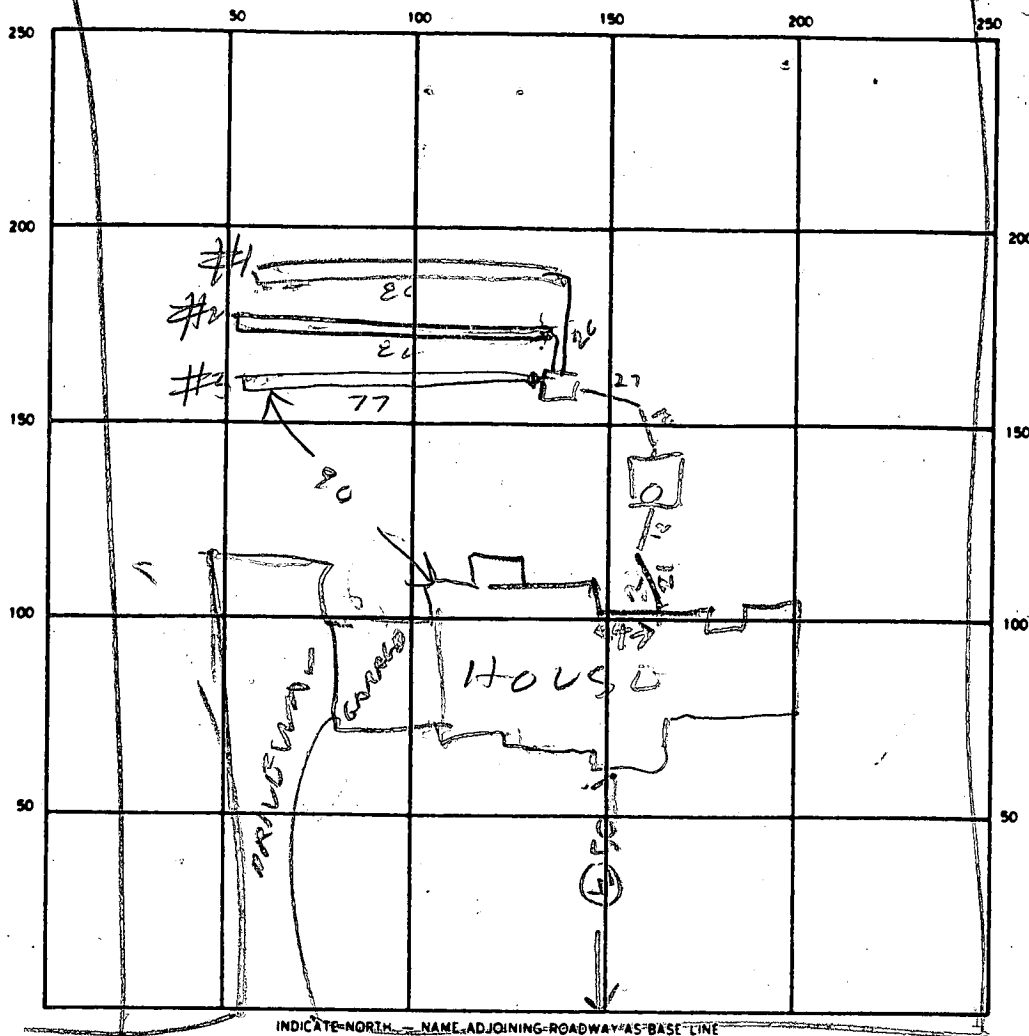

INDICATE NORTH - NAME ADJOINING ROADWAY AS BASE LINE

131W

240
370
23
LL

SEPTIC TANK LEVEL OR 1500 CLEANOUTS 37
OR

DISTRIBUTION BOX LEVEL _____

DRAIN FIELD/TILE FIELD DEPTH 5 FT. TRENCH WIDTH 3 FT. INLET DEPTH 3.5 FT.

EFFECTIVE GRAVEL DEPTH 2 FT. TOTAL LENGTH 80 | 82 | 78 FT. 23 9

NUMBER OF TRENCHES 3 ONE SIDEWALL/BOTTOM AREA 240 | 246 | 231 SQ FT. 717

DRYWELL INSIDE DIAMETER _____ FT. EFFECTIVE DEPTH BELOW INLET _____ FT.

ABSORBENT AREA _____ SQ. FT.

REMARKS 7/24/90 - LOCATION OF OR TO COVER TANK
& HOUSE GEVER & TRENCH #1 RT
7/25/90 TRENCHES FINISHED RT

DATE SYSTEM APPROVED 7/25/90 INSPECTOR Raymond Hodger

A 34922

SUBDIVISION: GLENELG MANOR II

LOT NUMBER: 27A

DRY WELL OR DRY WELL AND TRENCH

SYSTEM FIRST BEFORE BUILDING PERMIT _____ sq. ft./bedroom

	<u>Septic Tank</u>	<u>Minimum Total Square Feet</u>
3 bedroom	1000 gallon	_____
4 bedroom	1250 gallon	_____
5 bedroom	1500 gallon	_____

Inlet _____ feet below original grade.
 Bottom maximum depth _____ feet below original grade.
 Effective area begins at _____ feet below original grade.

NOTE: If trench is used to make up absorbent area, run the trench on level ground and leave a 5-foot earth buffer between dry well and trench. No trench is to exceed 100 feet in length. Trench inlet to be same as dry well, with _____ feet of stone below distribution pipe.

TRENCHES

180 sq. ft./bedroom

Trench to be 3 wide.
 Inlet 3 feet below original grade.
 Bottom maximum depth 5 feet below original grade.
 Effective area begins at 3 feet below original grade.
2 feet of stone below distribution pipe.

- NOTE:
- (1) No trench to exceed 100 feet in length.
 - (2) If more than one trench used, a distribution box is required.
 - (3) Trenches to be installed on level ground.
 - (4) Call for inspection of trench before gravel is installed.
 - (5) Provide 6" - 8" diameter cleanout and cap to grade or above on septic tank and drywell.
 - (6) If a garbage disposal is used, increase septic tank capacity by 50% and increase absorbent sidewall area by 22%.

LOCATION: 10/17/89 - PLACE THE DISTRIBUTION BOX 210 FT FROM THE CENTER OF COURT G AND 80 FT FROM THE LEFT SIDE OF THE LOT AS SEEN WHEN FACING THE LOT FROM COURT G. RUN THE TRENCHES TOWARD BOTH SIDE LINES R.H. SEPTIC SYSTEM TO BE INSTALLED BEFORE BUILDING PERMIT ISSUED R/H

APPLICATION

2/4
Prel
AM

SEWAGE DISPOSAL TESTING

STATE OF MARYLAND - DEPARTMENT OF HEALTH AND MENTAL HYGIENE

A 34922

P _____

HOWARD COUNTY HEALTH DEPARTMENT
ENVIRONMENTAL HEALTH SERVICES

P. O. BOX 476 ELLICOTT CITY, MARYLAND 21043
TELEPHONE: 992-2330

DISTRICT 5th

DATE 2/04/85

TO: THE COUNTY HEALTH OFFICER
ELLICOTT CITY, MARYLAND

I, HEREBY, APPLY FOR THE NECESSARY TEST IN ORDER TO CONSTRUCT (OR RECONSTRUCT) A SEWAGE DISPOSAL SYSTEM.

PROPERTY OWNER Glenelg Manor Associates Albert Paul Kathleen M. Free
12789 Folly Quarter Road 297-7582
ADDRESS Ellicott City, Maryland 21043 PHONE 531-5252

PROPERTY LOCATION:

SUBDIVISION Glenelg Manor II LOT NO. 27A
ROAD AND DESCRIPTION 12873 Folly Quarter Road

SIZE OF LOT _____ TYPE BLDG. 3 or 4 Bedrooms
(NUMBER OF BEDROOMS)

THE SYSTEM INSTALLED UNDER THIS APPLICATION IS ACCEPTABLE ONLY UNTIL PUBLIC FACILITIES BECOME AVAILABLE. I FULLY UNDERSTAND THE FEE CONNECTED WITH THE FILING OF THIS PERC TEST APPLICATION IS NON-REFUNDABLE UNDER ANY CIRCUMSTANCES. I ALSO AGREE TO COMPLY

WITH ALL M.O.S.H.A. REQUIREMENTS IN TESTING THIS LOT. /s/ Glenelg Manor Associates
(SIGNATURE OF APPLICANT)

APPROVED BY _____ FOR _____ DATE _____

REJECTED BY _____ FOR _____ DATE _____


HOLD PENDING FURTHER TESTS _____ DATE _____


REASONS FOR REJECTION OR HOLDING 2/4/85 - Hold for Review Water, Recommend System First & Shallow Drainfield
RH 3/13/85 Plat to Dr. Boyd for signature P.S.

BUDG. PERMIT SIGNED
AND RETURNED 3/18/85 2/11/90
Serial # 31877

THIS IS NOT A PERMIT

SOIL PROFILE

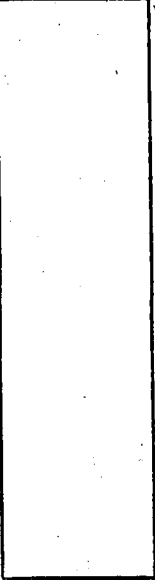0' 

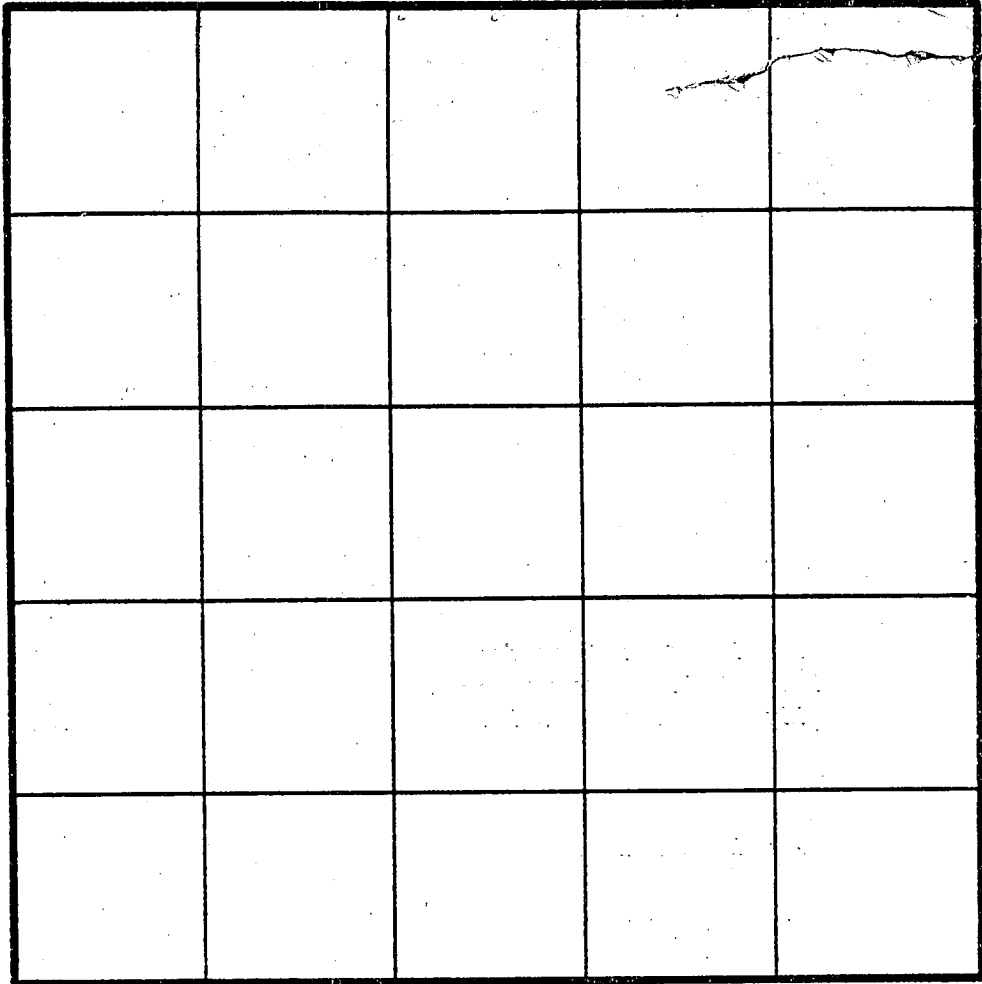

INDICATE NORTH - NAME ADJOINING ROADWAY AS BASE LINE.

DATE	TEST NO.	DEPTH	PRE-WET		TEST - 1" DROP		TIME
			START	STOP	START	STOP	

REMARKS _____

TYPE OF SOIL _____

TESTED BY _____ ALSO PRESENT _____

EH-12-1079

APPLICATION

SEWAGE DISPOSAL TESTING

STATE OF MARYLAND - DEPARTMENT OF HEALTH AND MENTAL HYGIENE

A 34922

P _____

HOWARD COUNTY HEALTH DEPARTMENT
ENVIRONMENTAL HEALTH SERVICES

P. O. BOX 476 ELLICOTT CITY, MARYLAND 21043
TELEPHONE: 992-2330

DISTRICT 5th

DATE 2/04/85

TO: THE COUNTY HEALTH OFFICER
ELLICOTT CITY, MARYLAND

I, HEREBY, APPLY FOR THE NECESSARY TEST IN ORDER TO CONSTRUCT (OR RECONSTRUCT) A SEWAGE DISPOSAL SYSTEM.

PROPERTY OWNER Glenelg Manor Associates
12789 Folly Quarter Road
ADDRESS Ellicott City, Maryland 21043 PHONE 531-5252

PROPERTY LOCATION:

SUBDIVISION Glenelg Manor II LOT NO. 27A

ROAD AND DESCRIPTION Folly Quarter Road

SIZE OF LOT _____ TYPE BLDG. 3 or 4 Bedrooms
(NUMBER OF BEDROOMS)

THE SYSTEM INSTALLED UNDER THIS APPLICATION IS ACCEPTABLE ONLY UNTIL PUBLIC FACILITIES BECOME AVAILABLE. I FULLY UNDERSTAND THE FEE CONNECTED WITH THE FILING OF THIS PERC TEST APPLICATION IS NON-REFUNDABLE UNDER ANY CIRCUMSTANCES. I ALSO AGREE TO COMPLY WITH ALL M.O.S.H.A. REQUIREMENTS IN TESTING THIS LOT. /s/ Glenelg Manor Associates

(SIGNATURE OF APPLICANT)


APPROVED BY _____ FOR _____ DATE _____


REJECTED BY _____ FOR _____ DATE _____

HOLD PENDING FURTHER TESTS _____ DATE _____

REASONS FOR REJECTION OR HOLDING _____

THIS IS NOT A PERMIT

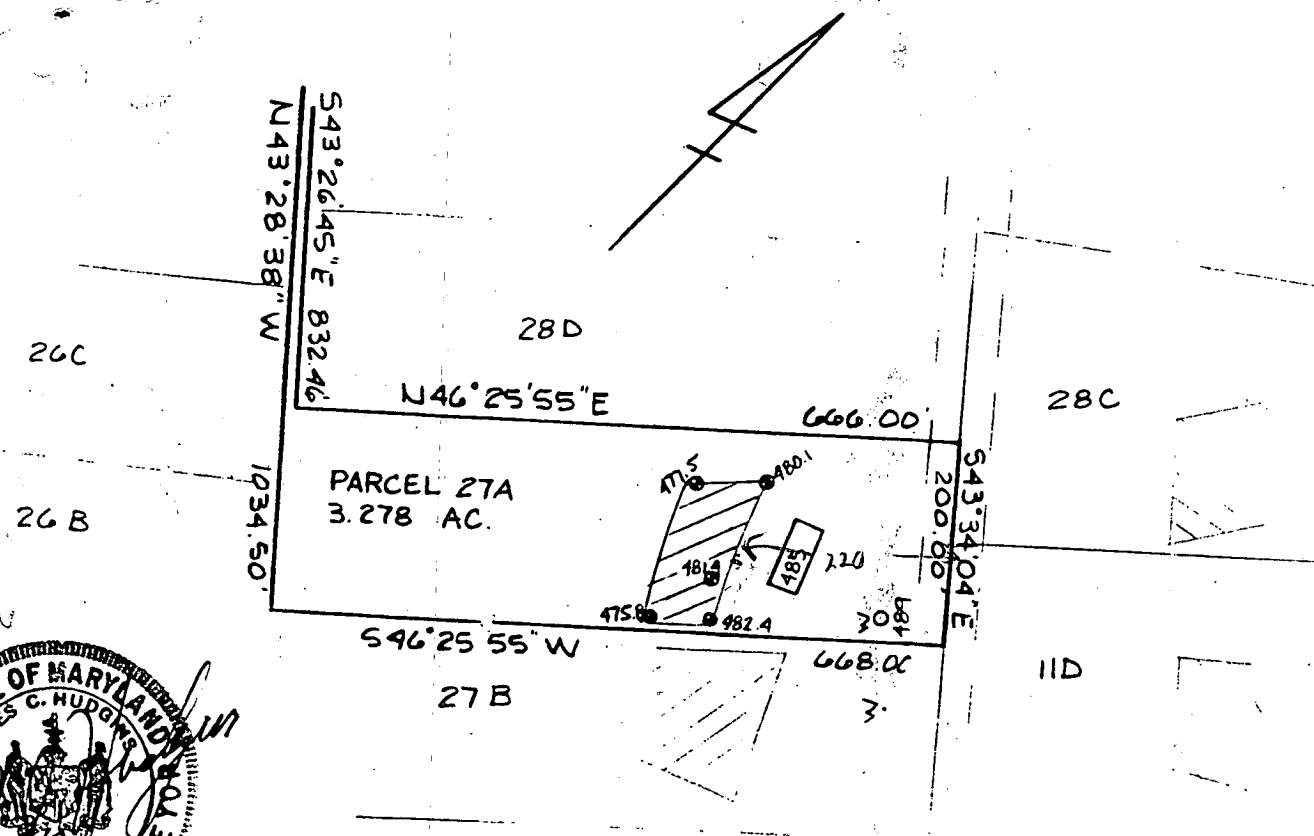

 This area designates a private sewage easement of 10,000 square feet as required by the Maryland State Department of Health and Mental Hygiene for individual sewage disposal. Improvements of any nature in this area are restricted until public sewage is available. These easements shall become null and void upon connection to a public sewage system. The County Health Officer shall have the authority to grant variances for encroachments into the private sewage easement. Recordation of a modified sewage easement shall not be necessary.

Percolation test holes shown hereon have been field located and shown as "●".

The lots shown hereon comply with the minimum ownership width and lot areas as required by the Maryland State Department of Health and Mental Hygiene.

Percolation areas and water wells for adjoining lots have been shown where pertinent.

APPROVED: For Private Water and Private Sewage Systems

County Health Officer *J. S.*

Date

PERCOLATION TEST PLAT
 PARCEL 27A
 GLENELG MANOR II

5th Election District
 Howard County, Maryland
 Scale 1"=200'
 Date 2/14/85

NTT Associates
 101 Sterrett Place
 Columbia, MD 21044
 442 2031

B-1 **2035** SEQUENCE NO. (DP USE ONLY)
 (THIS NUMBER IS TO BE PUNCHED IN COLS. 3-6 ON ALL CARDS)


STATE OF MARYLAND
 PERMIT TO DRILL WELL
 please print or type

STATE PERMIT NUMBER
HD-88-1077
 fill in this form completely

Date Received (APA) **6/27/89**
 OWNER INFORMATION
 Last Name: **FREE** Owner: **ALBERT**
 Street or RFD: **9467 BAEFF LANE**
 Town: **COLUMBIA** State: **MD** Zip: **21045**

LOCATION OF WELL
 COUNTY: **HOWARD**
 SUBDIVISION: **GLENELG MANOR 2**
 SECTION: **44 46** LOT: **27A**
 NEAREST TOWN: **GLENELG**
 MILES FROM TOWN: **3 1/2 MI**

DRILLER INFORMATION
 Driller's Name: **Joseph P. Mayne** License No. **238**
 Firm Name: **Joseph P. Mayne Well Drilling**
 Address: **5512 Ridge Rd. Mt. Airy Md. 21771**
 Signature: **Joseph P. Mayne** Date: **9/12/89**

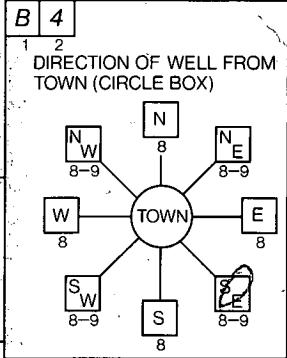

NEAR WHAT ROAD: **Court G**
 DISTANCE FROM ROAD: **60 FT**

WELL INFORMATION
 APPROX. PUMPING RATE (GAL. PER MIN.): **5**
 AVERAGE DAILY QUANTITY NEEDED (GAL. PER DAY): **500**

USE FOR WATER (CIRCLE APPROPRIATE BOX)
 HOME (SINGLE OR DOUBLE HOUSEHOLD UNIT ONLY)
 FARMING (LIVESTOCK WATERING & AGRICULTURAL IRRIGATION)
 INDUSTRIAL, COMMERCIAL, STATE AND FEDERAL GOV. OTHER (REQUIRES APPROPRIATION PERMIT)
 PUBLIC OR PRIVATE WATER COMPANY (REQUIRES APPROPRIATION PERMIT AND STATE HEALTH DEPARTMENT APPROVAL)
 TEST, OBSERVATION, MONITORING (MAY REQUIRE APPROPRIATION PERMIT)

NOT TO BE FILLED IN BY DRILLER HEALTH DEPARTMENT APPROVAL
 COUNTY NAME: **HOWARD** COUNTY NO.: **34922**
 STATE SIGNATURE: _____ DATE ISSUED: **10/18/89**
 CO SIGNATURE: **R. Hodges** EXP. DATE: **04/18/90**
 NORTH GRID: **515000** EAST GRID: **0811000**


APPROXIMATE DEPTH OF WELL: **300** FEET

APPROXIMATE DIAMETER OF WELL: **6** INCH

METHOD OF DRILLING (circle one)
 BORED (or Augered) JETTED Jetted & DRIVEN
 AIR-ROTARY AIR-PERCussion ROTARY (Hydraulic Rotary)
 CABLE REVerse-ROTary Drive-POINT
 other: _____

SHOW MAJOR FEATURES OF BOX & LOCATE WELL WITH AN X
 SOURCES OF DRILLING WATER
 1. WELL
 2.
 3.
 WRITE THE BOX NUMBER FROM THE MAP HERE
810
510

REPLACEMENT OR DEEPEMED WELLS (CIRCLE APPROPRIATE BOX)
 THIS WELL WILL NOT REPLACE AN EXISTING WELL
 THIS WELL WILL REPLACE A WELL THAT WILL BE ABANDONED AND SEALED
 THIS WELL WILL REPLACE A WELL THAT WILL BE USED AS A STANDBY
 THIS WELL WILL DEEPEM AN EXISTING WELL
 PERMIT NUMBER OF WELL TO BE REPLACED OR DEEPEMED (IF AVAILABLE): _____

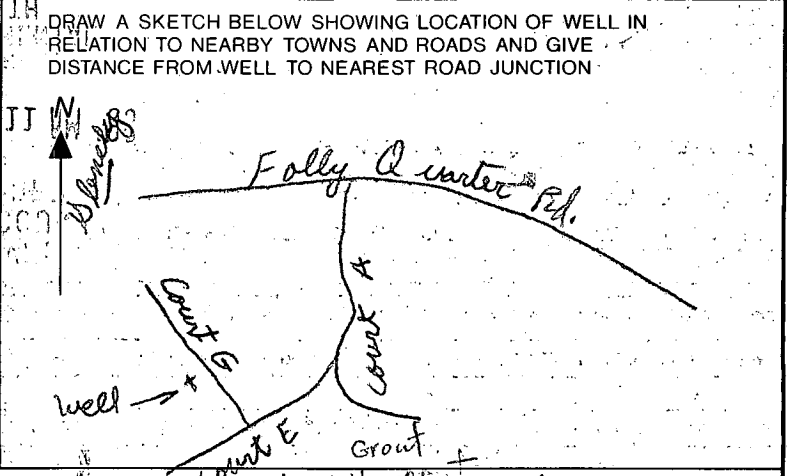

Not to be filled in by driller (OEP USE ONLY)
 APPROP. PERMIT NUMBER: _____
 FORCE: **1** WRITE INITIALS IN BOX: _____ PERMIT No.: **HD-88-1077**

SPECIAL CONDITIONS
 COUNTY: **1024-89** Lot: **10** 13 bags cement

WPI 7/25/90

Well line OK Tag H0881077

Pressure Tank Not yet installed
Clark Plumbing & Heating

→ 489 4029 & 635 6463

No permit on property File

3 Aug 90

Called Clark 489 4029 No
answer left message with
answering machine

RECEIVED
HOWARD COUNTY
HEALTH DEPT
SEP 12 9 11 AM '88
HEALTH DEPT
HOWARD COUNTY

C1 1186

SEQUENCE NO. (DENV USE ONLY)

STATE OF MARYLAND WELL COMPLETION REPORT

THIS REPORT MUST BE SUBMITTED WITHIN 45 DAYS AFTER WELL IS COMPLETED.

(THIS NUMBER IS TO BE PUNCHED IN COLS. 3-6 ON ALL CARDS)

COUNTY NUMBER 34922

ST/CO USE ONLY DATE Received

DATE WELL COMPLETED 102489

Depth of Well 165 (TO NEAREST FOOT)

PERMIT NO. FROM "PERMIT TO DRILL WELL" HC-48-1077

OWNER FREE ALBERT STREET OR RFD COURT TOWN GLENELG SUBDIVISION GLENELG MANOR SECTION II LOT 27A

WELL LOG Not required for driven wells STATE THE KIND OF FORMATIONS PENETRATED, THEIR COLOR, DEPTH, THICKNESS AND IF WATER BEARING

Table with columns: DESCRIPTION, FEET (FROM, TO), Check if water bearing. Includes entries for SAND and CORN MICHAEL.

GROUTING RECORD WELL HAS BEEN GROUTED (Y) TYPE OF GROUTING MATERIAL CEMENT (CM) BENTONITE CLAY (BC) NO. OF BAGS 15 NO. OF POUNDS 1410

CASING RECORD casing types insert appropriate code below MAIN CASING TYPE (S) Nominal diameter top (main) casing (nearest inch) 6 Total depth of main casing (nearest foot) 48

OTHER CASING (if used) diameter inch depth (feet) from to

SCREEN RECORD screen type or open hole insert appropriate code below (S) STEEL (BR) BRASS (PL) PLASTIC (HO) OPEN HOLE (OT) OTHER

DEPTH (nearest ft.) 110 47 165 SLOT SIZE 1 2 3 DIAMETER OF SCREEN (NEAREST INCH)

CIRCLE APPROPRIATE LETTER A A WELL WAS ABANDONED AND SEALED WHEN THIS WELL WAS COMPLETED E ELECTRIC LOG OBTAINED P TEST WELL CONVERTED TO PRODUCTION WELL

I HEREBY CERTIFY THAT THIS WELL HAS BEEN CONSTRUCTED IN ACCORDANCE WITH COMAR 26.04.04 "WELL CONSTRUCTION" AND IN CONFORMANCE WITH ALL CONDITIONS STATED IN THE ABOVE CAPTIONED PERMIT, AND THAT THE INFORMATION PRESENTED HEREIN IS ACCURATE AND COMPLETE TO THE BEST OF MY KNOWLEDGE.

DRILLERS IDENT. NO. 238 DRILLERS SIGNATURE (MUST MATCH SIGNATURE ON APPLICATION)

SITE SUPERVISOR (sign. of driller or journeyman responsible for sitework if different from permittee)


GRAVEL PACK IF WELL DRILLED WAS FLOWING WELL INSERT F IN BOX 68

OEP USE ONLY (NOT TO BE FILLED IN BY DRILLER) T (E.R.O.S.) W Q 70 72 74 75 76 TELESCOPE CASING LOG INDICATOR OTHER DATA


PUMPING TEST HOURS PUMPED (nearest hour) 3 PUMPING RATE (gal. per min. to nearest gal.) 12 METHOD USED TO MEASURE PUMPING RATE Bucket WATER LEVEL (distance from land surface) BEFORE PUMPING 24 WHEN PUMPING 46 TYPE OF PUMP USED (for test) (S) submersible

PUMP INSTALLED DRILLER WILL INSTALL PUMP YES (NO) IF DRILLER INSTALLS PUMP, THIS SECTION MUST BE COMPLETED FOR ALL WELLS EXCEPT HOME USE TYPE OF PUMP INSTALLED PLACE (A,C,J,P,R,S,T,O) IN BOX - SEE ABOVE: CAPACITY: GALLONS PER MINUTE (to nearest gallon) PUMP HORSE POWER PUMP COLUMN LENGTH (nearest ft.) CASING HEIGHT (circle appropriate box and enter casing height) above below LAND SURFACE (nearest foot)

LOCATION OF WELL ON LOT SHOW PERMANENT STRUCTURE SUCH AS BUILDING, SEPTIC TANKS, AND/OR LANDMARKS AND INDICATE NOT LESS THAN TWO DISTANCES (MEASUREMENTS TO WELL)

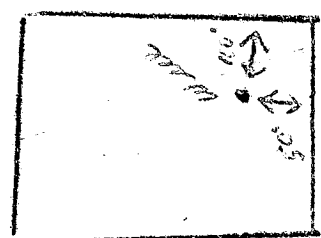

DRILLER County

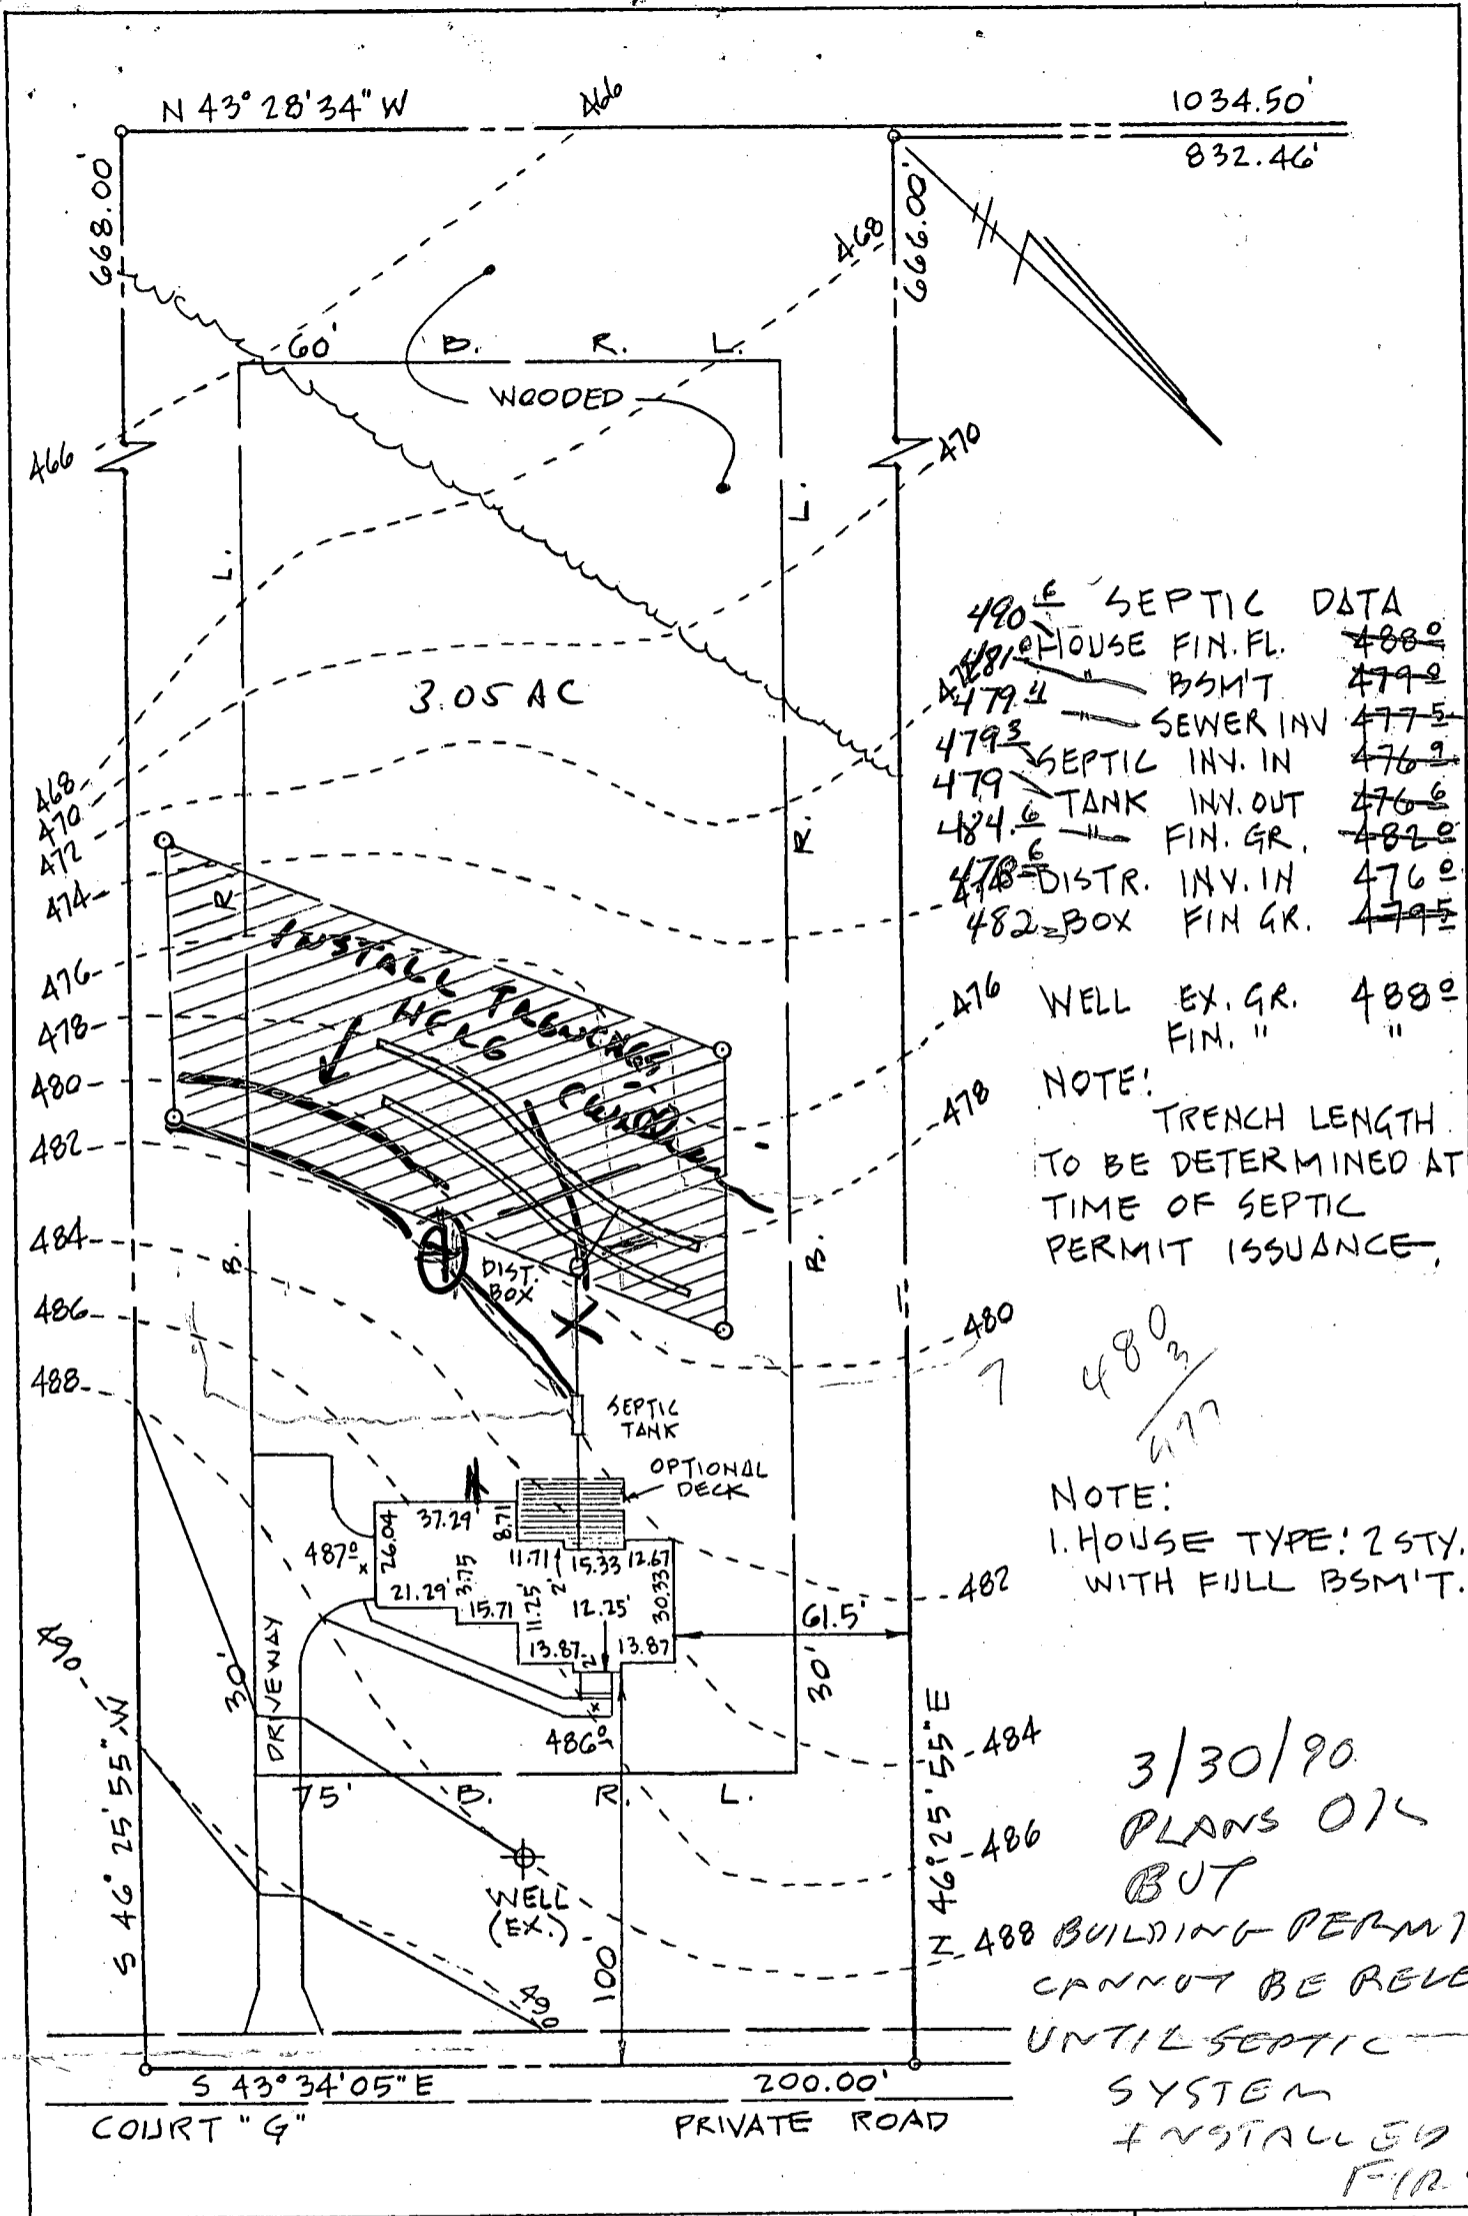

490 SEPTIC DATA

481 HOUSE FIN. FL.	488.0
479.4 BSMIT	479.2
479.3 SEWER INV.	477.5
479 SEPTIC INV. IN	476.9
484.6 TANK INV. OUT	476.6
478.6 FIN. GR.	482.0
478.6 DISTR. INV. IN	476.0
482 BOX FIN GR.	479.5

476 WELL EX. GR. 488.0
FIN. " "

NOTE:
TRENCH LENGTH TO BE DETERMINED AT TIME OF SEPTIC PERMIT ISSUANCE.


NOTE:
I. HOUSE TYPE: 2 STY. WITH FULL BSMIT.
480
7 480.2 / 477

3/30/90
PLANS OK BUT
Z 488 BUILDING PERMIT CANNOT BE RELEASED UNTIL SEPTIC SYSTEM INSTALLED FIRST

GRADING STUDY	OR SPECIAL ARRANGEMENTS MADE TO
LOT 27 A "GLENELG MANOR II"	CHECK SEPTIC SYSTEM AT
5th ELECTION DISTRICT HOWARD COUNTY, MARYLAND	TIME OF BUILDING INSPECTION
SCALE: 1"=50'	DATE: 3/21/90


ELEVATIONS RAISED - OK TO RELEASE OP. CHECKED 3/14

950'
1
950'

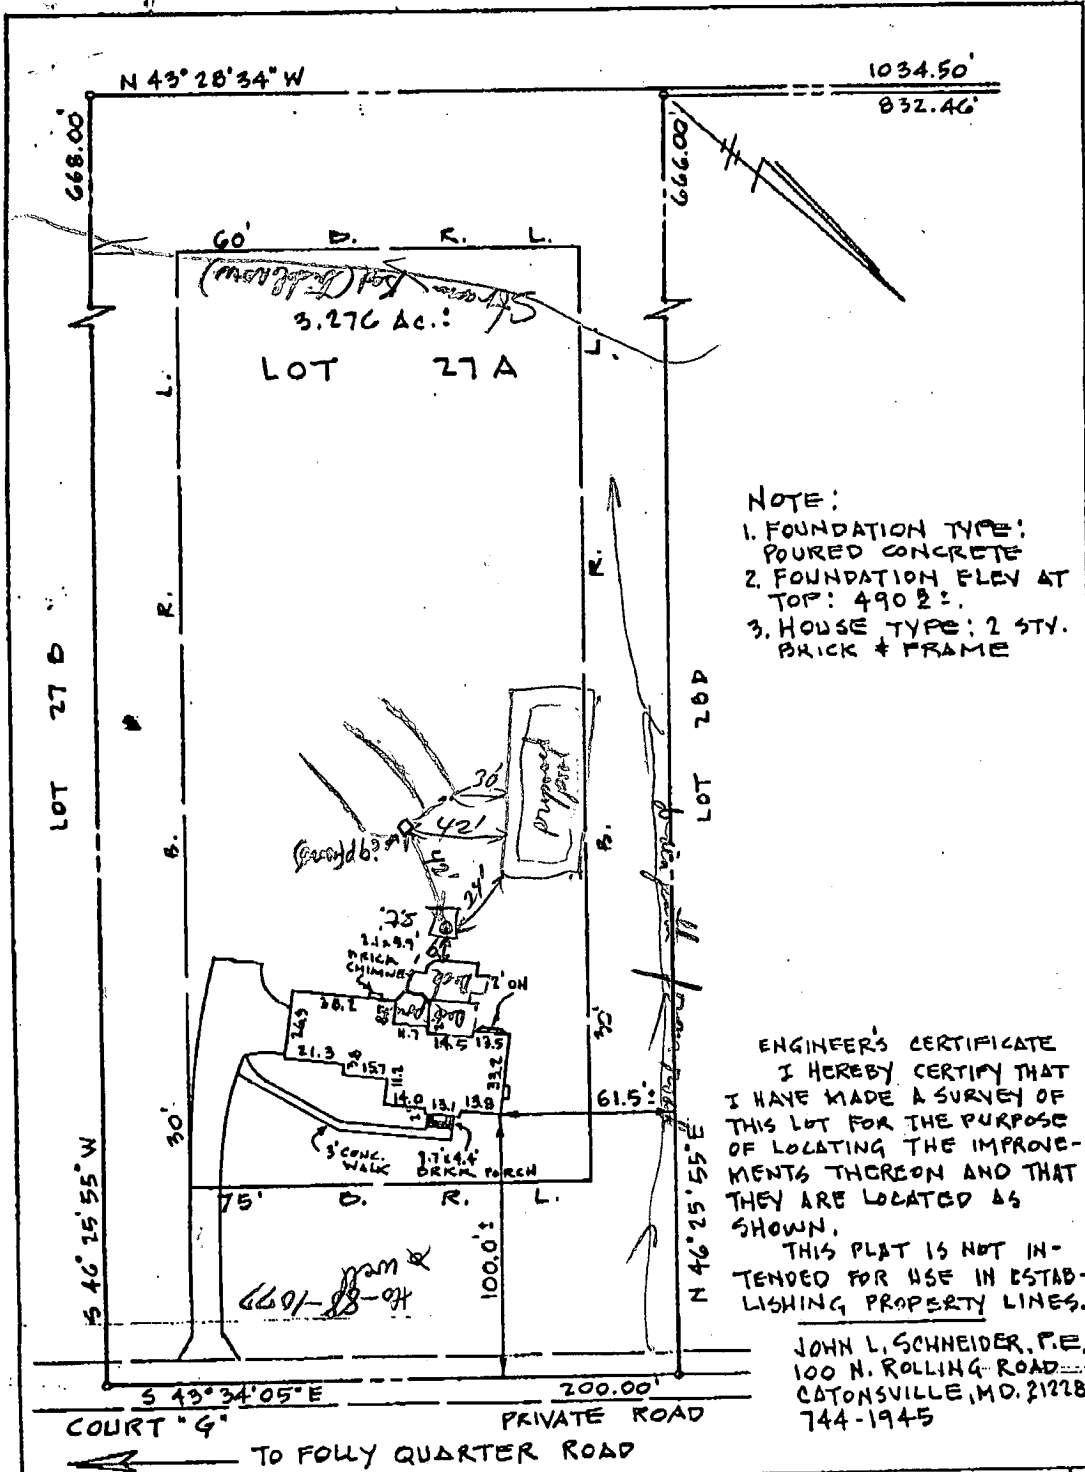

A34922
Glenelg Manor
Sect 2 Lot 27A
Court 6
12873
Folly Quarter
Ed Galloway
995-6600
MD Pools

FINAL CERTIFICATION	
LOT 27A "GLENELG MANOR II"	
5th ELECTION DISTRICT HOWARD COUNTY, MARYLAND	
SCALE: 1"=50'	DATE: SEPT. 8, 1990

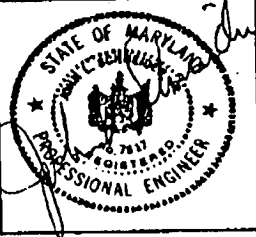

Looking for
septic easement
6-28-94
JEN

HOWARD COUNTY

APPLICATION

PERMIT APPLICATION

DEPARTMENT OF INSPECTIONS, LICENSES & PERMIT
3430 COURT HOUSE DRIVE, ELLICOTT CITY, MARYLAND 21043

SERIAL NUMBER

55212
55202

\$ 125.00
fee

BUILDING ADDRESS (HOUSE NO., STREET, TOWN OR AREA)

12873 Folly Quarter Rd
Ellicott City, Md 21045

GRADING/SEDIMENT CONTROL YES NO

SDP #

DESCRIPTION OF WORK AUTHORIZED

Inground concrete pool
in rear yard w/ 60
filter w/ separation tank
Pool to be filled by hose

LOT NO. PARCEL NO. SEC. AREA BLOCK NO. LIBER FOLIO

27-A

SUB DIVISION ZONE ZONE MAP ELEC. DIST. CENSUS TR.

Glenns Manor

05

OWNER NAME AND ADDRESS

PHONE NO.

Albert P. & Kathleen Free
12873 Folly Quarter Rd
Ellicott City, Md 21045

531-6957

OCCUPANT'S NAME AND ADDRESS

PHONE NO.

ARCHITECT OR ENGINEER'S NAME AND ADDRESS

PHONE NO.

CONTRACTOR'S NAME AND ADDRESS

PHONE NO.

Maryland Pools Inc
9515 Herwig Lane
Columbia, Md 21046

995-6600

EXISTING USE

PROPOSED USE

SFD

SFD + Pool

EST. CONSTRUCTION COST

LICENSE NUMBER

PERMIT FEE

12,000

6694

SIZE OF BLDG.	FRONT	DEPTH	HEIGHT
20x40		3-5'	
TYPE OF BLDG.	AREA	VOLUME	ROOF
B. ROOMS ROOMS BATHS FIREPLACES			
FOOTINGS		FOUNDATION	S. WALLS

UTILITIES					
WATER/WELL	SEWER/SEPTIC	GAS	ELECTRICITY	TYPE OF HEAT	AC

I have carefully examined and read this application and know the same is true and correct, and that in doing this work, all provisions of Howard County Ordinances and the State Laws of Maryland will be complied with, whether specified or not; and I will notify the Department of Inspections, and Permits twenty-four hours in advance when I am ready for the inspections called for elsewhere in the application; and that no work will be covered up until such inspections have been complied with.

[Signature]
SIGNATURE
DATE 1-7-5-94

W/S CODE

FOR OFFICE USE ONLY

DISTRICT IN FEET FROM R/W LINE TO FRONT BUILDING LINE _____
SIDE YARD _____
(DISTANCE IN FEET FROM SIDE BLDG. LINE TO SIDE PROPERTY LINE)
TO SIDE BUILDING LINE _____
DISTANCE IN FEET, REAR YD. REQUIRING SET
BACK _____ (CORNER LOT ONLY) _____ SDP # _____

Check payable to: DIRECTOR OF FINANCE OF HOWARD COUNTY

CAUTION

To begin construction before a permit placard has been issued and displayed on the job is a violation of the law.
Use and occupancy permit must be applied for two weeks before it will be issued.

IMPORTANT: PLEASE SHOW ZIP CODES AND AREA CODES WHEREVER REQUIRED.

LP-69-591

FUNCTION	DATE	SIGNATURE APPROVAL
ZONING/PLANNING		
SHA		
SEDIMENT/GRADING		
BUILDING OFFICIAL		
WATER & SEWER		
HEALTH DEPT.	7/14/94	<i>[Signature]</i>
FIRE PROTECTION		
STORM WATER MGM.		

APPROVED

DATE

Distribution of Copies:
White - Building Official
Green - Planning & Zoning


Yellow - Engineering
Pink - Health Dept.
Gold - S.H.A.

GENERAL NOTES

- 1) FT. OF ELECTRIC IN CONTRACT.
- 2) POOL AREA TO BE FENCED BY GATES TO

SETBACKS:

REAR PL.	10'
SIDE PL.	30'
HOUSE	10'
SEPTIC	20'
WELL	10'

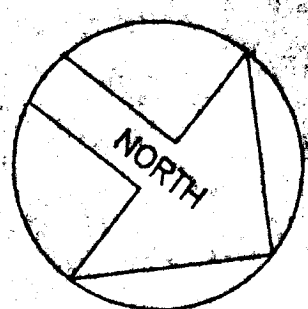


LOT 27B

TYP. 3 EXIST. DRAIN FIELDS
estimate enough for one (maybe 2) repair systems fibre hit low area (100' set-back from stream bed, - Need to look up original records off well top & - Prof drain pathway leads directly to S.T. (soil v. moist). This could explain green grass around S.T. & D.B. in other areas dry lawn

EX. SEPTIC TANK

HO-88-1077 EX. WELL

Records how plotted SDA runs into proposed pool site water table in early Feb '85 at 11 ft or lower test holes. I recommend No Approval at this time. See letter of 9/13/94

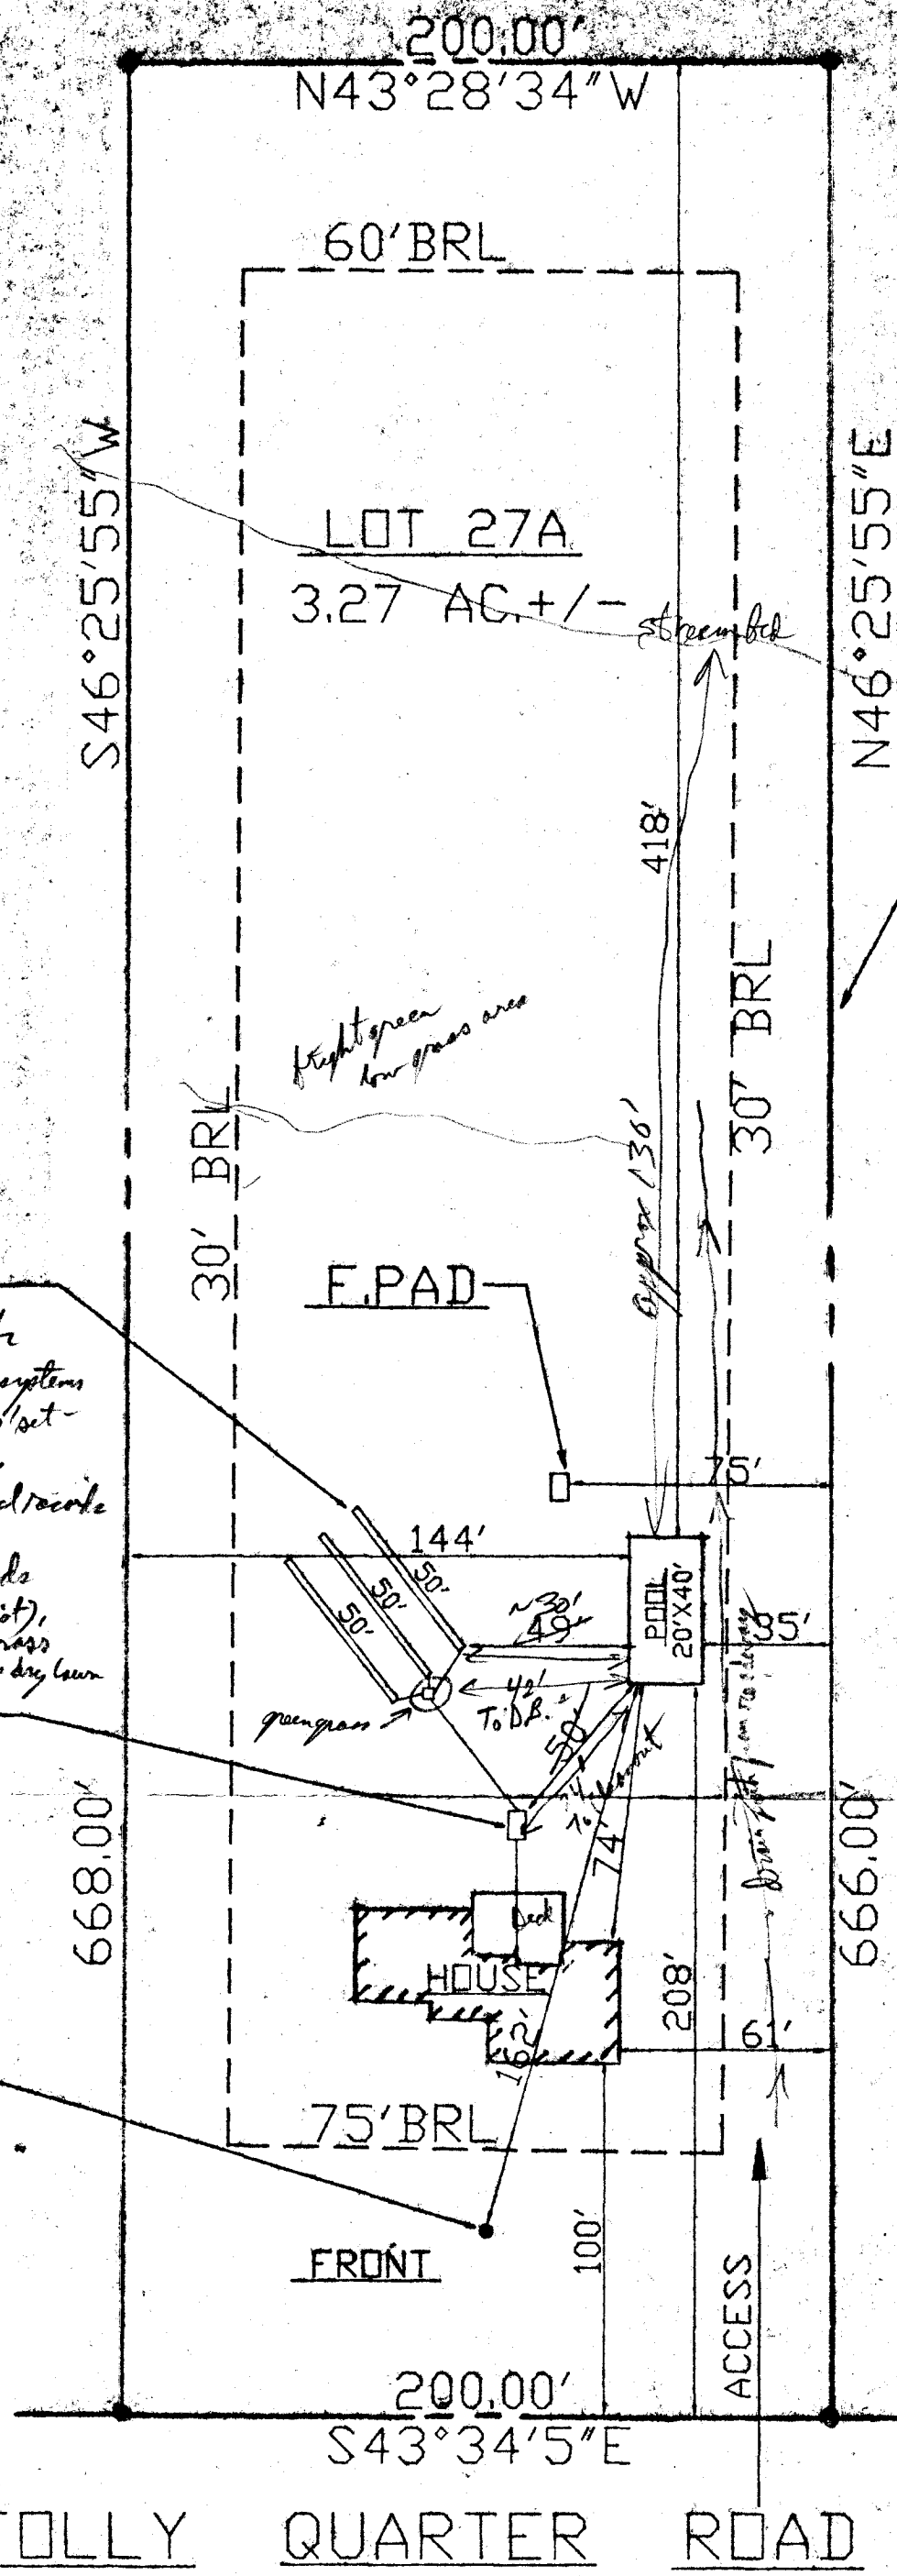

SITE PLAN
 SCALE: 1"=50'

12873 FOLLY QUARTER RD.
 HOWARD COUNTY, MD. 21043

GLENELG MANOR II

5TH ELECTION DIST.
 LOT 27A, LOT SIZE- 3.27 AC +/-
 ZONE MAP 28, BLOCK 4

*Glennys Mauer
 Sect 2 Lot 27A
 Court G
 A34922*

Both Customer and Salesman agree that this drawing, access, elevation & location of all equipment and appurtenances are in agreement. Any changes from this drawing must be approved in writing by the Customer and MPI.

CHECKED BY - SALESMAN _____
 CHECKED BY - CUSTOMER _____



DIRECTIONS: RTE. 29 NORT ON HOMEWOOD RD, CONT. TO RIGHT, FOLLY QUARTER

MAP BOOK:
 Co.: HOWARD
 MAP 14
 GRID C-11



SETBACKS:

REAR PL.	10'
SIDE PL.	30'
HOUSE	10'
SEPTIC	20'
WELL	10'

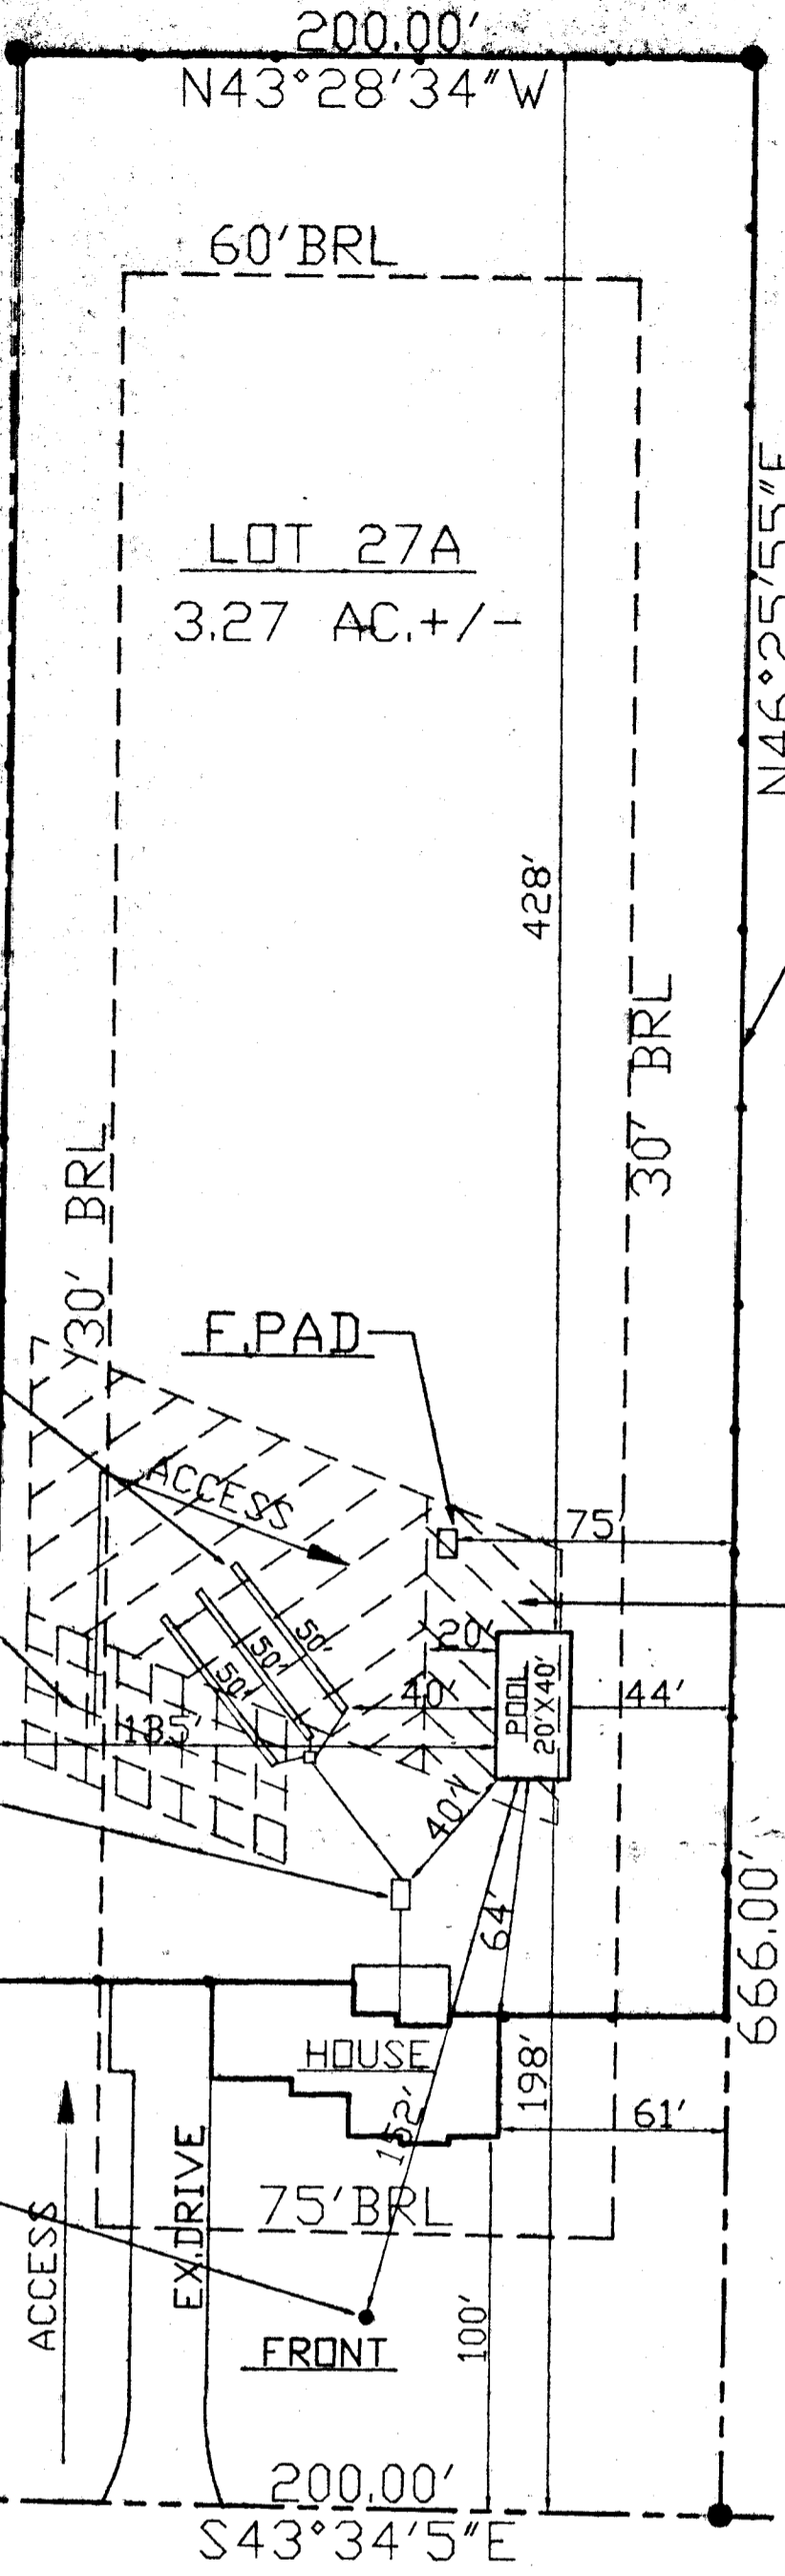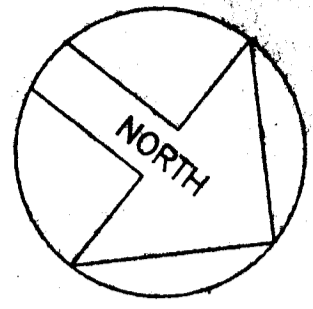

TYP. 3 EXIST. DRAIN FIELDS

2590 SQ. FT. RELOCATED SEPTIC RESERVE AREA

See Galloway 7/13/94

EX. SEPTIC TANK

EX. WELL

FOLLY QUARTER ROAD

SITE PLAN

SCALE: 1"=50'

12873 FOLLY QUARTER RD.
HOWARD COUNTY, MD. 21043

GLENELG MANOR II

5TH ELECTION DIST.
LOT 27A, LOT SIZE- 3.27 AC. +/-
ZONE MAP 28, BLOCK 4

Both Customer and Salesman agree that this drawing, access, elevation & location of all equipment and appurtenances are in agreement. Any changes from this drawing must be approved in writing by the Customer and MPI.

CHECKED BY - SALESMAN _____
CHECKED BY - CUSTOMER _____

DIRECTIONS: RTE. 29 N ON HOMEWOOD RD, CONT. RIGHT, FOLLY QUARTER ROAD

MAP BOOK:
Co.: HOWARD
MAP 14
GRID C-11

MARYLAND POOLS