

7/5/84
10' repair pvc
7/25/84
9.5

approved 7/20/84
Stayer

PERMIT

P 34019
A REPAIR

SEWAGE DISPOSAL SYSTEM

MARYLAND STATE DEPARTMENT OF HEALTH*

HOWARD COUNTY
BUREAU OF ENVIRONMENTAL HEALTH
992-2330

ELLICOTT CITY
DISTRICT _____

INDEX

DATE 6/20/84

Fogle Septic Cleaning IS PERMITTED TO INSTALL _____ ALTER X

ADDRESS 6430 Woodbine Road, Woodbine, Maryland 21797 PHONE 795-5670

SUBDIVISION _____ ROAD 2396 Florence Road LOT _____

PROPERTY OWNER Jerald C. Hoffberger
2396 Florence Road

ADDRESS Woodbine, Maryland 21797

IF GARBAGE GRINDER IS USED INCREASE SEPTIC TANK CAPACITY BY 50% AND ABSORPTION AREA BY 22%.

GARBAGE GRINDER? YES _____ NO _____

SEPTIC TANK CAPACITY _____ GALLONS NUMBER OF BEDROOMS _____

REPAIR - CALL FOR INSPECTION WHEN GROUND IS OPENED UP SO SANITARIAN CAN RECOMMEND

REPAIR.

7/5/84 For 3 apartment dwelling two 75ft. long trenches 2 ft wide, 12 ft deep inlet about 6ft. below original grade with 6ft. of gravel below distribution pipe. Use a distribution box. F. Skinner

PLANS APPROVED BY Frank Skinner DATE 6/20/84

COVER NO WORK UNTIL INSPECTED AND APPROVED.

NEITHER THE HOWARD COUNTY COUNCIL NOR THE HEALTH DEPARTMENT IS RESPONSIBLE FOR THE SUCCESSFUL OPERATION OF ANY SYSTEM.

NOTE: IF TRENCH IS USED CALL FOR INSPECTION BEFORE AND AFTER PLACING GRAVEL IN TRENCH.

NOTE: NO DRY WELL SHALL EXCEED 15 FOOT IN DIAMETER. NO ABSORPTION TRENCH TO EXCEED 100 FEET IN LENGTH.

NOTE: ALL PIPE FROM HOUSE TO SEPTIC TANK MUST BE CAST IRON OR SCHEDULE 40 PVC OR ABS.

PERMIT VOID AFTER THREE YEARS.


NOTE: INSTALL STAND PIPE ON SEPTIC TANK AND DRY WELL. STAND PIPES MUST BE 6 INCHES IN DIAMETER. CAST IRON, CONCRETE OR TERRA COTTA, OR PVC OR ABS ACCEPTED. IF TOP OF SEPTIC TANK IS DEEPER THAN 3 FEET MANHOLE TO GRADE REQUIRED.

***INSTALLER IS RESPONSIBLE FOR OBTAINING FINAL APPROVAL ON THIS PERMIT**

*CALL 992-2330 FOR INSPECTION OF SEPTIC SYSTEMS.

EH - 2-1082

A 34019

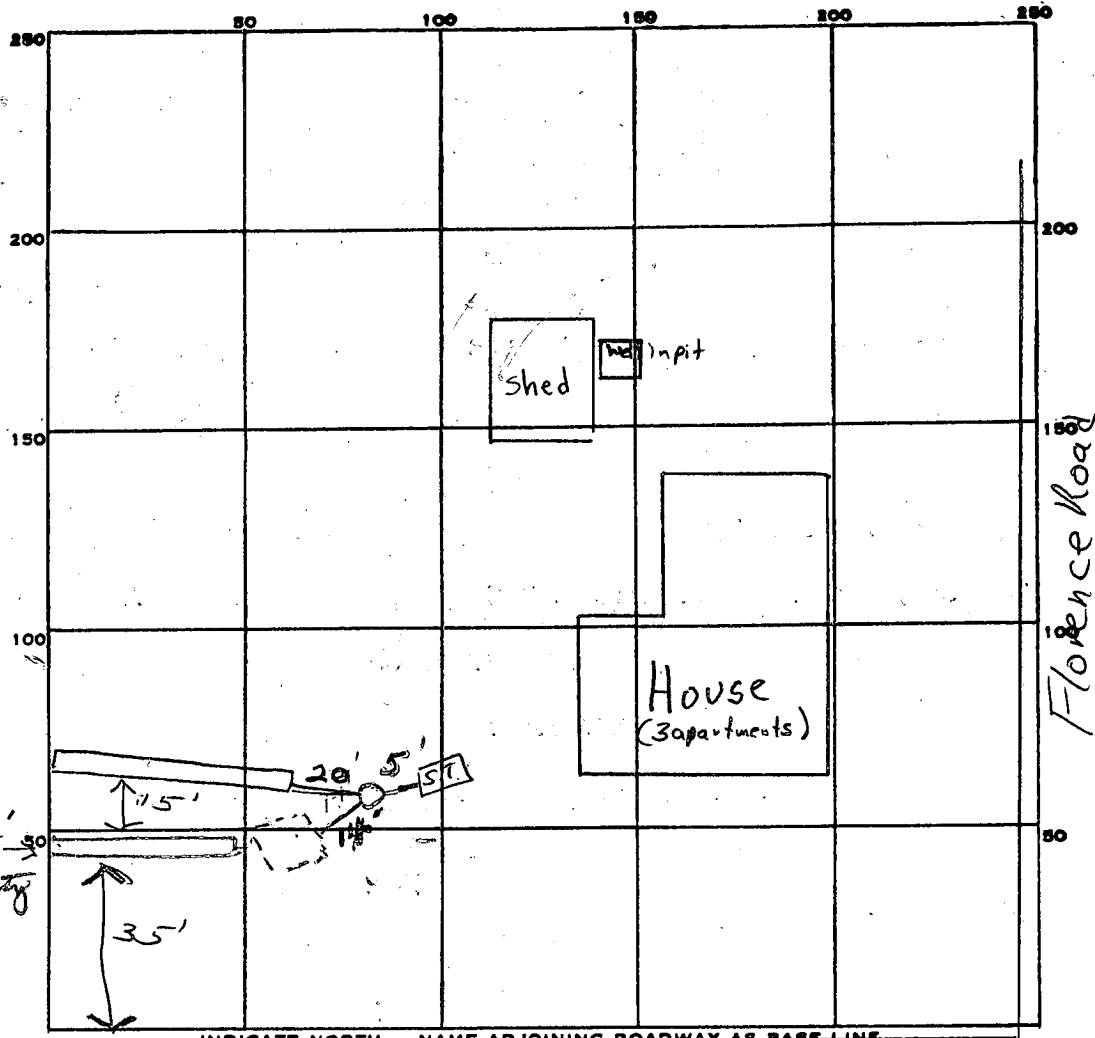

INDICATE NORTH NAME ADJOINING ROADWAY AS BASE LINE

Md. Rte 94

→ to Rte. 144 →

PERMIT CARD _____

SEPTIC TANK, LEVEL existing CLEANOUTS existing S.T. _____

DISTRIBUTION BOX, LEVEL _____

TILE FIELD, DEPTH 12 FT. TRENCH WIDTH 2 FT.

GRAVEL DEPTH 6 IN. TOTAL LENGTH 75 75 FT.

NUMBER OF TRENCHES 2 TOTAL BOTTOM AREA 900

SEEPAGE PITS, INSIDE DIAMETER _____ FT. DEPTH BELOW INLET _____ FT.

ABSORBENT AREA 900 SQ. FT.

150
6
900

REMARKS 7/17/84 - OK to add stone in #1 trench fs
7/20/84 OK to add stone in #2 trench fs
7/20/84 OK to cover all work fs

DATE SYSTEM APPROVED 7/20/84 INSPECTOR Stayer