

7/13/84  
as soon as possible

APPROVED  
7/12/84  
P 34100  
A REPAIR

# PERMIT

SEWAGE DISPOSAL SYSTEM

MARYLAND STATE DEPARTMENT OF HEALTH\*

HOWARD COUNTY  
BUREAU OF ENVIRONMENTAL HEALTH  
992-2330

04-328515

ELLICOTT CITY  
DISTRICT 3rd  
DATE 7/12/84

## INDEX

Jack Fuock IS PERMITTED TO INSTALL \_\_\_\_\_ ALTER X

ADDRESS 13775 Triadelphia Road, Glenelg, Md. PHONE 988-9270

SUBDIVISION \_\_\_\_\_ ROAD 2225 McKendree LOT \_\_\_\_\_

PROPERTY OWNER J. F. Spurrier

ADDRESS 2225 McKendree Road  
West Friendship, Maryland

IF GARBAGE GRINDER IS USED INCREASE SEPTIC TANK CAPACITY BY 50% AND ABSORPTION AREA BY 22%.

GARBAGE GRINDER? YES \_\_\_\_\_ NO ?

SEPTIC TANK CAPACITY 1000 GALLONS NUMBER OF BEDROOMS ?

REPAIR - Install new septic tank - 1000 gallon.

PERMIT VOID  
AND RETURNED 3-20-89  
BP 21088  
Garcia  
Adler

PLANS APPROVED BY Frank Skinner DATE 7/11/84

COVER NO WORK UNTIL INSPECTED AND APPROVED.

NEITHER THE HOWARD COUNTY COUNCIL NOR THE HEALTH DEPARTMENT IS RESPONSIBLE FOR THE SUCCESSFUL OPERATION OF ANY SYSTEM.

NOTE: IF TRENCH IS USED CALL FOR INSPECTION BEFORE AND AFTER PLACING GRAVEL IN TRENCH.

NOTE: NO DRY WELL SHALL EXCEED 15 FOOT IN DIAMETER. NO ABSORPTION TRENCH TO EXCEED 100 FEET IN LENGTH.

NOTE: ALL PIPE FROM HOUSE TO SEPTIC TANK MUST BE CAST IRON OR SCHEDULE 40 PVC OR ABS.

PERMIT VOID AFTER THREE YEARS.


NOTE: INSTALL STAND PIPE ON SEPTIC TANK AND DRY WELL. STAND PIPES MUST BE 6 INCHES IN DIAMETER. CAST IRON, CONCRETE OR TERRA COTTA, OR PVC OR ABS ACCEPTED. IF TOP OF SEPTIC TANK IS DEEPER THAN 3 FEET MANHOLE TO GRADE REQUIRED.

**\*INSTALLER IS RESPONSIBLE FOR OBTAINING FINAL APROVAL ON THIS PERMIT**

\*CALL 992-2330 FOR INSPECTION OF SEPTIC SYSTEMS.

EH - 2-1082

AS 34100

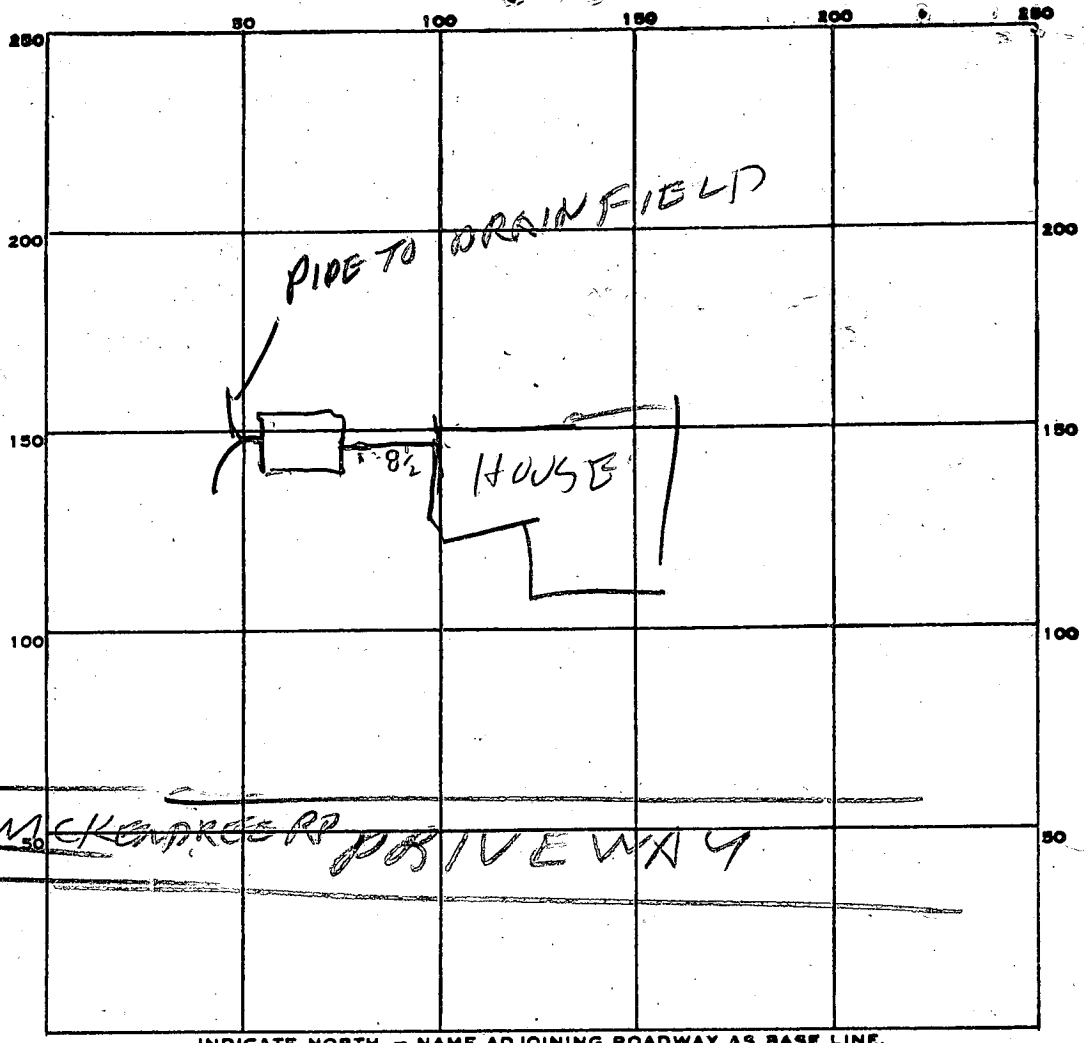

INDICATE NORTH. - NAME ADJOINING ROADWAY AS BASE LINE.

PERMIT CARD \_\_\_\_\_

SEPTIC TANK, LEVEL 1000

CLEANOUTS ST  
OK

DISTRIBUTION BOX, LEVEL \_\_\_\_\_

TILE FIELD, DEPTH \_\_\_\_\_ FT. TRENCH WIDTH \_\_\_\_\_ FT.

GRAVEL DEPTH \_\_\_\_\_ IN. TOTAL LENGTH \_\_\_\_\_ FT.

NUMBER OF TRENCHES \_\_\_\_\_ TOTAL BOTTOM AREA \_\_\_\_\_

SEEPAGE PITS, INSIDE DIAMETER \_\_\_\_\_ FT. DEPTH BELOW INLET \_\_\_\_\_ FT.

ABSORBENT AREA \_\_\_\_\_ SQ. FT.


REMARKS Tall Field OK

DATE SYSTEM APPROVED 7/13/04

INSPECTOR Raymond Dodge

# MARYLAND TROYCORP, INC.

P.O. Box 3101, Baltimore, MD 21228

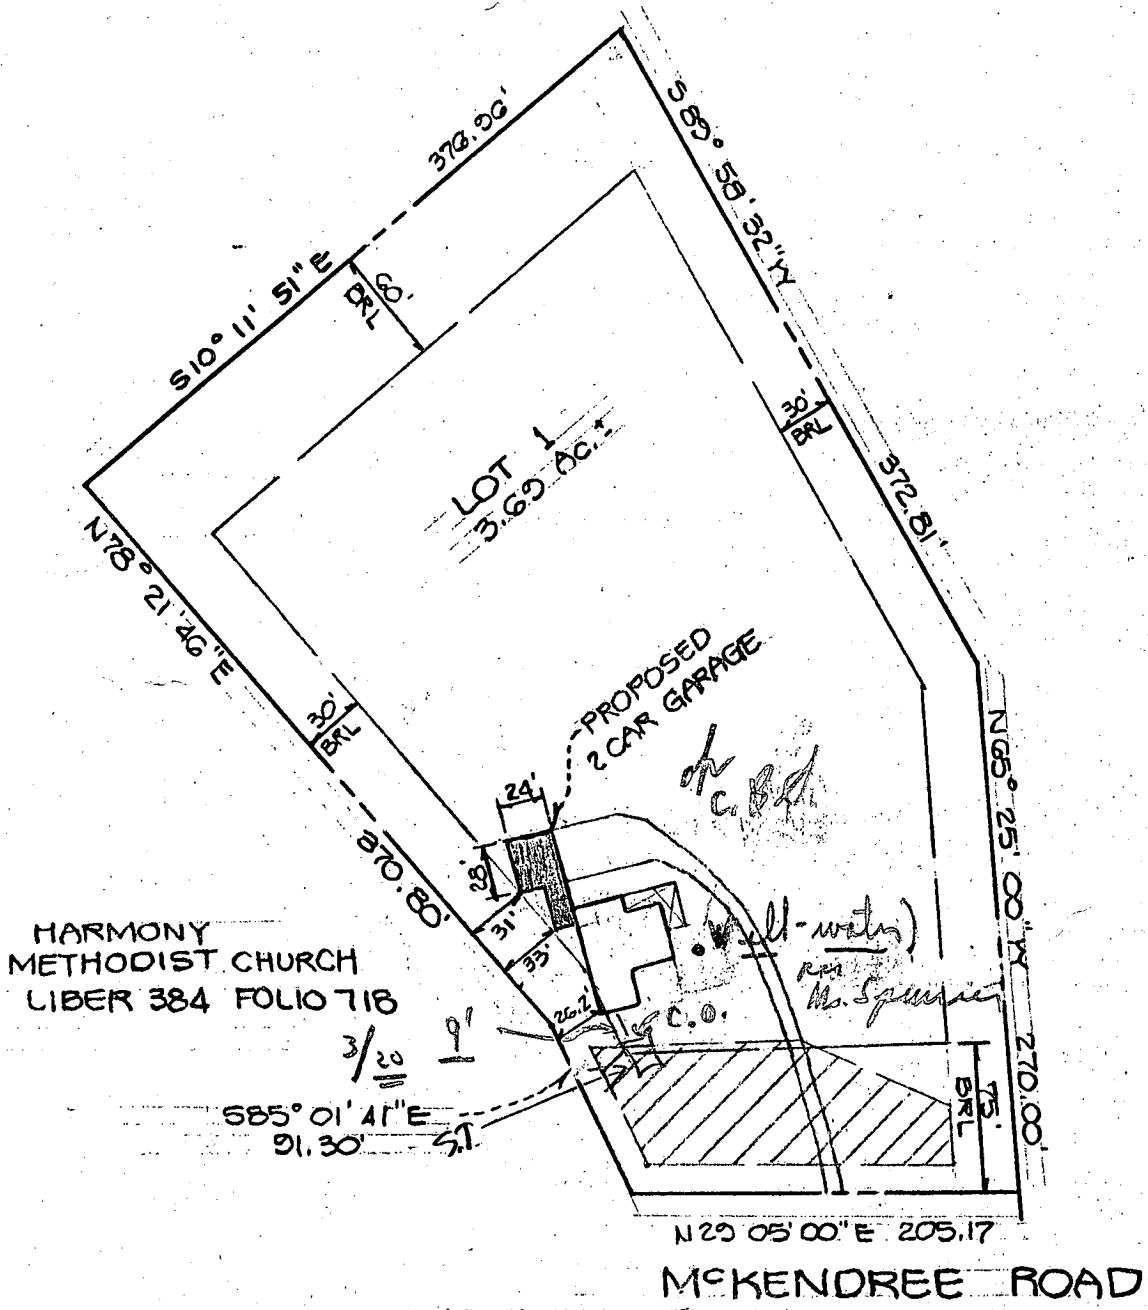

PLAN  
1" = 100'

OWNER CATHERINE SPURRIER  
 2225 MCKENDREE ROAD  
 WESTERLIENSHIP MD 21794  
 PHONE (301) 442-2232

GARAGE ADDITION  
 SPURRIER PROPERTY  
 4TH ELECTION DISTRICT  
 HOWARD COUNTY, MD.