

04-328116

2/2/77

SEWAGE DISPOSAL SYSTEM  
MARYLAND STATE DEPARTMENT OF HEALTH

HOWARD COUNTY

INDEXED

DATE 2-2-77

\_\_\_\_\_ IS PERMITTED TO INSTALL \_\_\_\_\_

ADDRESS 2222 Jennings Chapel Road, Washington, MD. PHONE 222-2722

A SEWAGE DISPOSAL SYSTEM LOCATED AT \_\_\_\_\_

SUBDIVISION \_\_\_\_\_ ROAD 2105 MILLERS HILL RD. LOT \_\_\_\_\_

PROPERTY OWNER Richard C. Smith

ADDRESS same as above

SPECIFICATIONS - 3 bedrooms

DRAIN FIELD \_\_\_\_\_ DEPTH \_\_\_\_\_ FEET. BOTTOM AREA \_\_\_\_\_ SQ. FT.

SLEPAGE PITS \_\_\_\_\_ ABSORBENT SIDE-WALL AREA \_\_\_\_\_ SQ. FT.

SEPTIC TANK CAPACITY 1,000 GALLONS

FOR GARBAGE GRINDER, INCREASE DISPOSAL AREA 25% & TANK CAPACITY 50%.

OTHER Dry well - 336 sq. ft. sidewall area below inlet with inlet 6" to 8" diameter

grade and bottom of dry well no closer than 12 ft. from the dry well to the

edge of Millers Hill Road and 50 ft. from the well toward the back of the

tank at least 50 ft. from the well and the main pipe inside a concrete system of the well.

NOTE: ALL PIPE FROM ROOMS TO SEPTIC TANK MUST BE CAST IRON.

PERMIT VOID AFTER THREE YEARS. \_\_\_\_\_

NOTE: RECOMMENDED INSTALL STAND PIPE ON DRY WELL AND SEPTIC TANK.

PLANS APPROVED BY Richard C. Smith DATE 2/2/77

FILL SEPTIC TANK AND DISTRIBUTION BOX WITH WATER BEFORE CALLING FOR AN INSPECTION. COVER NO WORK UNTIL INSPECTED AND APPROVED.


NEITHER THE HOWARD COUNTY COMMISSIONERS NOR THE HEALTH DEPARTMENT IS RESPONSIBLE FOR THE BUILDING PERMIT SIGNED \_\_\_\_\_

AND RETURNED

5-23-04 800 141764-GHAGel

AND RETURNED 12-28-95  
And # 157 1135 4/1  
[Stray Addition]

34467-D

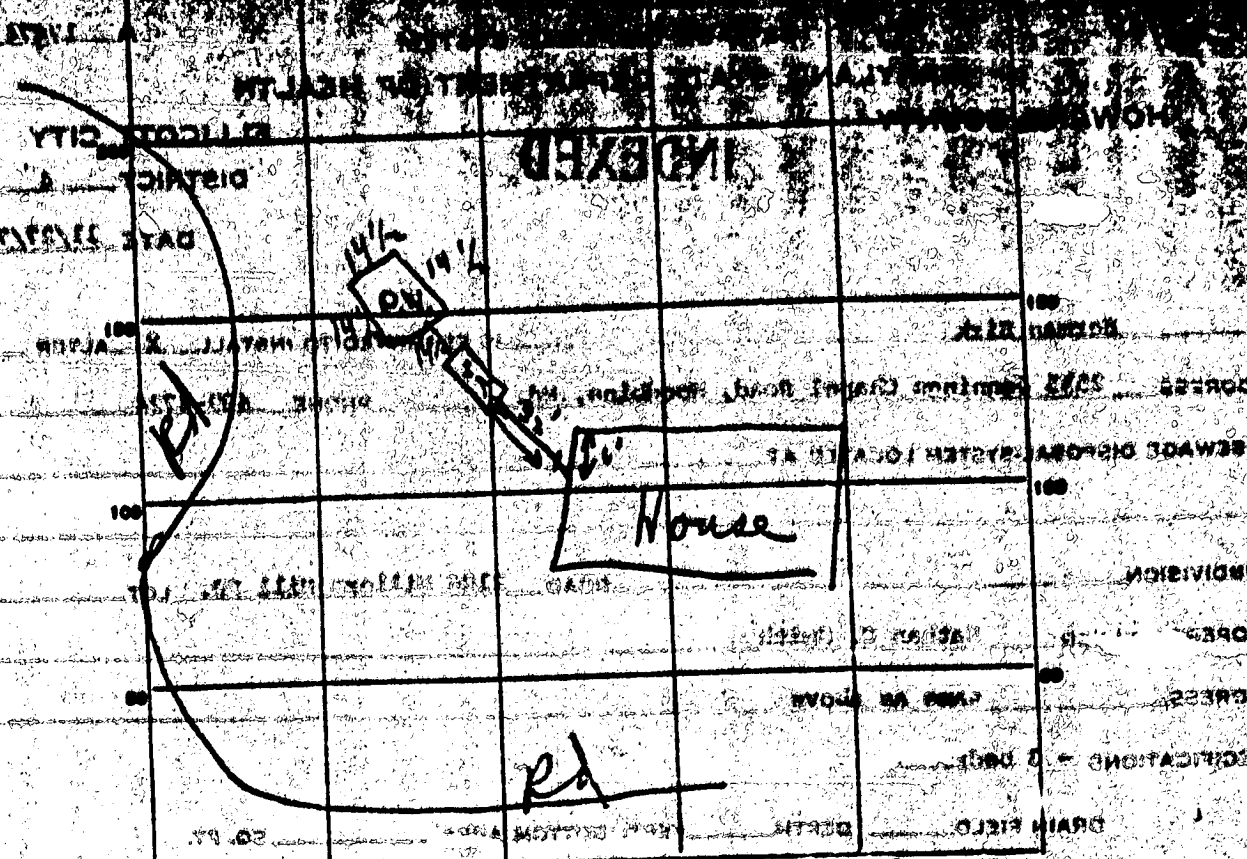

INDICATE NORTH - NAME ADJOINING ROADWAY AS BASE  
 APPROXIMATE ROADWAY AREA

PERMIT CARD No OK ST / D.W  
 SEPTIC TANK LEVEL OK CLEANLINE OK / OK  
 DISTRIBUTION BOX LEVEL OK  
 TILE FIELD DEPTH 1.5 FT. TRENCH WIDTH 12 IN. 12 IN.  
 GRAVEL DEPTH 6 IN. TOTAL LENGTH 12 FT. 12 FT.  
 NUMBER OF TRENCHES 1 TOTAL BOTTOM AREA 144 SQ. FT.  
 SEEPAGE PITS, INSIDE DIAMETER 5.8 FT. DEPTH BELOW INLET 3 FT.  
 ABSORBENT AREA 1.64 SQ. FT.

REMARKS 2/11/74 Pipe from house to septic tank  
exposed except for 3' from house to street

DATE SYSTEM APPROVED 2/11/74 INSPECTOR C.R.S. H.Z.

SEWAGE DISPOSAL TESTING  
MARYLAND STATE DEPARTMENT OF HEALTH  
HOWARD COUNTY

ELLICOTT CITY

DISTRICT 1

DATE 9/21/72

TO: THE COUNTY HEALTH OFFICER  
ELLICOTT CITY, MARYLAND

I, HEREBY, APPLY FOR THE NECESSARY TESTS IN ORDER TO CONSTRUCT (OR RECONSTRUCT) A SEWAGE DISPOSAL SYSTEM.

PROPERTY OWNER Nathan C. Smith

ADDRESS 14249 Bushy Park Road, Bethesda, Md. PHONE 442-2186

PROPERTY LOCATION:

SUBDIVISION \_\_\_\_\_ LOT NO. \_\_\_\_\_

ROAD AND DESCRIPTION 2105 Millers Hill Road - Doo Rt. 144 - turn left onto Bushy Park Road - left fork - house sits on bend of road

OCCUPANT \_\_\_\_\_ PHONE \_\_\_\_\_

PERSON TO CONSTRUCT SYSTEM \_\_\_\_\_

ADDRESS \_\_\_\_\_ PHONE \_\_\_\_\_

SIZE OF LOT 1, 3/4 acres TYPE BLDG. 1

IF NOT SINGLE RESIDENCE DESCRIBE \_\_\_\_\_ (Single Fam. Dwlg.)

SIGNATURE OF APPLICANT Nathan C. Smith


APPROVED BY \_\_\_\_\_ FOR \_\_\_\_\_ DATE \_\_\_\_\_

REJECTED BY \_\_\_\_\_ FOR \_\_\_\_\_ DATE \_\_\_\_\_

HOLD PENDING FURTHER TESTS \_\_\_\_\_ DATE \_\_\_\_\_

REASONS FOR REJECTION OR HOLDING \_\_\_\_\_

**THIS IS NOT A DEPOSIT**

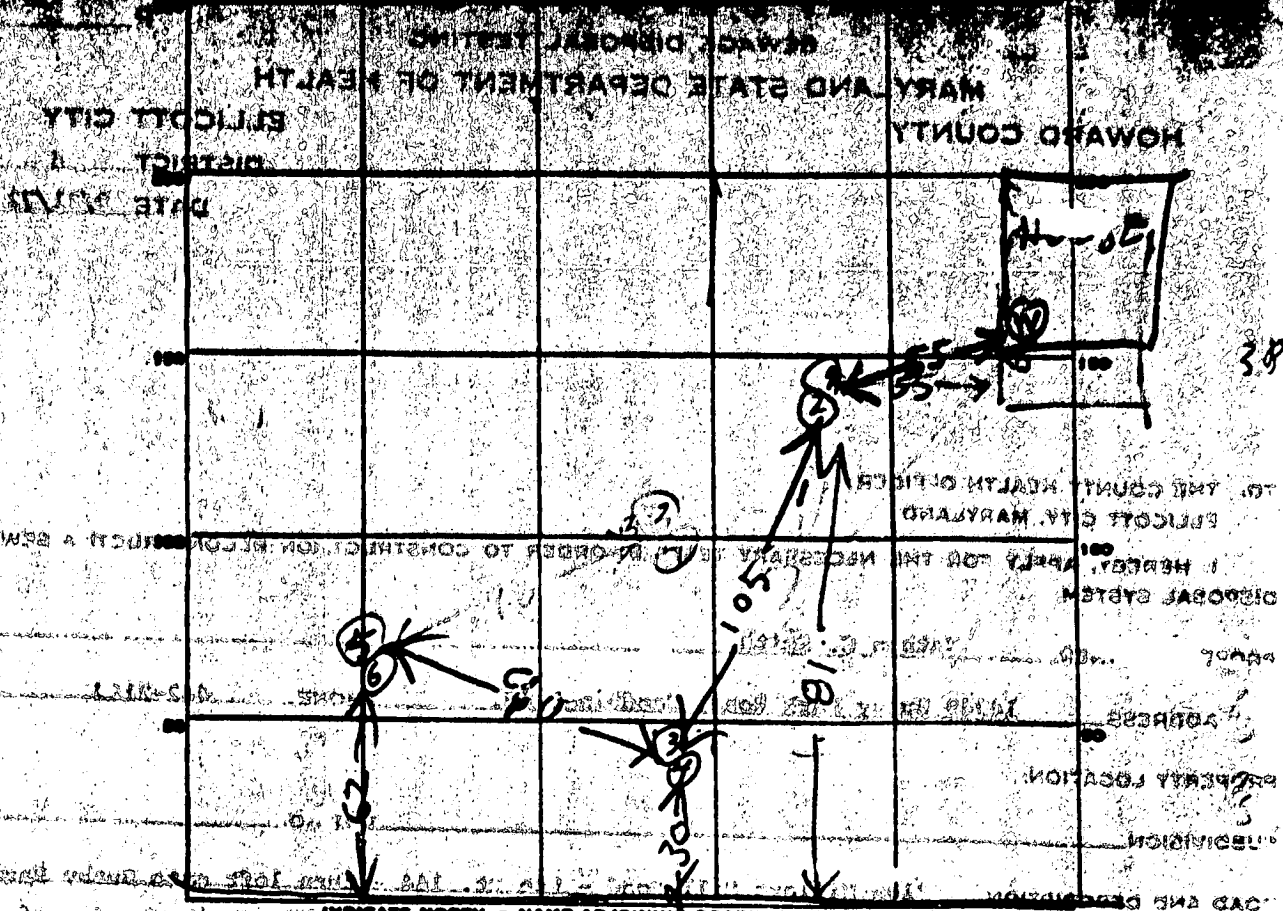

INDICATE NORTH - NAME ADJOINING ROADWAY AS BASE LINE.

MILLER'S MILL RD

DATE	TEST NO.	DEPTH	PRE-WET		TEST - 1" DROP		TIME	OCCUPANCY
			START	STOP	START	STOP		
10/6/72	1	12 1/2	1000	1002	1002	1006	4	10 m. a.
	2	6	1000	1004	1004	1011	7	
	3	12	1008	1012	1012	1027	15	
	4	6 1/2	1010	1017	1017	1032	13	
	5	13	1031	1042	1042	1100	18	
10/6/72	6	6	1032	1042	1042	1056	14	

SOIL AUGER FINDINGS

TESTED BY P. J. Hodges

Well under House But No Water Hole

APPLICATION

HOWARD COUNTY

SERIAL NUMBER

# PERMIT APPLICATION

40825

DEPARTMENT OF INSPECTIONS, LICENSES & PERMIT  
3430 COURT HOUSE DRIVE, ELLICOTT CITY, MARYLAND 21043

B00112541

BUILDING ADDRESS (HOUSE NO., STREET, TOWN OR AREA)

2106 MILLERS MILL Rd 35528  
COOKSVILLE, MD 21723

LOT NO.	PARCEL NO.	SEC.	AREA	BLOCK NO.	LIBER	FOHO
-	113	-	-	B	-	-
SUB DIVISION		ZONE	ZONE MAP	ELEC. DIST.	CENSUS TR.	
NONE		REDED	14	4	6040	

OWNER NAME AND ADDRESS PHONE NO.  
 ANTONIO V. SMITH 410 3562446  
 2106 MILLERS MILL Rd  
 COOKSVILLE MD 21723

OCCUPANT'S NAME AND ADDRESS PHONE NO.  
 SAME

ARCHITECT OR ENGINEER'S NAME AND ADDRESS PHONE NO.  
 NONE

CONTRACTOR'S NAME AND ADDRESS PHONE NO.  
 OWNER

EXISTING USE PROPOSED USE  
 SINGLE FAMILY DWELLING ADDITION

EST. CONSTRUCTION COST LICENSE NUMBER PERMIT FEE  
 3500

W/S CODE FOR OFFICE USE ONLY

DISTANCE IN FEET FROM R/W LINE TO FRONT BUILDING LINE 60'

SIDE YARD 150'  
(DISTANCE IN FEET FROM SIDE BLDG. LINE TO SIDE PROPERTY LINE)

TO SIDE BUILDING LINE  
DISTANCE IN FEET, REAR YD. REQUIRING SET

BACK 45' (CORNER LOT ONLY) SDP #

Check payable to: DIRECTOR OF FINANCE OF HOWARD COUNTY

**CAUTION**  
 To begin construction before a permit placard has been issued and displayed on the job is a violation of the law.  
 Use and occupancy permit must be applied for two weeks before it will be issued.

IMPORTANT: PLEASE SHOW ZIP CODES AND AREA CODES WHEREVER REQUIRED.

LP-69-591 *Cash*

GRADING/SEDIMENT CONTROL  YES  NO SDP #

DESCRIPTION OF WORK AUTHORIZED  
 1 STORY W/ CRAWL SPACE  
 ENLARGING 2 BEDROOMS  
 (APPROX 336 SQ FT ADDITION)

SIZE OF BLDG.	FRONT	DEPTH	HEIGHT
<del>336</del> 336 FT			

TYPE OF BLDG.	AREA	VOLUME	ROOF
B. ROOMS 3 ROOMS 4+DL BATHS 1 FIREPLACES			ASPH SH

FOOTINGS	FOUNDATION	S. WALLS

UTILITIES				
WATER/WELL	SEWER/SEPTIC	GAS	ELECTRICITY	TYPE OF HEAT
				E

I have carefully examined and read this application and know the same is true and correct, and that is doing this work, all provisions of Howard County Ordinances and the State Laws of Maryland will be complied with, whether specified or not; and I will notify the Department of Inspections, and Permits twenty-four hours in advance when I am ready for the inspections called for elsewhere in the application; and that no work will be covered up until such inspections have been completed with.

*Antonio V. Smith*  
 SIGNATURE  
 OWNER TITLE 19 JUN 98 DATE



FOR OFFICE USE ONLY

FUNCTION	DATE	SIGNATURE APPROVAL
ZONING/PLANNING		
SHA		
SEDIMENT/GRADING		
BUILDING OFFICIAL		
WATER & SEWER		
HEALTH DEPT.	6/28/98	Mark E. Reikin
FIRE PROTECTION		
STORM WATER MGM.		

APPROVED DATE

Distribution of Copies:  
 White - Building Official  
 Green - Planning & Zoning  
 Yellow - Engineering  
 Pink - Health Dept.  
 Gold - S.H.A.



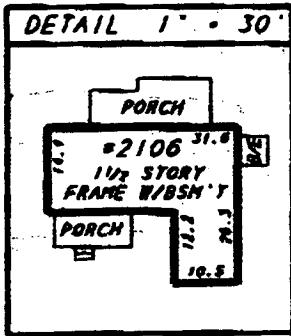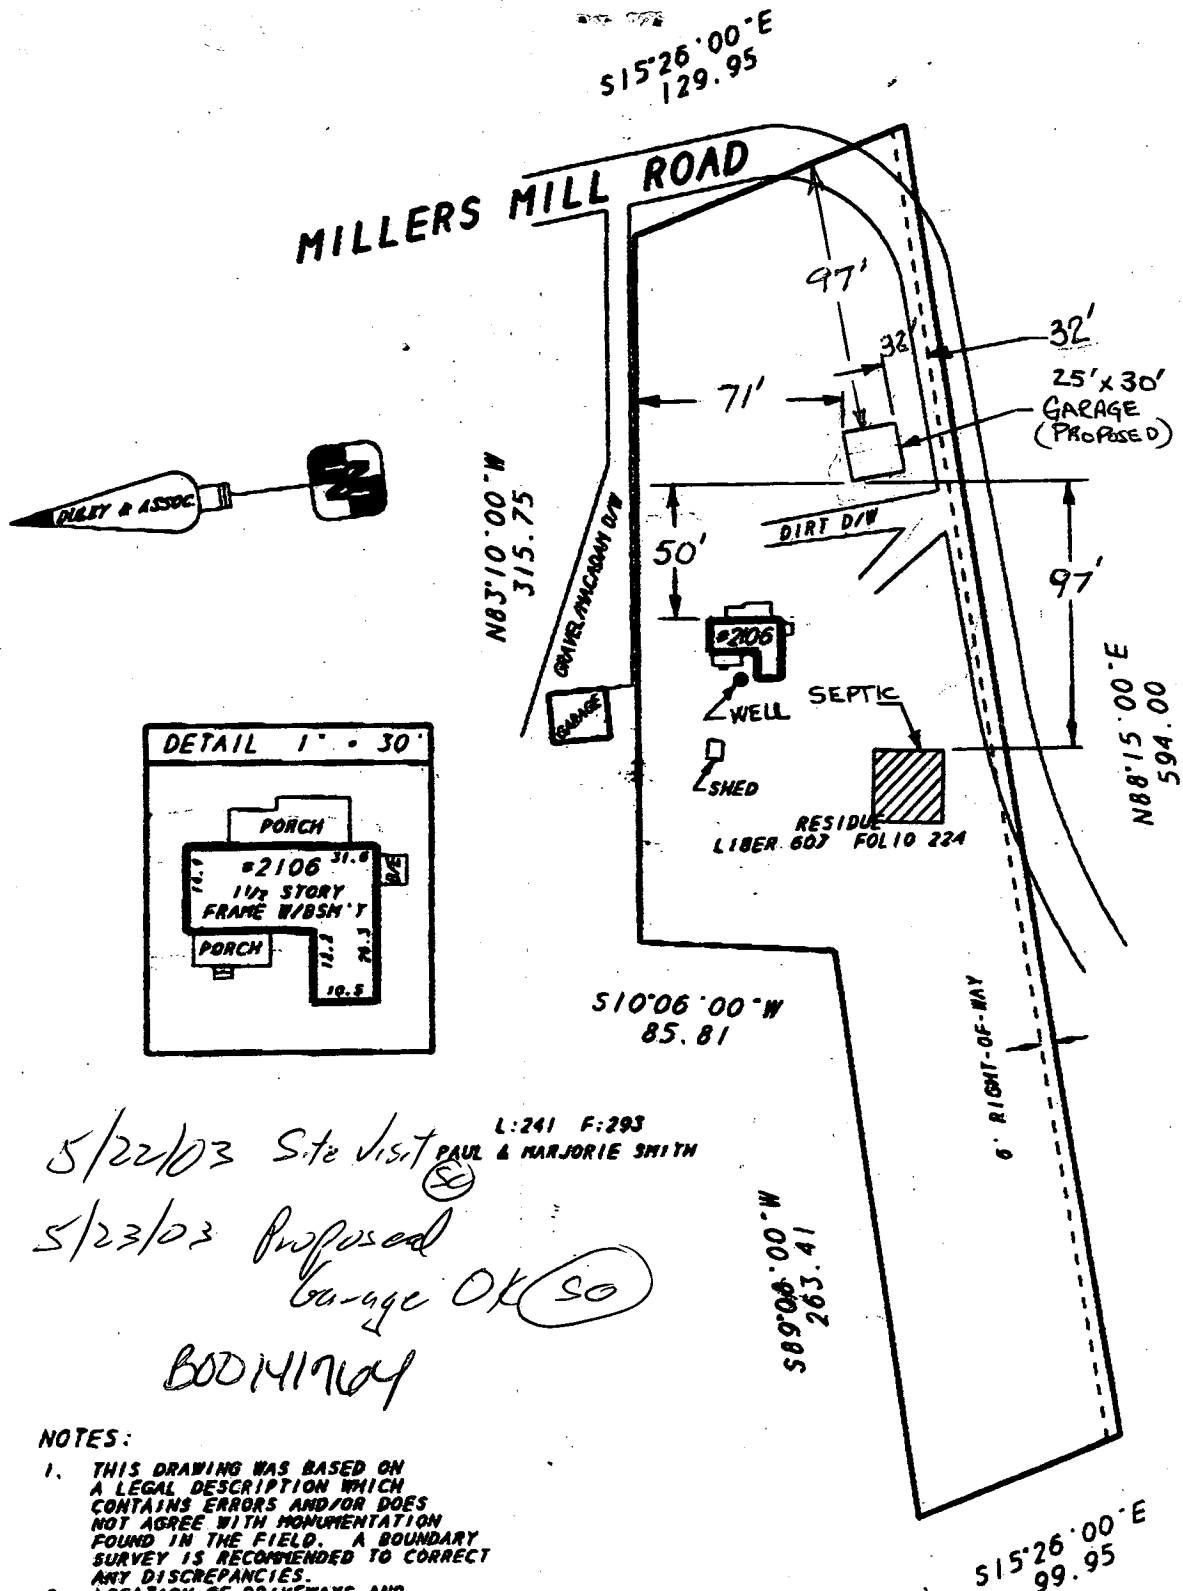

5/22/03 Site Visit  
 5/23/03 Proposed Garage OK (so)  
 BOOMINIA

L:241 F:293  
 PAUL & MARJORIE SMITH

**NOTES:**

1. THIS DRAWING WAS BASED ON A LEGAL DESCRIPTION WHICH CONTAINS ERRORS AND/OR DOES NOT AGREE WITH MONUMENTATION FOUND IN THE FIELD. A BOUNDARY SURVEY IS RECOMMENDED TO CORRECT ANY DISCREPANCIES.
2. LOCATION OF DRIVENWAYS AND ACCESS ROADS IS APPROXIMATE.
3. POSSIBLE ENCROACHMENTS MAY EXIST.

**DULEY AND ASSOCIATES, INC.**

DC. METRO OFFICE  
 9450 PENNSYLVANIA AVE.  
 UPPER MARLBORO, MD. 20772  
 PHONE: 301-888-1111  
 FAX: 301-888-1114

SOUTHERN MD. OFFICE  
 2460X THREE NOTCH RD.  
 HOLLYWOOD, MD. 20636  
 PHONE: 301-373-3300  
 FAX: 301-373-3301

**LOCATION SURVEY OF:**

**#2106 MILLERS MILL ROAD**  
 PART OF LIBER 607 FOLIO 224  
 N/F PROPERTY OF  
**NATHAN C., Jr., DOROTHY E. & CHARLES DOUGLAS SMITH**  
 4TH ELECTION DISTRICT  
 HOWARD COUNTY, MD  
 SCALE 1"=80' DATE: 5/29/97



CASE # 975375  
 SMITH  
 FILE # TA971870

**SURVEYOR'S CERTIFICATE**

I HEREBY STATE THAT THE EXISTING VISIBLE IMPROVEMENTS ON THE ABOVE DESCRIBED PROPERTY HAS BEEN CAREFULLY ESTABLISHED BY ACCEPTED METHODS AND THAT THE IMPROVEMENTS APPEAR TO LIE WITHIN FLOOD ZONE C. THIS SURVEY IS NOT TO BE USED OR RELIED UPON FOR THE ESTABLISHMENT OF ANY FENCE, BUILDING, OR OTHER IMPROVEMENTS. THIS PLAN DOES NOT PROVIDE FOR THE ACCURATE IDENTIFICATION OF PROPERTY BOUNDARY LINES, BUT SUCH IDENTIFICATION MAY NOT BE REQUIRED FOR THE TRANSFER OF TITLE OR SECURED FINANCING OR REFINANCING. THIS PLAN IS OF BENEFIT TO A CUSTOMER ONLY INsofar AS IT IS REQUIRED BY A LENDER OR A TITLE INSURANCE COMPANY OR ITS AGENT IN CONNECTION WITH THE CONTEMPLATED TRANSFER, FINANCING OR REFINANCING. THE LEVEL OF ACCURACY FOR THIS DRAWING IS 1/4". NO TITLE REPORT WAS FURNISHED TO NOR DONE BY THIS COMPANY. SAID PROPERTY SUBJECT TO ALL NOTES, RESTRICTIONS AND EASEMENTS OF RECORD. BUILDING RESTRICTION LINES AND EASEMENTS NOT SHOWN ON RECORD PLAN MAY NOT BE SHOWN HEREON.