

12/28/84
12N

02-24222

approved
12-28-84
SA P 34612

PERMIT

SEWAGE DISPOSAL SYSTEM

A REPAIR

MARYLAND STATE DEPARTMENT OF HEALTH*

HOWARD COUNTY
BUREAU OF ENVIRONMENTAL HEALTH

INDEXED

ELLICOTT CITY

DISTRICT _____

992-2330
461-1133

DATE 12/7/84

John Ruth Company IS PERMITTED TO INSTALL _____ ALTER X

ADDRESS 5820 Johnny Cake Road, Baltimore, MD 21207 PHONE 747-0678

SUBDIVISION _____ ROAD 9222 Frederick Road LOT _____

PROPERTY OWNER Mrs. Edgar Schneider
9222 Frederick Road

ADDRESS _____

IF GARBAGE GRINDER IS USED INCREASE SEPTIC TANK CAPACITY BY 50% AND ABSORPTION AREA BY 22%.

GARBAGE GRINDER? YES _____ NO X

SEPTIC TANK CAPACITY 1000 GALLONS NUMBER OF BEDROOMS _____

REPAIR - REPLACE METAL SEPTIC TANK WITH A 1000 gal. concrete tank.

PLANS APPROVED BY Frank Skinner DATE 12/7/84

COVER NO WORK UNTIL INSPECTED AND APPROVED.

NEITHER THE HOWARD COUNTY COUNCIL NOR THE HEALTH DEPARTMENT IS RESPONSIBLE FOR THE SUCCESSFUL OPERATION OF ANY SYSTEM.

NOTE: IF TRENCH IS USED CALL FOR INSPECTION BEFORE AND AFTER PLACING GRAVEL IN TRENCH.

NOTE: NO DRY WELL SHALL EXCEED 15 FOOT IN DIAMETER. NO ABSORPTION TRENCH TO EXCEED 100 FEET IN LENGTH.

NOTE: ALL PIPE FROM HOUSE TO SEPTIC TANK MUST BE CAST IRON OR SCHEDULE 40 PVC OR ABS.

PERMIT VOID AFTER THREE YEARS.


NOTE: INSTALL STAND PIPE ON SEPTIC TANK AND DRY WELL. STAND PIPES MUST BE 6 INCHES IN DIAMETER. CAST IRON, CONCRETE OR TERRA COTTA, OR PVC OR ABS ACCEPTED. IF TOP OF SEPTIC TANK IS DEEPER THAN 3 FEET MANHOLE TO GRADE REQUIRED.

***INSTALLER IS RESPONSIBLE FOR OBTAINING FINAL APROVAL ON THIS PERMIT**

*CALL 992-2330 FOR INSPECTION OF SEPTIC SYSTEMS. *1000g*

EH - 2-1082

P 34612
K R PHIL

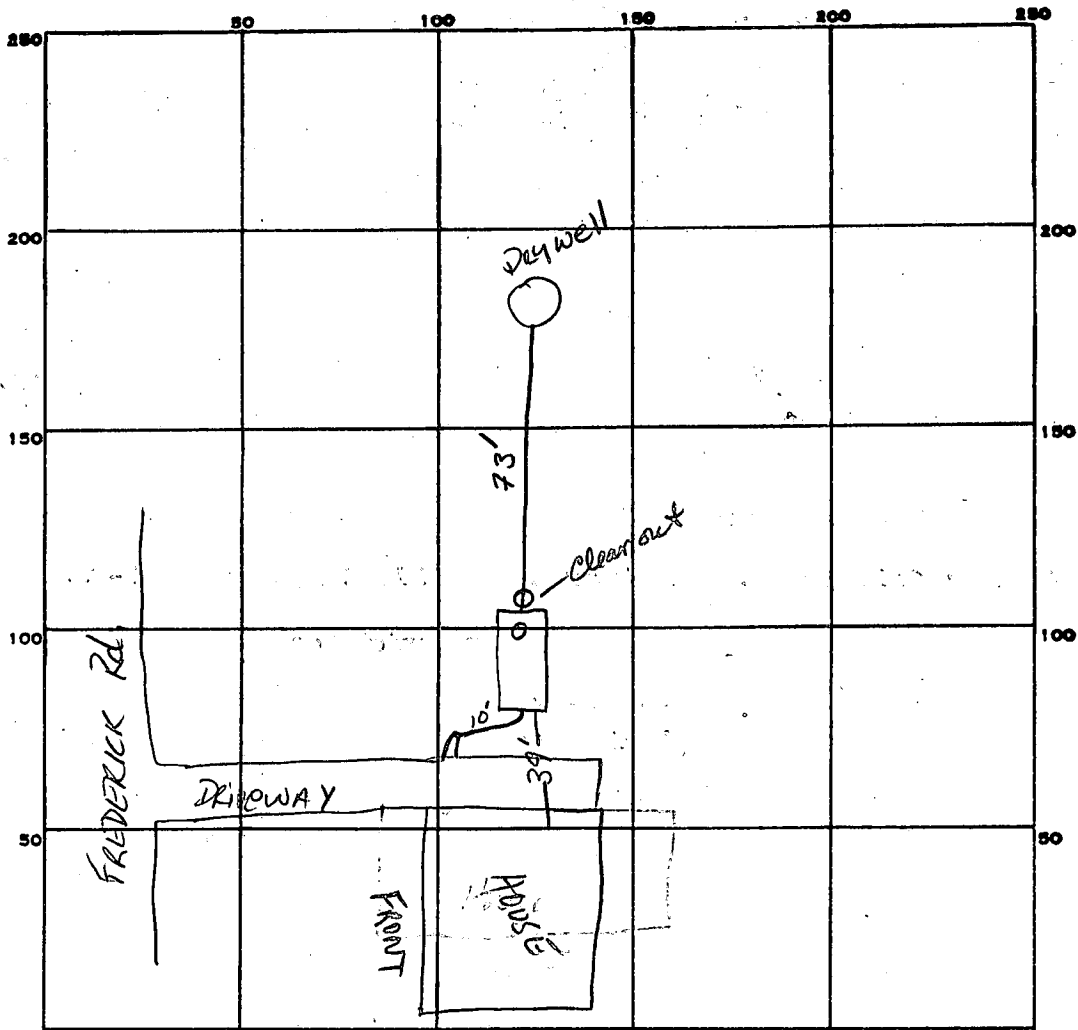

INDICATE NORTH. - NAME ADJOINING ROADWAY AS BASE LINE.

CHATHAM Rd.

PERMIT CARD _____

SEPTIC TANK, LEVEL _____

CLEANOUTS ST line to Dry well

DISTRIBUTION BOX, LEVEL N/A

TILE FIELD, DEPTH _____ FT. TRENCH WIDTH _____ FT.

GRAVEL DEPTH _____ IN. TOTAL LENGTH _____ FT.

NUMBER OF TRENCHES _____ TOTAL BOTTOM AREA _____

SEEPAGE PITS, INSIDE DIAMETER _____ FT. DEPTH BELOW INLET _____ FT.

ABSORBENT AREA _____ SQ. FT.

REMARKS 12/27/84 3pm Not ready J.S.

12/28/84 Septic Tank (1000 gal) in place, old cess pool collapsed and filled in, Dry well liquid level 4.5 ft below grade, extra open pit 15' off ST - unknown why present 8A

12/28/84 Cleanout on ST + line leading to Dry well - cement around all points OK - cover all work. - S Abel

DATE SYSTEM APPROVED 12-29-84

INSPECTOR S. Abel